
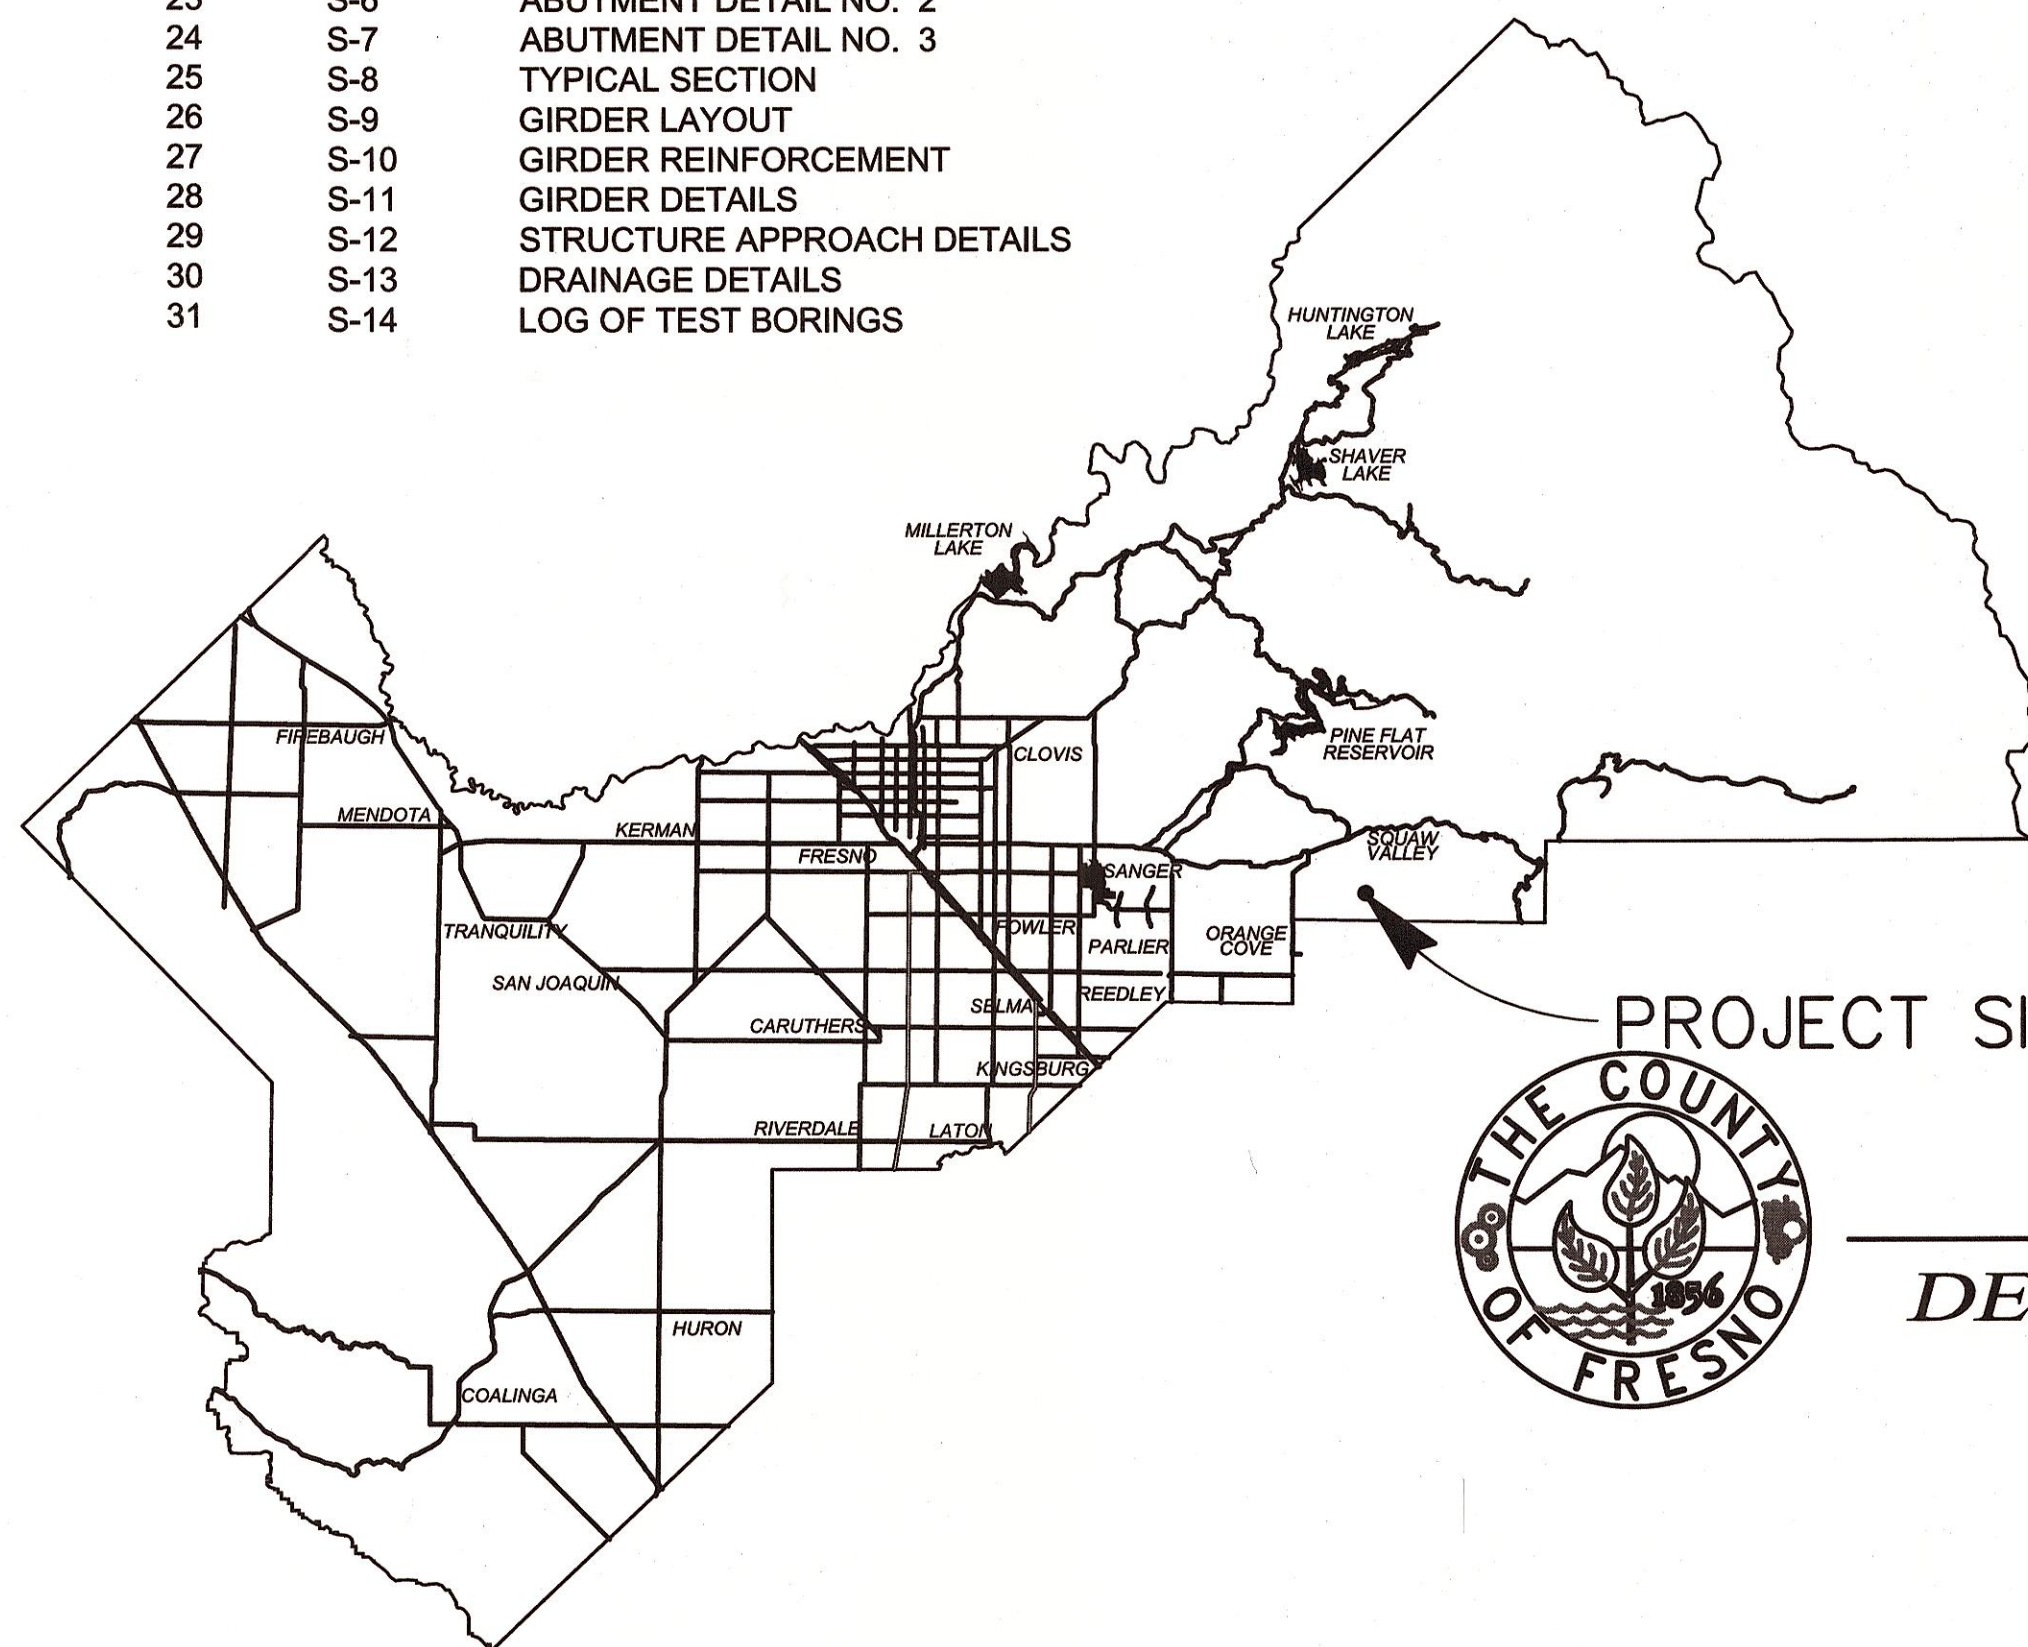


# PLANS FOR CONSTRUCTION

## FEDERAL BRIDGE REPLACEMENT PROJECT SAND CREEK BRIDGE REPLACEMENT ON ENNIS ROAD

FEDERAL PROJECT NUMBER: BRLO-5942(238)  
BRIDGE NO: 42CO697

<b>SHEET NO:</b>	<b>GENERAL:</b>
1	T-1 TITLE SHEET
2	T-2 CONSTRUCTION NOTES AND ABBREVIATIONS
	<b>ROADWAY PLANS:</b>
3	A-1 AERIAL SITE CONTROL PLAN
4	X-1 TYPICAL SECTIONS
5	X-2 TYPICAL SECTIONS
6	DM-1 DEMOLITION PLAN
7	PP-1 PLAN AND PROFILE ENNIS ROAD STA 9+00-13+50
8	PP-2 PLAN AND PROFILE ENNIS ROAD STA 13+50-17+00
9	PP-3 PLAN AND PROFILE HUMMINGBIRD LANE STA 10+00-STA 12+25
	<b>STORM DRAIN:</b>
10	SD-1 STORM DRAIN PLAN AND PROFILE
	<b>CONSTRUCTION DETAILS:</b>
11	CD-1 CONSTRUCTION DETAILS
12	CD-2 CONSTRUCTION DETAILS
	<b>EROSION CONTROL:</b>
13	EC-1 EROSION CONTROL
	<b>SIGNING AND STRIPING, AND DETOUR:</b>
14	SS-1 SIGNING PLAN
	<b>STAGE CONSTRUCTION AND DETOUR PLAN:</b>
15	SC-1 STAGE CONSTRUCTION -STAGE 1
16	SC-2 STAGE CONSTRUCTION -STAGE 2
17	DE-1 DETOUR PLAN
	<b>BRIDGE PLANS:</b>
18	S-1 GENERAL PLAN
19	S-2 DECK CONTOURS
20	S-3 FOUNDATION PLAN
21	S-4 ABUTMENT LAYOUT
22	S-5 ABUTMENT DETAIL NO. 1
23	S-6 ABUTMENT DETAIL NO. 2
24	S-7 ABUTMENT DETAIL NO. 3
25	S-8 TYPICAL SECTION
26	S-9 GIRDER LAYOUT
27	S-10 GIRDER REINFORCEMENT
28	S-11 GIRDER DETAILS
29	S-12 STRUCTURE APPROACH DETAILS
30	S-13 DRAINAGE DETAILS
31	S-14 LOG OF TEST BORINGS

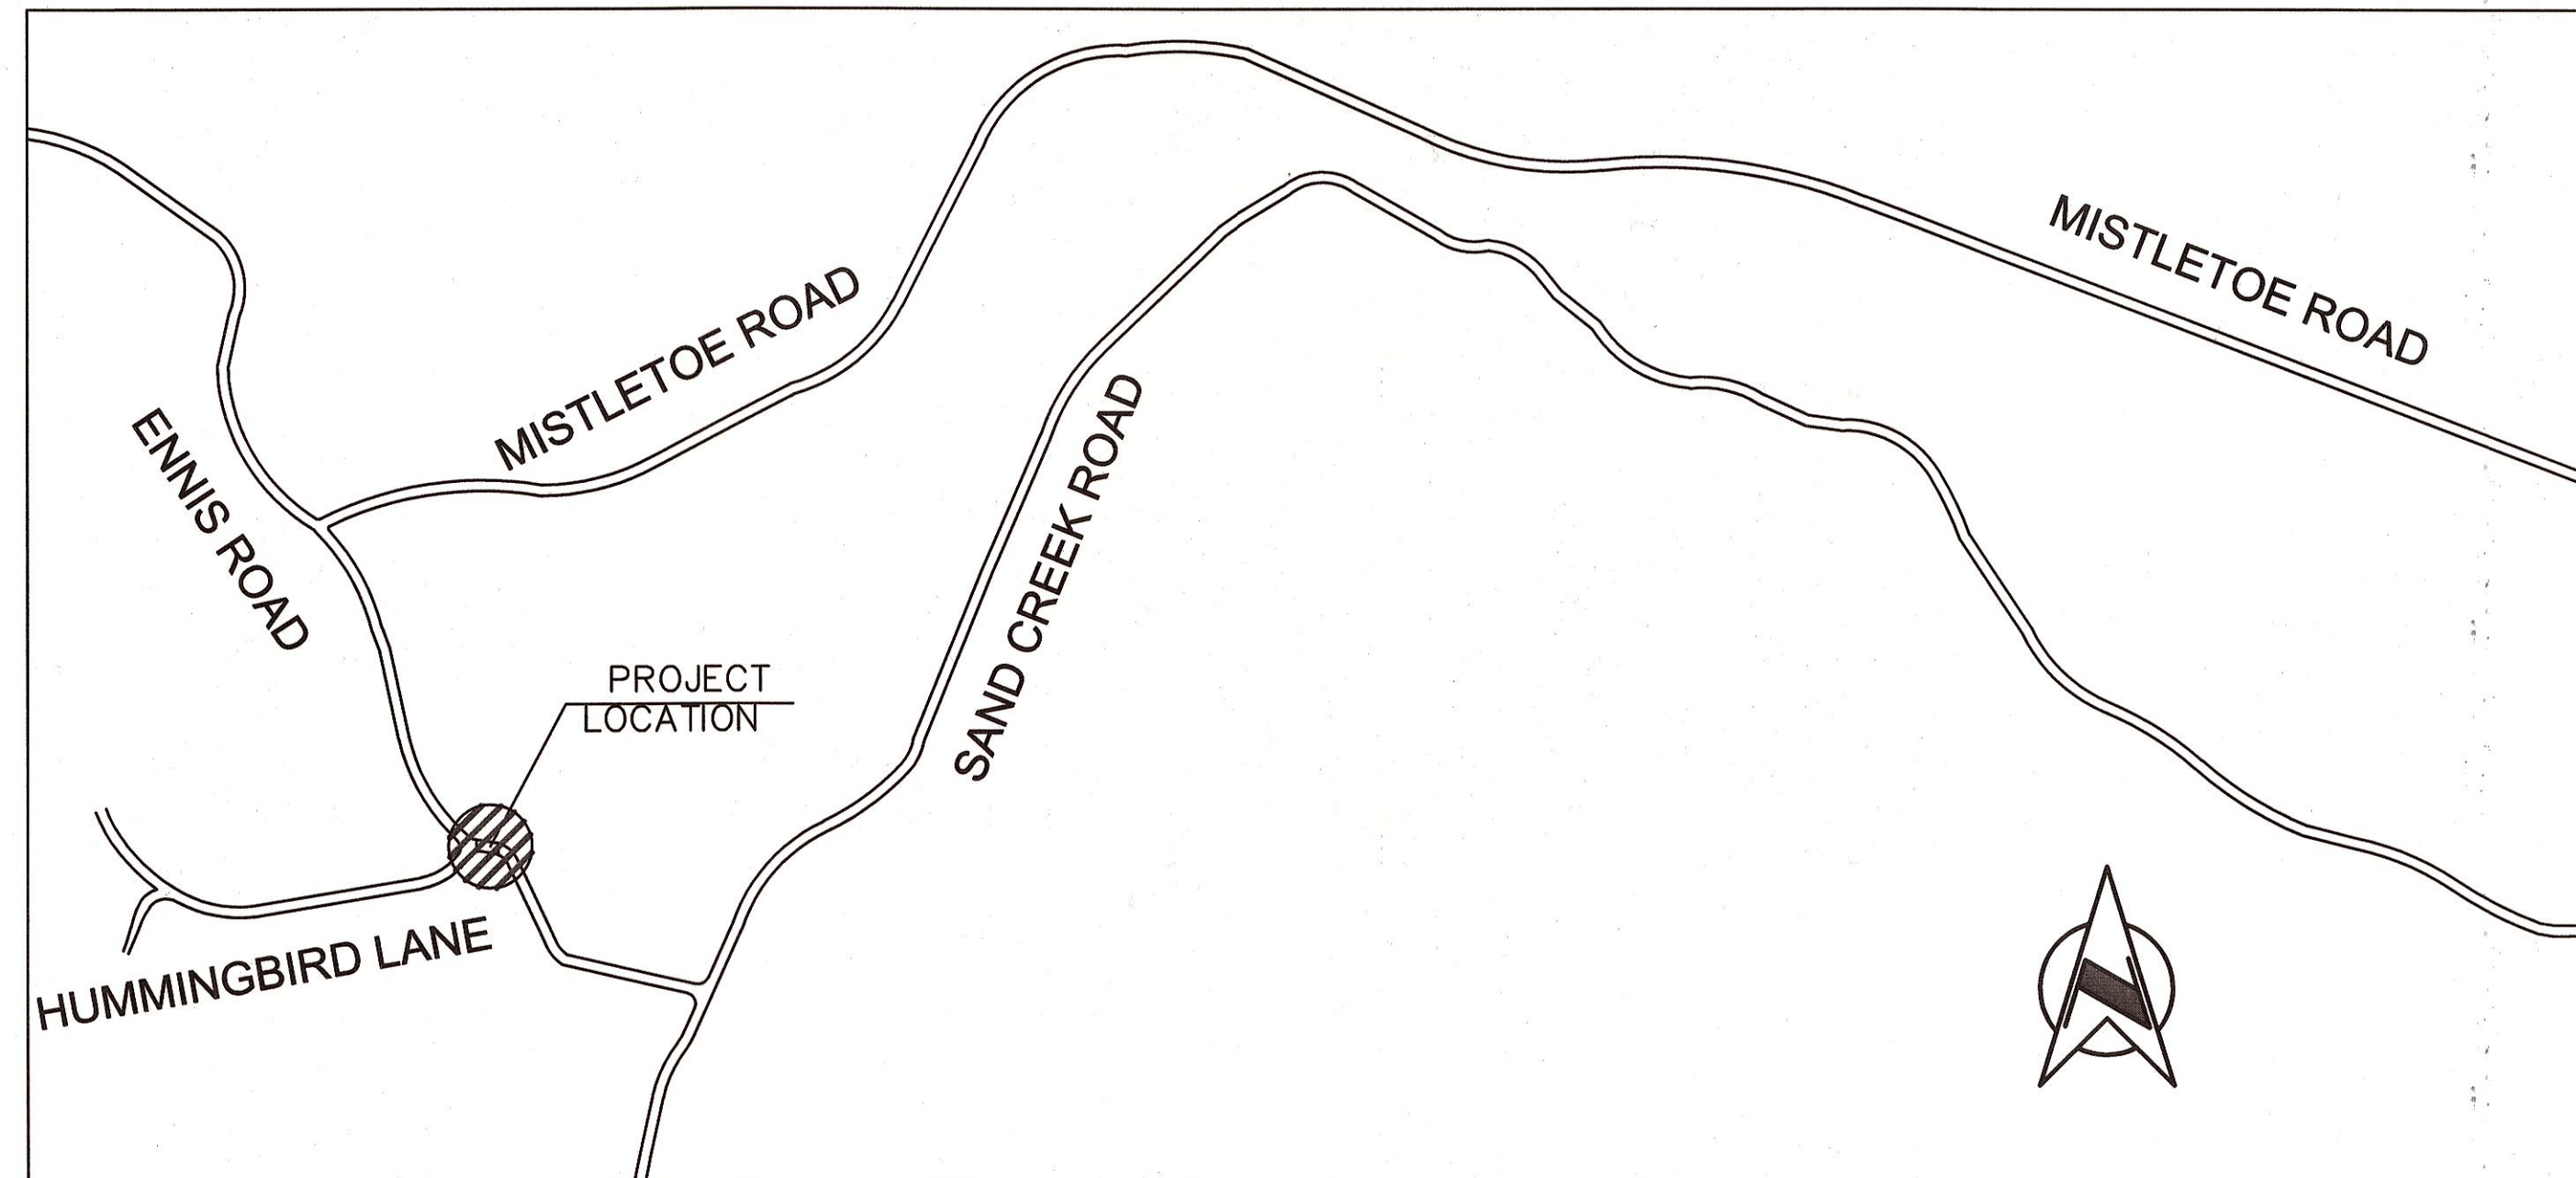

BENCH MARK AND DATUM				
MONUMENT	COORDINATES		ELEVATION	DESCRIPTION/LOCATION
	NORTHING	EASTING		
HN1G	2002915.567	6372176.001	252.141	COORDINATE VALUES WERE GPS DERIVED IN CALIFORNIA STATE PLAN COORDINATES, ZONE 4, EPOCH 2011 (NAD83) USING CSDS CONTINUALLY MONITORING STATION "HN1G", LOCATED IN HANFORD, CA. VERTICAL DATUM = NAVD88

NOTE: ALL DIMENSIONS HEREON ARE GRID DISTANCES. TO CONVERT FROM GRID TO GROUND, MULTIPLY THE GRID DISTANCE BY THE COMBINED SCALE FACTOR OF 0.999897'.

Steve Brandau	Chairman	2nd District
Brian Pacheco	Vice Chairman	1st District
Sal Quintero		3rd District
Ernest Buddy Mendes		4th District
Nathan Magsig		5th District

Jean M. Rousseau  
County Administrative Officer

APPROVED \_\_\_\_\_

Steven E. White, Director  
Department of Public Works and Planning

CALIFORNIA CONTRACTOR'S LICENSES REQUIRED FOR THIS PROJECT					
CLASS A, GENERAL ENGINEERING					
DRAWING NO.	ROAD NO.	BRIDGE NO.	FISCAL YR.	SHEET NO.	TOTAL
11257	2824-2825	42CO697	2020/2021	1	31
CONTRACT NO. 20-01-C					

RECORD DRAWING	
CONTRACTOR	
NAME	
ADDRESS	
CITY	STATE ZIP
PHONE	
DATE AWARDED	
DATE STARTED	
DATE COMPLETED	
RESIDENT ENGINEER	
NAME	SIGNATURE
NAME	SIGNATURE



DEPARTMENT OF PUBLIC WORKS AND PLANNING

## ABBREVIATIONS

AB	AGGREGATE BASE
ACB	ARTICULATED CONCRETE BLOCK
BB	BEGIN BRIDGE
BC	BEGIN CURVE
BEG	BEGIN
BVCE	BEGIN VERTICAL CURVE ELEVATION
BVCS	BEGIN VERTICAL CURVE STATION
CL	CENTERLINE
CA	CALIFORNIA
CP	CATCH POINT
CSDS	CALIFORNIA SURVEYING AND DRAFTING SERVICES
DIA	DIAMETER
E	EAST/EASTING
EA	EACH
EB	END BRIDGE
EC	END CURVE
EL	ELEVATION
ELEC	ELECTRICAL
EP	EDGE OF PAVEMENT
ETW	EDGE OF TRAVEL WAY
EX.	EXISTING
FG	FINISHED GROUND
FR	FIBER ROLLS
FS	FINISHED SURFACE
FT	FEET
G	GRADE
GB	GRADE BREAK
H	HEIGHT
HMA	HOT MIX ASPHALT
INTER	INTERSECTION
L	LENGTH
LF	LINEAR FEET
LN	LANE
LT	LEFT
LVC	LENGTH OF VERTICAL CURVE
MAX	MAXIMUM
MGS	MIDWEST GUARDRAIL SYSTEM
MIN	MINIMUM
MOD	MODIFIED
MPH	MILES PER HOUR
MUTCD	MANUAL ON UNIFORM TRAFFIC CONTROL DEVICES
N	NORTHING
NTS	NOT TO SCALE
O.C.	ON CENTER
OG	ORIGINAL GROUND
OH	OVERHEAD
P	PAVEMENT
PG	PROFILE GRADE
PI	POINT OF INTERSECTION
PR.	PROPOSED
PSI	POUNDS PER SQUARE INCH
PUE	PUBLIC UTILITY EASEMENT
PVI	POINT OF VERTICAL INTERSECTION
R	RADIUS
RD	ROAD
RT	RIGHT
R/W	RIGHT OF WAY
S	SOUTH
SD	STORM DRAIN
SHLD	SHOULDER
STD	STANDARD
T	TANGENT
TCE	TEMPORARY CONSTRUCTION EASEMENT
TYP	TYPICAL
W	WEST/WIDTH
WWLOL	WING WALL LAYOUT LINE

## CONSTRUCTION NOTES




- 1 PROTECT IN PLACE UTILITY POLE
- 2 CONSTRUCT 3" HMA OVER 9" AB
- 3 PROTECT IN PLACE OVERHEAD LINES
- 4 CONSTRUCT GUARDRAIL SYSTEM STANDARD RAILING SECTION, PER CALTRANS RSP A77L1 WITH CALTRANS APPROVED 31" IN-LINE TERMINAL END TREATMENT, USING TYPE 12A LAYOUT PER CALTRANS RSP A77Q1
- 5 CONSTRUCT GUARDRAIL SYSTEM STANDARD RAILING SECTION, PER CALTRANS RSP A77L1 WITH CALTRANS APPROVED 31" IN-LINE TERMINAL END TREATMENT, USING TYPE 12AA LAYOUT PER CALTRANS RSP A77Q4
- 6 RELOCATE UTILITY POLE AND OVERHEAD LINE (BY OTHERS)
- 7 REMOVE EXISTING TREE
- 8 PROTECT IN PLACE SHED STRUCTURE
- 9 INSTALL TRANSITIONAL RAILING TYPE WB-31 PER CALTRANS STD PLAN RSP A77U4
- 10 INSTALL PIPE CULVERT WINGWALL (W=1') PER CALTRANS STD PLAN D86B
- 11 INSTALL 24" RCP CULVERT PER CALTRANS STD PLAN A62D
- 12 CONSTRUCT 10" CLASS II AGGREGATE BASE
- 13 INSTALL MUTCD STANDARD TYPE E WHITE RETROREFLECTOR (2-SIDED) GUARDRAIL DELINEATOR; SPACING TO BE EVERY 20 FT
- 14 PROTECT IN PLACE GATE
- 15 REMOVE ASPHALT CONCRETE PAVEMENT
- 16 REMOVE EXISTING METAL BEAM GUARDRAIL
- 17 REMOVE EXISTING WOOD POST AND WIRE FENCE
- 18 REMOVE EXISTING 24" STORM DRAIN PIPE
- 19 CONSTRUCT HOT MIX ASPHALT DIKE TYPE C PER CALTRANS STANDARD PLAN RSP A87B PER PLACEMENT AS INDICATED ON CALTRANS STANDARD PLAN A77N4
- 20 CONSTRUCT SHOULDER BACKING MATERIAL AT A DEPTH OF 0.30'
- 21 CONCRETE BARRIER, SEE STRUCTURAL PLANS
- 22 SAWCUT, MATCH EXISTING
- 23 INSTALL CLASS III RSP
- 24 INSTALL 10'X10' CLASS V RSP CENTERED ON PIPE AT TOE OF SLOPE
- 25 CONSTRUCT CONCRETE LINED V-DITCH
- 26 CONSTRUCT DIP CROSSING
- 27 CONSTRUCT SPLASH WALL

## SIGNING NOTES


- |   |  |
|---|--|
| E | PROTECT IN PLACE EXISTING SIGN UNLESS OTHERWISE NOTED                      |
| 1 | REMOVE EXISTING SIGN   |
| 2 | INSTALL SIGN AND POST AS INDICATED. EXISTING SHALL BE REMOVED AND DISPOSED |

**Note:**

These plans shall be supplemented by the Caltrans Standard Plans dated 2018.

		<b>RECORD DRAWING</b>	<b>SCALE</b>		<b>PROJECT</b>		<i>DEPARTMENT OF PUBLIC WORKS AND PLANNING</i>
DESIGNED: SA	3/12/2021	RESIDENT ENGINEER	DATE	AS SHOWN	SAND CREEK BRIDGE REPLACEMENT ON ENNIS ROAD		<b>CONSTRUCTION</b>
DRAWN: LS	3/12/2021						<b>NOTES AND ABBREVIATIONS</b>
CHECKED: SA	3/12/2021						DRAWING NO. 11257      SHEET NO. 2      TOTAL 31
FOR RIGHT OF WAY DATA AND ACCURATE ACCESS DETERMINATION, SEE DOCUMENTS IN THE DEPARTMENT OF PUBLIC WORKS AND PLANNING.				 4670 Willow Rd., Ste 250 Pleasanton, CA 94566 925.396.7700	 REGISTERED PROFESSIONAL ENGINEER SIBILA AMPARO 78003 Exp 9-30-21 CIVIL STATE OF CALIFORNIA	ROAD NO. 2824-2825      BRIDGE NO. 42C0697, BRLO-5942(238)	

P:\ENG14\20141070\_FRESNO-SAND\_CREEK\_BRIDGE\_ON\_ENNIS\_ROAD\ENG\SHEETS\A-1

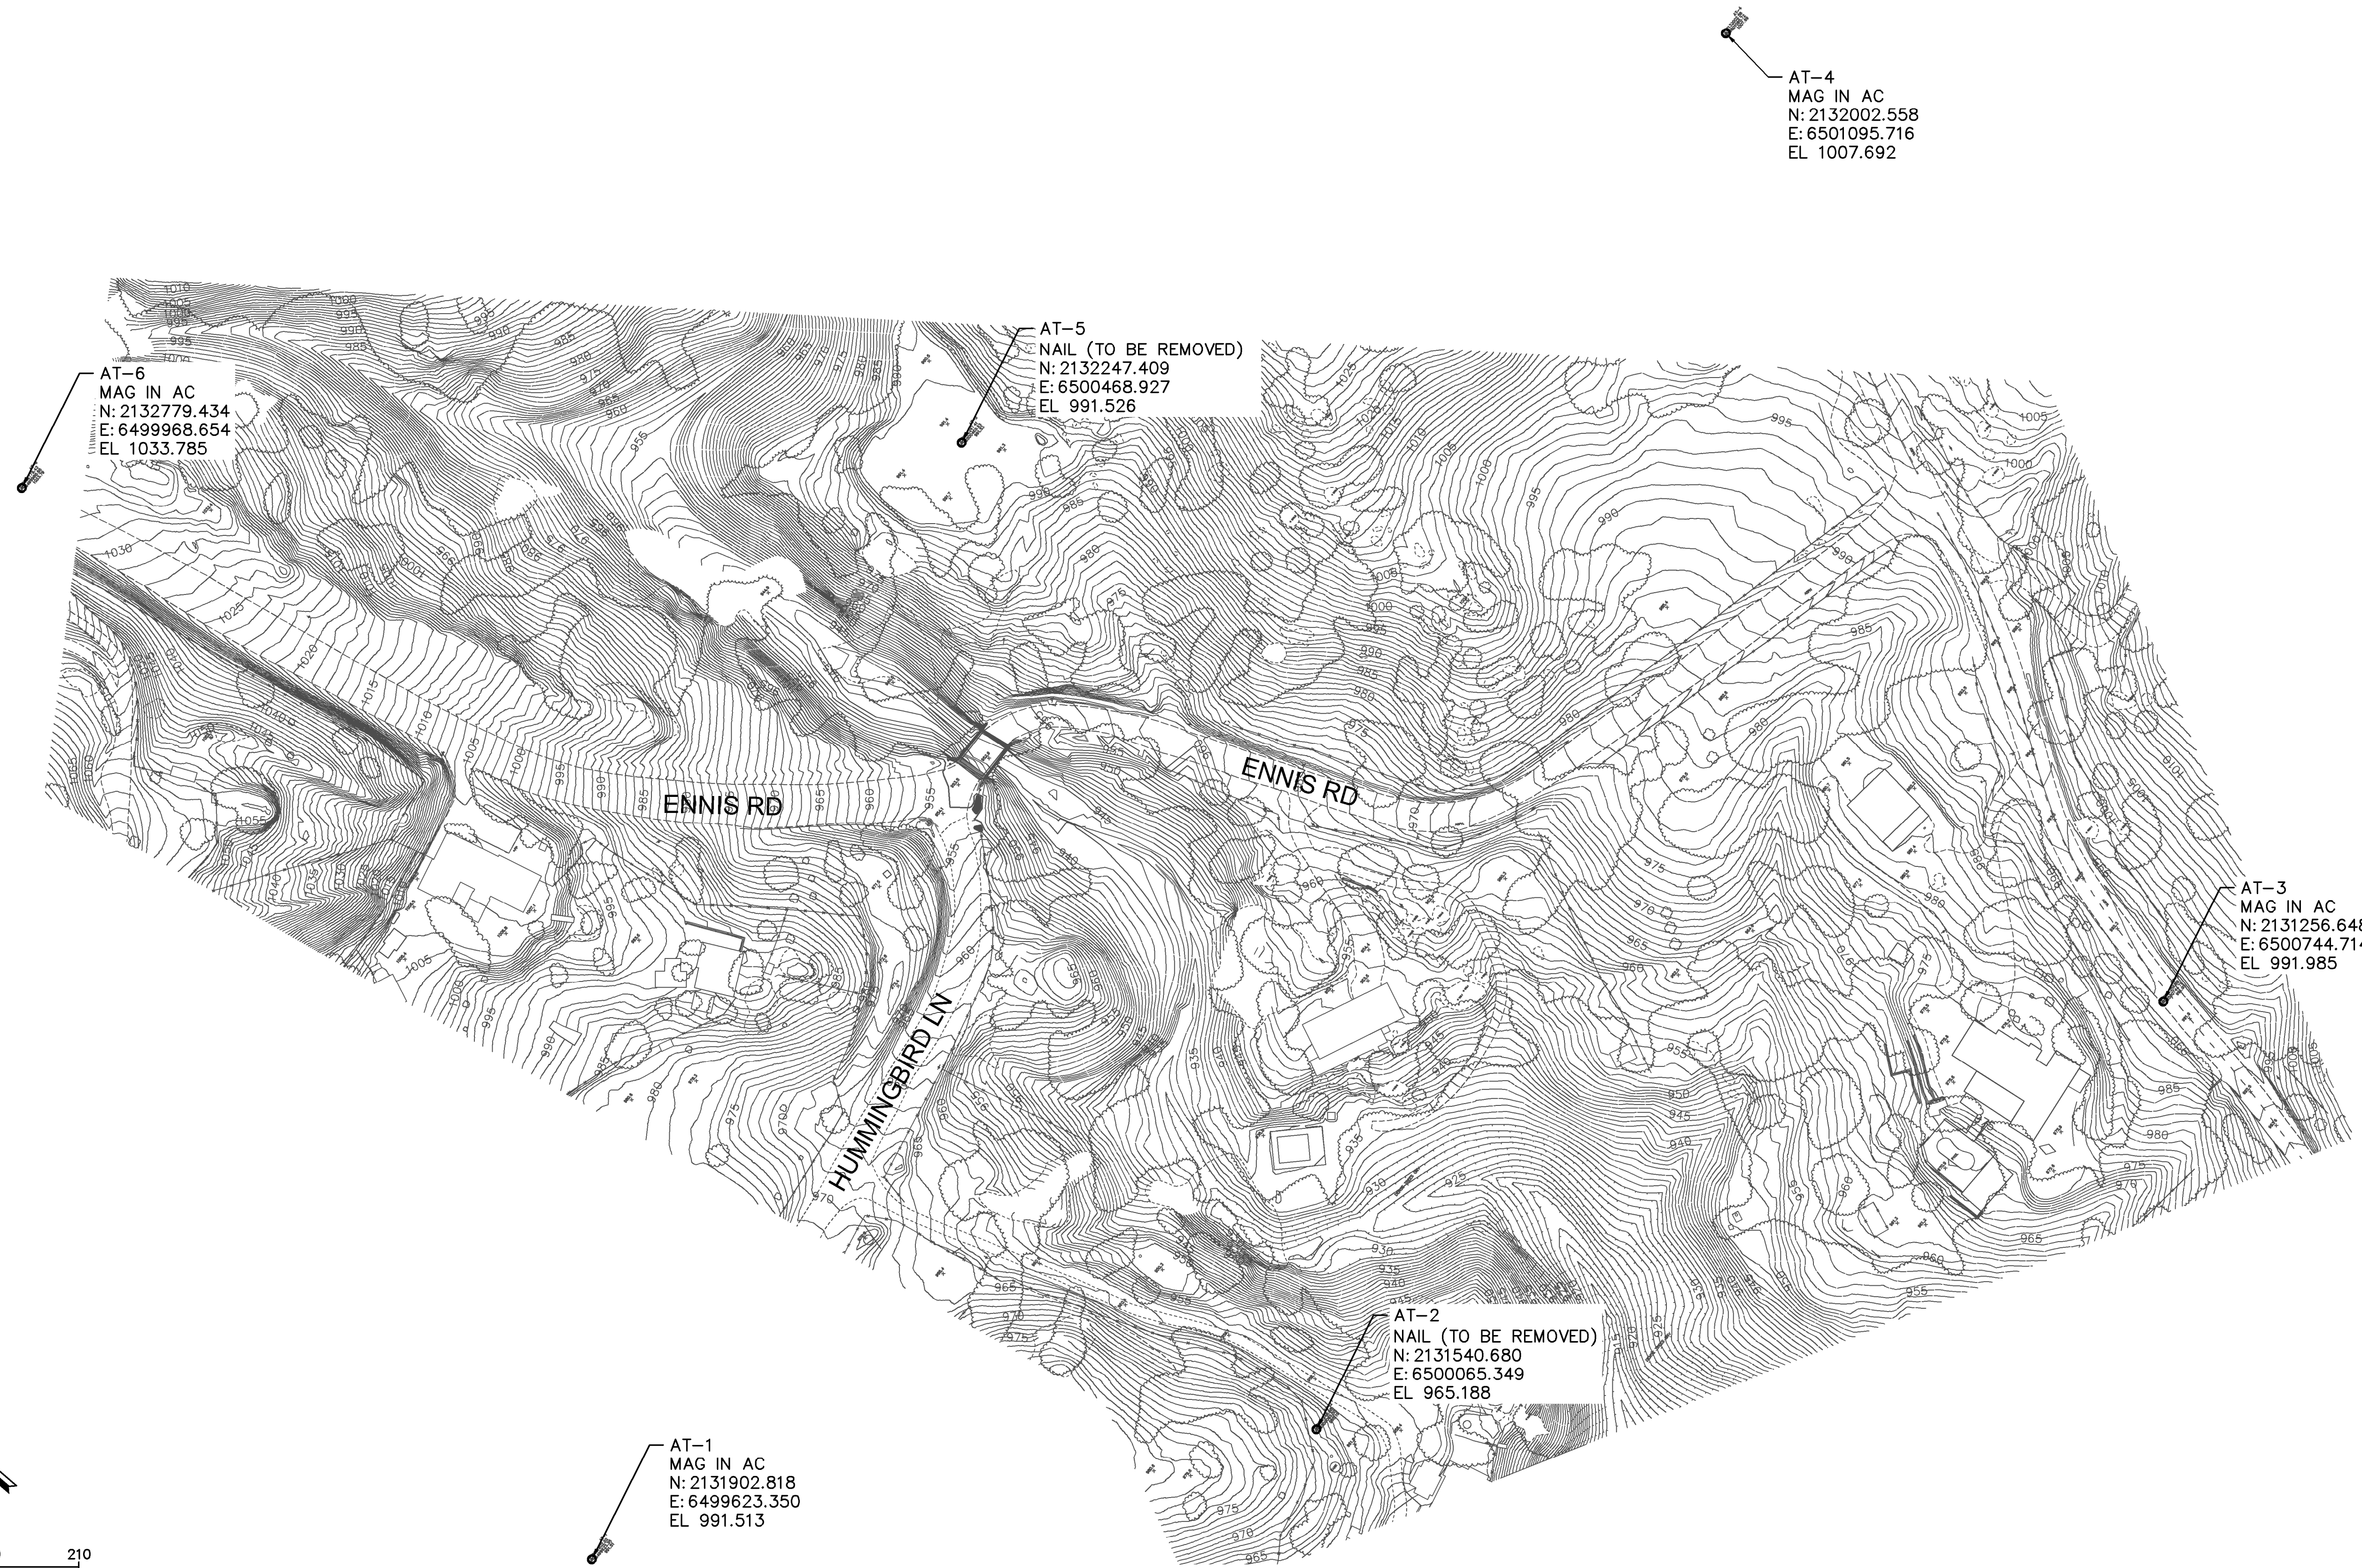

AT-6  
MAG IN AC  
N: 2132779.434  
E: 6499968.654  
EL 1033.785



AT-5  
NAIL (TO BE REMOVED)  
N: 2132247.409  
E: 6500468.927  
EL 991.526

AT-4  
MAG IN AC  
N: 2132002.558  
E: 6501095.716  
EL 1007.692




AT-3  
MAG IN AC  
N: 2131256.648  
E: 6500744.714  
EL 991.985









AT-2  
NAIL (TO BE REMOVED)  
N: 2131540.680  
E: 6500065.349  
EL 965.188

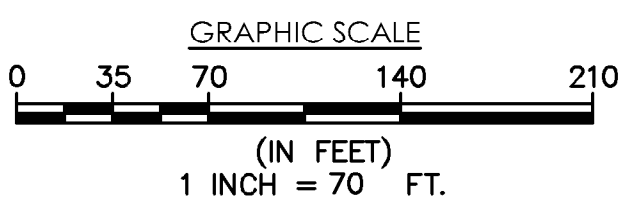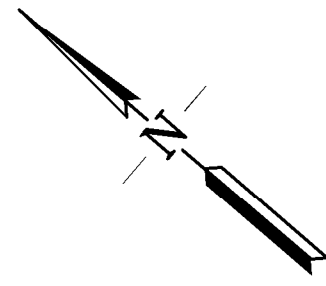AT-1  
MAG IN AC  
N: 2131902.818  
E: 6499623.350  
EL 991.513



A-1

DESIGNED: SA		DATE: 3/12/2021		RECORD DRAWING		SCALE		 <p>4670 Willow Rd., Ste 250 Pleasanton, CA 94588 925.396.7700</p>		PROJECT			DEPARTMENT OF PUBLIC WORKS AND PLANNING		
DRAWN: LS		DATE: 3/12/2021				AS SHOWN				SAND CREEK BRIDGE REPLACEMENT ON ENNIS ROAD			AERIAL SITE CONTROL PLAN		
CHECKED: SA		DATE: 3/12/2021								ROAD NO. 2824-2825			BRIDGE NO. 42C0697, BRLO-5942(238)		DRAWING NO. 11257
FOR RIGHT OF WAY DATA AND ACCURATE ACCESS DETERMINATION, SEE DOCUMENTS IN THE DEPARTMENT OF PUBLIC WORKS AND PLANNING.												SHEET NO. 3		TOTAL 31	

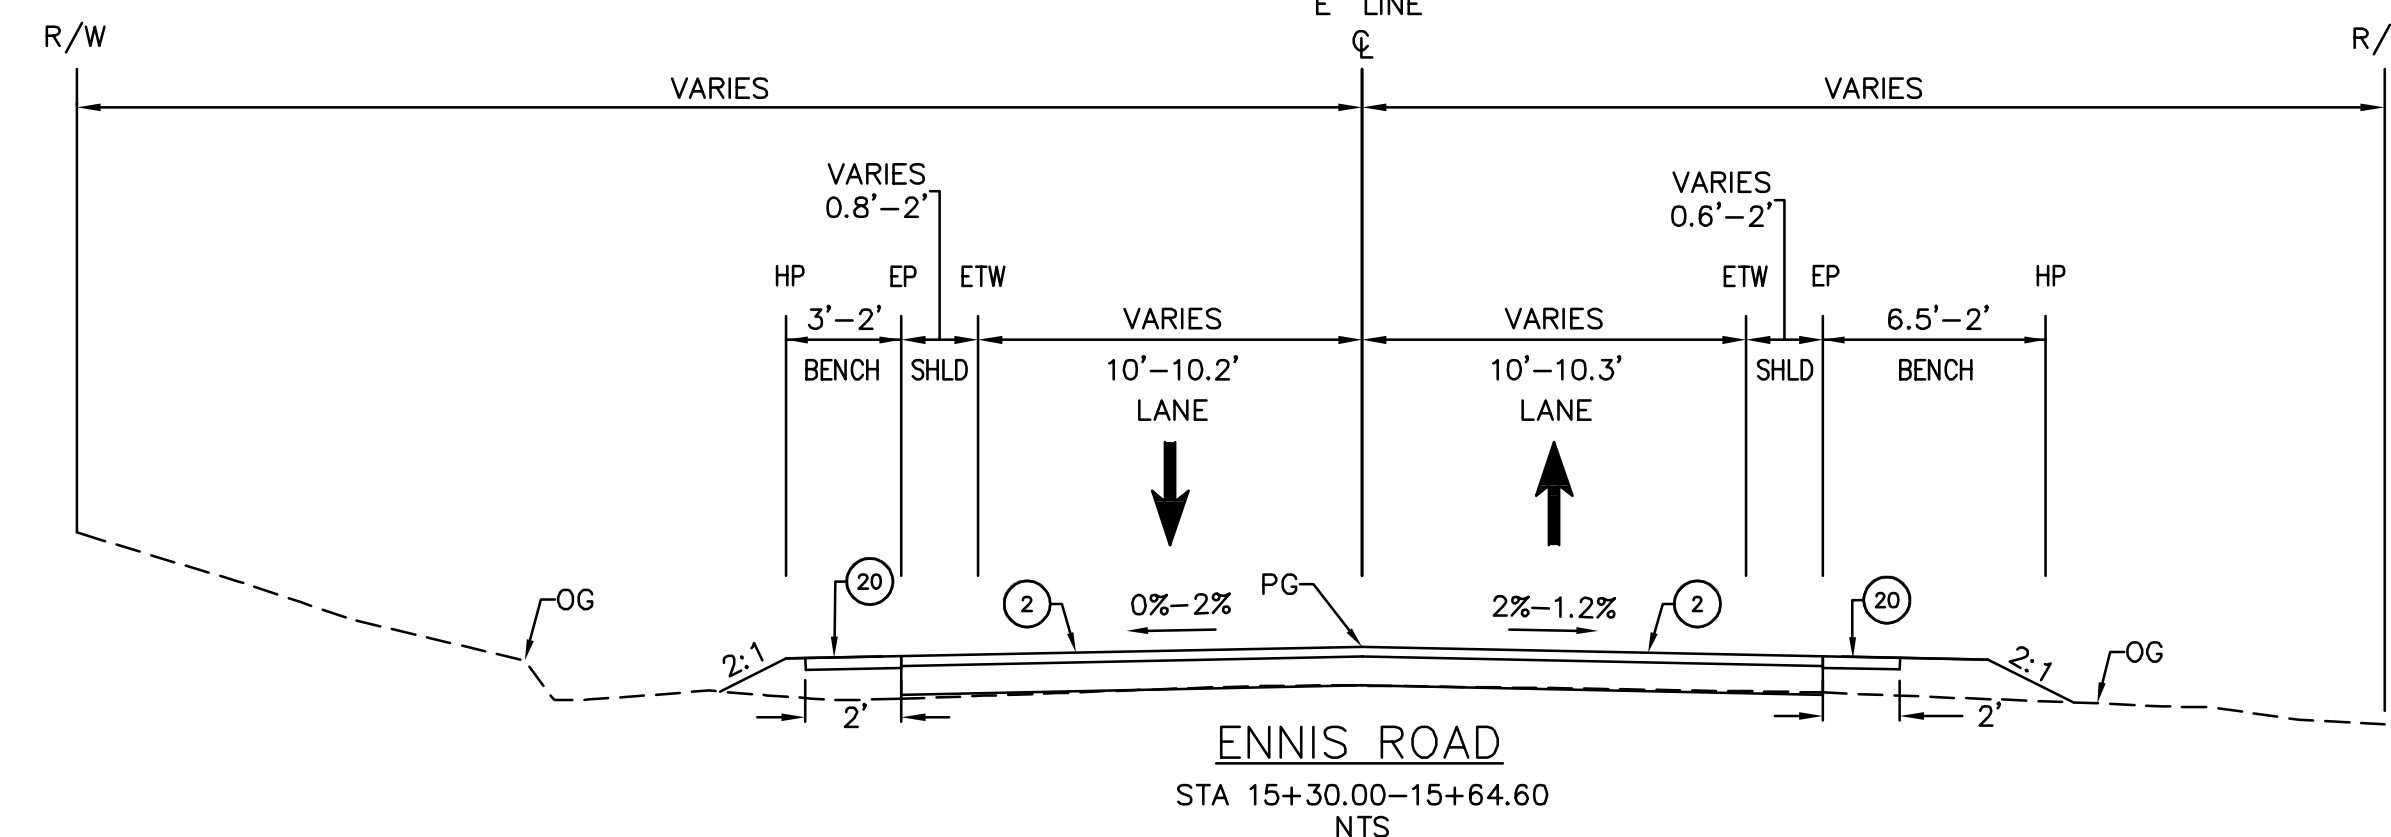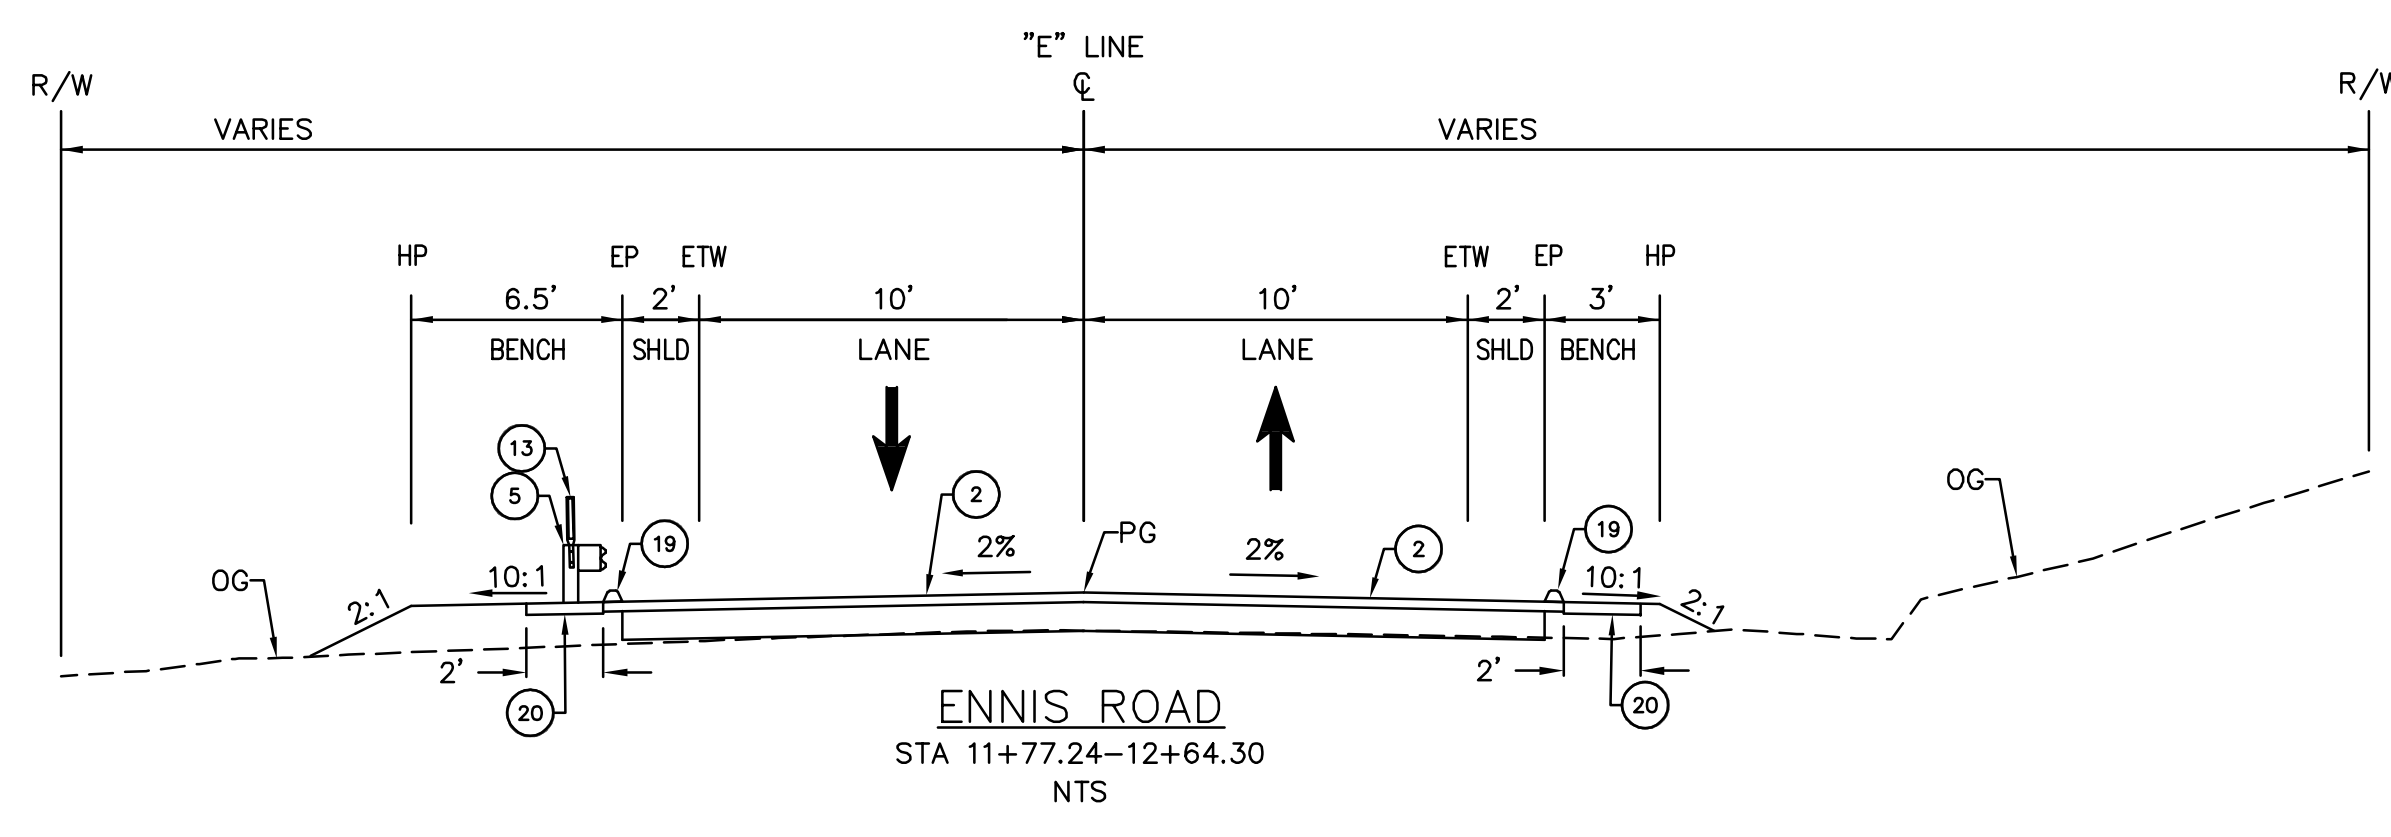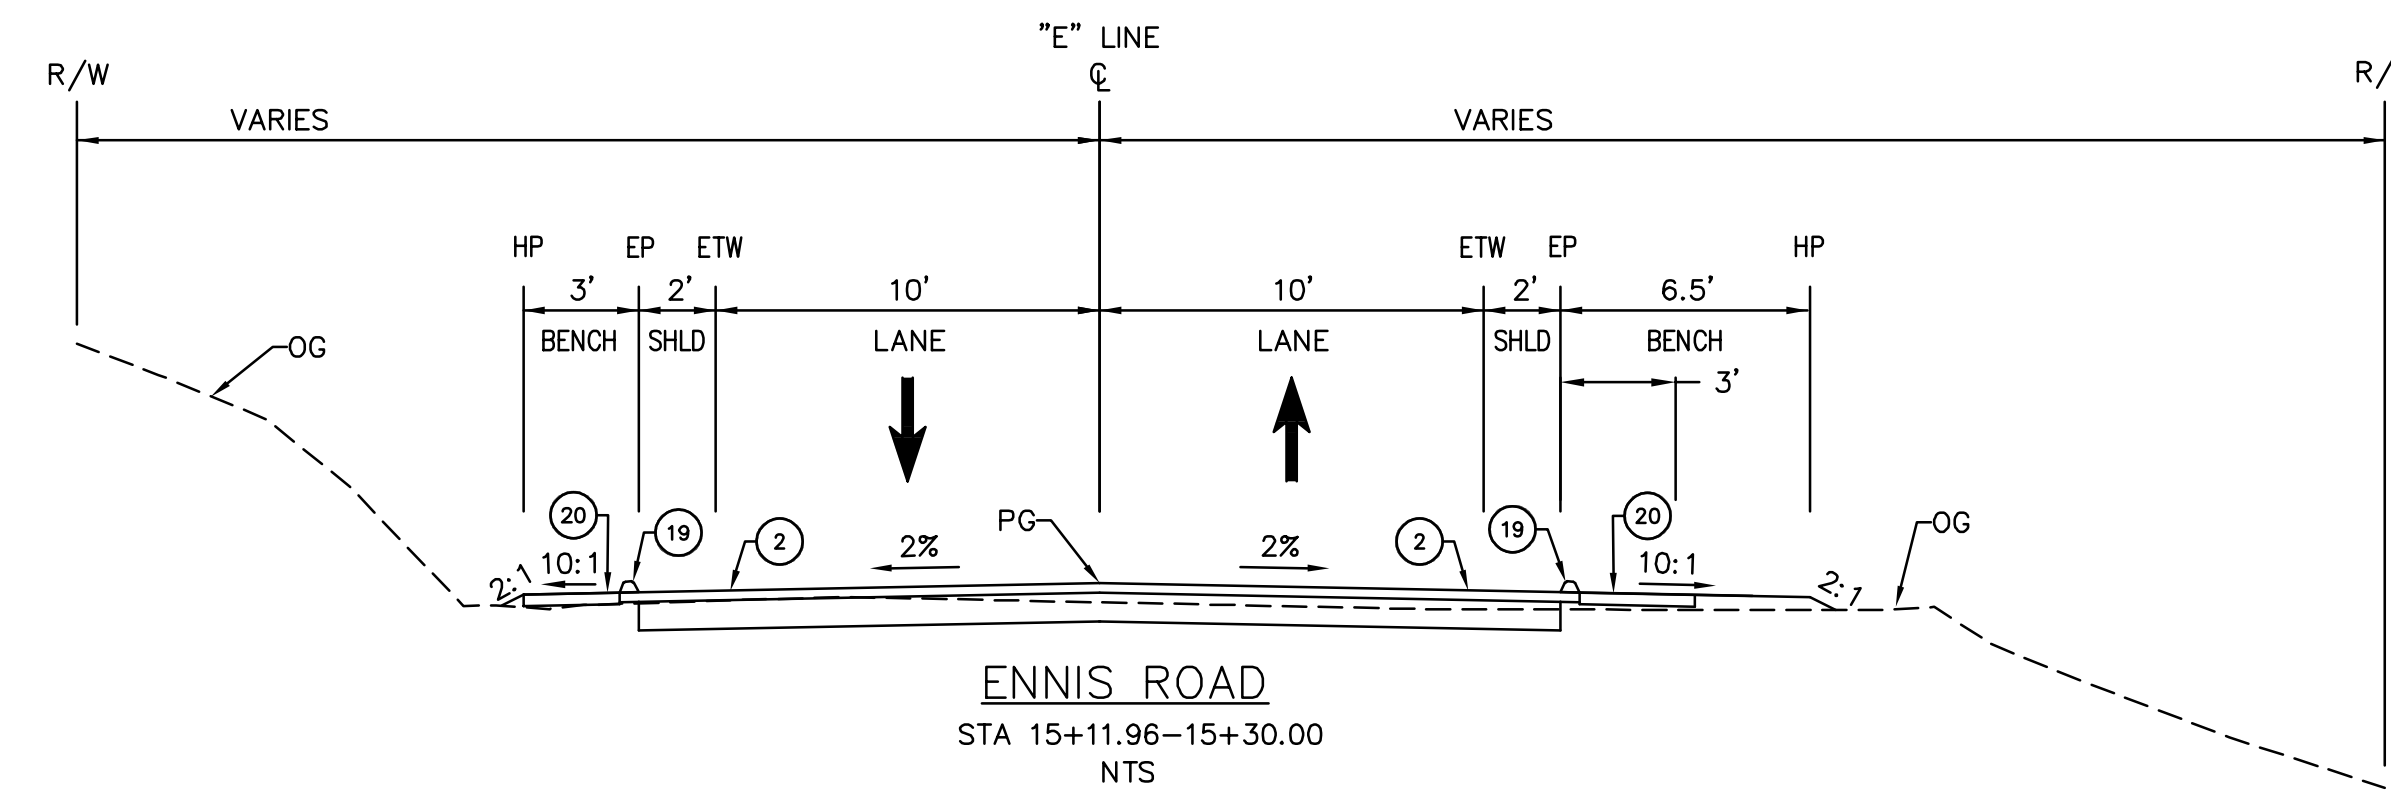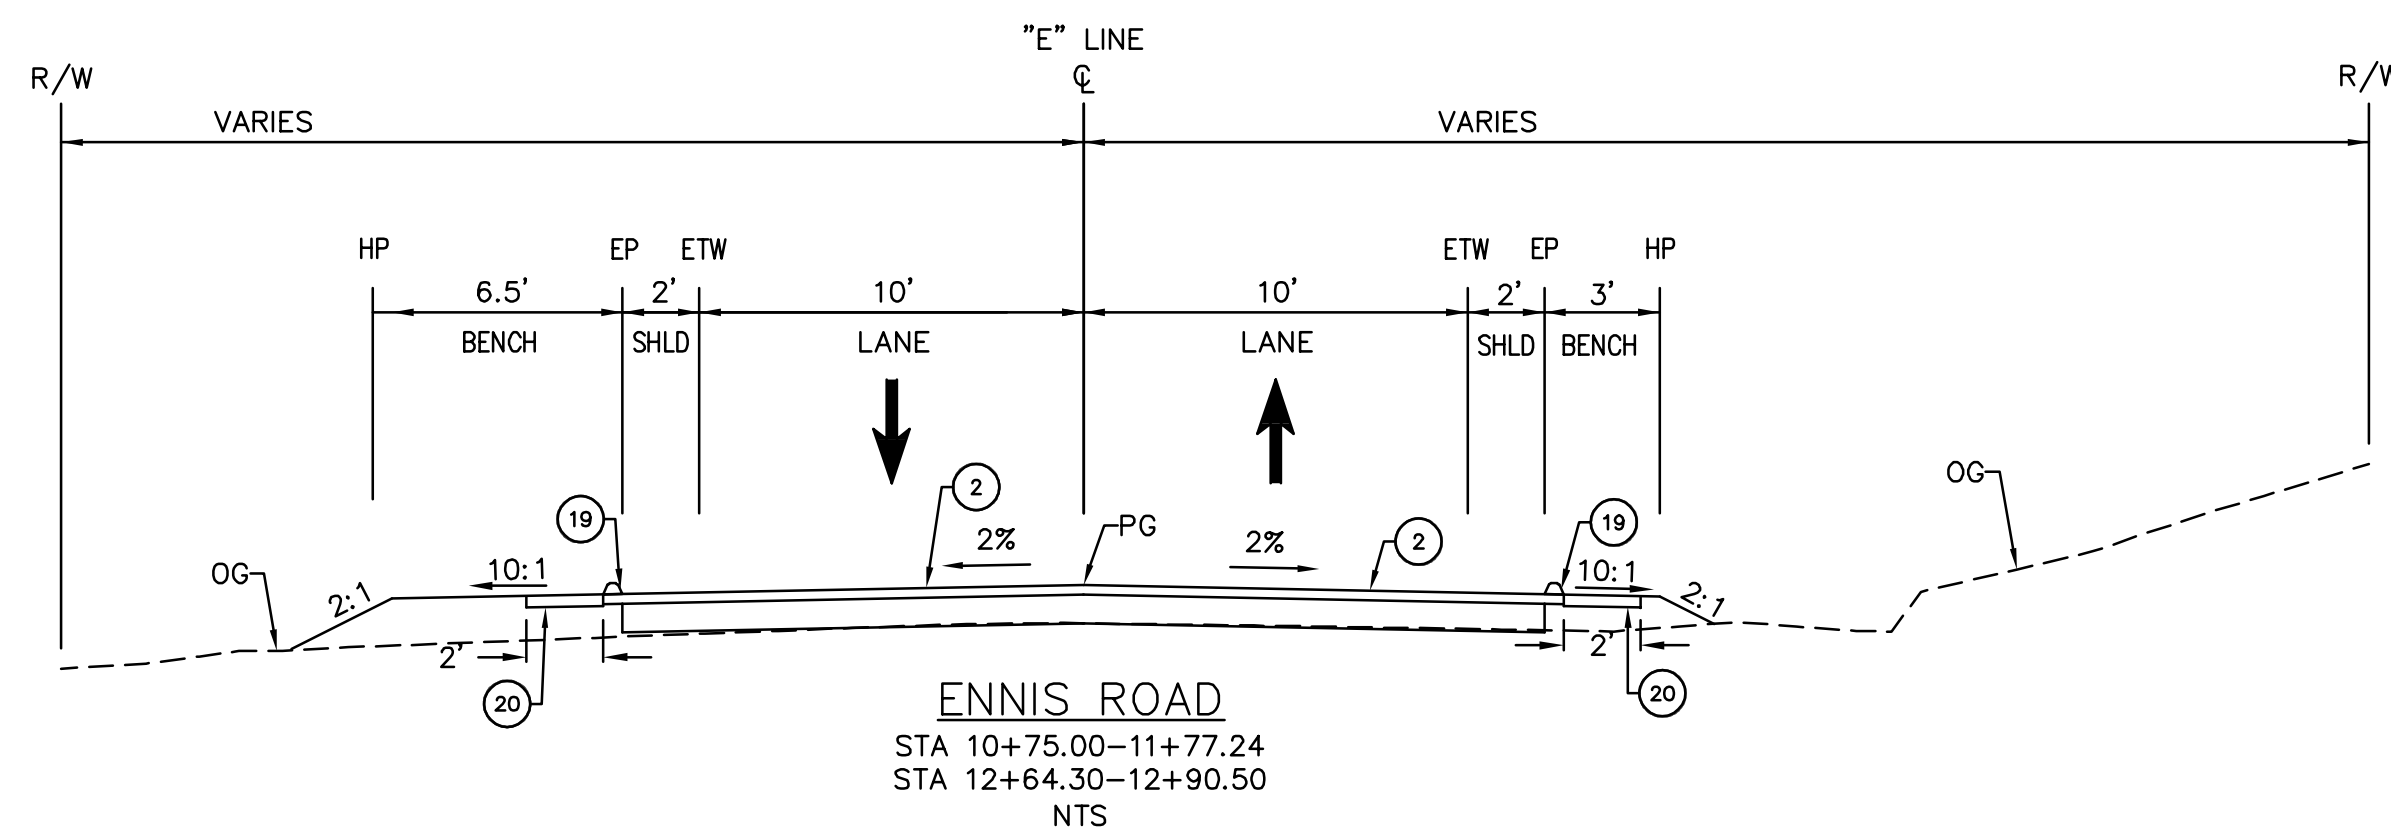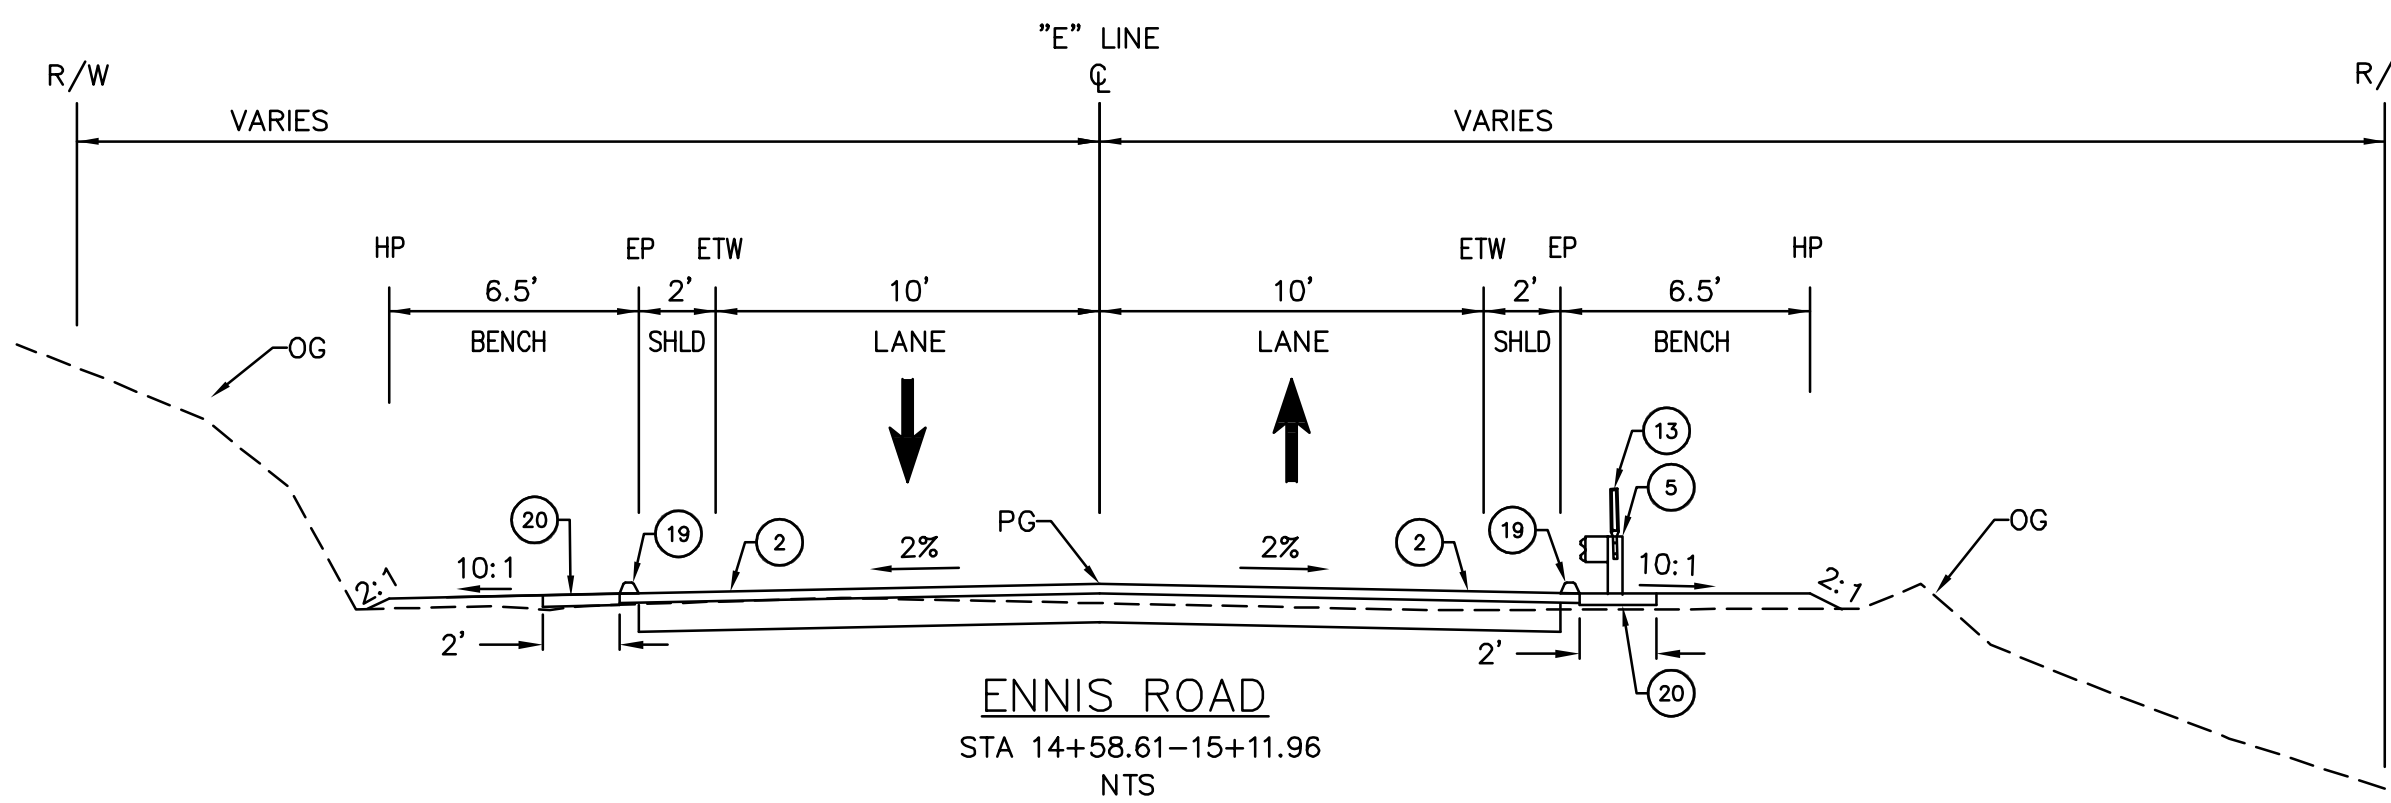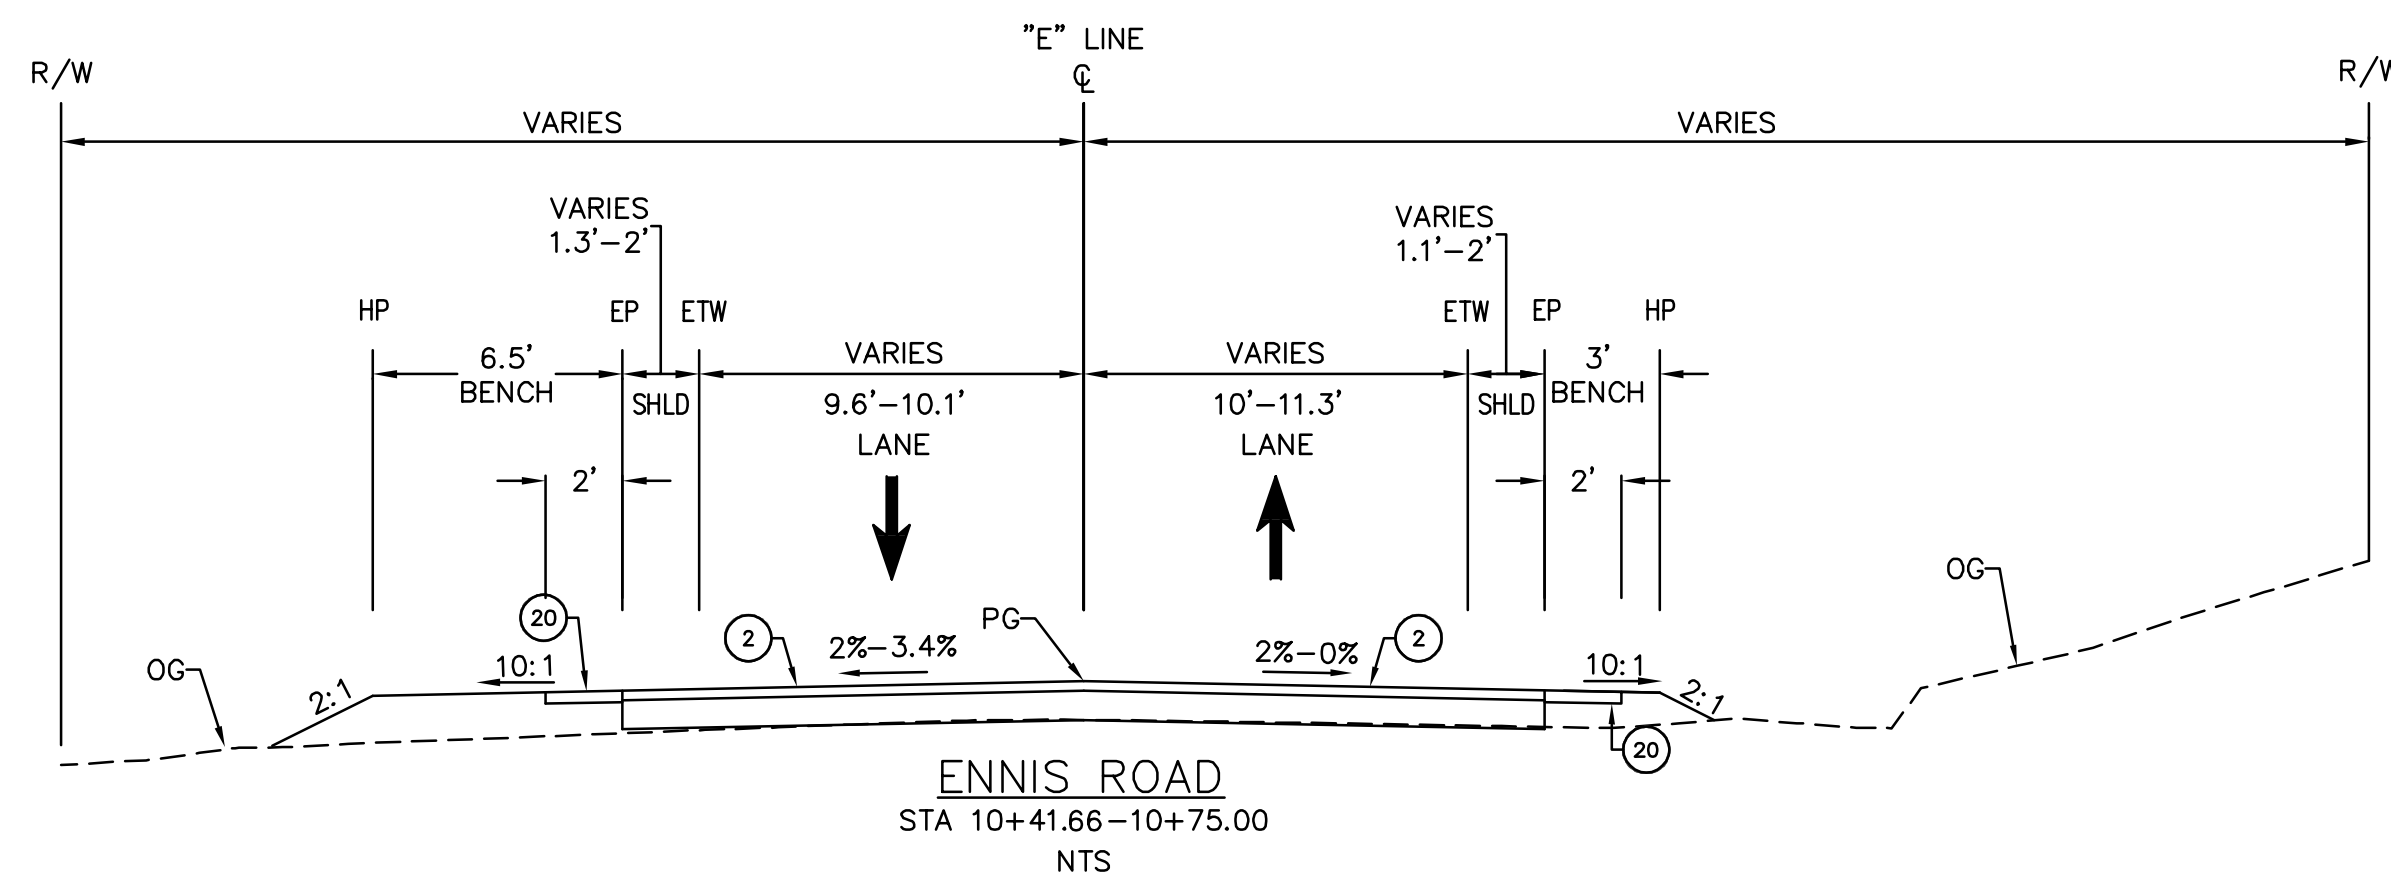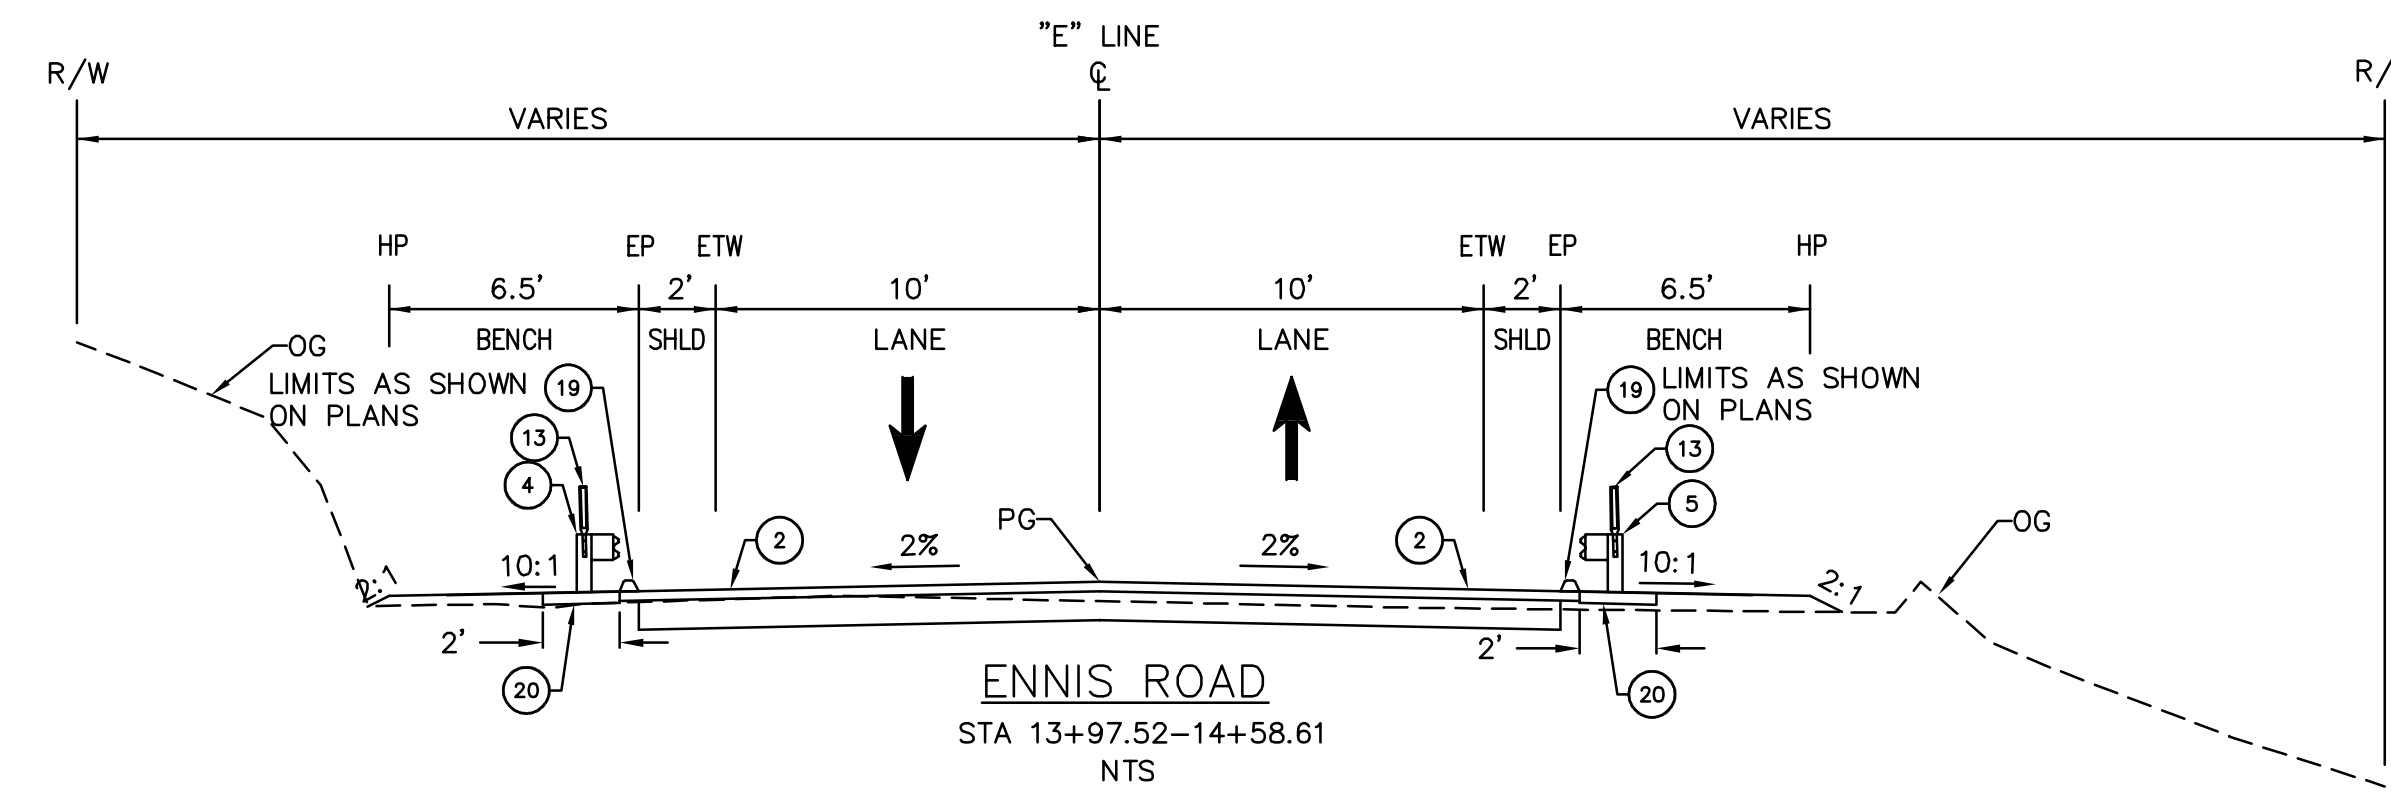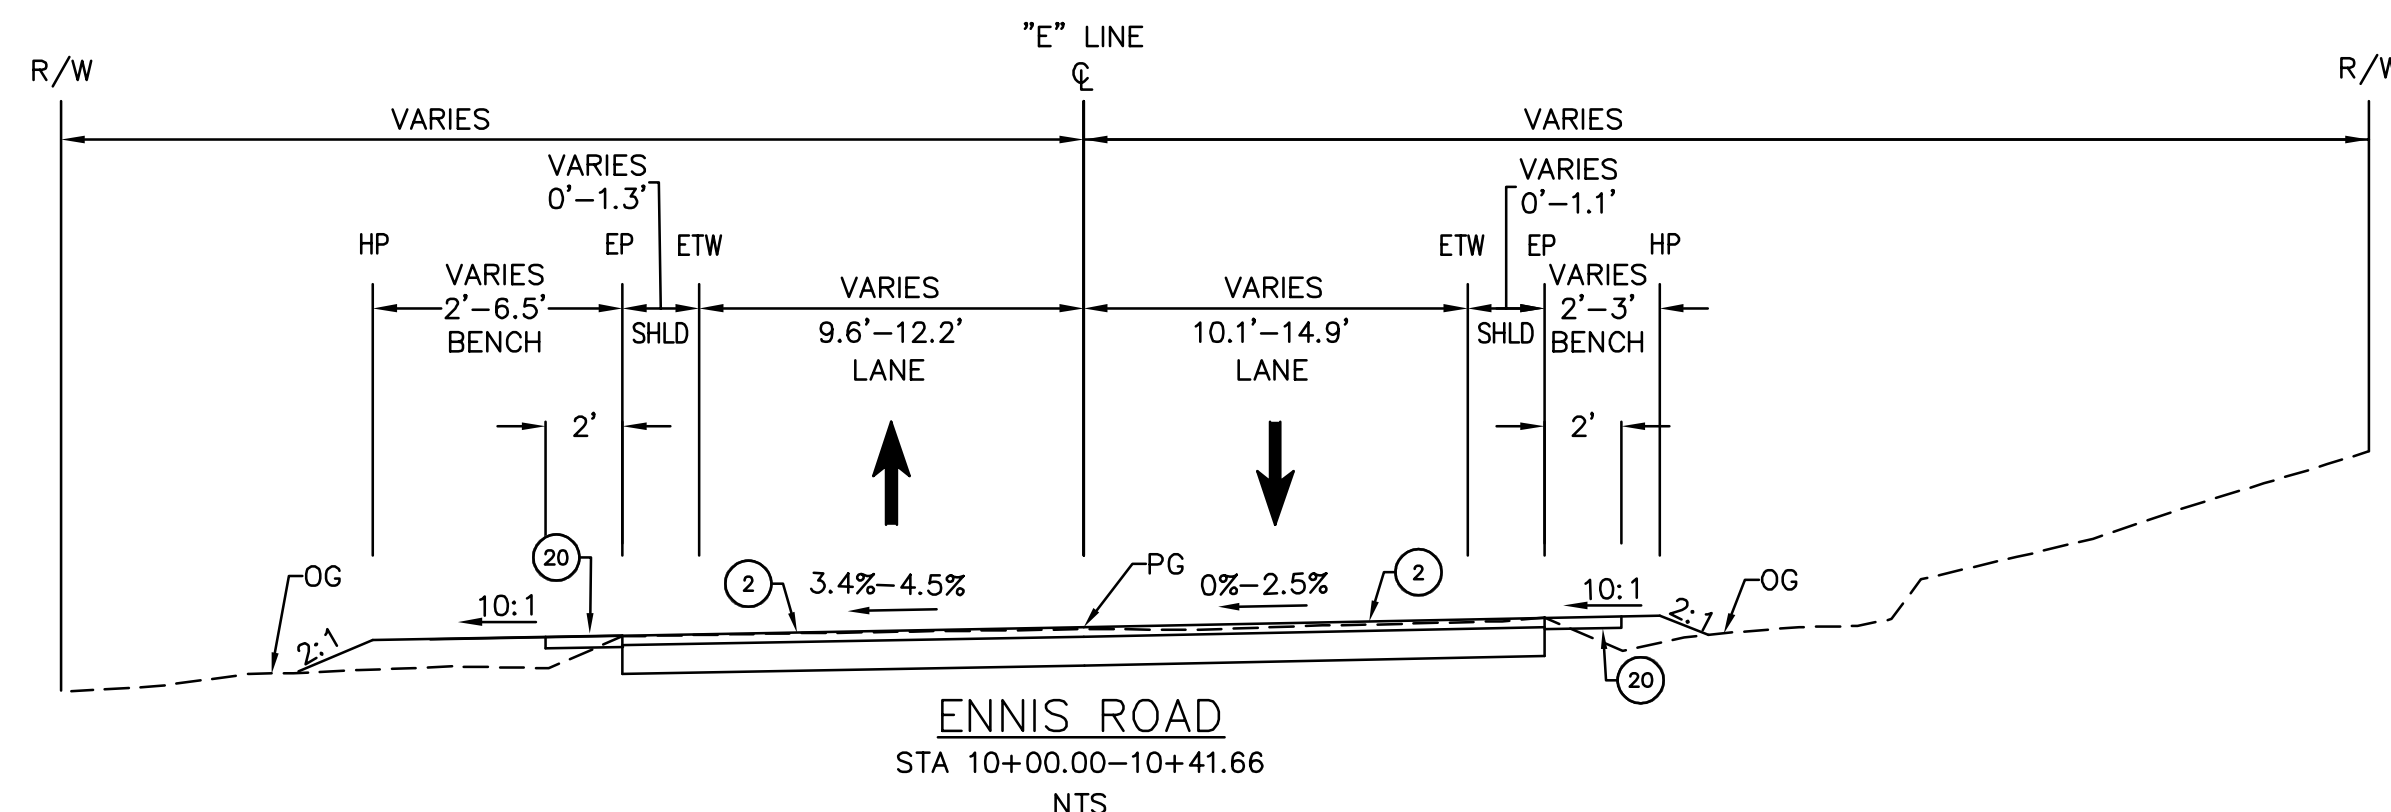

CONSTRUCTION NOTES:

- 2 CONSTRUCT 3" HMA OVER 9" AB
- 4 CONSTRUCT GUARDRAIL SYSTEM STANDARD RAILING SECTION, PER CALTRANS RSP A77L1 WITH CALTRANS APPROVED 31" IN-LINE TERMINAL END TREATMENT, USING TYPE 12A LAYOUT PER CALTRANS RSP A77Q1
- 5 CONSTRUCT GUARDRAIL SYSTEM STANDARD RAILING SECTION, PER CALTRANS RSP A77L1 WITH CALTRANS APPROVED 31" IN-LINE TERMINAL END TREATMENT, USING TYPE 12AA LAYOUT PER CALTRANS RSP A77Q4
- 13 INSTALL MUTCD STANDARD TYPE E WHITE RETROREFLECTOR (2-SIDED) GUARDRAIL DELINEATOR; SPACING TO BE EVERY 20 FT
- 19 CONSTRUCT HOT MIX ASPHALT DIKE TYPE C PER CALTRANS STANDARD PLAN RSP A87B PER PLACEMENT AS INDICATED ON CALTRANS STANDARD PLAN A77N4
- 20 CONSTRUCT SHOULDER BACKING MATERIAL AT A DEPTH OF 0.30'




P:\ENGIN\20141070\_FRESNO-SAND\_CREEK\_BRIDGE\_ON\_ENNIS\_ROAD\ENG\SHEETS\X-1

X-1

DESIGNED: SA		DATE	3/12/2021	RECORD DRAWING		SCALE		<p><b>BKF</b> 4670 Willow Rd., Ste 250 Pleasanton, CA 94588 925.396.7700</p>	<p>GABRIELA AMPARO 78003 Exp 9-30-21 CIVIL STATE OF CALIFORNIA</p>	PROJECT		<p>DEPARTMENT OF PUBLIC WORKS AND PLANNING</p>
DRAWN: LS		DATE	3/12/2021	AS SHOWN		SAND CREEK BRIDGE REPLACEMENT ON ENNIS ROAD				TYPICAL SECTIONS		
CHECKED: SA		DATE	3/12/2021			ROAD NO. 2824-2825				DRAWING NO. 11257		
						BRIDGE NO. 42C0697, BRLO-5942(238)				SHEET NO. 4		
FOR RIGHT OF WAY DATA AND ACCURATE ACCESS DETERMINATION, SEE DOCUMENTS IN THE DEPARTMENT OF PUBLIC WORKS AND PLANNING.											TOTAL 31	

CONSTRUCTION NOTES:

- 2 CONSTRUCT 3" HMA OVER 9" AB
- 4 CONSTRUCT GUARDRAIL SYSTEM STANDARD RAILING SECTION, PER CALTRANS RSP A77L1 WITH CALTRANS APPROVED 31" IN-LINE TERMINAL END TREATMENT, USING TYPE 12A LAYOUT PER CALTRANS RSP A77Q1
- 5 CONSTRUCT GUARDRAIL SYSTEM STANDARD RAILING SECTION, PER CALTRANS RSP A77L1 WITH CALTRANS APPROVED 31" IN-LINE TERMINAL END TREATMENT, USING TYPE 12AA LAYOUT PER CALTRANS RSP A77Q4
- 13 INSTALL MUTCD STANDARD TYPE E WHITE RETROREFLECTOR (2-SIDED) GUARDRAIL DELINEATOR; SPACING TO BE EVERY 20 FT
- 19 CONSTRUCT HOT MIX ASPHALT DIKE TYPE C PER CALTRANS STANDARD PLAN RSP A87B PER PLACEMENT AS INDICATED ON CALTRANS STANDARD PLAN A77N4
- 20 CONSTRUCT SHOULDER BACKING MATERIAL AT A DEPTH OF 0.30'

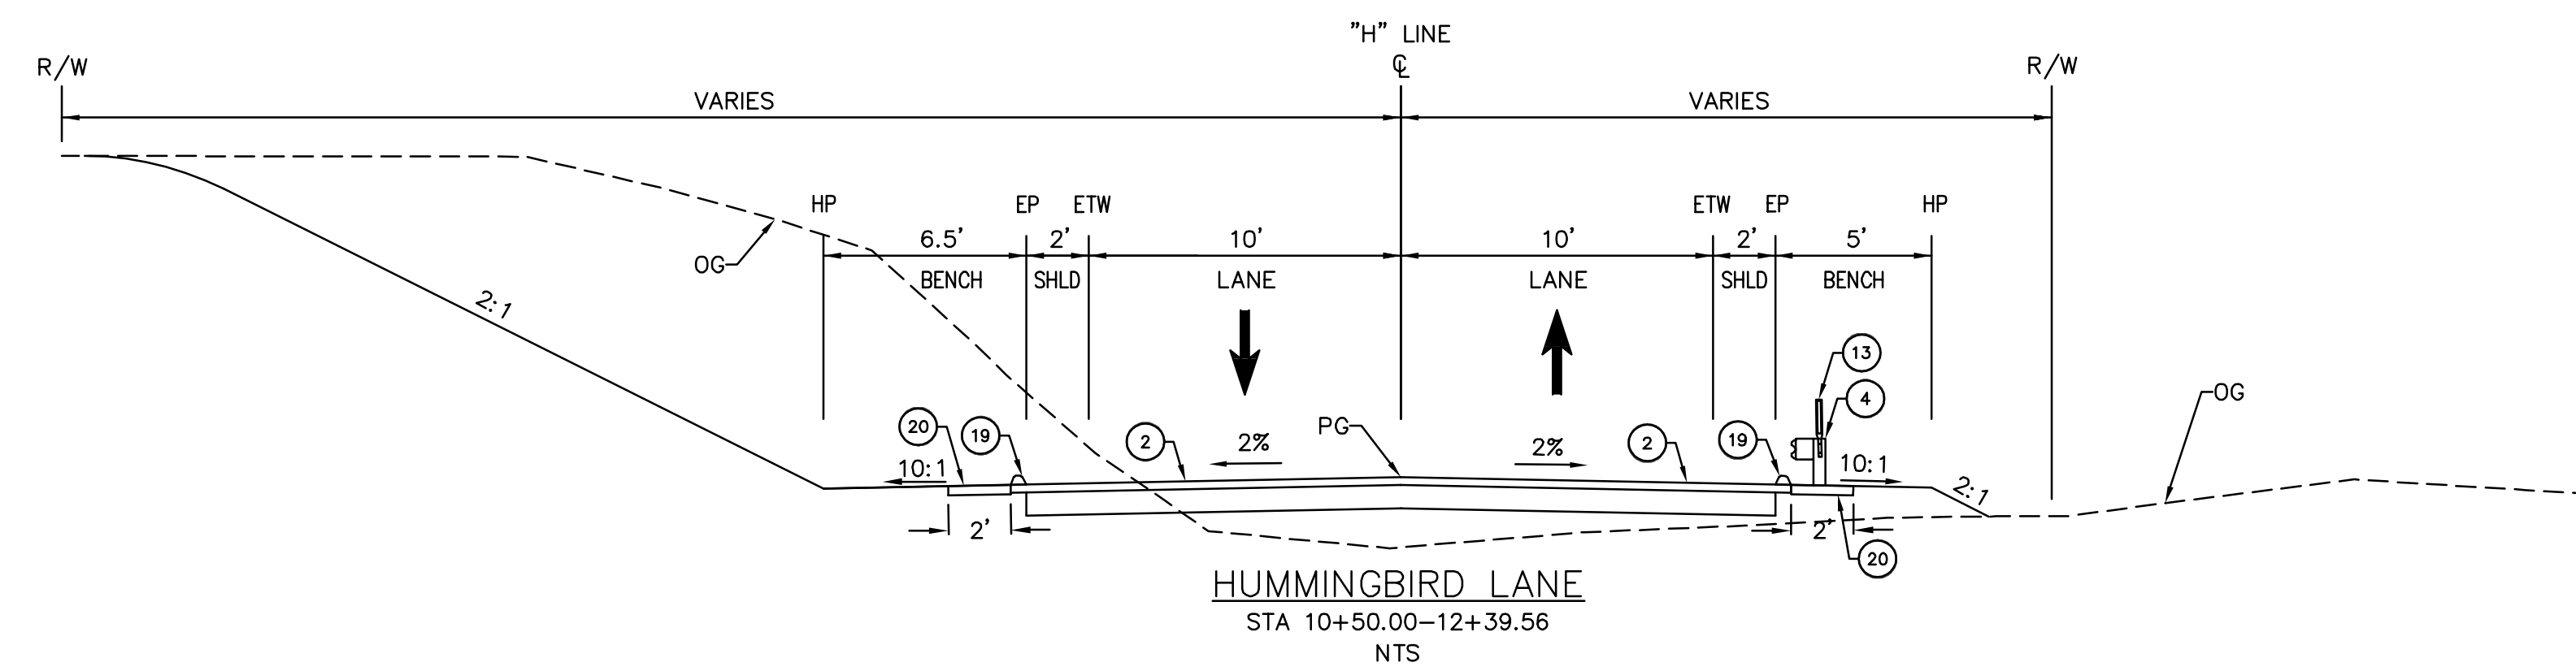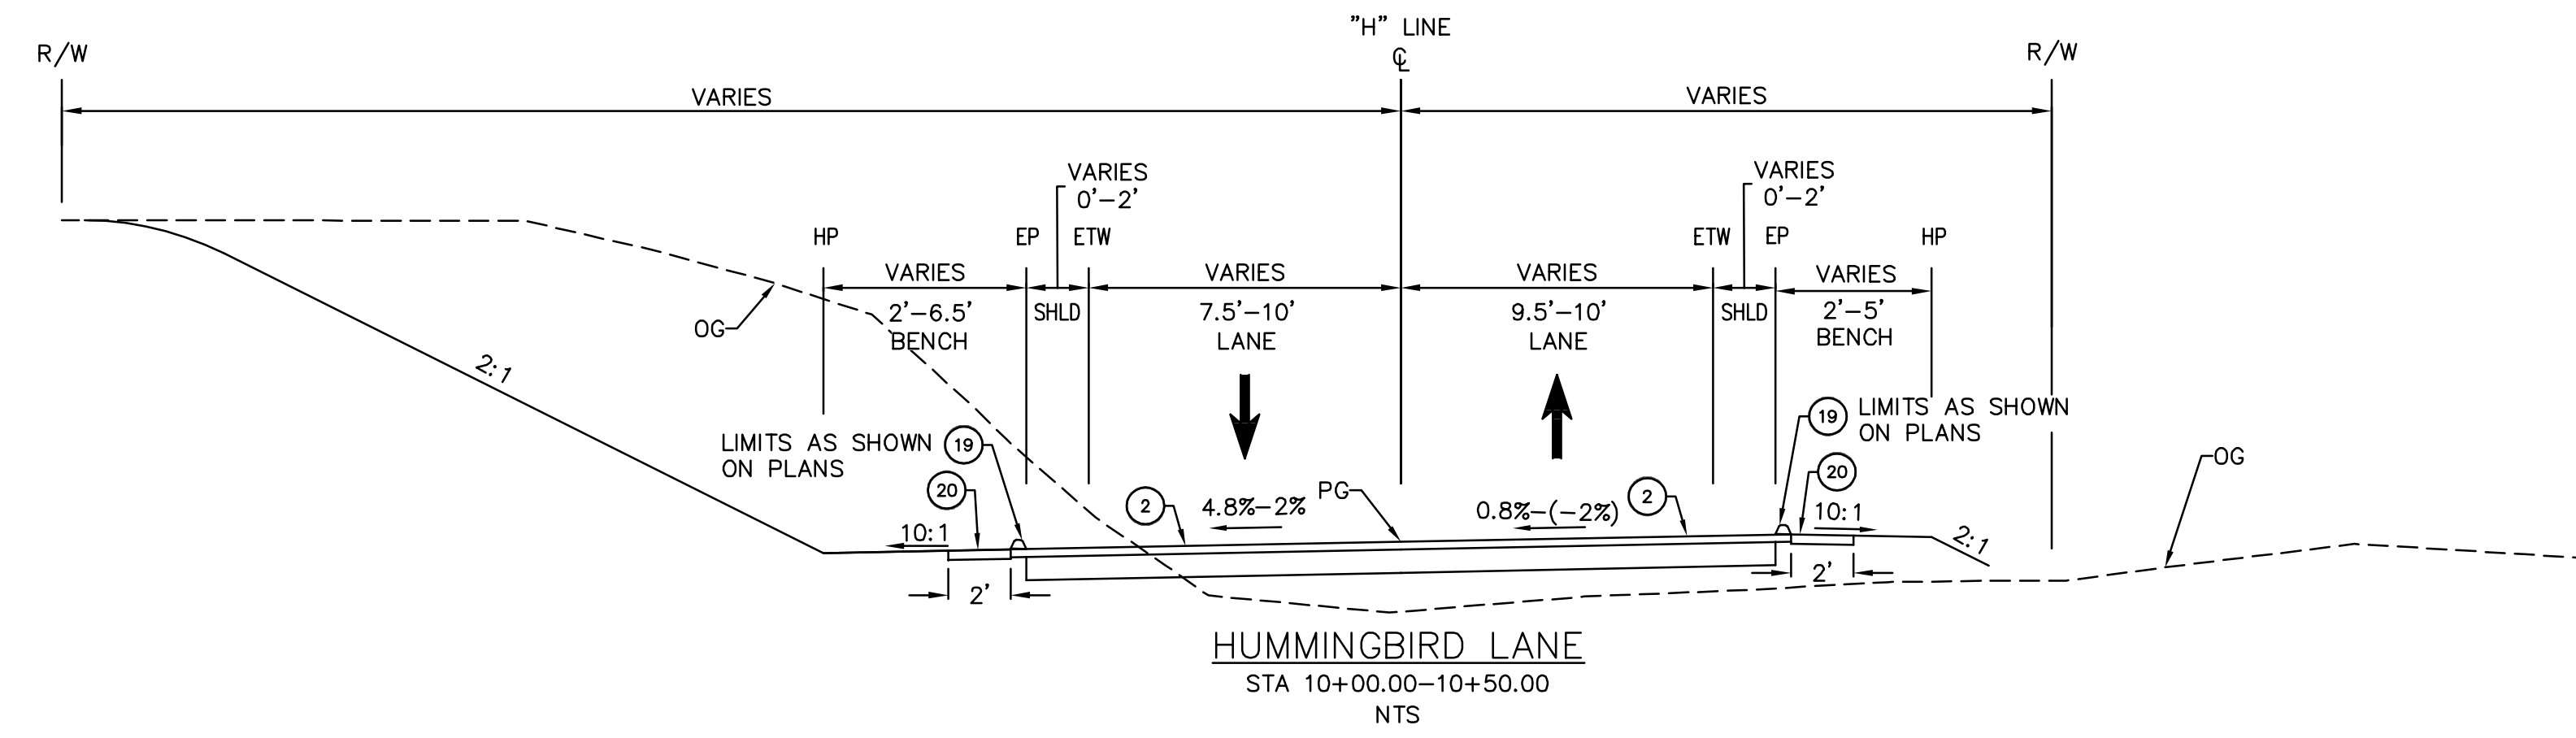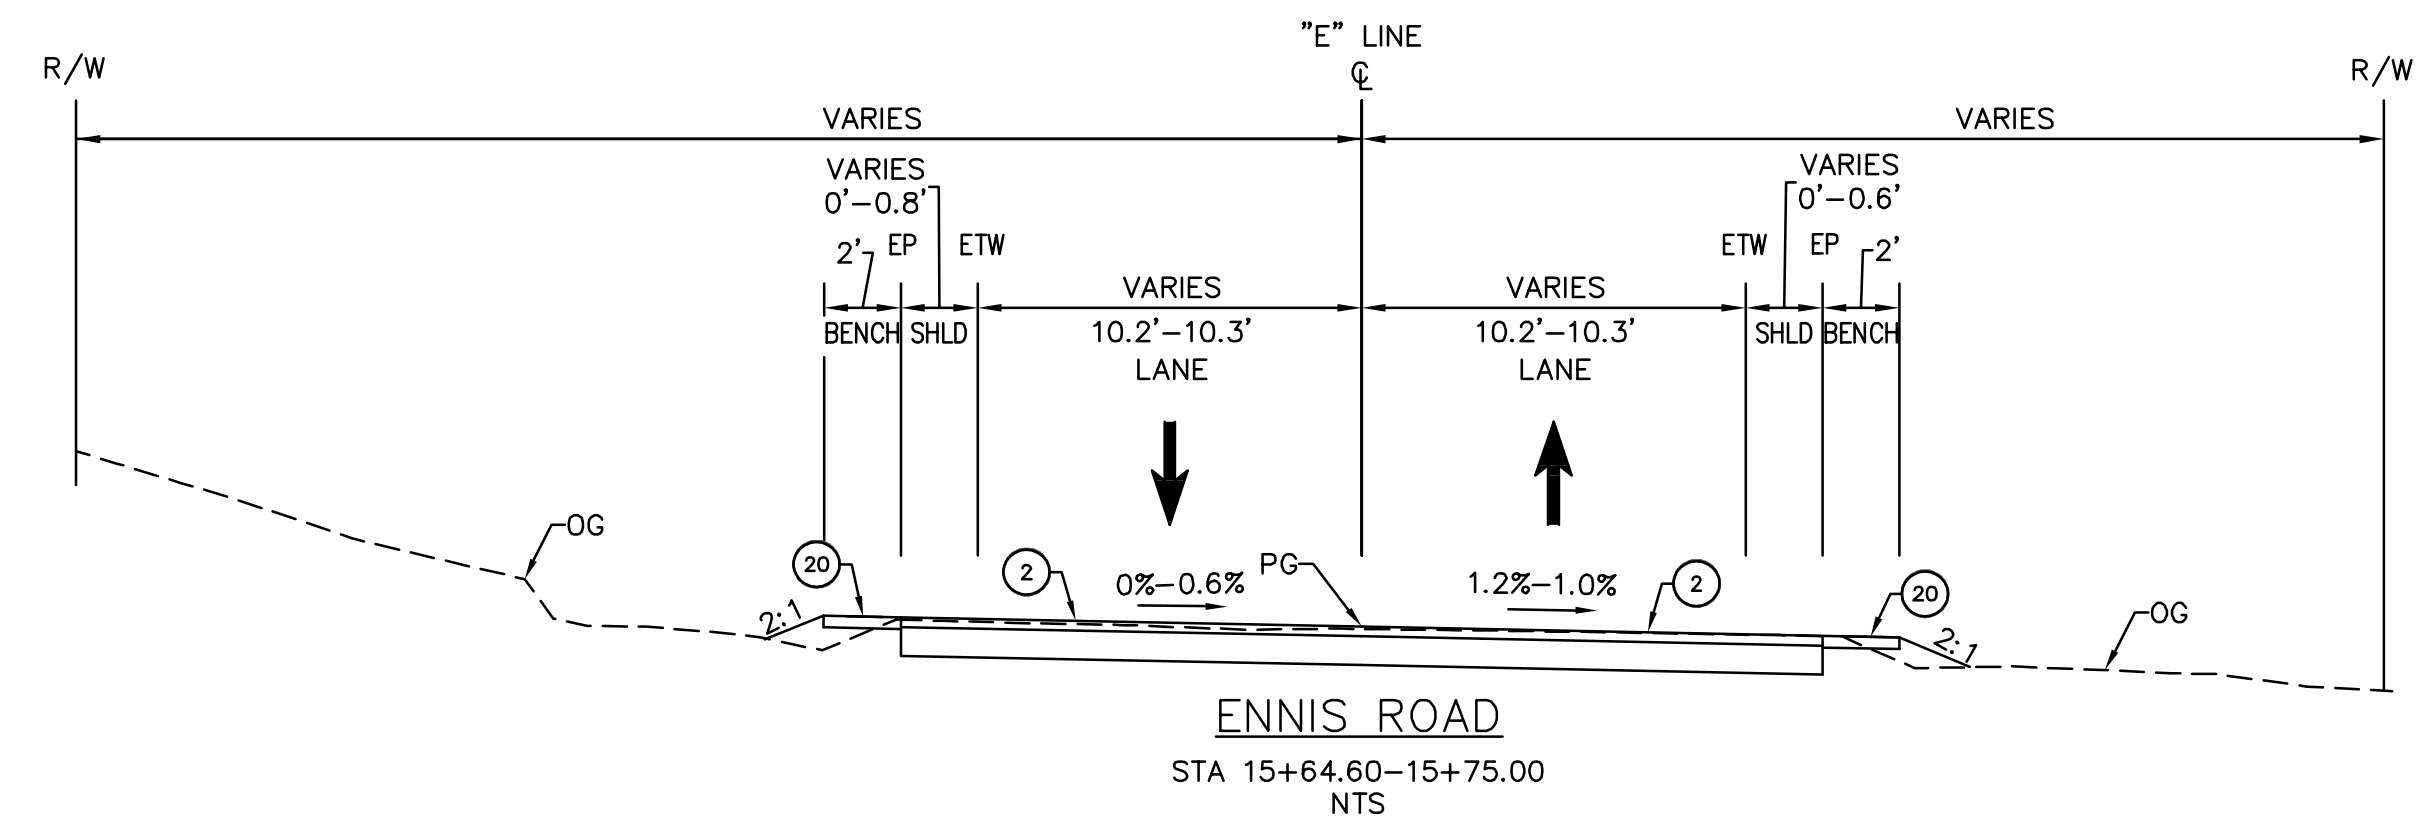

X-2

P:\ENG\4\20141070\_FRESNO-SAND\_CREEK\_BRIDGE\_ON\_ENNIS\_ROAD\ENG\_SHEETS\X-1

DESIGNED:	DATE	RECORD DRAWING	SCALE
SA	3/12/2021	RESIDENT ENGINEER	AS SHOWN
DRAWN:	DATE		
LS	3/12/2021		
CHECKED:	DATE		
SA	3/12/2021		




PROJECT
SAND CREEK BRIDGE REPLACEMENT ON ENNIS ROAD
ROAD NO. 2824-2825 BRIDGE NO. 42C0697, BRLO-5942(238)



DEPARTMENT OF PUBLIC WORKS AND PLANNING
TYPICAL SECTION
DRAWING NO. 11257 SHEET NO. 5 TOTAL 31

FOR RIGHT OF WAY DATA AND ACCURATE ACCESS DETERMINATION, SEE DOCUMENTS IN THE DEPARTMENT OF PUBLIC WORKS AND PLANNING.

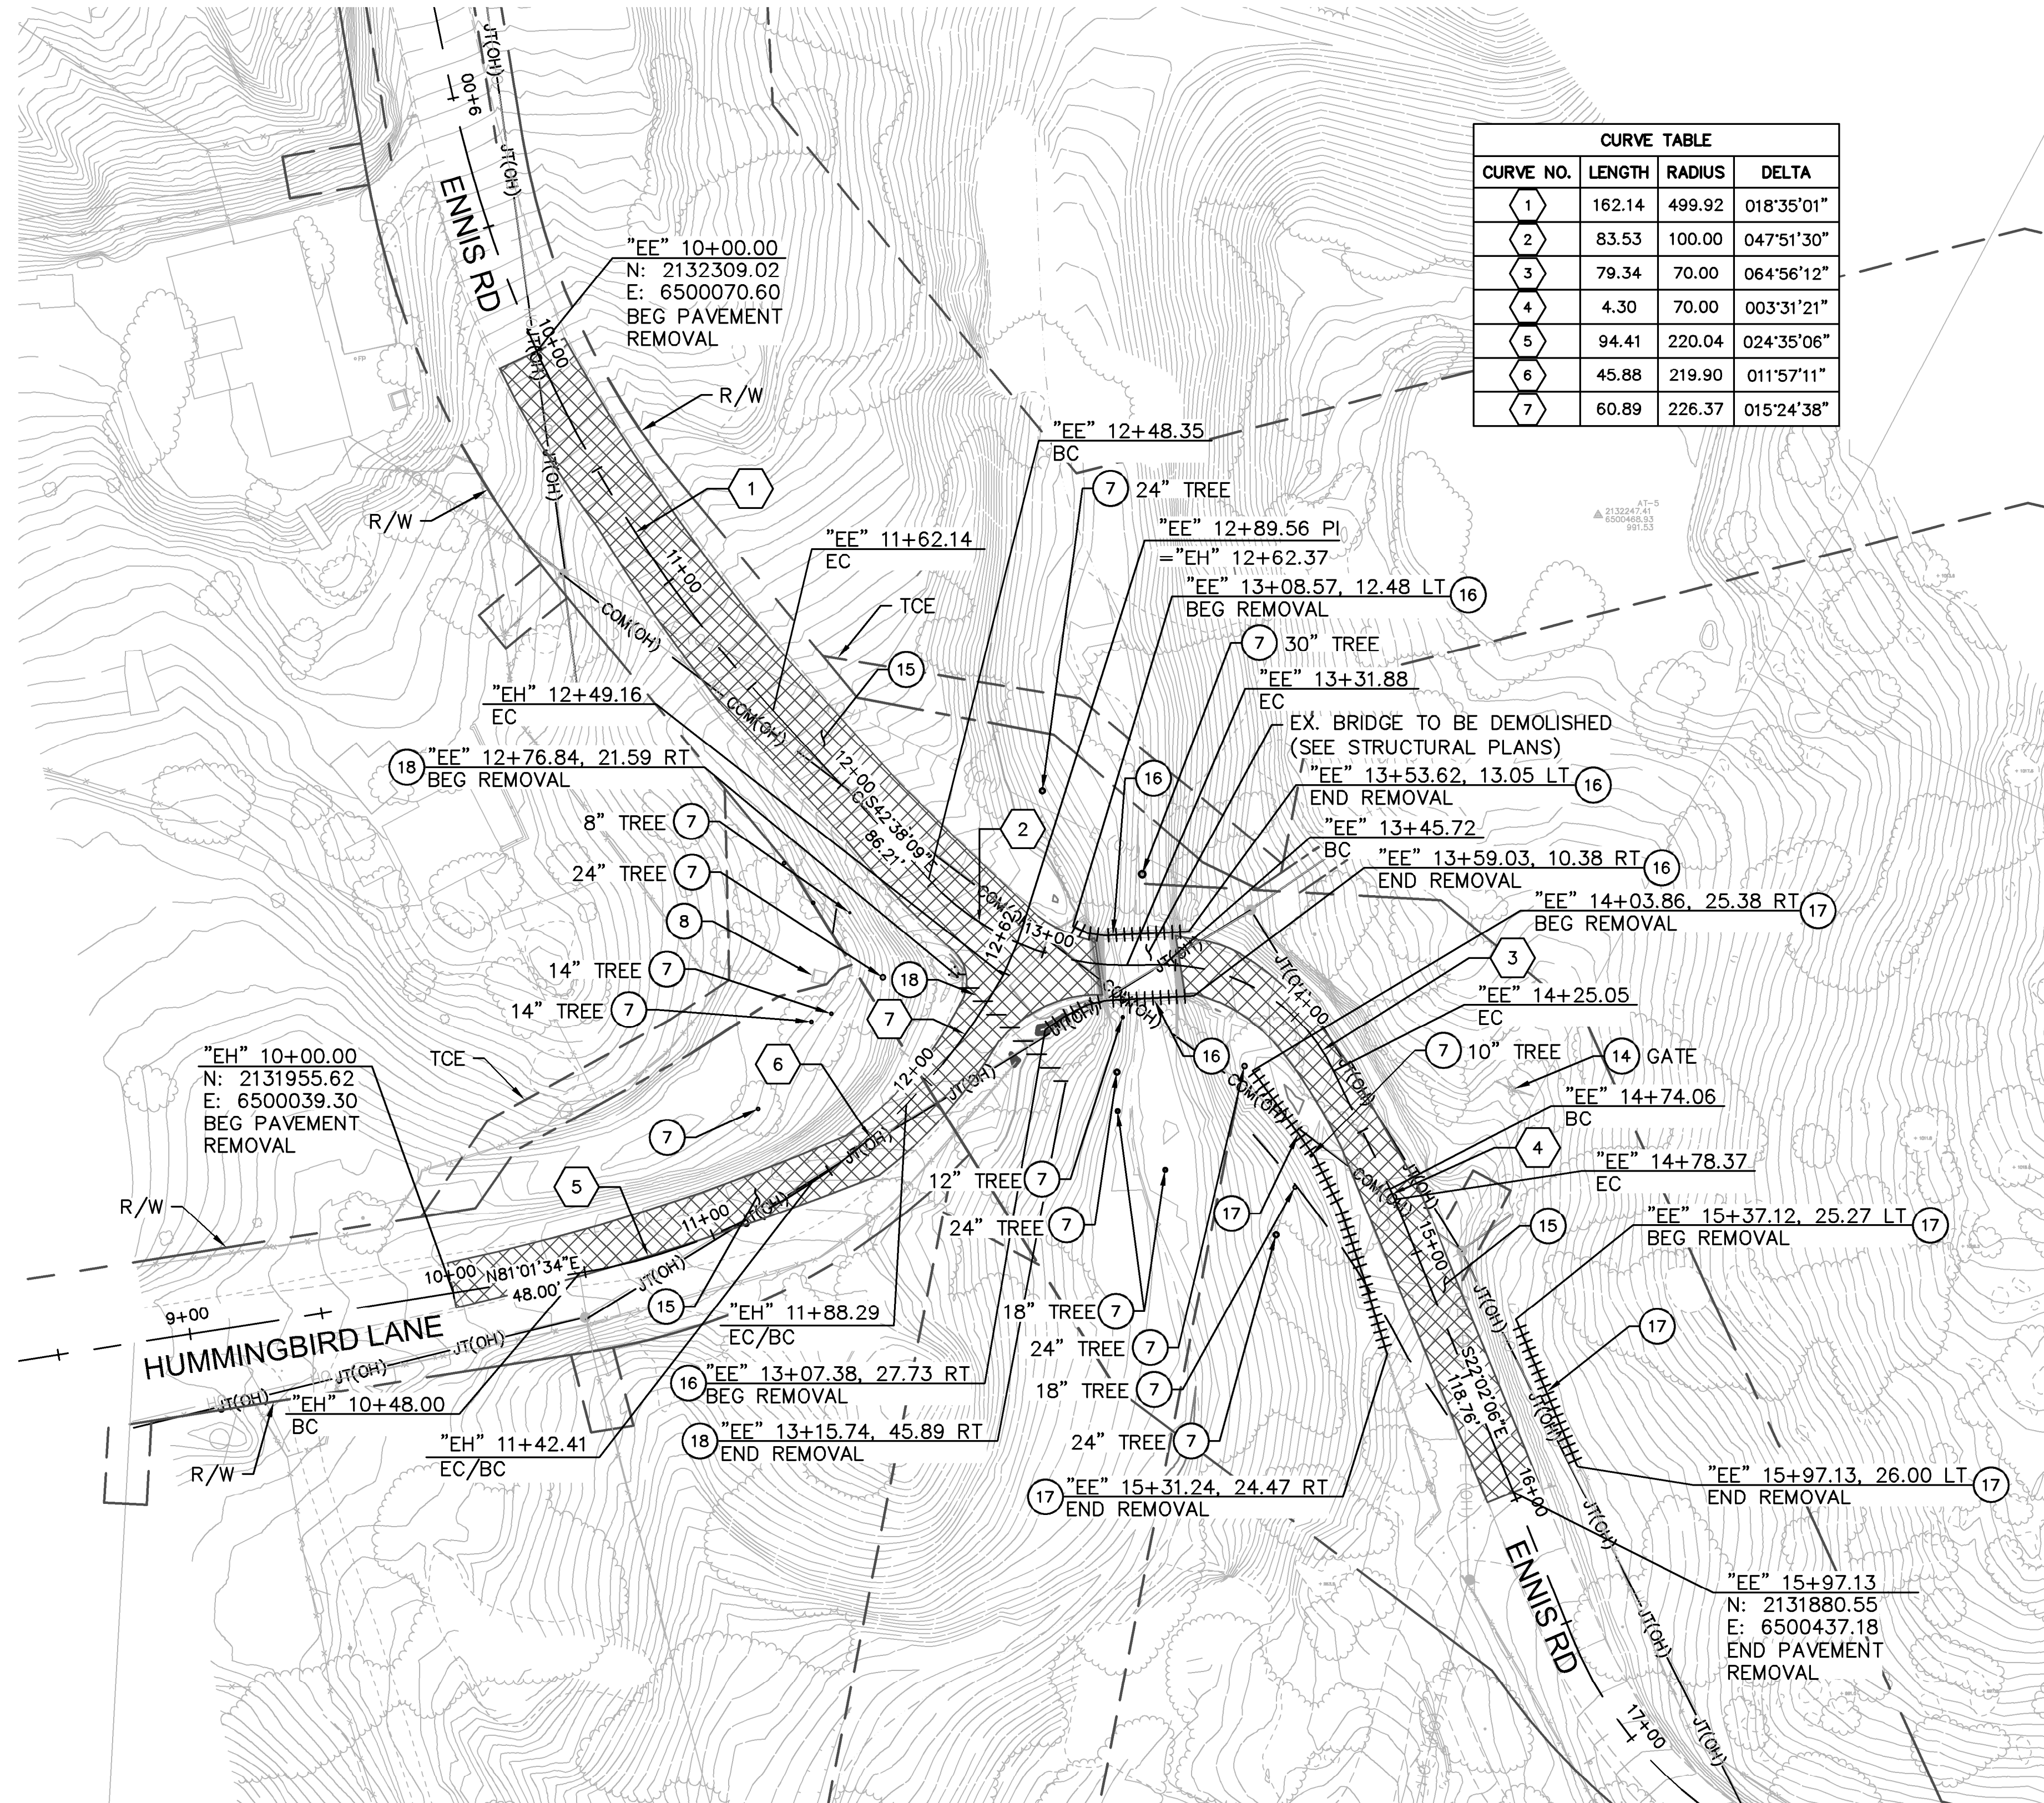


CURVE TABLE			
CURVE NO.	LENGTH	RADIUS	DELTA
1	162.14	499.92	018°35'01"
2	83.53	100.00	047°51'30"
3	79.34	70.00	064°56'12"
4	4.30	70.00	003°31'21"
5	94.41	220.04	024°35'06"
6	45.88	219.90	011°57'11"
7	60.89	226.37	015°24'38"

- CONSTRUCTION NOTES:**
- 7 REMOVE EXISTING TREE
  - 8 PROTECT IN PLACE SHED STRUCTURE
  - 14 PROTECT IN PLACE GATE
  - 15 REMOVE EXISTING ASPHALT CONCRETE PAVEMENT
  - 16 REMOVE EXISTING METAL BEAM GUARDRAIL
  - 17 REMOVE EXISTING WOOD POST AND WIRE FENCE
  - 18 REMOVE EXISTING 24" STORM DRAIN PIPE

- LEGEND**
- OH EX. OVERHEAD ELECTRICAL
  - OT EX. OVERHEAD TELECOMMUNICATIONS
  - ROW
  - - - TCE
  - (CIRCLE) EX. TREE
  - (CIRCLE WITH DOT) EX. UTILITY POLE
  - (HATCHED) EX. ASPHALT CONCRETE PAVEMENT REMOVAL
  - (DASHED) EX. FENCE REMOVAL
  - (DIAGONAL) EX. STORM DRAIN REMOVAL


- NOTES:**
- FOR BRIDGE DEMOLITION, SEE STRUCTURAL PLANS.
  - SEE PP SHEETS FOR EXISTING UTILITY DISPOSITIONS.
  - SEE SHEET SS-1 FOR EXISTING SIGNING REMOVAL AND IMPROVEMENTS.

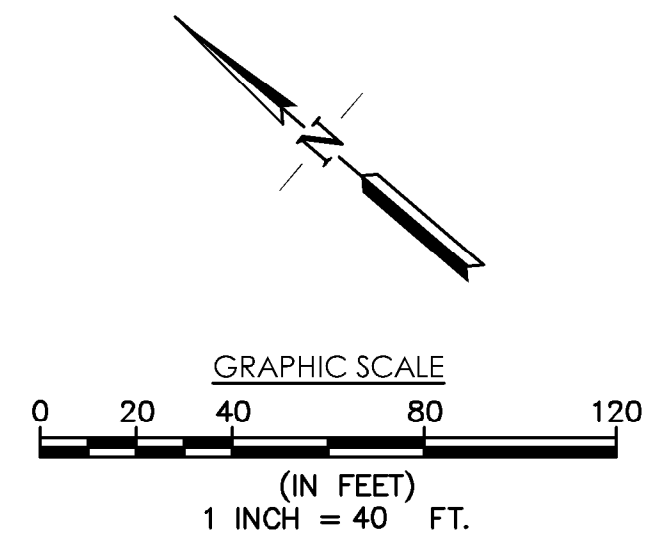

DM-1

DESIGNED: SA	DATE: 3/12/2021	RECORD DRAWING	SCALE: AS SHOWN	<p><b>BKF</b> 4670 Willow Rd., Ste 250 Fresno, CA 94388 925.396.7700</p>	PROJECT: SAND CREEK BRIDGE REPLACEMENT ON ENNIS ROAD	<p>DEPARTMENT OF PUBLIC WORKS AND PLANNING</p>	
DRAWN: LS	DATE: 3/12/2021	RESIDENT ENGINEER	DATE:		ROAD NO. 2824-2825		BRIDGE NO. 42C0697, BRLO-5942(238)
CHECKED: SA	DATE: 3/12/2021				DRAWING NO. 11257		SHEET NO. 6

FOR RIGHT OF WAY DATA AND ACCURATE ACCESS DETERMINATION, SEE DOCUMENTS IN THE DEPARTMENT OF PUBLIC WORKS AND PLANNING.

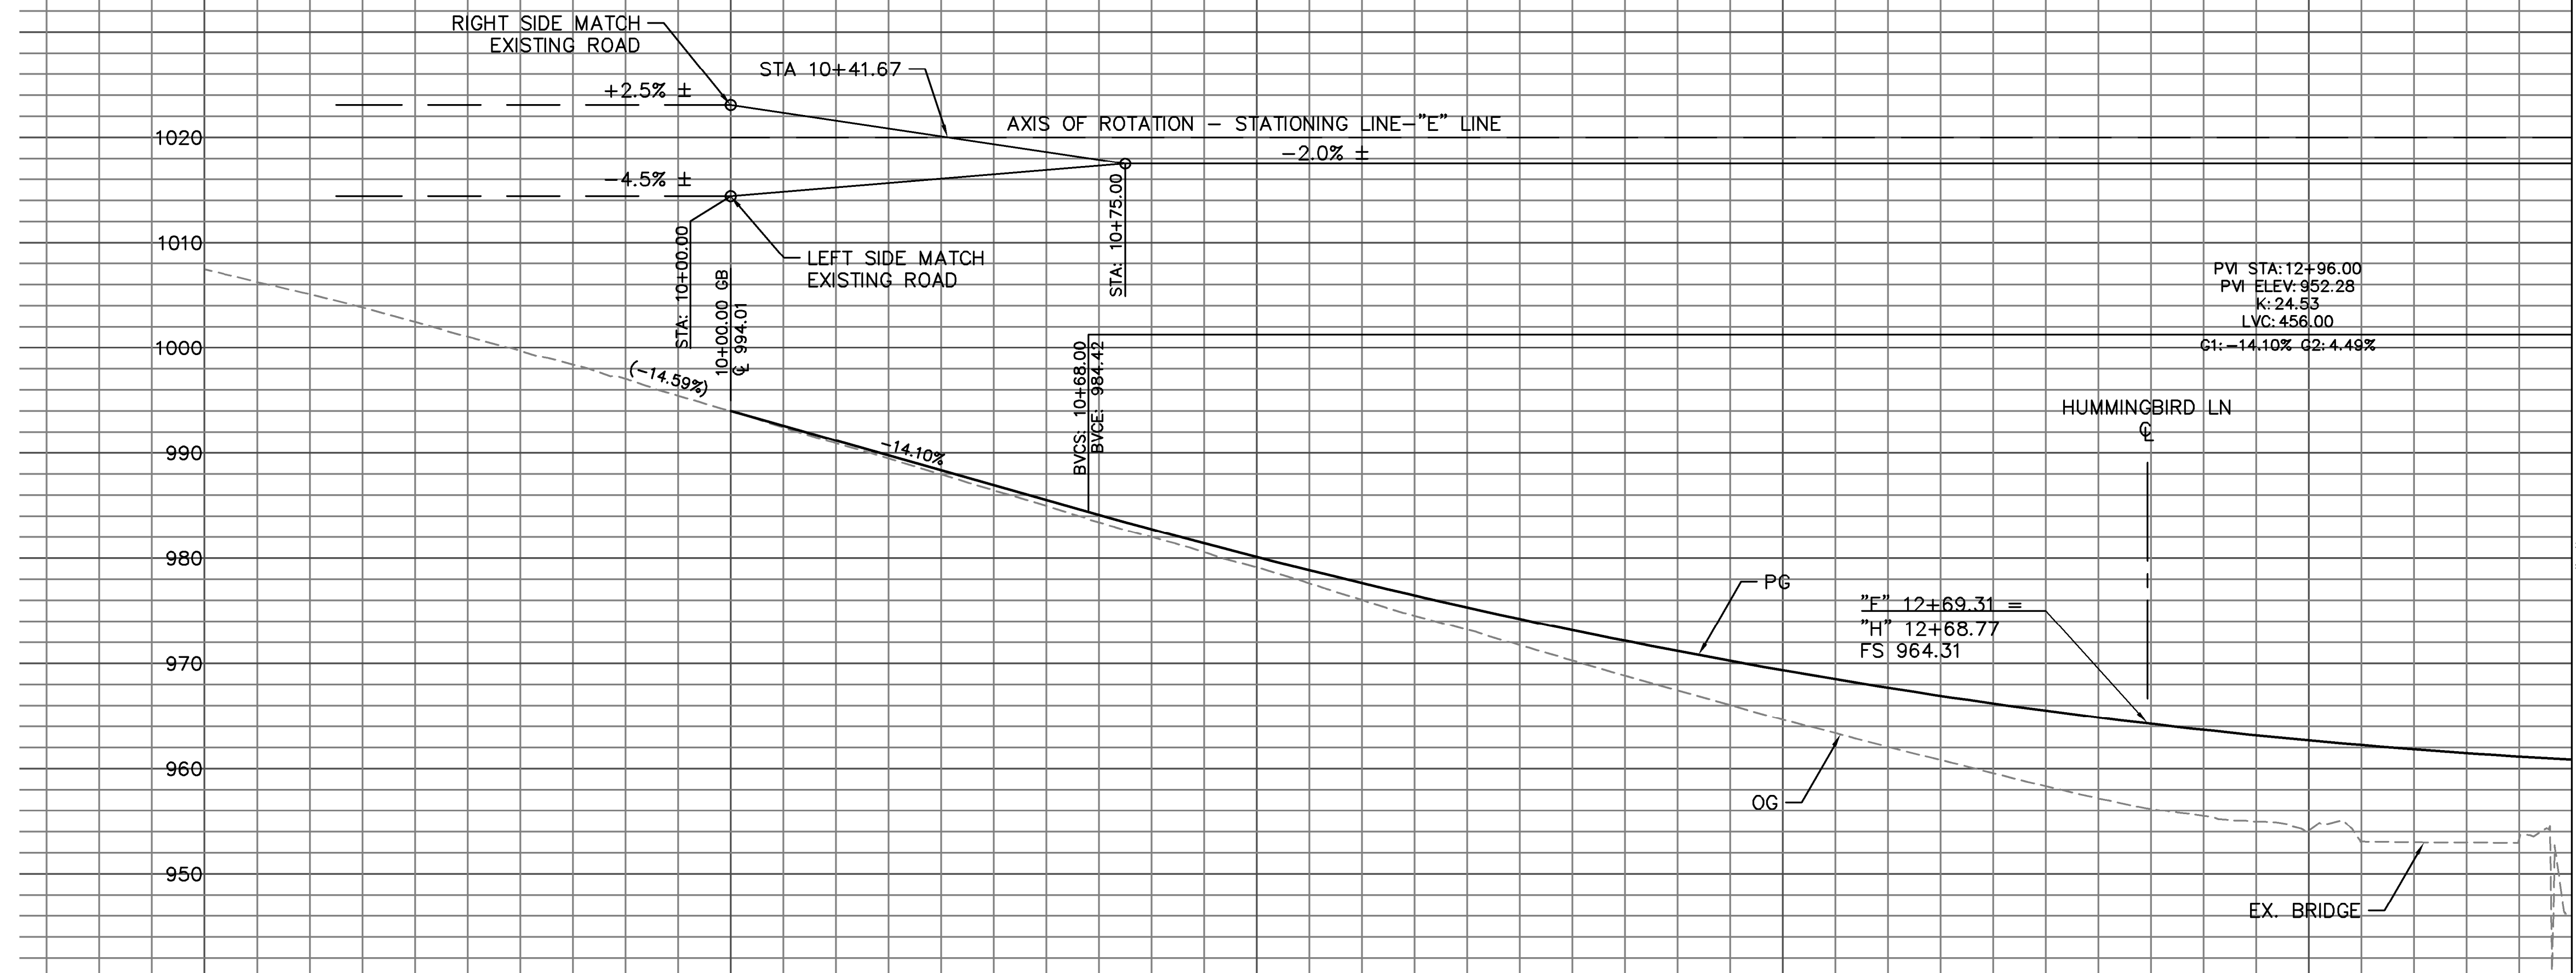

- CONSTRUCTION NOTES:**
- 1 PROTECT IN PLACE UTILITY POLE
  - 2 CONSTRUCT 3" HMA OVER 9" AB
  - 3 PROTECT IN PLACE OVERHEAD LINES
  - 4 CONSTRUCT GUARDRAIL SYSTEM STANDARD RAILING SECTION, PER CALTRANS RSP A77L1 WITH CALTRANS APPROVED 31" IN-LINE TERMINAL END TREATMENT, USING TYPE 12A LAYOUT PER CALTRANS RSP A77Q1
  - 5 CONSTRUCT GUARDRAIL SYSTEM STANDARD RAILING SECTION, PER CALTRANS RSP A77L1 WITH CALTRANS APPROVED 31" IN-LINE TERMINAL END TREATMENT, USING TYPE 12AA LAYOUT PER CALTRANS RSP A77Q4
  - 6 RELOCATE UTILITY POLE AND OVERHEAD LINE (BY OTHERS)
  - 9 INSTALL TRANSITIONAL RAILING TYPE WB-31 PER CALTRANS STD PLAN RSP A77U4
  - 13 INSTALL MUTCD STANDARD TYPE E WHITE RETROREFLECTOR (2-SIDED) GUARDRAIL DELINEATOR; SPACING TO BE EVERY 20 FT
  - 19 CONSTRUCT HOT MIX ASPHALT DIKE TYPE C PER CALTRANS STANDARD PLAN RSP A87B PER PLACEMENT AS INDICATED ON CALTRANS STANDARD PLAN A77N4
  - 21 CONCRETE BARRIER, SEE STRUCTURAL PLANS
  - 22 SAWCUT, MATCH EXISTING


**CURVE TABLE**

CURVE NO.	LENGTH	RADIUS	DELTA	TANGENT
1	48.27	33.00	083°48'38"	29.61
2	108.30	370.00	016°46'13"	54.54
3	223.14	410.00	031°10'58"	114.41
4	277.43	415.00	038°18'08"	144.12
5	54.88	33.00	095°16'50"	36.19


**LINE TABLE**

LINE NO.	LENGTH	DIRECTION
6	88.93	S12°23'03"E
7	23.19	S29°09'17"E

**PROFILE**  
SCALE: HORIZ 1"=20'  
VERT 1"=10'

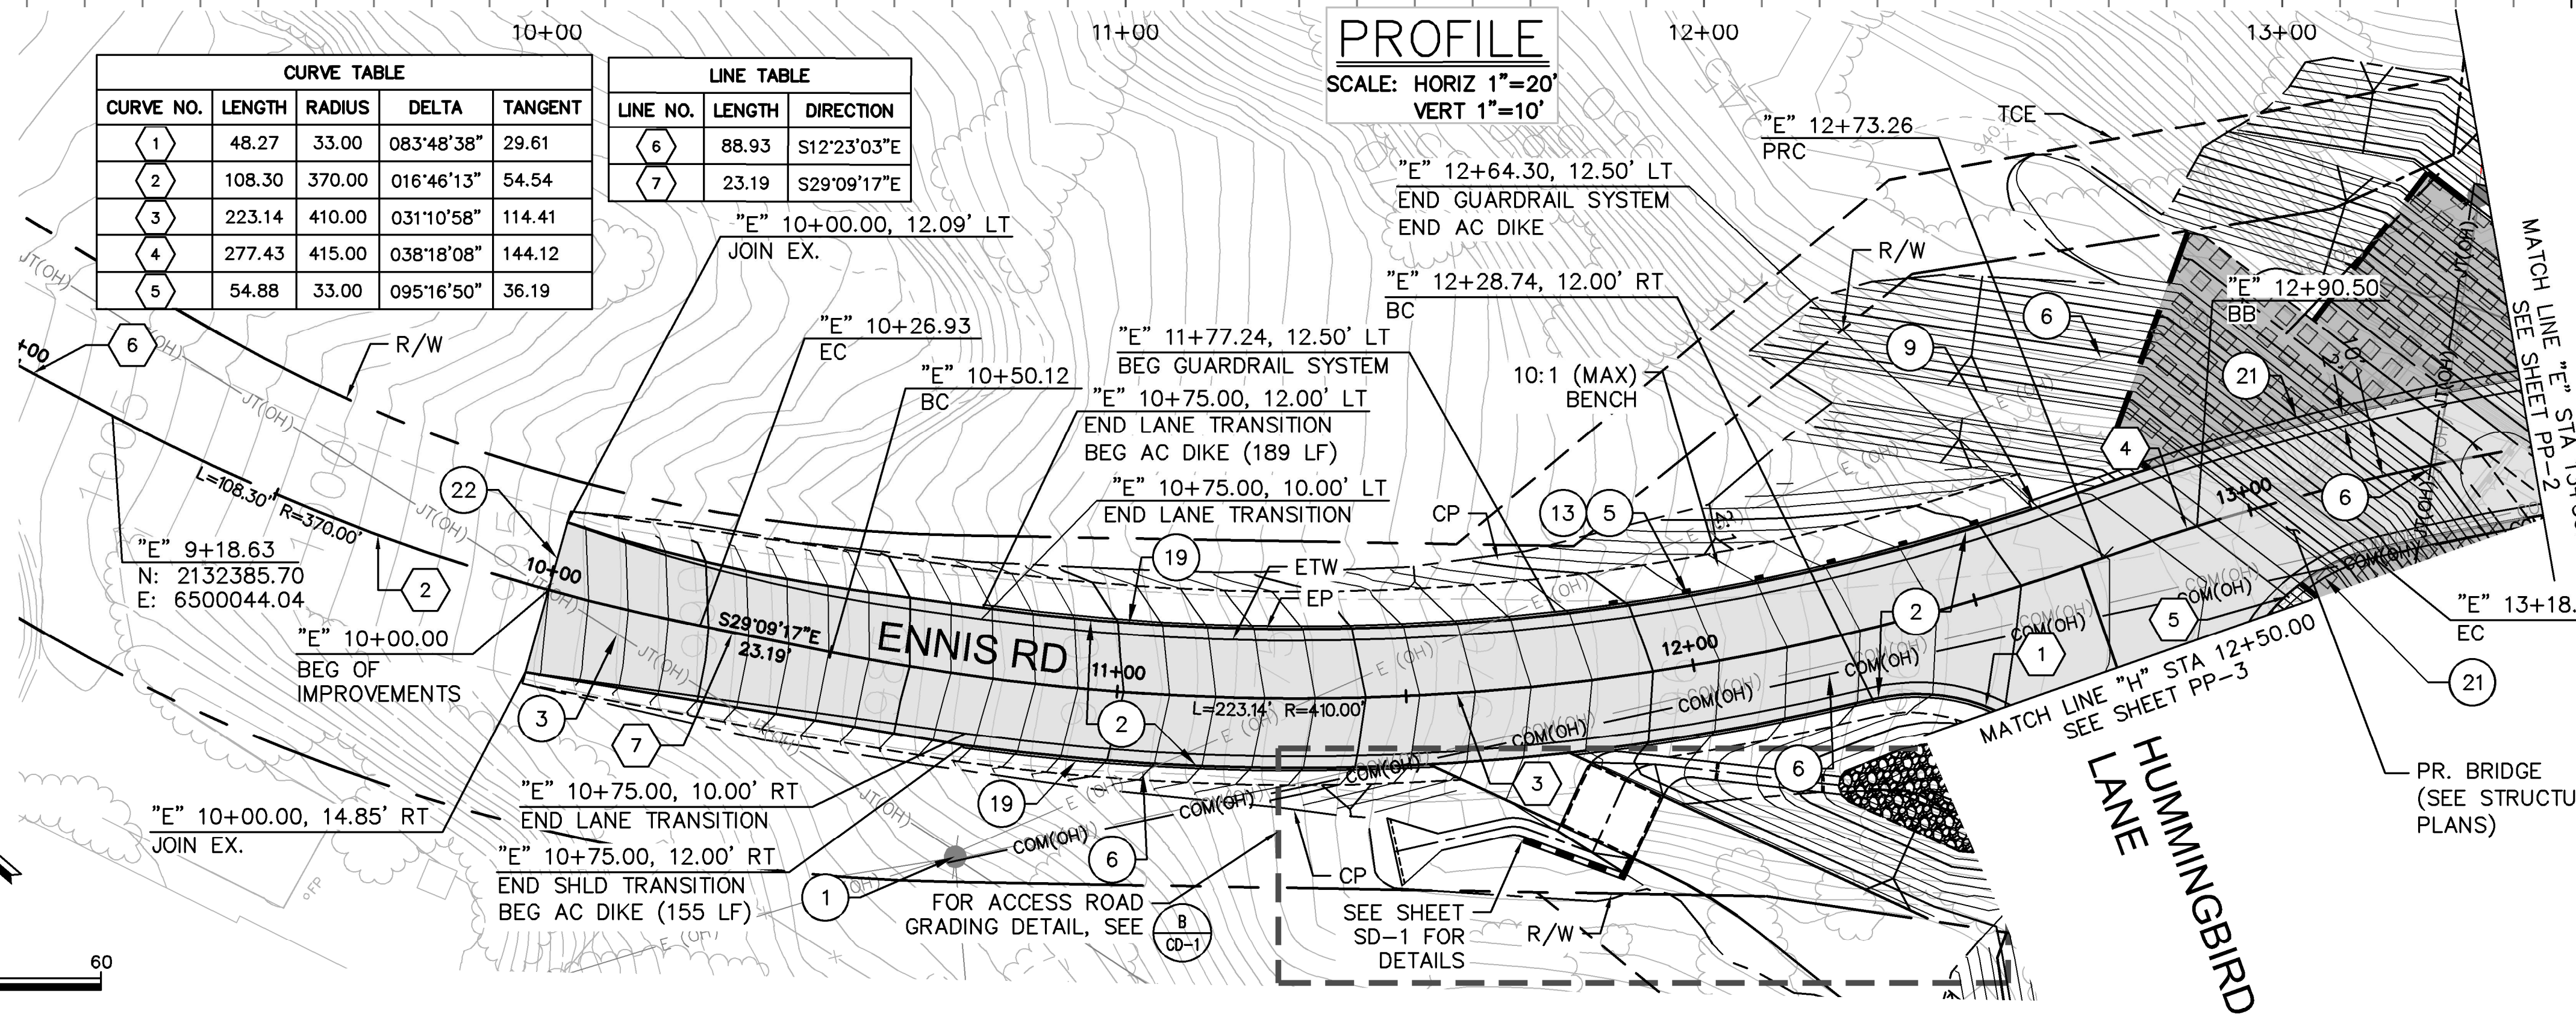

- LEGEND**
- EX. UTILITY POLE
  - E (OH) — EX. OVERHEAD ELECTRICAL
  - - - R/W
  - - - TCE
  - - - PR. DAYLIGHT
  - - - PR. BENCH
  - - - PR. MGS
  - - - PR. PAVEMENT
  - ▨ ACB SLOPE PROTECTION (SEE SHEET CD-02)

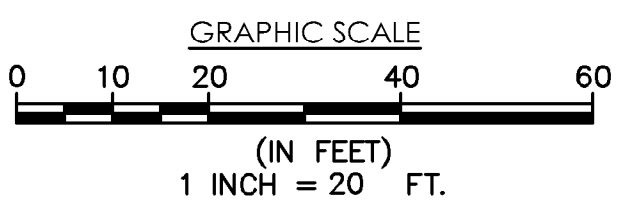


PP-1

DESIGNED: SA DRAWN: LS CHECKED: SA	DATE: 3/12/2021 DATE: 3/12/2021 DATE: 3/12/2021	<b>RECORD DRAWING</b> RESIDENT ENGINEER	<b>SCALE</b> AS SHOWN	 4670 Willow Rd., Ste 250 Pleasanton, CA 94588 925.396.7700	 REGISTERED PROFESSIONAL ENGINEER MICHELE ANAPARO 78003 Exp 9-30-21 CIVIL STATE OF CALIFORNIA	<b>PROJECT</b> SAND CREEK BRIDGE REPLACEMENT ON ENNIS ROAD ROAD NO. 2824-2825      BRIDGE NO. 42C0697, BRLO-5942(238)	 <b>DEPARTMENT OF PUBLIC WORKS AND PLANNING</b> PLAN AND PROFILE ENNIS ROAD STA 9+00.00-13+50.00 DRAWING NO. 11257      SHEET NO. 7      TOTAL 31
--	---	--	--------------------------	--	---	--	---


P:\ENG14\20141070\_FRESNO-SAND\_CREEK\_BRIDGE\_ON\_ENNIS\_ROAD\ENG\SHEETS\PP-1

FOR RIGHT OF WAY DATA AND ACCURATE ACCESS DETERMINATION, SEE DOCUMENTS IN THE DEPARTMENT OF PUBLIC WORKS AND PLANNING.

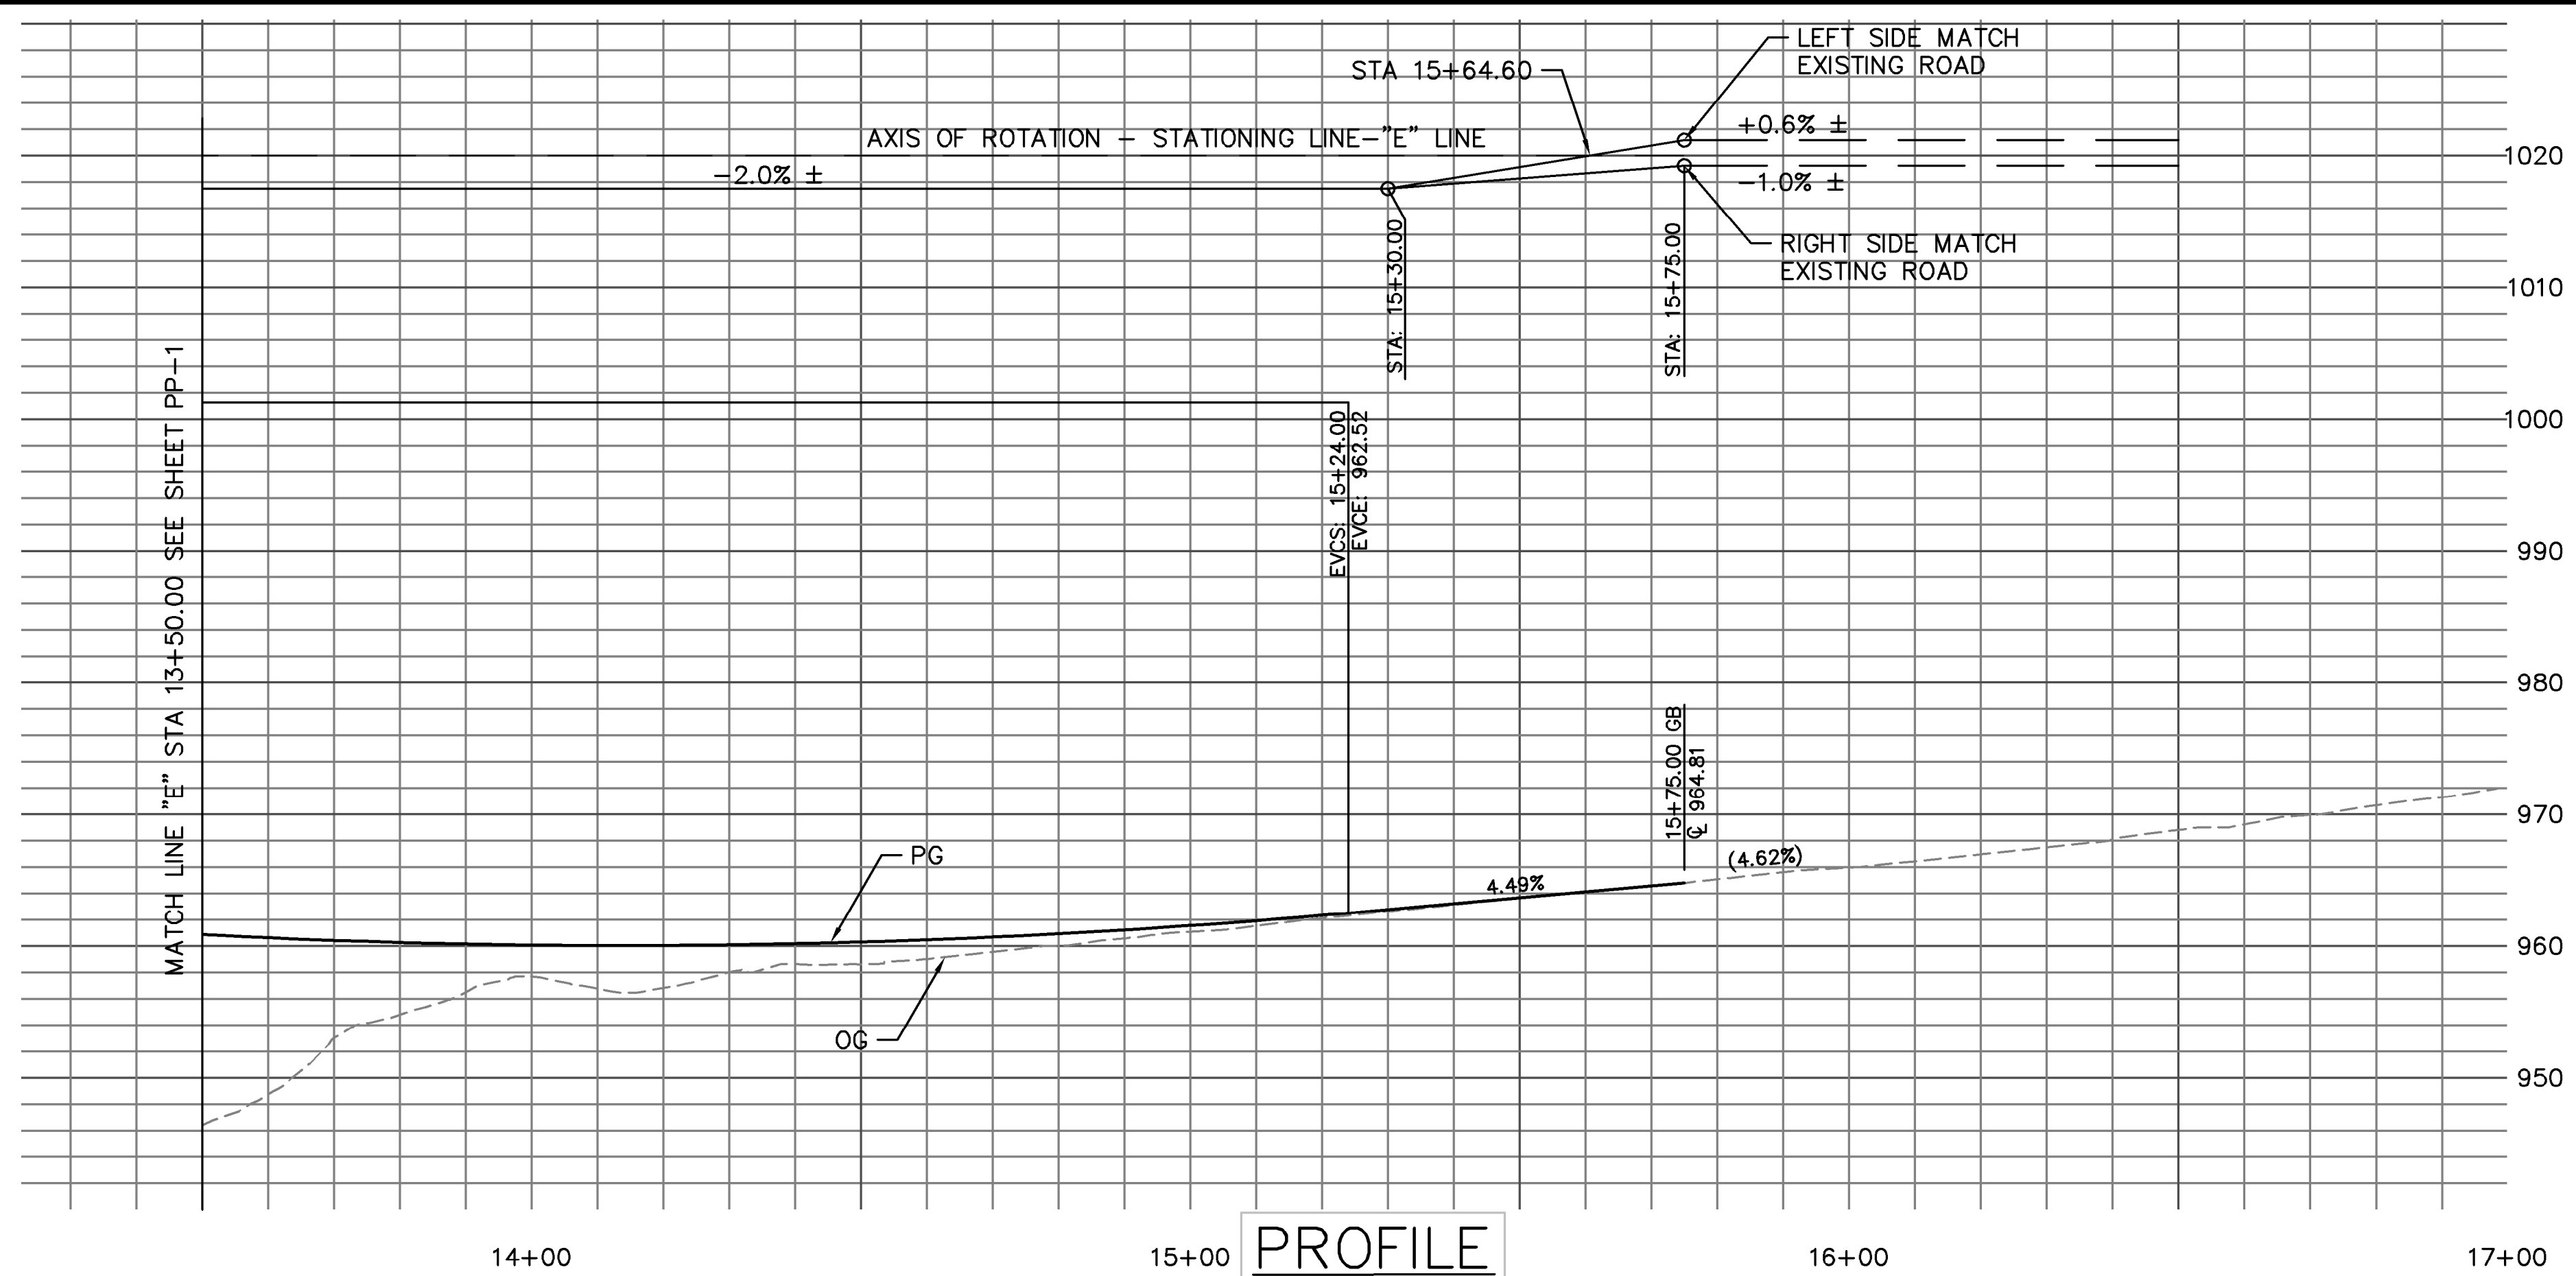

- CONSTRUCTION NOTES:**
- 1 PROTECT IN PLACE UTILITY POLE
  - 2 CONSTRUCT 3" HMA OVER 9" AB
  - 4 CONSTRUCT GUARDRAIL SYSTEM STANDARD RAILING SECTION, PER CALTRANS RSP A77L1 WITH CALTRANS APPROVED 31" IN-LINE TERMINAL END TREATMENT, USING TYPE 12A LAYOUT PER CALTRANS RSP A77Q1
  - 5 CONSTRUCT GUARDRAIL SYSTEM STANDARD RAILING SECTION, PER CALTRANS RSP A77L1 WITH CALTRANS APPROVED 31" IN-LINE TERMINAL END TREATMENT, USING TYPE 12AA LAYOUT PER CALTRANS RSP A77Q4
  - 6 RELOCATE UTILITY POLE AND OVERHEAD LINE (BY OTHERS)
  - 9 INSTALL TRANSITIONAL RAILING TYPE WB-31 PER CALTRANS STD PLAN RSP A77U4
  - 13 INSTALL MUTCD STANDARD TYPE E WHITE RETROREFLECTOR (2-SIDED) GUARDRAIL DELINEATOR; SPACING TO BE EVERY 20 FT
  - 19 CONSTRUCT HOT MIX ASPHALT DIKE TYPE C PER CALTRANS STANDARD PLAN RSP A87B PER PLACEMENT AS INDICATED ON CALTRANS STANDARD PLAN A77N4
  - 21 CONCRETE BARRIER, SEE STRUCTURAL PLANS
  - 22 SAWCUT, MATCH EXISTING
  - 23 INSTALL CLASS III RSP



**PROFILE**  
SCALE: HORIZ 1"=20'  
VERT 1"=10'

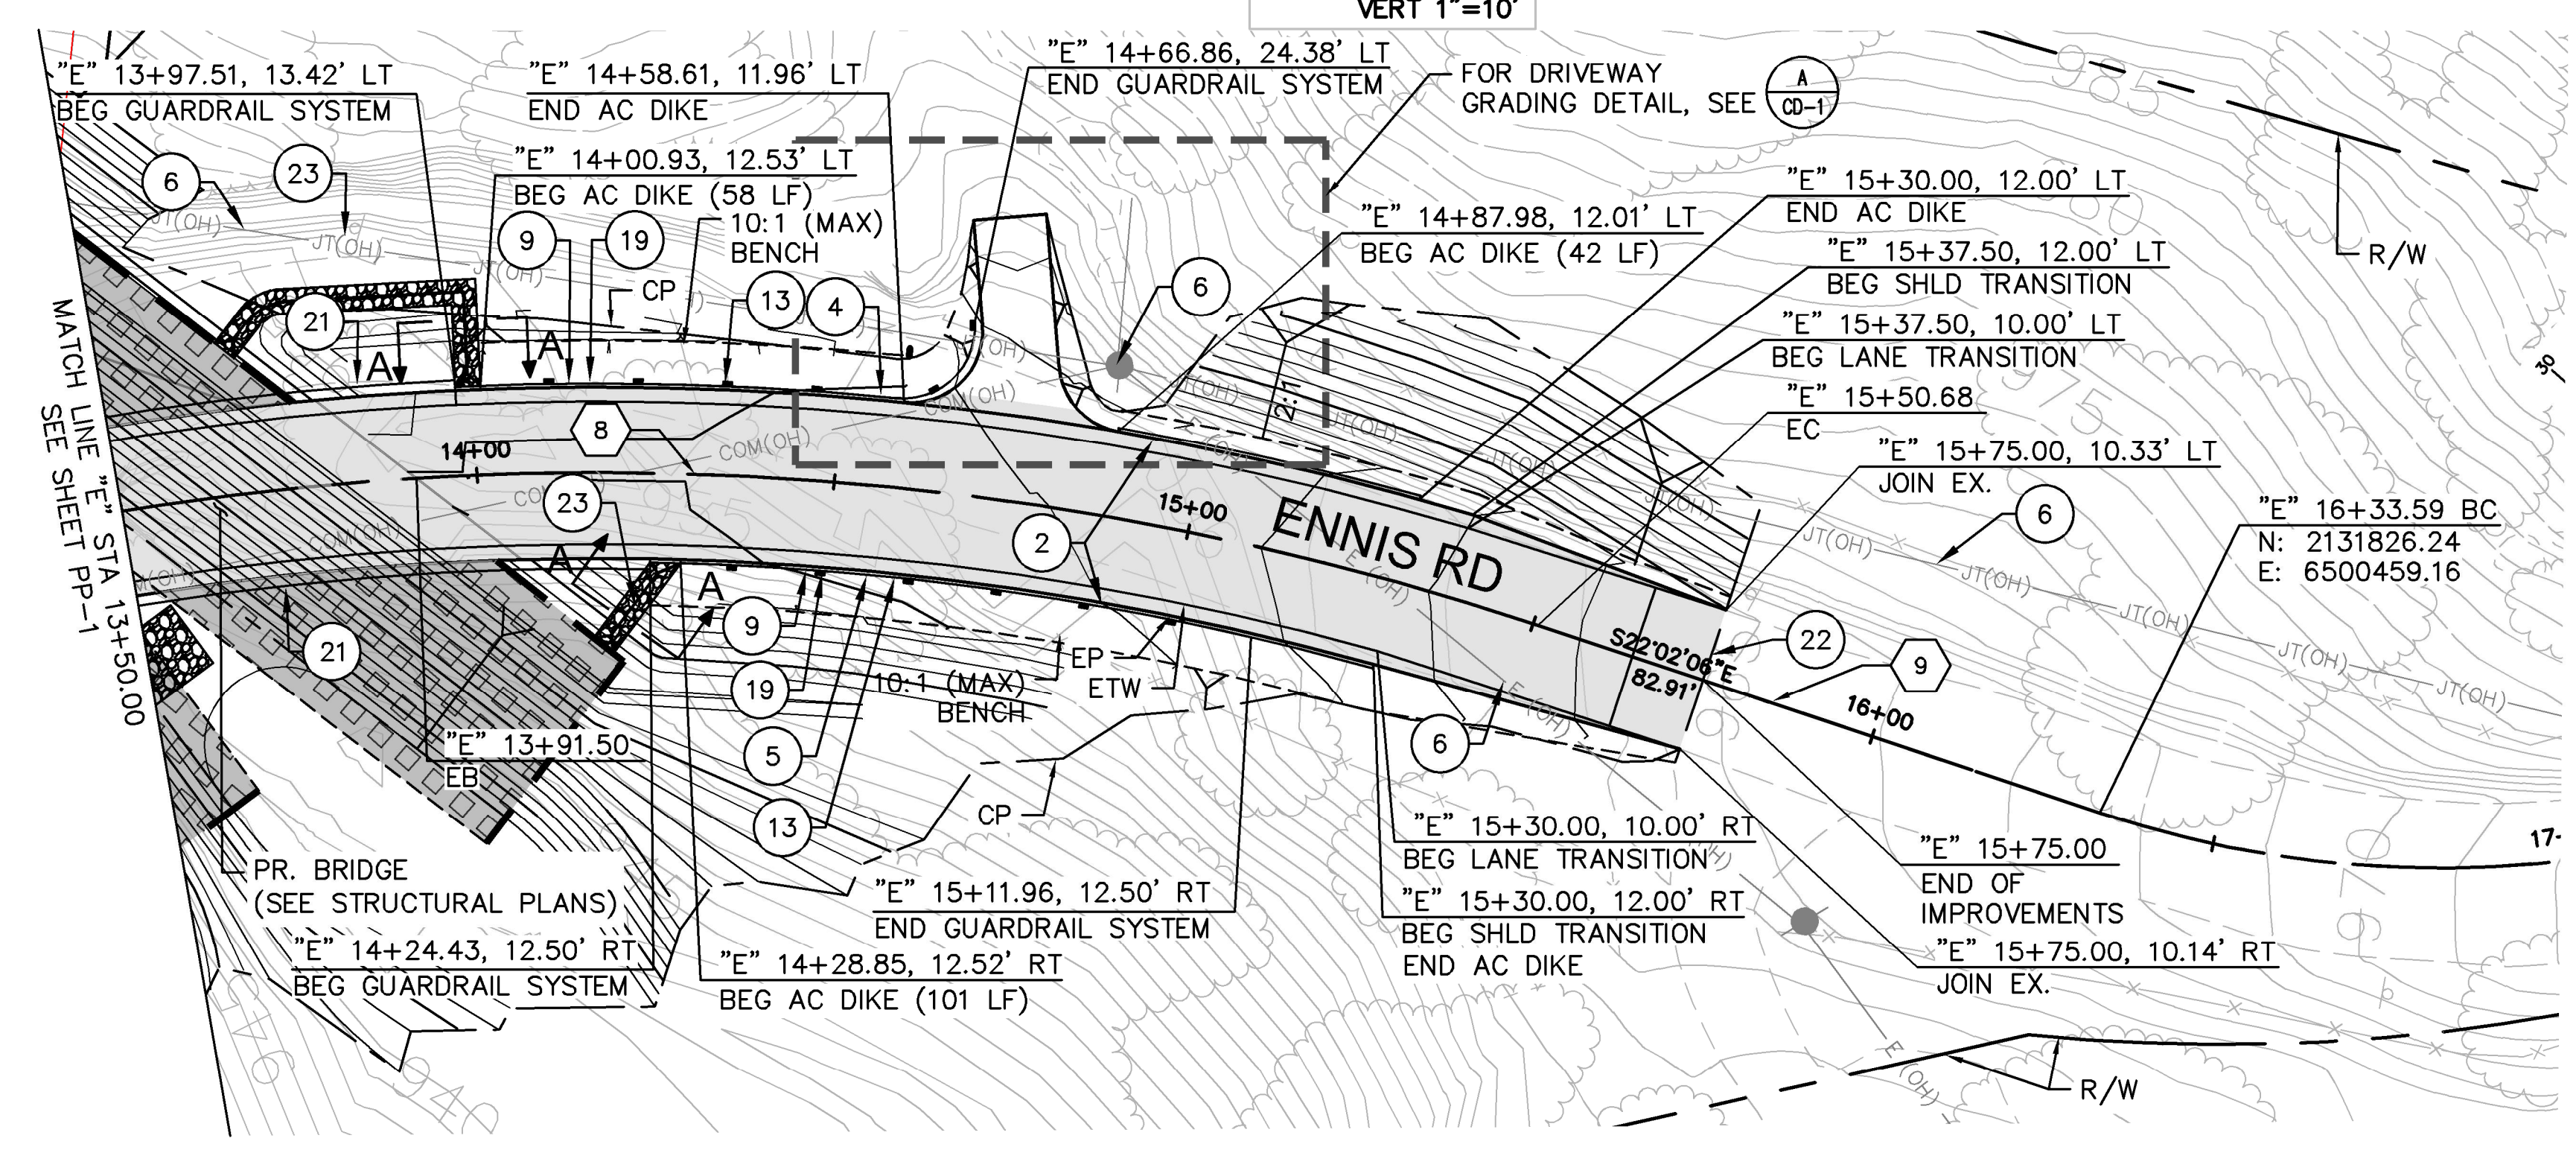

- LEGEND**
- EX. UTILITY POLE
  - E (OH) — EX. OVERHEAD ELECTRICAL
  - R/W
  - - - - - TCE
  - - - - - PR. DAYLIGHT
  - - - - - PR. BENCH
  - - - - - PR. MGS
  - ▨ PR. PAVEMENT
  - ▨ ACB PROTECTION (SEE SHEET CD-02)

CURVE TABLE				
CURVE NO.	LENGTH	RADIUS	DELTA	TANGENT
7	277.43	415.00	038°18'08"	144.12


LINE TABLE		
LINE NO.	LENGTH	DIRECTION
8	82.91	S22°02'06"E

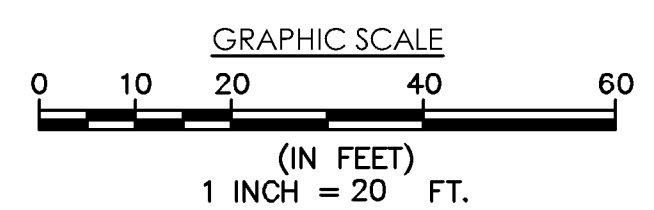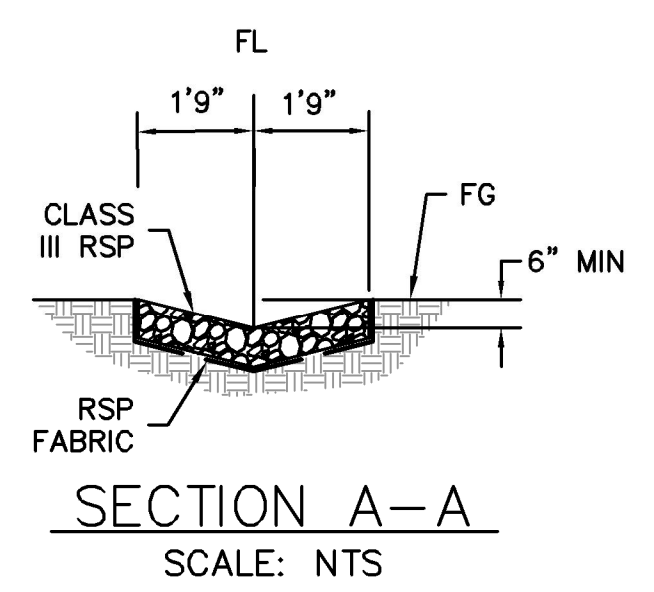

P:\ENG14\20141070\_FRESNO-SAND\_CREEK\_BRIDGE\_ON\_ENNIS\_ROAD\ENG\SHEETS\PP-1

DESIGNED:	DATE	RECORD DRAWING	SCALE
SA	3/12/2021	RESIDENT ENGINEER	AS SHOWN
DRAWN:	DATE		
LS	3/12/2021		
CHECKED:	DATE		
SA	3/12/2021		

FOR RIGHT OF WAY DATA AND ACCURATE ACCESS DETERMINATION, SEE DOCUMENTS IN THE DEPARTMENT OF PUBLIC WORKS AND PLANNING.

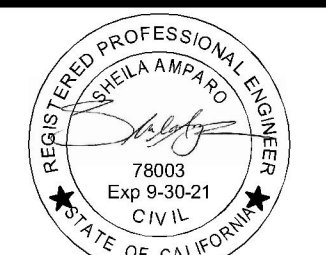

PROJECT	BRIDGE NO.
SAND CREEK BRIDGE REPLACEMENT ON ENNIS ROAD	42C0697, BRLO-5942(238)


ROAD NO. 2824-2825



DEPARTMENT OF PUBLIC WORKS AND PLANNING		
PLAN AND PROFILE		
ENNIS ROAD STA 13+50.00-17+00.00		
DRAWING NO. 11257	SHEET NO. 8	TOTAL 31

PP-2



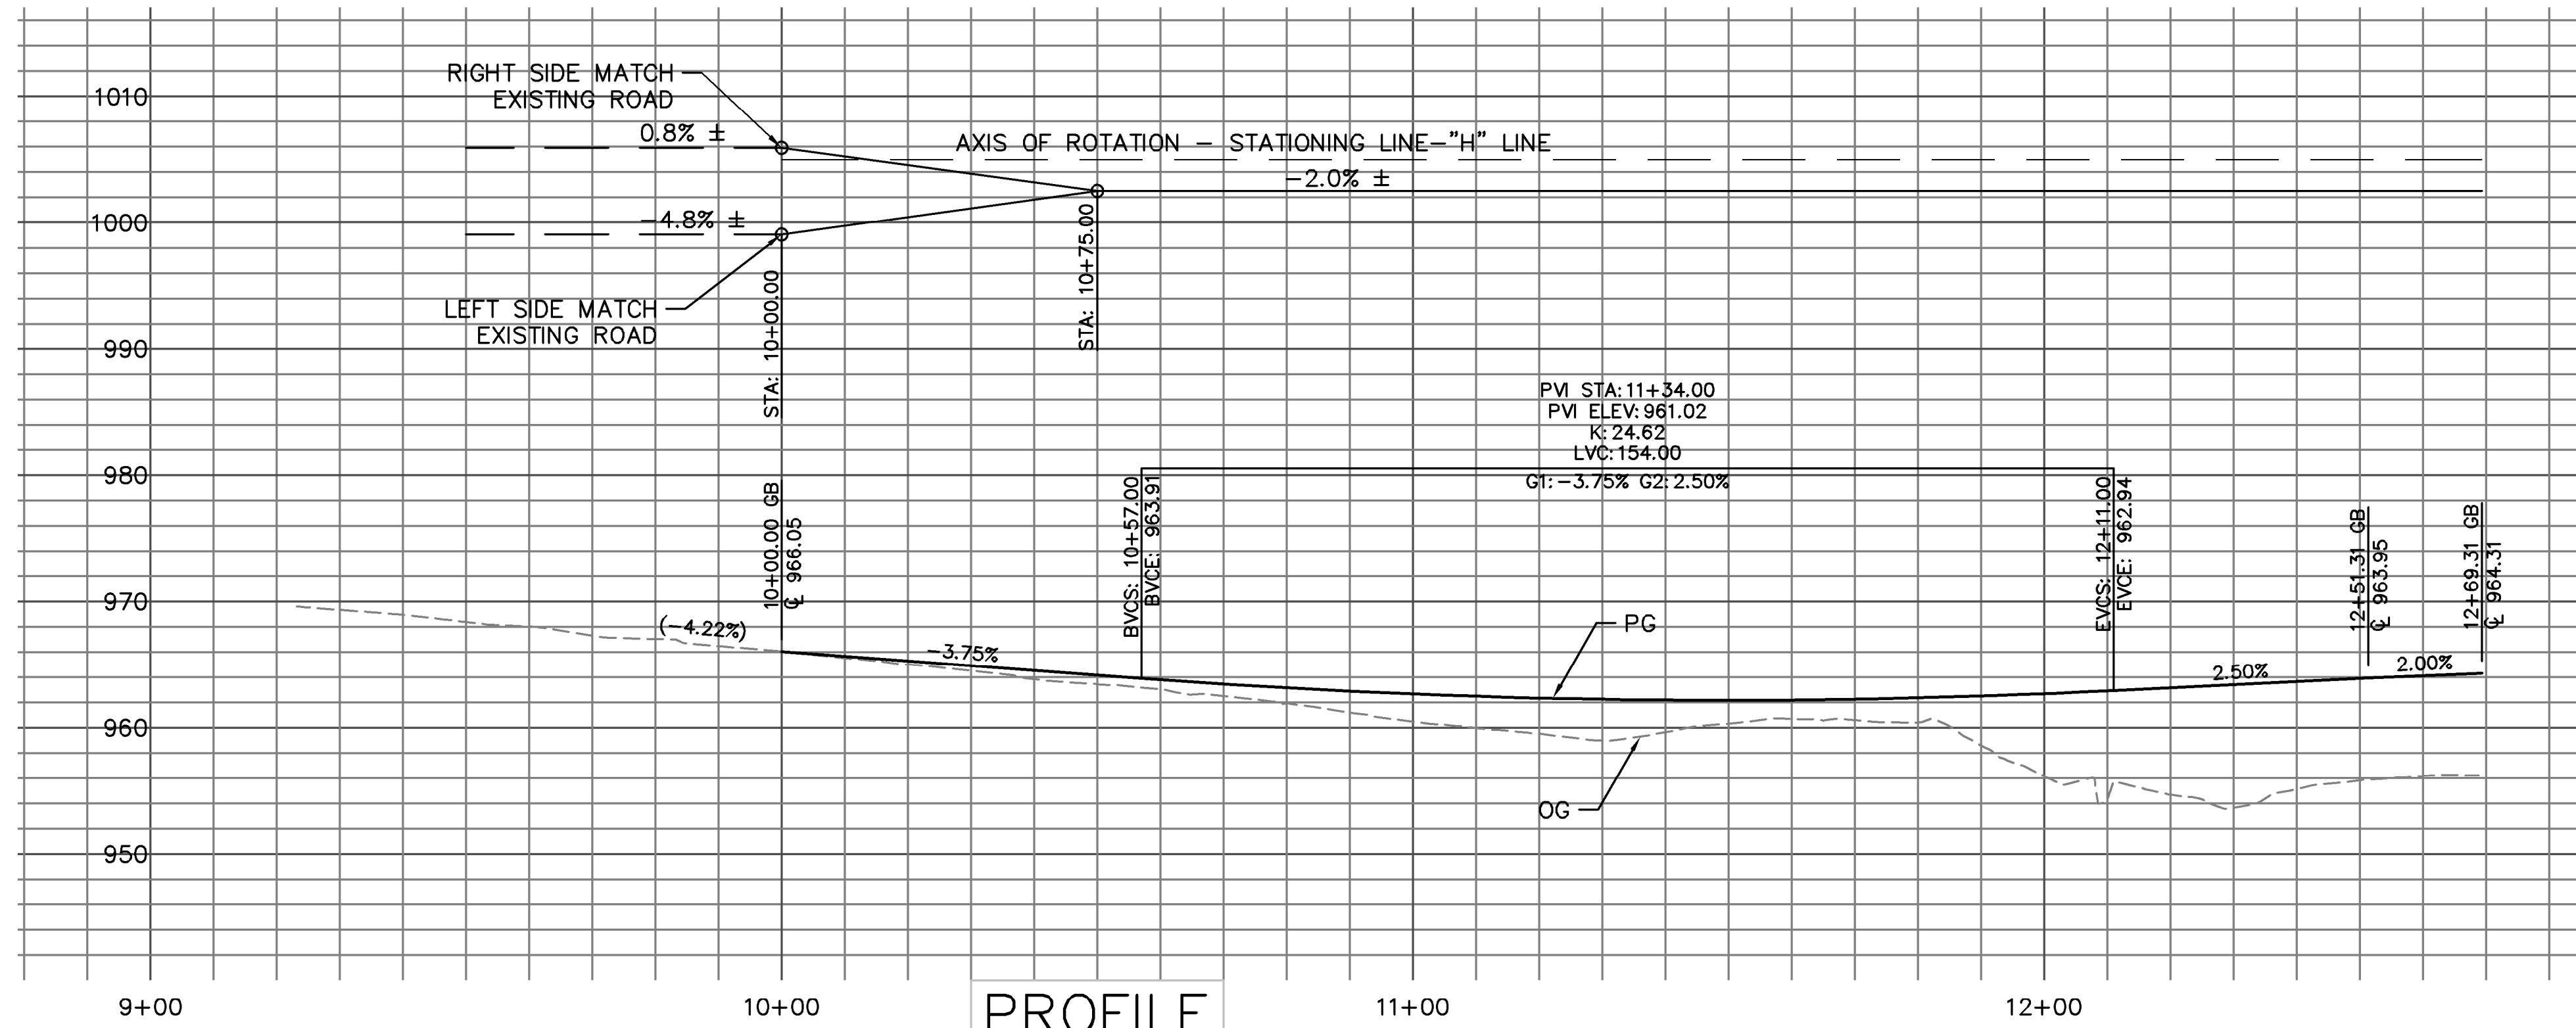


**PROFILE**  
SCALE: HORIZ 1"=20'  
VERT 1"=10'


- CONSTRUCTION NOTES:**
- 1 PROTECT IN PLACE UTILITY POLE
  - 2 CONSTRUCT 3" HMA OVER 9" AB
  - 3 PROTECT IN PLACE OVERHEAD LINES
  - 4 CONSTRUCT GUARDRAIL SYSTEM STANDARD RAILING SECTION, PER CALTRANS RSP A77L1 WITH CALTRANS APPROVED 31" IN-LINE TERMINAL END TREATMENT, USING TYPE 12A LAYOUT PER CALTRANS RSP A77Q1
  - 6 RELOCATE UTILITY POLE AND OVERHEAD LINE (BY OTHERS)
  - 8 PROTECT IN PLACE SHED STRUCTURE
  - 13 INSTALL MUTCD STANDARD TYPE E WHITE RETROREFLECTOR (2-SIDED) GUARDRAIL DELINEATOR; SPACING TO BE EVERY 20 FT
  - 19 CONSTRUCT HOT MIX ASPHALT DIKE TYPE C PER CALTRANS STANDARD PLAN RSP A87B PER PLACEMENT AS INDICATED ON CALTRANS STANDARD PLAN A77N4
  - 21 CONCRETE BARRIER, SEE STRUCTURAL PLANS
  - 22 SAWCUT, MATCH EXISTING

CURVE TABLE				
CURVE NO.	LENGTH	RADIUS	DELTA	TANGENT
10	188.68	220.00	049°08'18"	100.58

LINE TABLE		
LINE NO.	LENGTH	DIRECTION
11	112.58	N79°16'43"E
12	44.33	N30°08'25"E

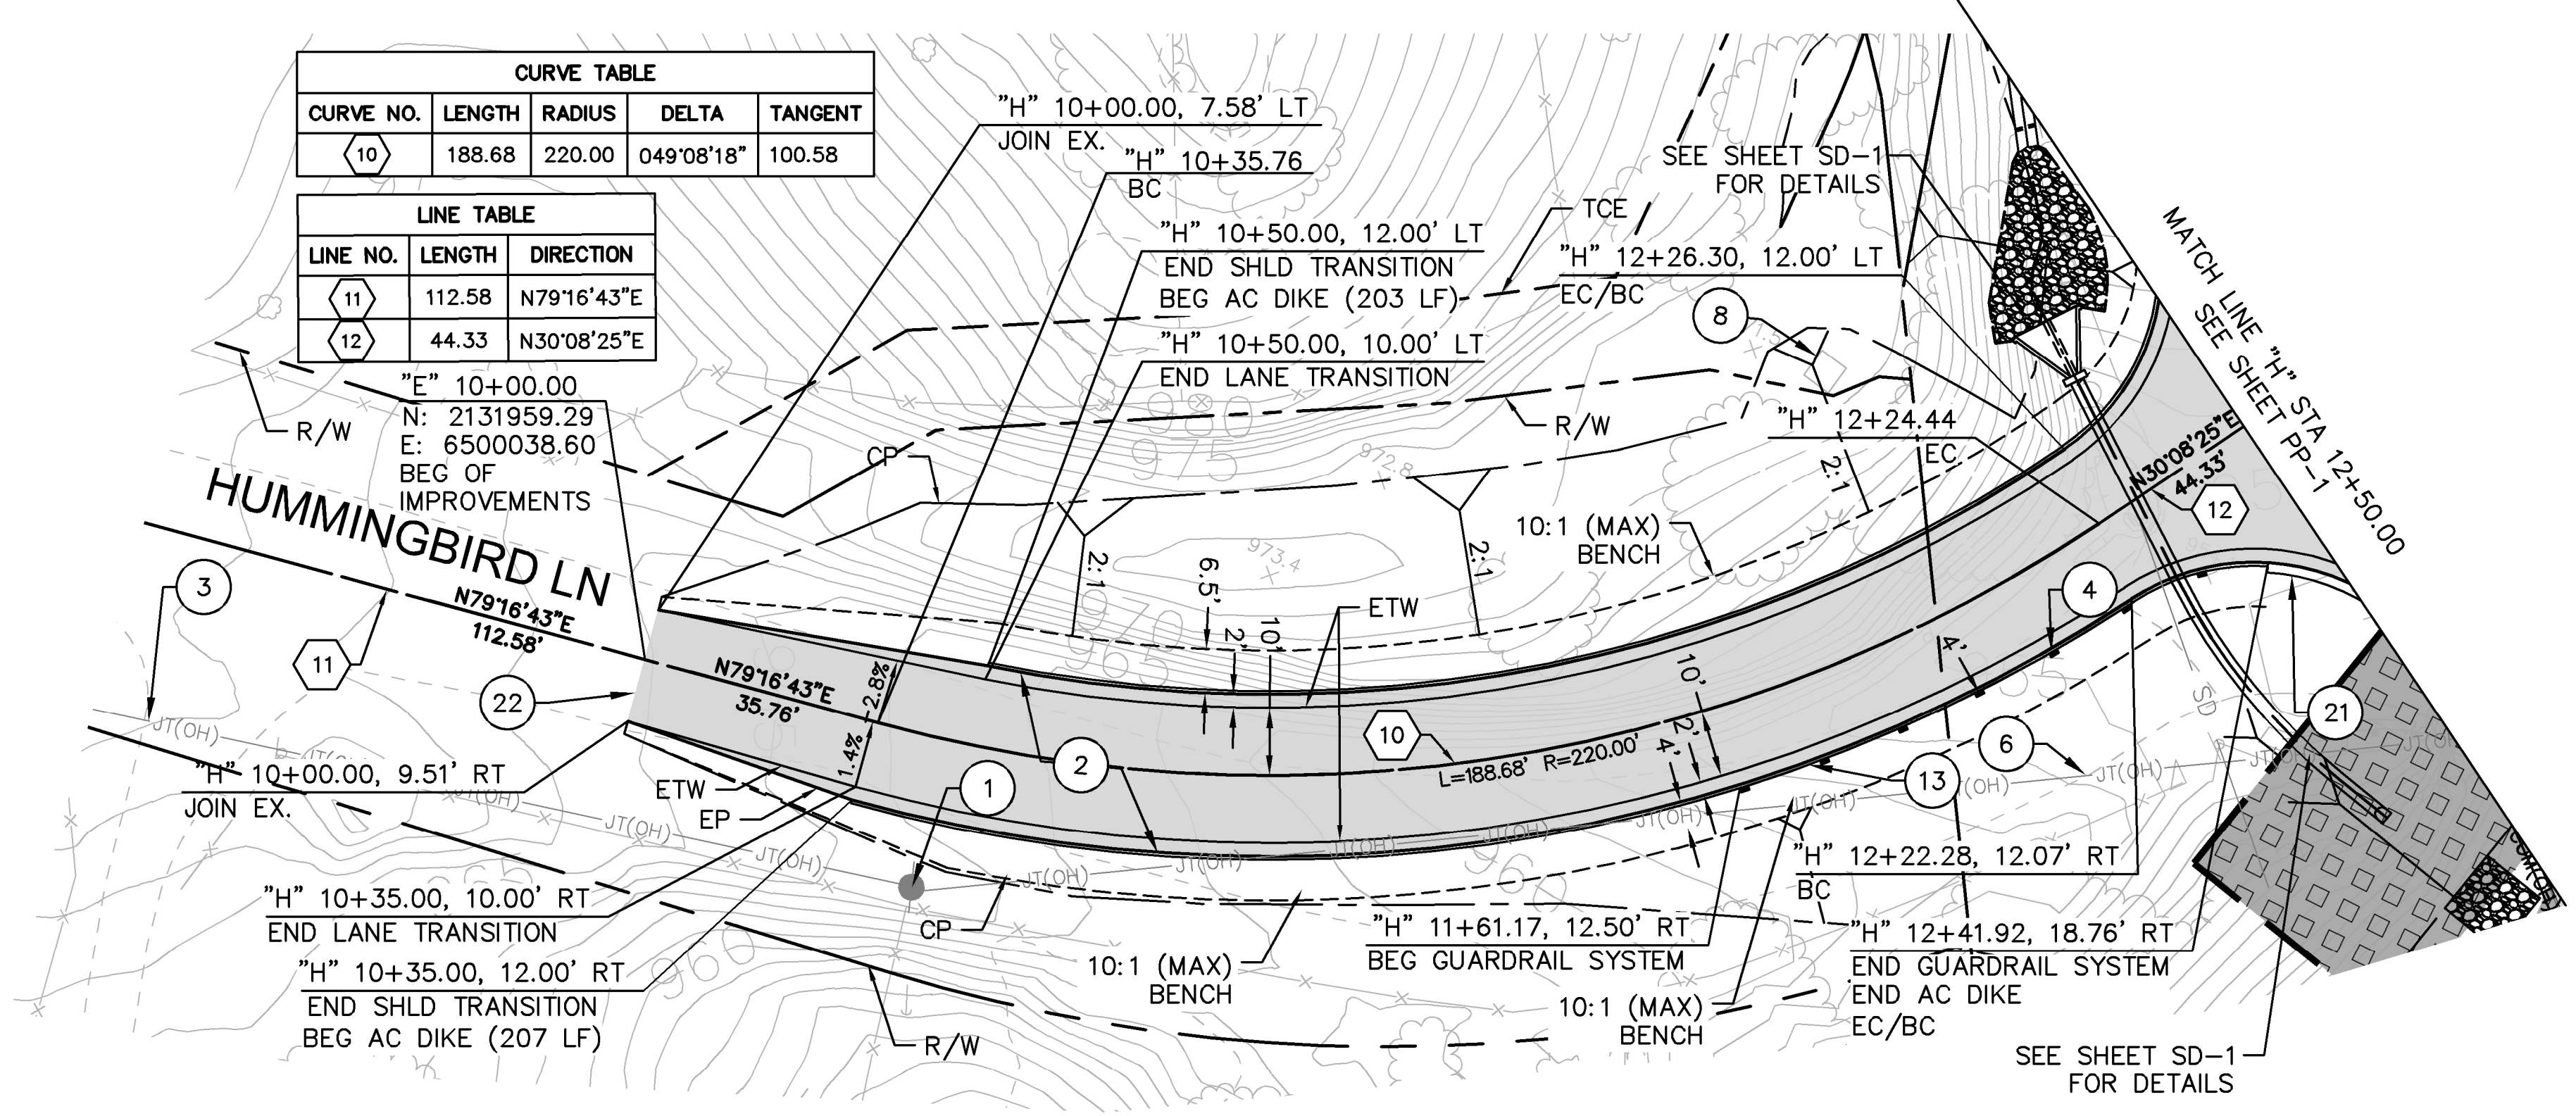

- LEGEND**
- EX. UTILITY POLE
  - E (OH) — EX. OVERHEAD ELECTRICAL
  - R/W
  - TCE
  - PR. DAYLIGHT
  - PR. BENCH
  - PR. MGS
  - ▭ PR. PAVEMENT
  - ▨ ACB SLOPE PROTECTION (SEE SHEET CD-02)

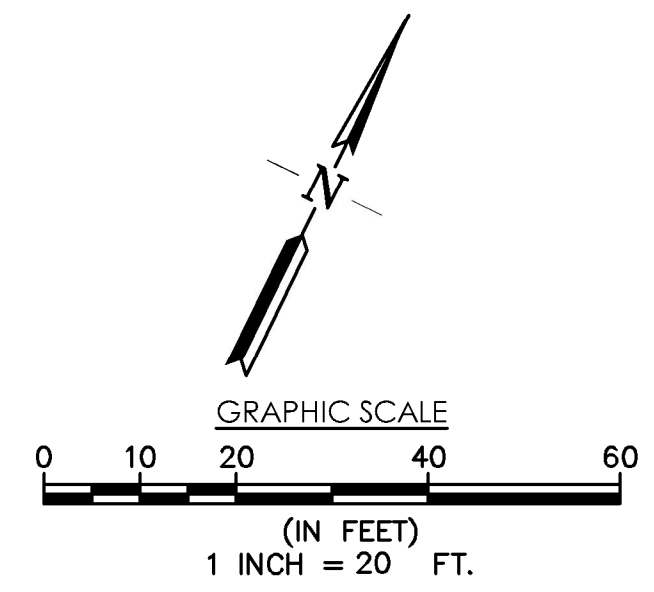

PP-3


DESIGNED: SA	DATE	RESIDENT ENGINEER	DATE
DRAWN: LS	3/12/2021		
CHECKED: SA	3/12/2021		

FOR RIGHT OF WAY DATA AND ACCURATE ACCESS DETERMINATION, SEE DOCUMENTS IN THE DEPARTMENT OF PUBLIC WORKS AND PLANNING.

SCALE  
AS SHOWN



PROJECT  
SAND CREEK BRIDGE REPLACEMENT  
ON ENNIS ROAD  
ROAD NO. 2824-2825 BRIDGE NO. 42C0697, BRLO-5942(238)

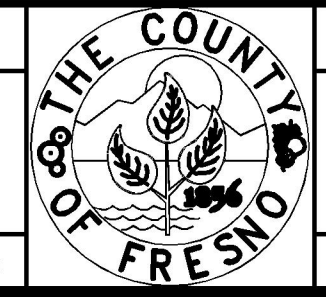




DEPARTMENT OF PUBLIC WORKS AND PLANNING  
PLAN AND PROFILE  
HUMMINGBIRD LANE STA 10+00.00-12+25.00  
DRAWING NO. 11257 SHEET NO. 9 TOTAL 31

**CONSTRUCTION NOTES:**

- 10 INSTALL PIPE CULVERT WARPED WING WALL (W=1') PER CALTRANS STD PLAN D86B
- 11 INSTALL 24" RSP CULVERT PER CALTRANS STD PLAN A62D
- 23 INSTALL CLASS III RSP
- 24 INSTALL 10'X10' CLASS V RSP CENTERED ON PIPE AT TOE OF SLOPE
- 25 CONSTRUCT CONCRETE LINED V-DITCH, SEE DETAIL 2 ON THIS SHEET FOR DIMENSIONS
- 26 CONSTRUCT DIP CROSSING
- 27 CONSTRUCT SPLASH WALL

**LEGEND**


- R/W
- TCE
- PR. DAYLIGHT
- PR. BENCH
- PR. MGS
- PR. PAVEMENT
- ACB SLOPE PROTECTION (SEE SHEET CD-02)
- ROCK SLOPE PROTECTION

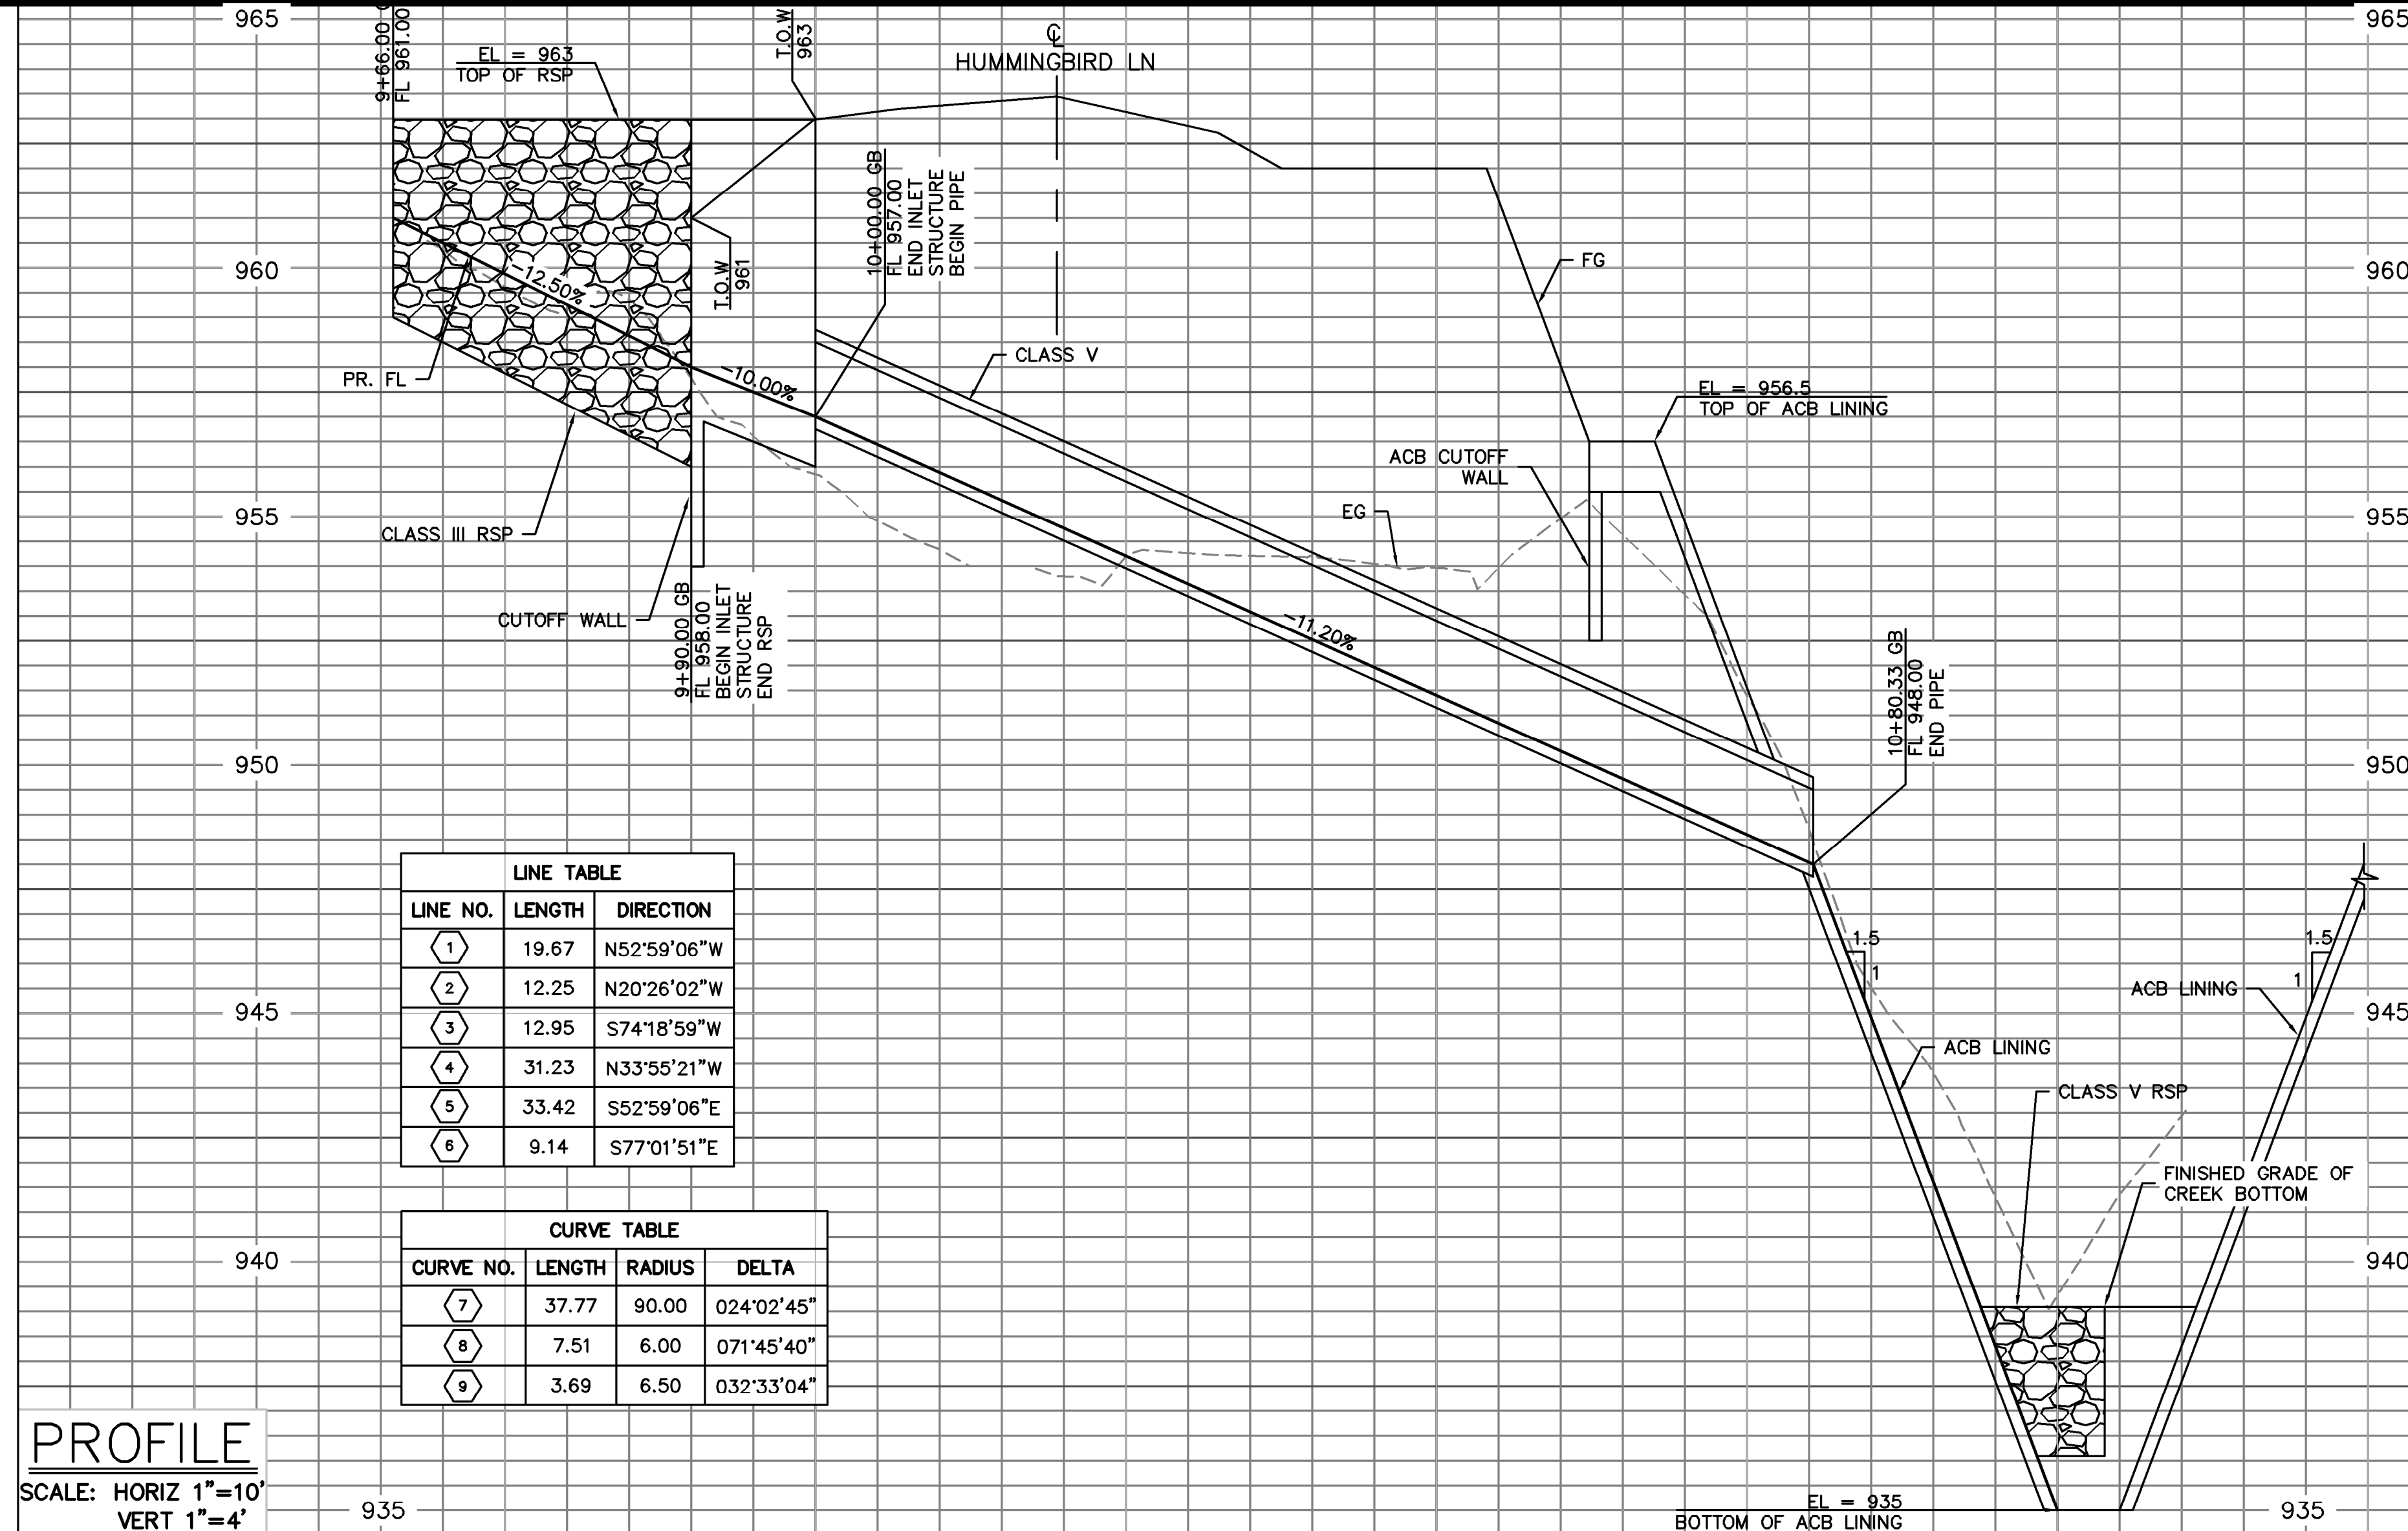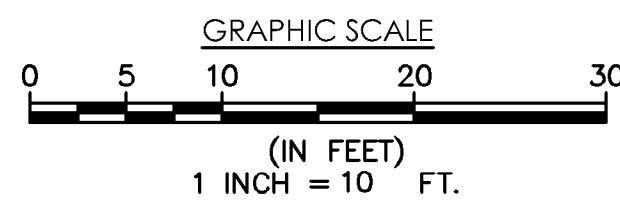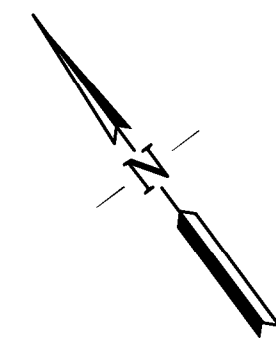


LINE NO.	LENGTH	DIRECTION
1	19.67	N52°59'06"W
2	12.25	N20°26'02"W
3	12.95	S74°18'59"W
4	31.23	N33°55'21"W
5	33.42	S52°59'06"E
6	9.14	S77°01'51"E

CURVE NO.	LENGTH	RADIUS	DELTA
7	37.77	90.00	024°02'45"
8	7.51	6.00	071°45'40"
9	3.69	6.50	032°33'04"

**PROFILE**  
SCALE: HORIZ 1"=10'  
VERT 1"=4'

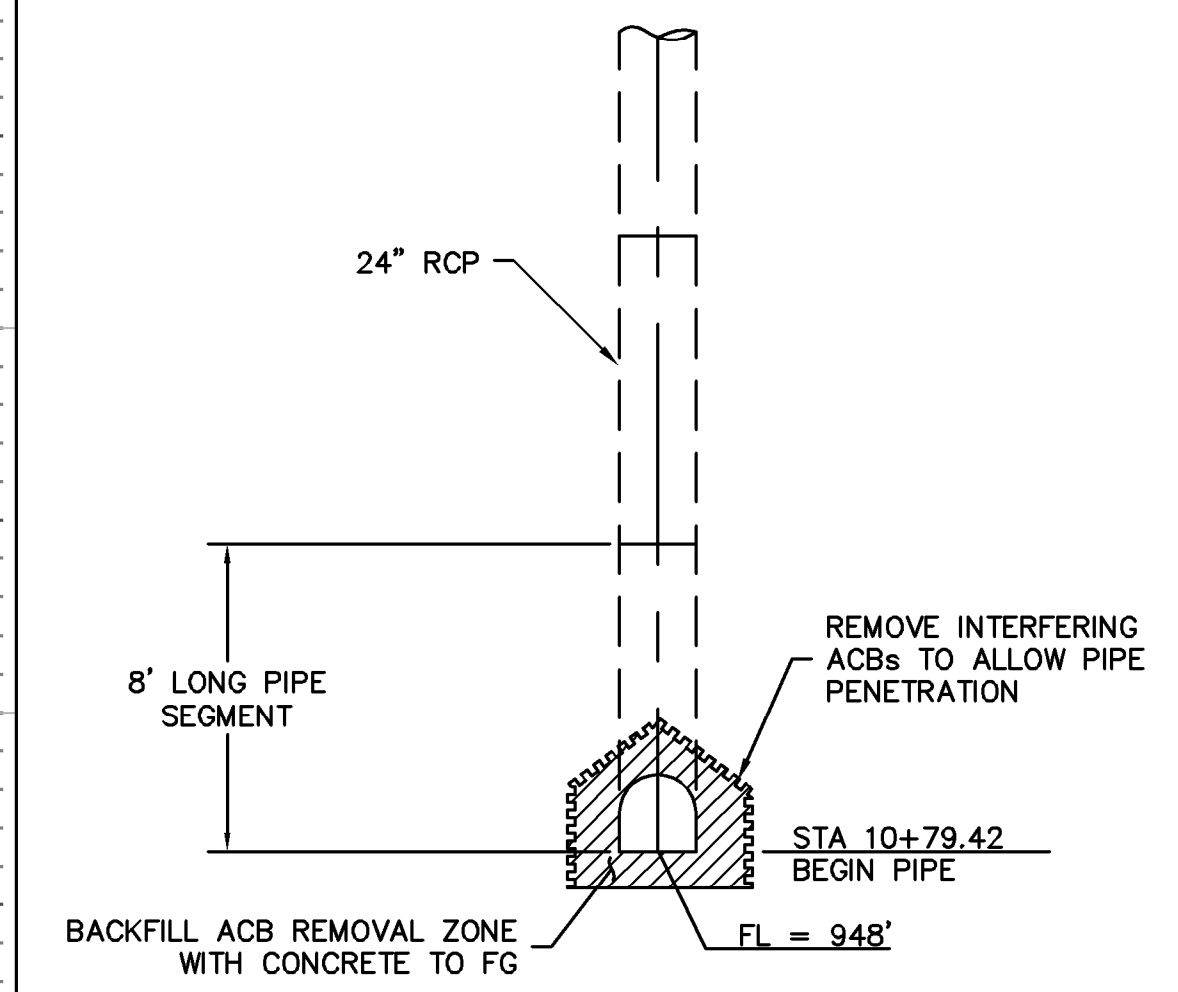


1 SD-1 PIPE INTERCEPT DETAIL  
SCALE: N.T.S.

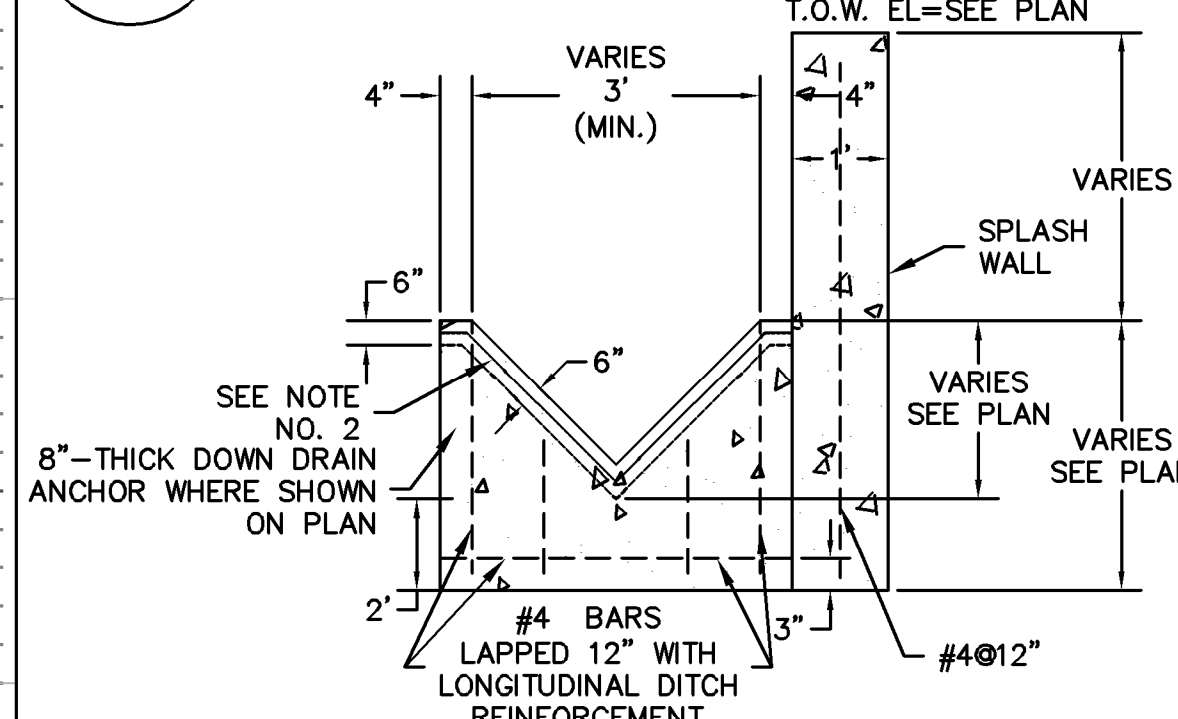


- NOTES:**
- CONCRETE SHALL HAVE A MINIMUM ULTIMATE COMPRESSIVE STRENGTH AT 28 DAYS OF 2500 PSI. CONCRETE MAY BE PNEUMATICALLY PLACED AND SHALL CONFORM TO SECTION 1924 OF THE UNIFORM BUILDING CODE.
  - REINFORCING SHALL BE 6"x6" - W1.4 X W1.4 WELDED WIRE MESH (W.W.M.) OR APPROVED EQUAL.
  - GROUNDING SHALL BE PRE-WETTED TO THE SATISFACTION OF THE ENGINEER PRIOR TO PLACEMENT OF CONCRETE. MOISTURE LOSS RETARDANT SHALL BE USED WHEN REQUIRED BY THE ENGINEER.

2 SD-1 V-DITCH DETAIL  
SCALE: N.T.S.

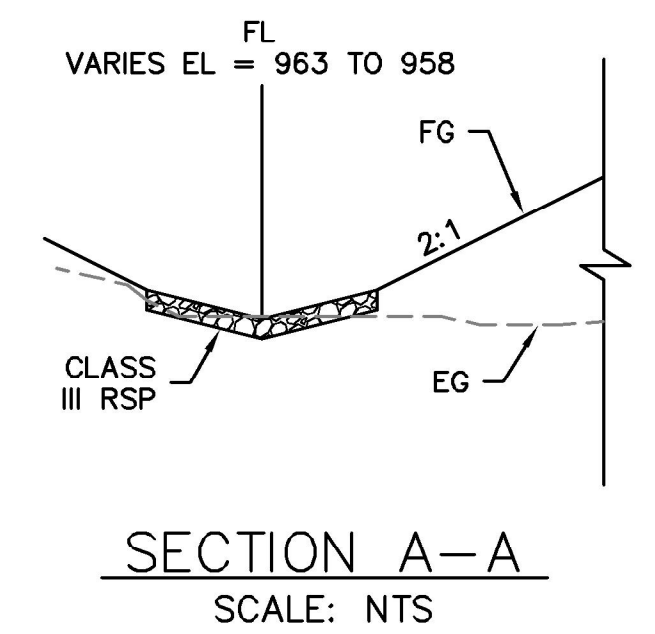

SECTION A-A  
SCALE: N.T.S.

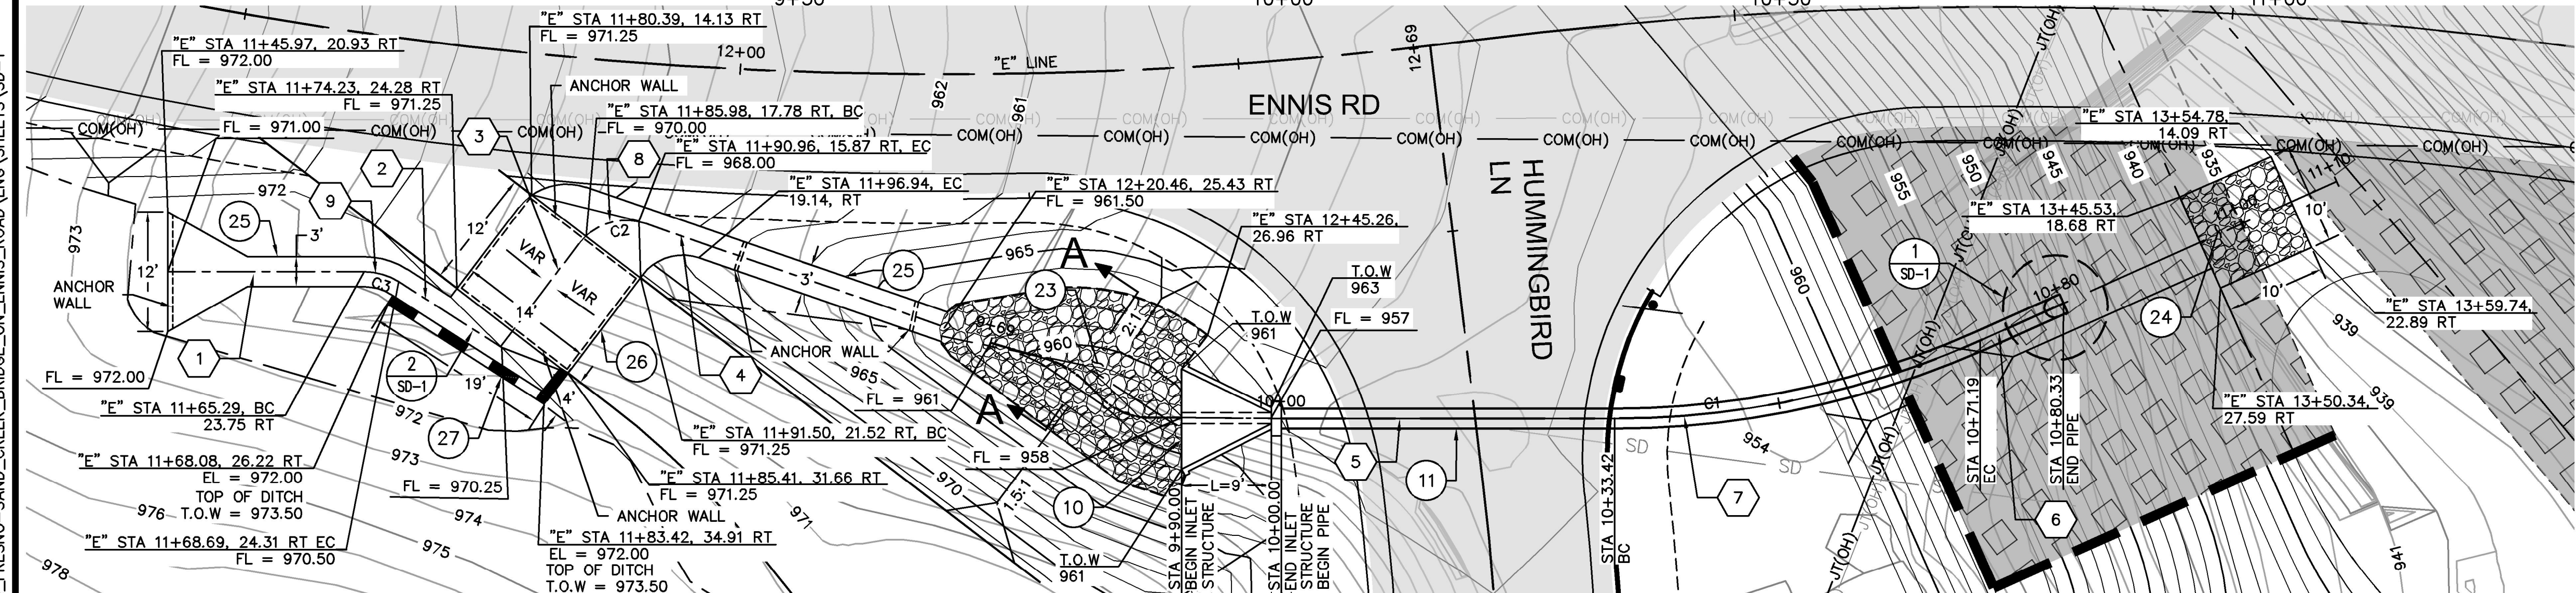

DESIGNED:	DATE	RECORD DRAWING	SCALE
SA DV	3/12/2021	RESIDENT ENGINEER	AS SHOWN
DRAWN: LS	3/12/2021		
CHECKED: DV	3/12/2021		






**PROJECT**  
SAND CREEK BRIDGE REPLACEMENT  
ON ENNIS ROAD  
ROAD NO. 2824-2825 BRIDGE NO. 42C0697, BRLO-5942(238)




**DEPARTMENT OF PUBLIC WORKS AND PLANNING**  
STORM DRAIN  
PLAN AND PROFILE  
DRAWING NO. 11257 SHEET NO. 10 TOTAL 31

P:\ENG\4\2014\1070\_FRESNO-SAND\_CREEK\_BRIDGE\_ON\_ENNIS\_ROAD\ENG\_SHEETS\SD-1




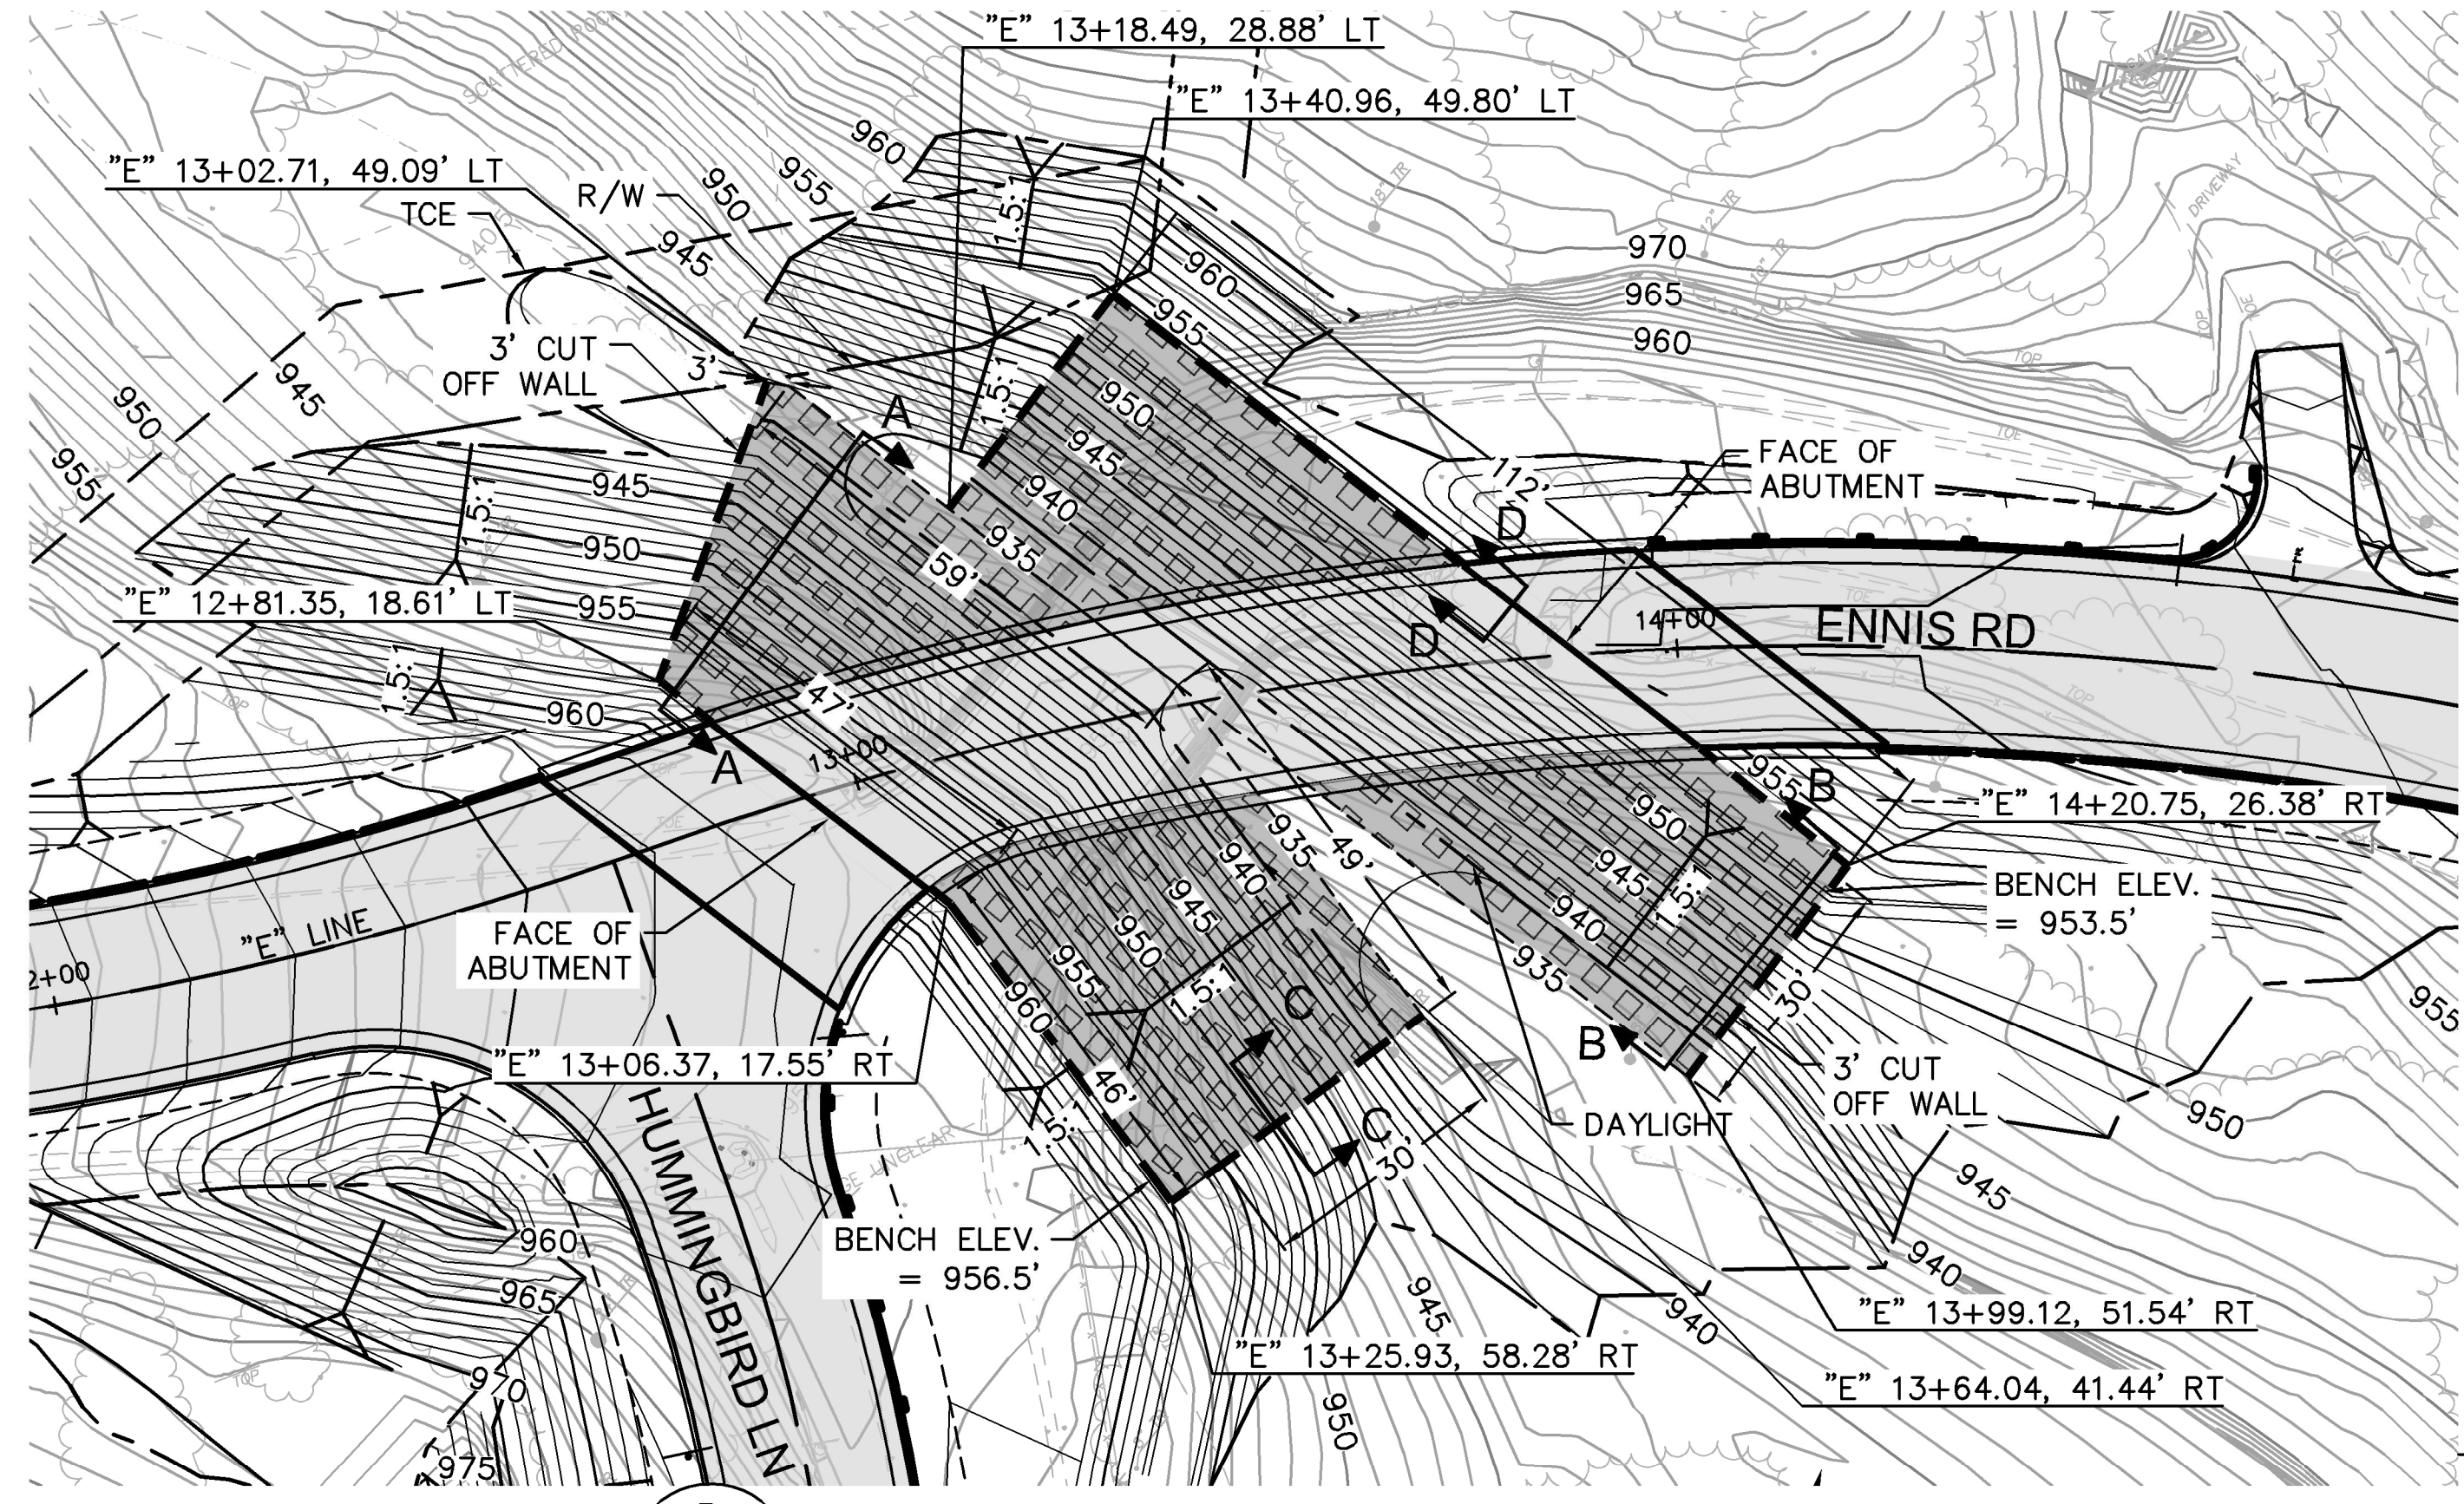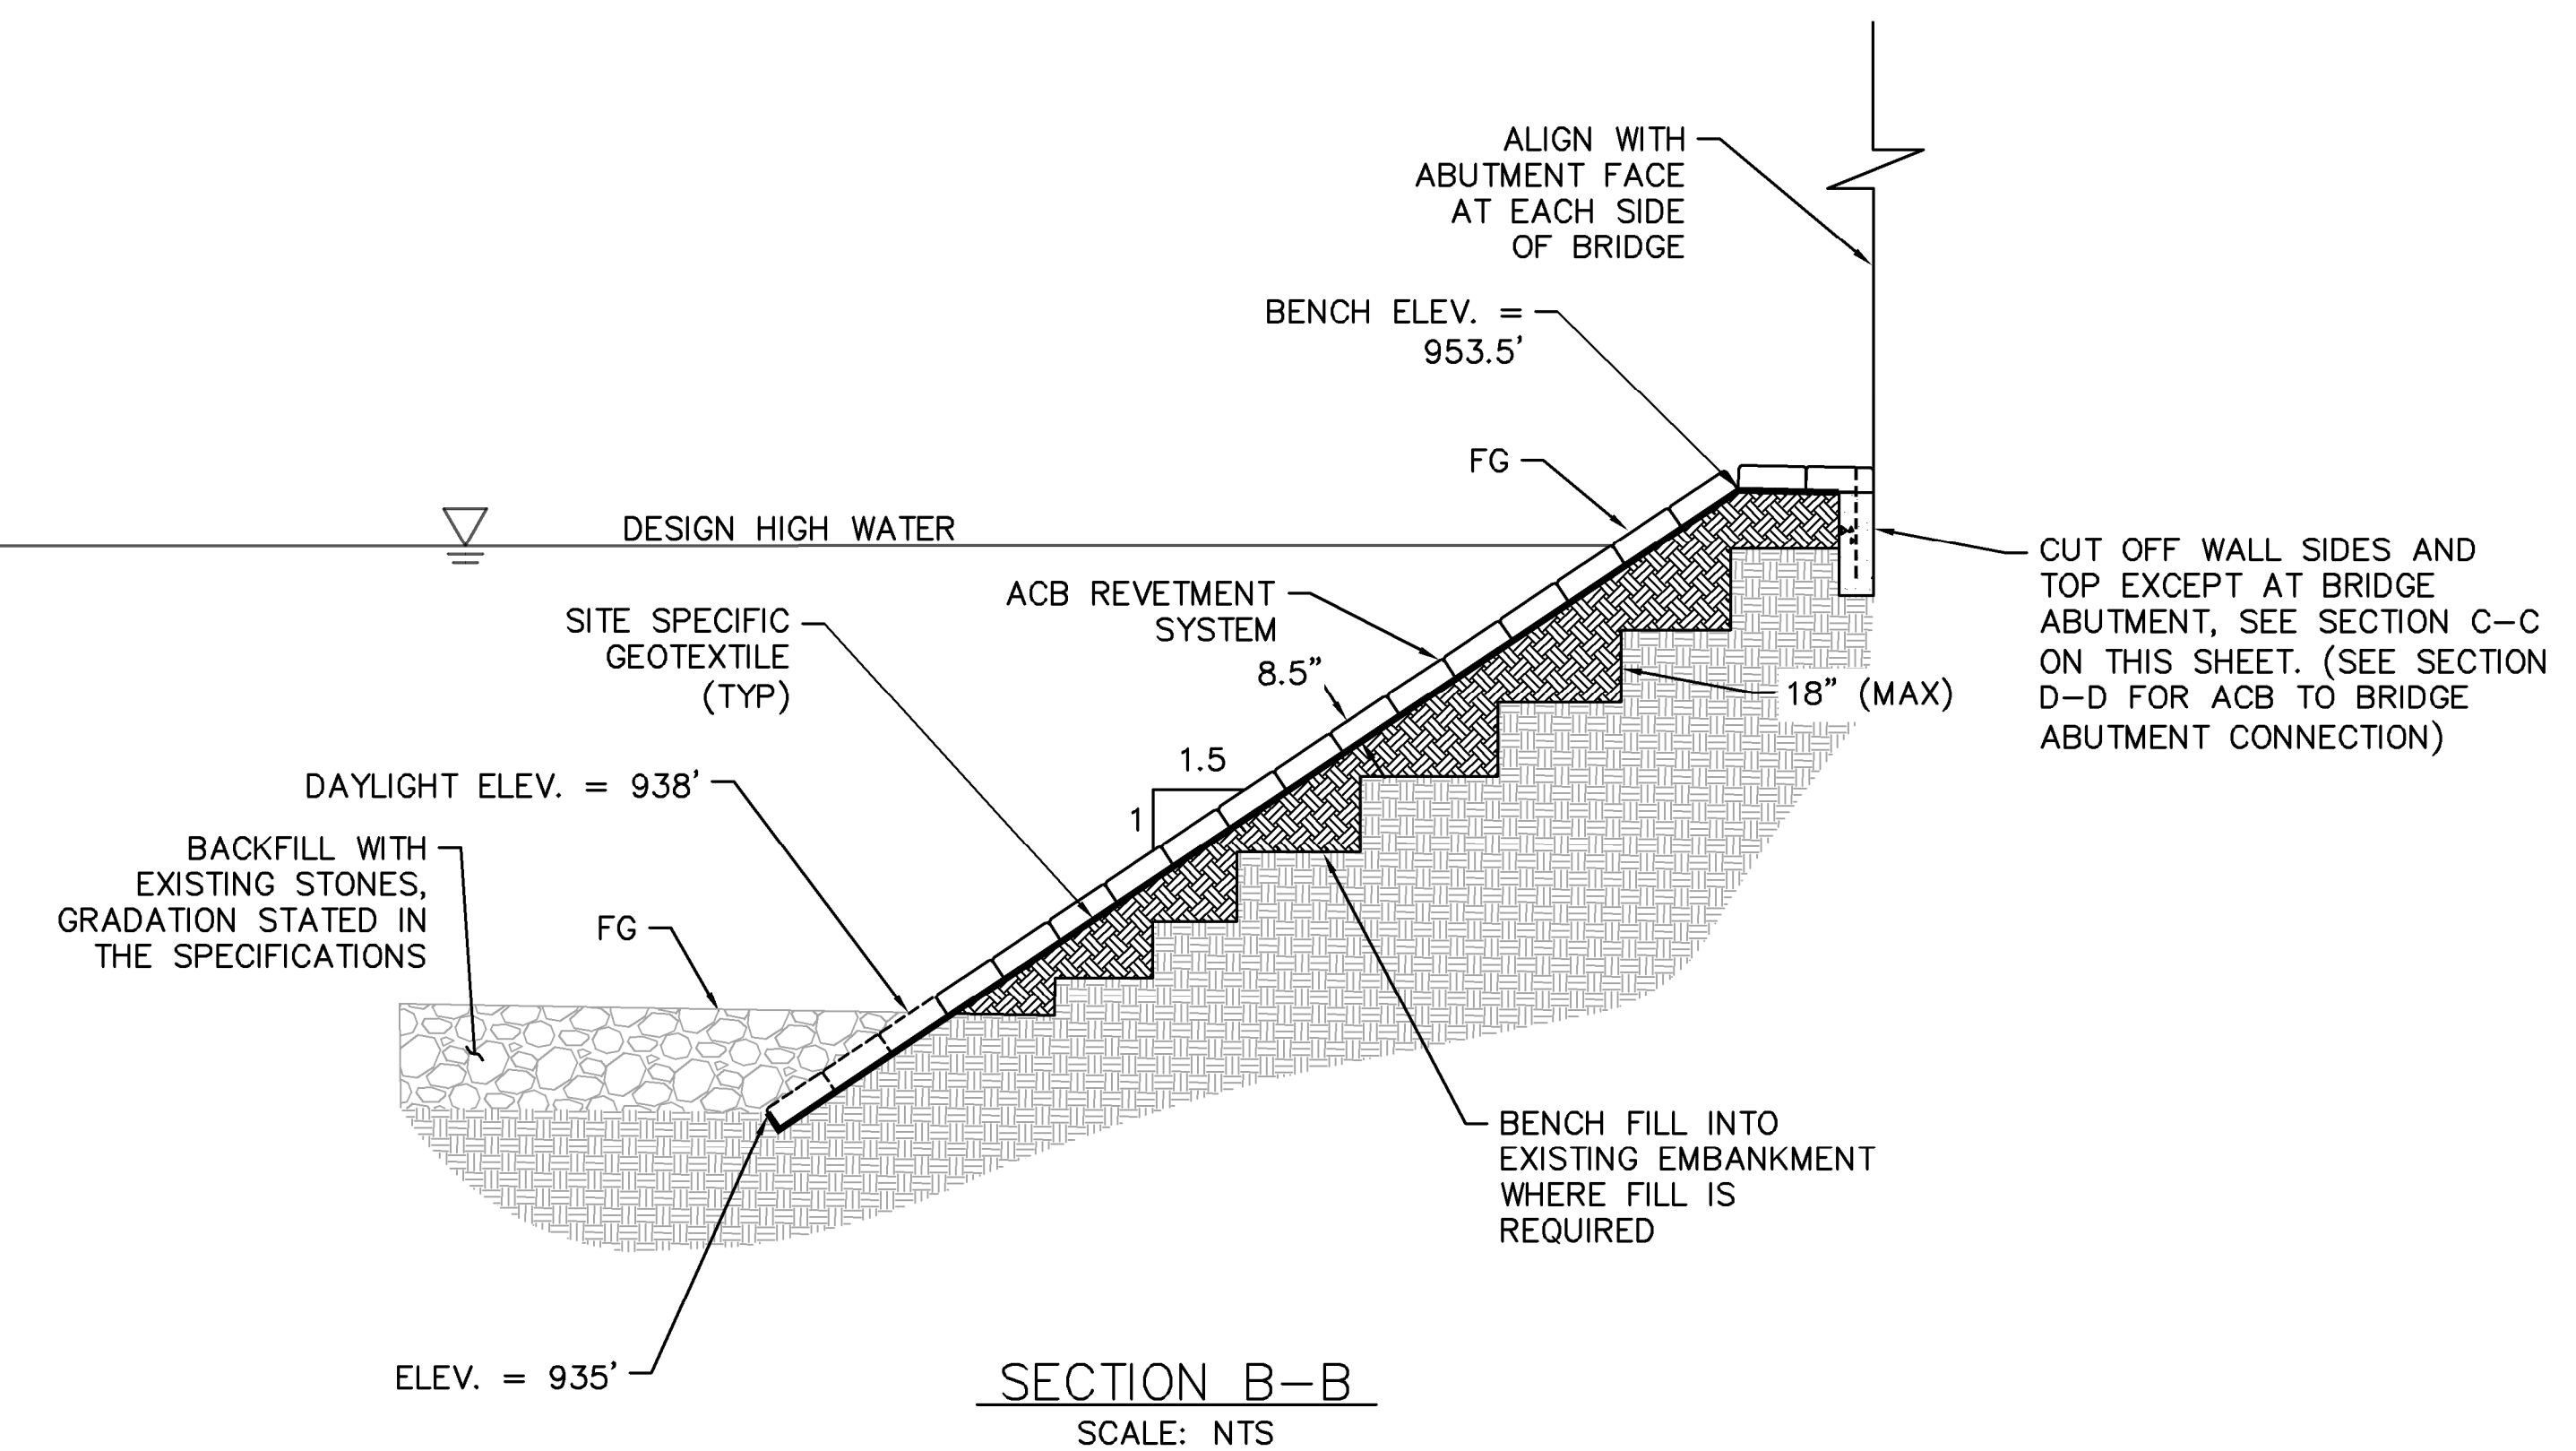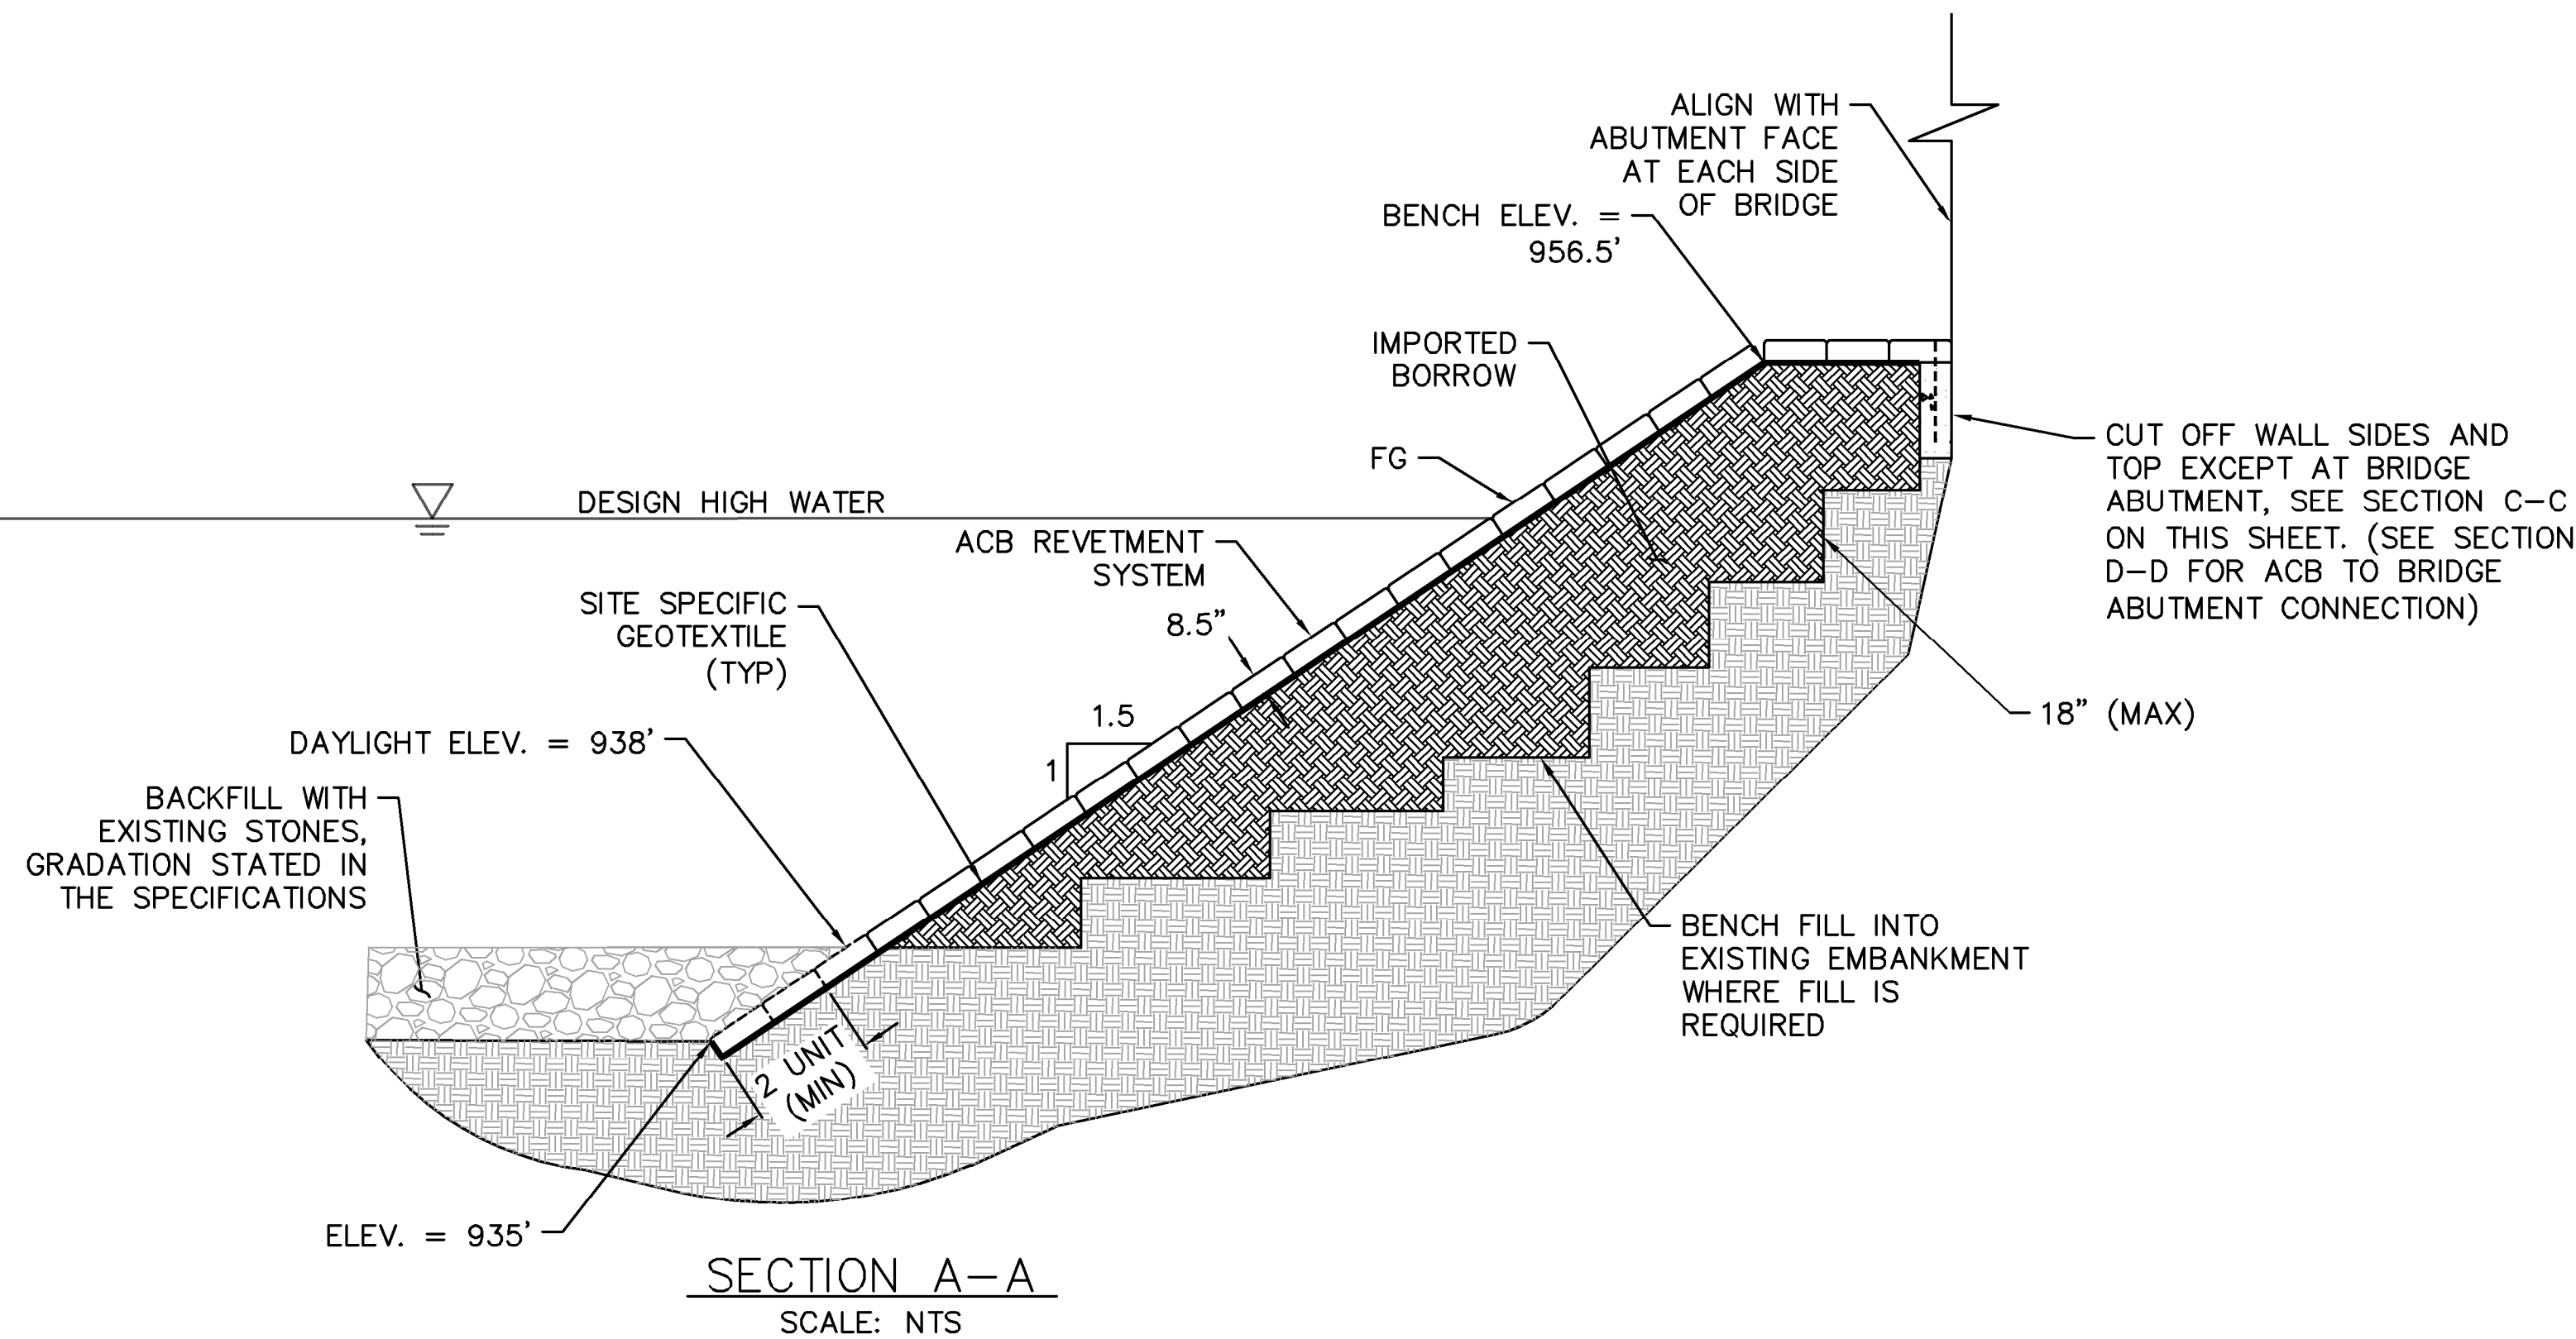

**D**  
CD-2  
**SLOPE PROTECTION DETAIL**  
SCALE: 1"=20'

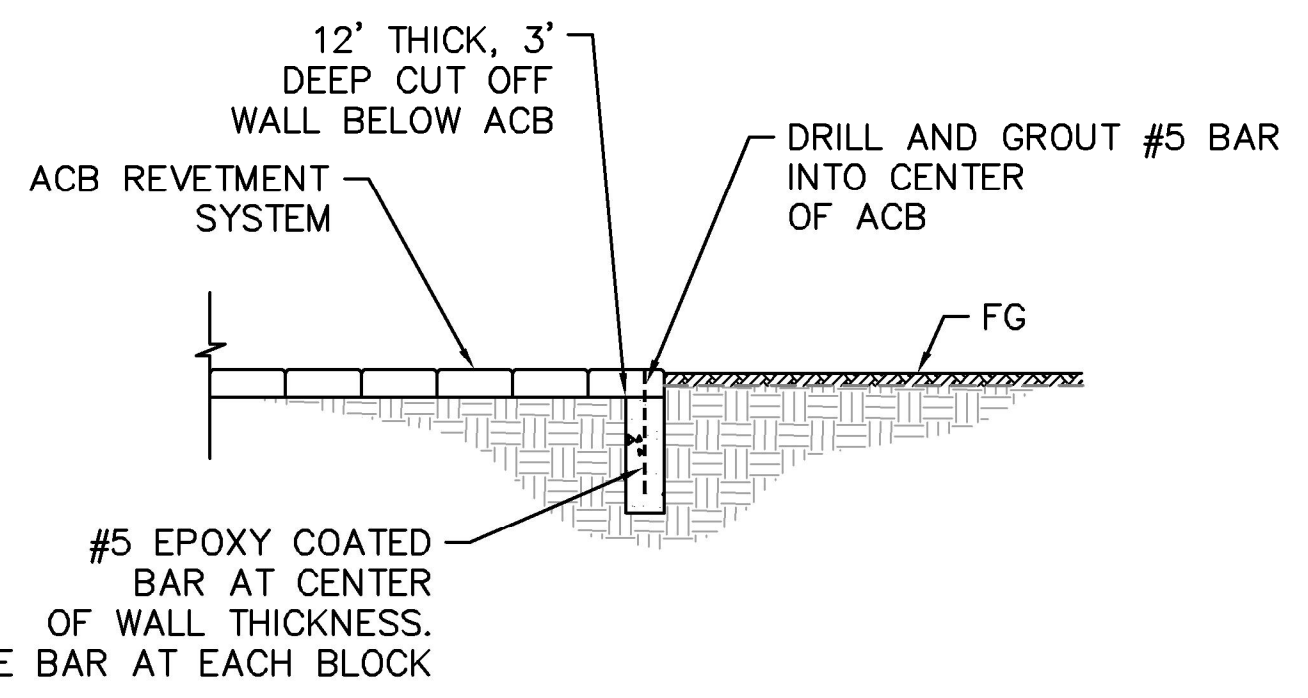


**SECTION C-C: TYPICAL CUTOFF WALL DETAIL**  
SCALE: NTS

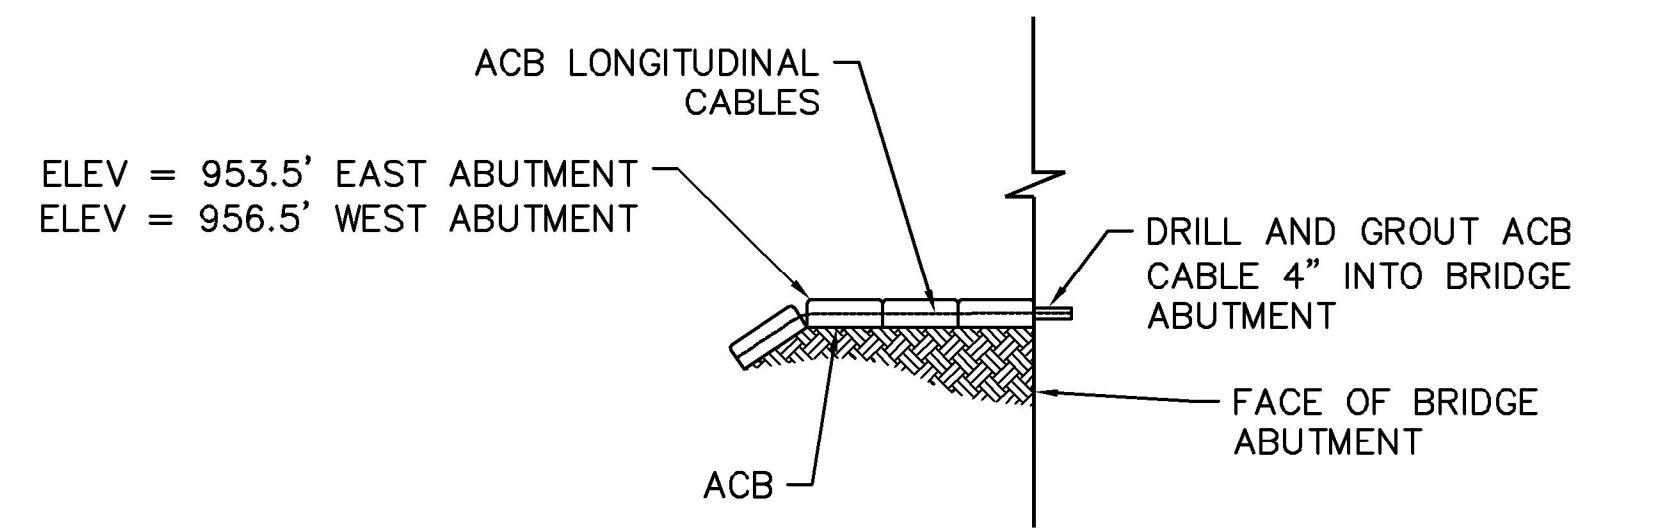

**SECTION D-D: ACB TO BRIDGE ABUTMENT CONNECTION**  
SCALE: NTS


- NOTES:**
- DESIGN OF ARTICULATED CONCRETE BLOCK (ACB) SLOPE PROTECTION IS BASED ON THE REPORT TITLED "PRELIMINARY DESIGN HYDRAULIC STUDY ENNIS ROAD BRIDGE OVER SAND CREEK (BRIDGE 42C0697), FRESNO COUNTY, CALIFORNIA," PREPARED BY AVILA AND ASSOCIATES, DATED NOVEMBER 6, 2019.
  - FOR BRIDGE GENERAL PLAN, SEE STRUCTURAL SHEET S-1.

- LEGEND**
- R/W
  - - - PR. TCE
  - - - PR. DAYLIGHT
  - - - PR. BENCH
  - - - PR. CUT OFF WALL
  - - - PR. MGS
  - ▭ PR. PAVEMENT
  - ▨ ACB SLOPE PROTECTION

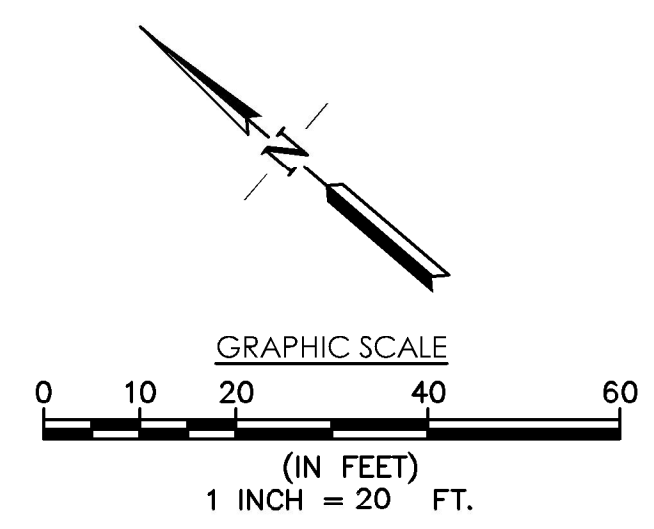



CD-2

DESIGNED: DV	DATE: 3/12/2021	RECORD DRAWING: RESIDENT ENGINEER	SCALE: AS SHOWN	<p><b>BKF</b> 4670 Willow Rd., Ste 250 Pleasanton, CA 94588 925.396.7700</p>	<p>DANIEL VILLALOBOS REGISTERED PROFESSIONAL ENGINEER 55210 Exp 6/30/22 CIVIL STATE OF CALIFORNIA</p>	PROJECT: SAND CREEK BRIDGE REPLACEMENT ON ENNIS ROAD	<p>FRESNO COUNTY DEPARTMENT OF PUBLIC WORKS AND PLANNING</p>	CONSTRUCTION DETAILS		
DRAWN: LS	DATE: 3/12/2021		ROAD NO. 2824-2825			BRIDGE NO. 42C0697, BRLO-5942(238)		DRAWING NO. 11257	SHEET NO. 12	TOTAL 31
CHECKED: DV	DATE: 3/12/2021		FOR RIGHT OF WAY DATA AND ACCURATE ACCESS DETERMINATION, SEE DOCUMENTS IN THE DEPARTMENT OF PUBLIC WORKS AND PLANNING.							

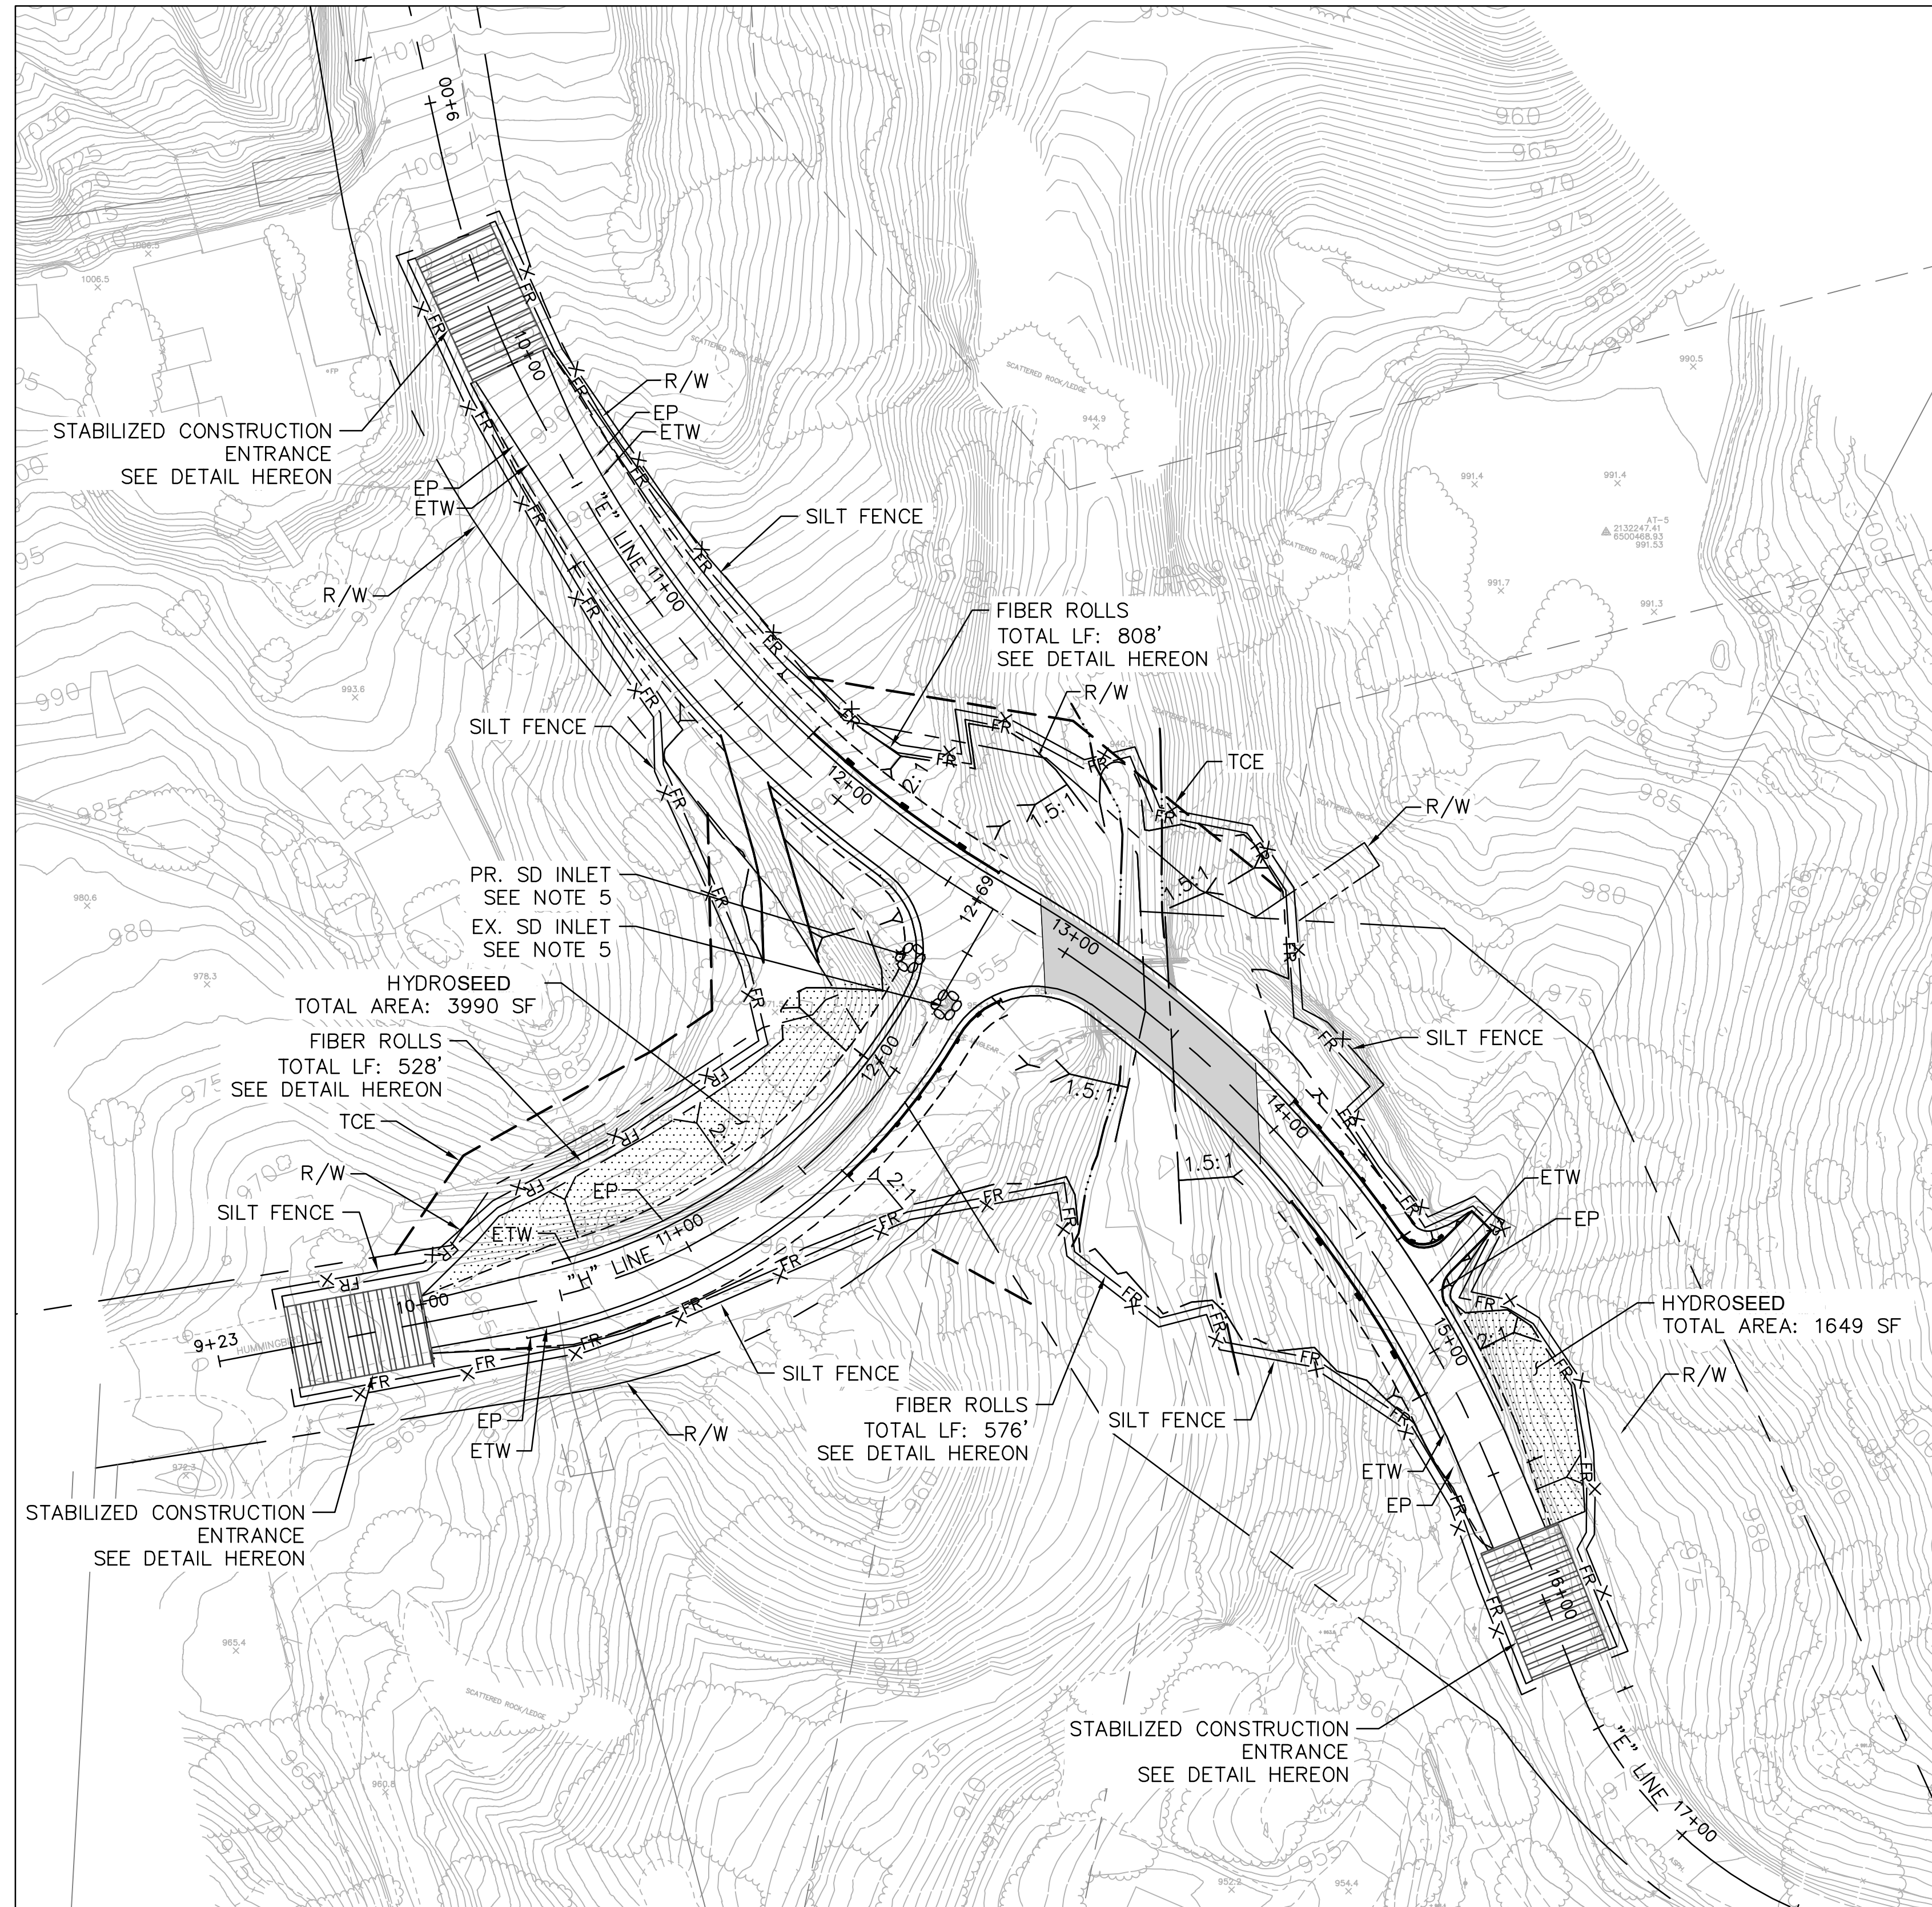


**EROSION CONTROL NOTES:**

1. EROSION AND SEDIMENT CONTROL MEASURES SHALL BE EFFECTIVE FOR CONSTRUCTION IN DISTURBED AREAS THAT WILL NOT BE WORKED FOR 14 DAYS.
2. ALL PAVED AREAS SHALL BE KEPT CLEAR OF EARTH MATERIALS AND DEBRIS, THE SITE SHALL BE MAINTAINED SO AS TO MINIMIZE SEDIMENT-LADEN RUNOFF FROM ENTERING SAND CREEK.
3. ALL FIBER ROLLS TO REMAIN IN PLACE AFTER COMPLETION OF CONSTRUCTION.
4. CONTRACTOR SHALL REVISE EROSION CONTROL PLAN TO ACCOMMODATE CONSTRUCTION SCHEDULE AND PHASING.
5. FOR TEMPORARY DRAINAGE INLET PROTECTION, SEE CALTRANS STANDARD PLAN T62. INLET PROTECTION LOCATION WILL CHANGE DEPENDING ON CONSTRUCTION STAGE.

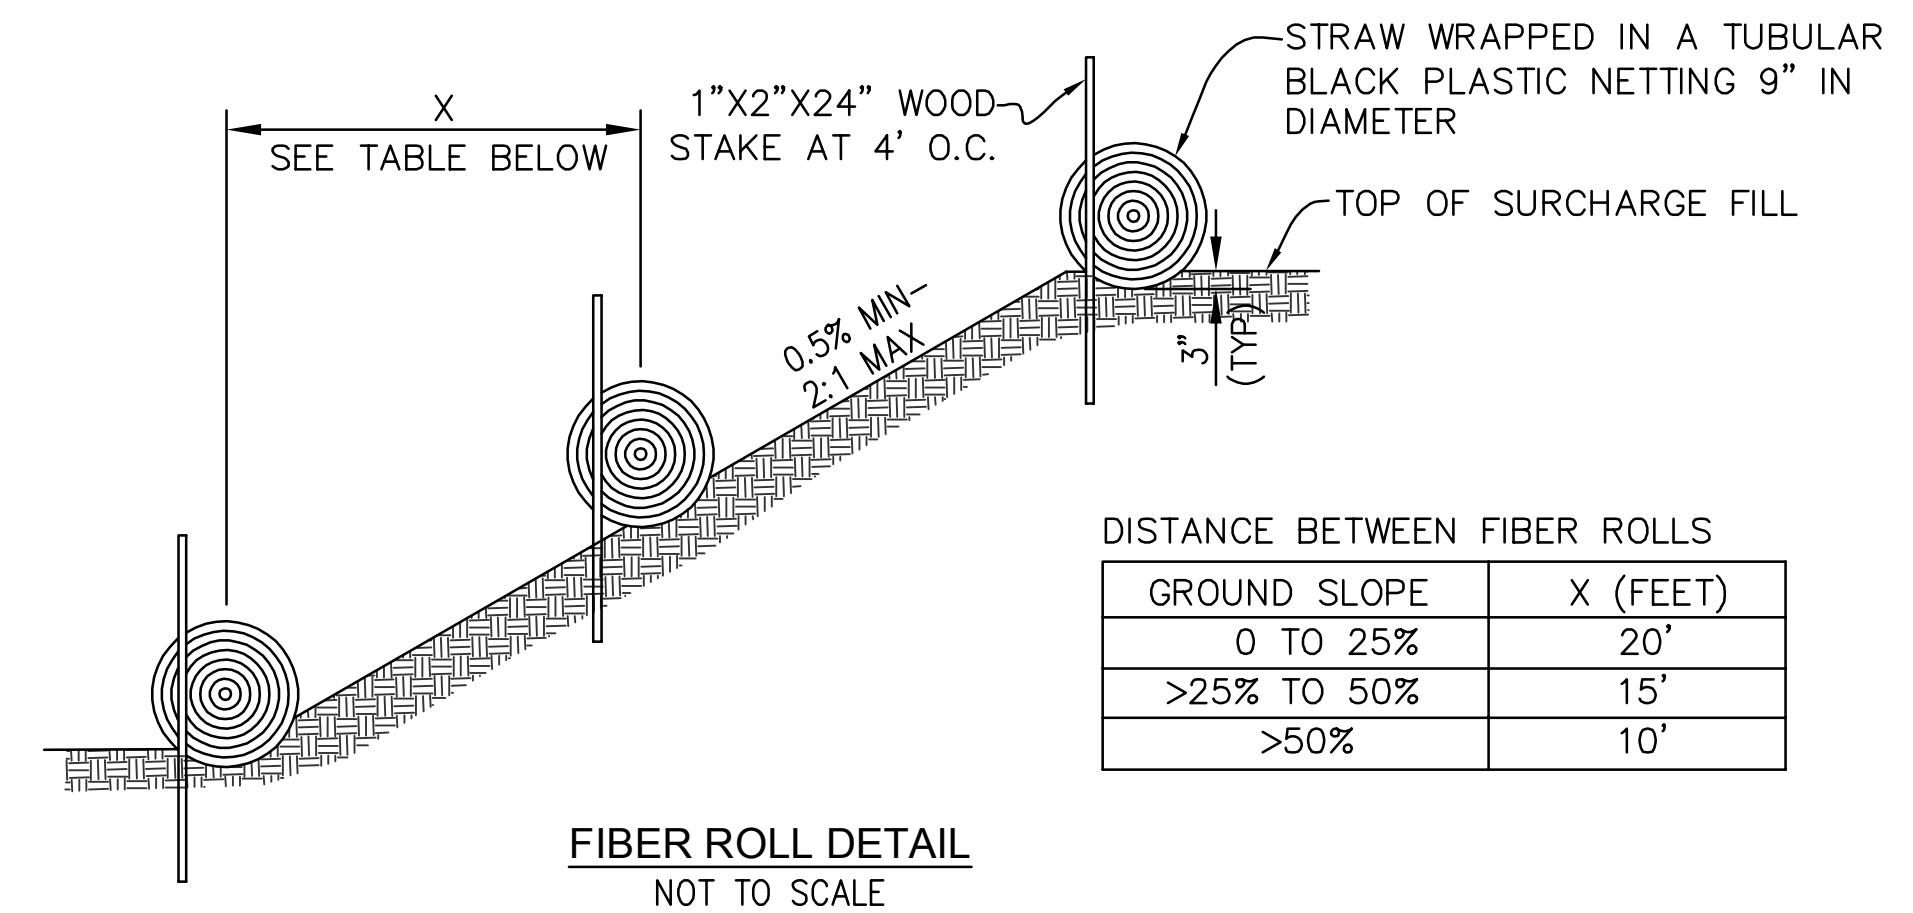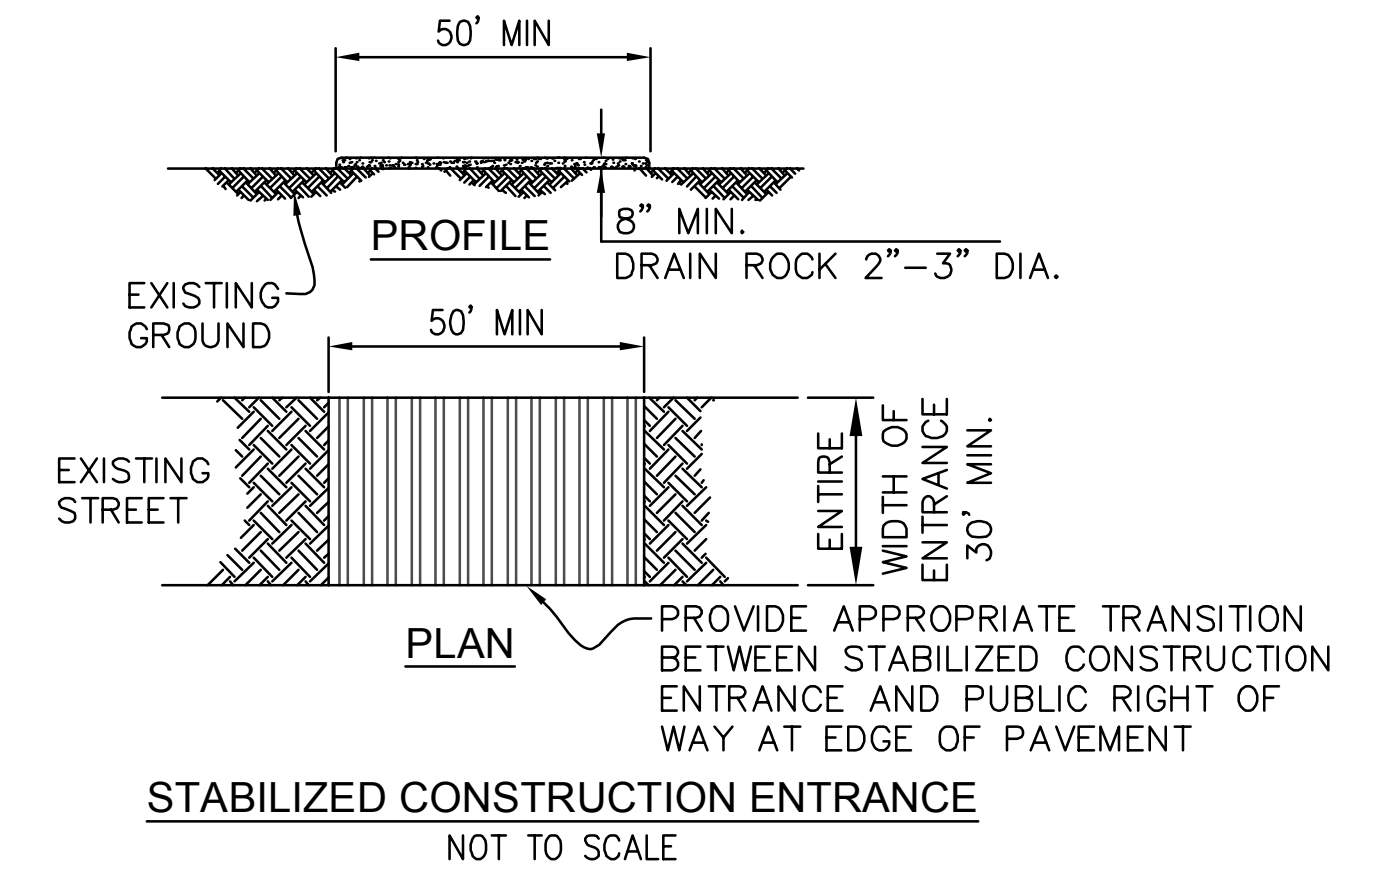

DISTANCE BETWEEN FIBER ROLLS

GROUND SLOPE	X (FEET)
0 TO 25%	20'
>25% TO 50%	15'
>50%	10'

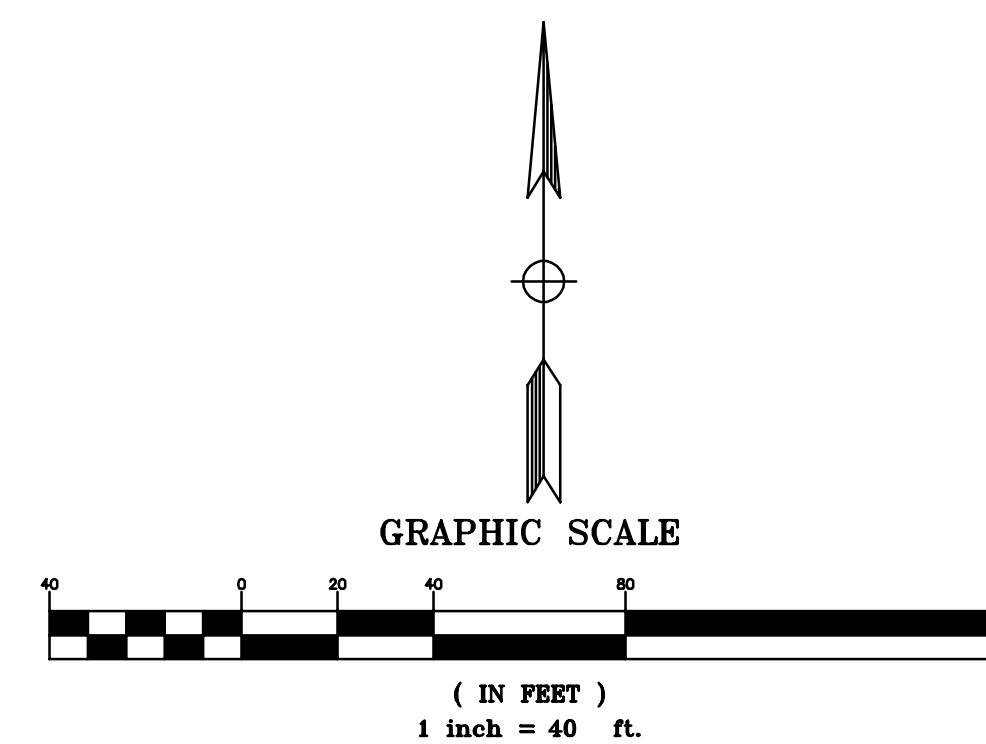


EC-1

DESIGNED:	DATE	RECORD DRAWING	SCALE
SA	3/12/2021	RESIDENT ENGINEER	AS SHOWN
DRAWN:	3/12/2021		
CHECKED:	3/12/2021		

FOR RIGHT OF WAY DATA AND ACCURATE ACCESS DETERMINATION, SEE DOCUMENTS IN THE DEPARTMENT OF PUBLIC WORKS AND PLANNING.



PROJECT
SAND CREEK BRIDGE REPLACEMENT ON ENNIS ROAD
ROAD NO. 2824-2825 BRIDGE NO. 42C0697, BRLO-5942(238)

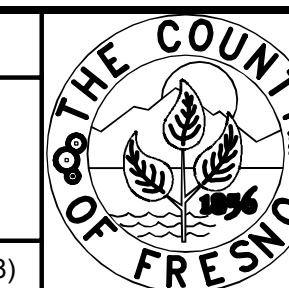


DEPARTMENT OF PUBLIC WORKS AND PLANNING
EROSION CONTROL
DRAWING NO. 11257 SHEET NO. 13 TOTAL 31



- SIGNING NOTES:**
- E PROTECT IN PLACE EXISTING SIGN UNLESS OTHERWISE NOTED
  - 1 REMOVE EXISTING SIGN
  - 2 INSTALL SIGN AND POST AS INDICATED. EXISTING SHALL BE REMOVED AND DISPOSED

- LEGEND**
- EX. UTILITY POLE
  - EX. OVERHEAD ELECTRICAL
  - R/W
  - PR. TCE
  - PR. DAYLIGHT
  - PR. BENCH
  - PR. MGS
  - EX. SIGN
  - PR. SIGN

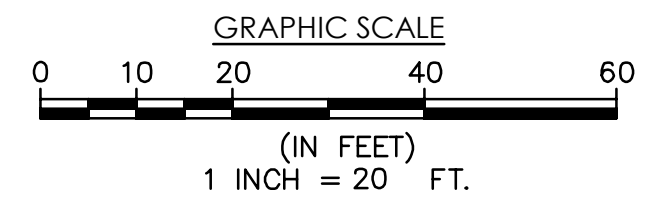

SS-1


	DATE	RECORD DRAWING	SCALE		PROJECT		DEPARTMENT OF PUBLIC WORKS AND PLANNING	
DESIGNED: SA	3/12/2021	RESIDENT ENGINEER	AS SHOWN	4670 Willow Rd., Ste 250 Pleasanton, CA 94566 925.396.7700	SAND CREEK BRIDGE REPLACEMENT ON ENNIS ROAD		SIGNING PLAN	
DRAWN: LS	3/12/2021				ROAD NO. 2824-2825	BRIDGE NO. 42C0697, BRLO-5942(238)		
CHECKED: SA	3/12/2021							DRAWING NO. 11257 SHEET NO. 14 TOTAL 31
FOR RIGHT OF WAY DATA AND ACCURATE ACCESS DETERMINATION, SEE DOCUMENTS IN THE DEPARTMENT OF PUBLIC WORKS AND PLANNING.								



**NOTE:**  
 1. CONTRACTOR SHALL PREPARE AND SUBMIT TRAFFIC CONTROL PLANS FOR COUNTY APPROVAL.  
 2. CONTRACTOR SHALL PROVIDE ACCESS TO DRIVEWAYS AT ALL TIMES.

- LEGEND**
- SURFACE MOUNTED CHANNELIZER
  - ▨ CONSTRUCTION AREA
  - ▨ GRADE EMBANKMENT PER PLAN
  - ▨ TEMPORARY OR PERMANENT ASPHALT CONCRETE AS NOTED IN STAGE CONSTRUCTION CALL-OUTS.
  - K-RAIL (10-FOOT OR 20-FOOT SEGMENTS)
  - ▨ ABSORB 350
  - ++ TYPE II BARRICADE
  - ++ TYPE III BARRICADE
  - ▨ GEOTEXTILE FABRIC
  - TRAFFIC DIRECTION
  - MIDWEST GUARDRAIL SYSTEM
  - ▨ 24"x24" CATCH BASIN
  - ▨ TEMPORARY ROADSIDE SIGN

- STAGE 1 CONSTRUCTION**
- 1-A DEMOLISH EXISTING BRIDGE
  - 1-B INSTALL TEMPORARY K-RAIL, BARRICADES, SURFACE MOUNTED CHANNELIZERS AND TEMPORARY SIGNS.
  - 1-C CONSTRUCT PIPE CULVERT WARPED WINGWALL, RSP AND STORM DRAIN. CONSTRUCT 24"x24" CATCH BASIN AND CONNECT TO EXISTING 24" STORM DRAIN FOR TEMPORARY DRAINAGE.
  - 1-D CONSTRUCT NEW ROADWAY SECTION ALONG ENNIS ROAD. CONSTRUCT NEW BRIDGE ALONG ENNIS ROAD. GRADE SLOPE EMBANKMENTS ALONG ENNIS ROAD EAST OF HUMMINGBIRD LANE, AS SHOWN PER PLANS. INSTALL ACB SLOPE PROTECTION
  - 1-E INSTALL GEOTEXTILE FABRIC OR OTHER MEANS AND METHOD (APPROXIMATELY H=10 FEET) TO RETAIN EXPOSED SOIL. INSTALL GUARDRAIL SYSTEM ALONG ENNIS ROAD.
  - 1-F REGRADE EXISTING DRIVEWAYS TO MEET NEW FINISHED GRADE OR SURFACE PER PLAN. DRIVEWAY SHALL REMAIN ACCESSIBLE DURING CONSTRUCTION.
  - 1-G CONSTRUCT TEMPORARY AC PAVEMENT WHERE NEEDED TO MEET A 16 FT WIDE ROAD BED ALONG ENNIS ROAD AND HUMMINGBIRD LANE.
  - 1-H CONSTRUCT SOUTH BOUND SIDE OF ROADWAY SECTION OF ENNIS ROAD. CONSTRUCT WEST BOUND SIDE OF ROADWAY SECTION OF HUMMINGBIRD LANE. CONSTRUCT ACCESS ROAD. GRADE SLOPE EMBANKMENTS AS SHOWN ON PLANS. INSTALL CRASH CUSHION AND GUARDRAIL SYSTEM.

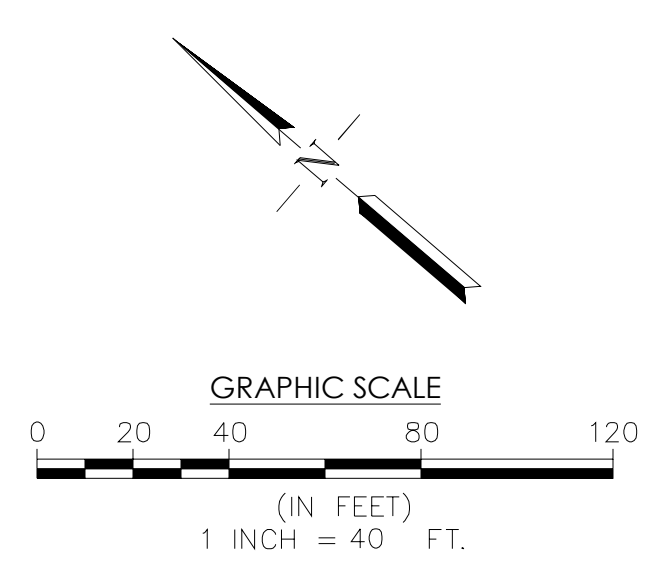

SC-1

DESIGNED: SA	DATE: 3/12/2021	RECORD DRAWING	SCALE	<p>4670 Willow Rd., Ste 250 Pleasanton, CA 94588 925.396.7700</p>		PROJECT		DEPARTMENT OF PUBLIC WORKS AND PLANNING
DRAWN: LS	DATE: 3/12/2021	RESIDENT ENGINEER	AS SHOWN			SAND CREEK BRIDGE REPLACEMENT ON ENNIS ROAD		STAGE CONSTRUCTION - STAGE1
CHECKED: SA	DATE: 3/12/2021					ROAD NO. 2824-2825		BRIDGE NO. 42C0697, BRLO-5942(238)

FOR RIGHT OF WAY DATA AND ACCURATE ACCESS DETERMINATION, SEE DOCUMENTS IN THE DEPARTMENT OF PUBLIC WORKS AND PLANNING.

**NOTE:**



1. CONTRACTOR SHALL PREPARE AND SUBMIT TRAFFIC CONTROL PLANS FOR COUNTY APPROVAL.
2. CONTRACTOR SHALL PROVIDE ACCESS TO DRIVEWAYS AT ALL TIMES.

**LEGEND**

- SURFACE MOUNTED CHANNELIZER
- ▨ CONSTRUCTION AREA
- ▨ GRADE EMBANKMENT PER PLAN
- ▨ TEMPORARY OR PERMANENT ASPHALT CONCRETE AS NOTED IN STAGE CONSTRUCTION CALL-OUTS.
- ▬ K-RAIL (910-FOOT OR 20-FOOT SEGMENTS)
- ▬ ABSORB 350
- ++ TYPE II BARRICADE
- +++ TYPE III BARRICADE
- ▬ GEOTEXTILE FABRIC
- ↔ TRAFFIC DIRECTION
- ▬ MIDWEST GUARDRAIL SYSTEM
- ▬ TEMPORARY ROADSIDE SIGN

**STAGE 2 CONSTRUCTION**

- 2-A SWITCH EXISTING TRAFFIC TO WEST SIDE OF ENNIS ROAD, PERMANENT ASPHALT CONCRETE CONSTRUCTED DURING STAGE 1.
- 2-B DEMOLISH TEMPORARY CATCH BASIN CONNECTION CONSTRUCTED IN STAGE 1. DEMOLISH EXISTING STORM DRAIN SYSTEM. CONSTRUCT STORM DRAIN, RSP, AND OUTLET PROTECTION.
- 2-C DEMOLISH TEMPORARY ASPHALT CONCRETE PAVEMENT. CONSTRUCT NORTH BOUND SIDE OF ENNIS ROAD. CONSTRUCT EAST BOUND SIDE OF HUMMINGBIRD LANE. GRADE SLOPE EMBANKMENTS ALONG ENNIS ROAD AS SHOWN ON PLANS. INSTALL ACB SLOPE PROTECTION.
- 2-D INSTALL GUARDRAIL SYSTEM ALONG ENNIS ROAD AND HUMMINGBIRD LANE.

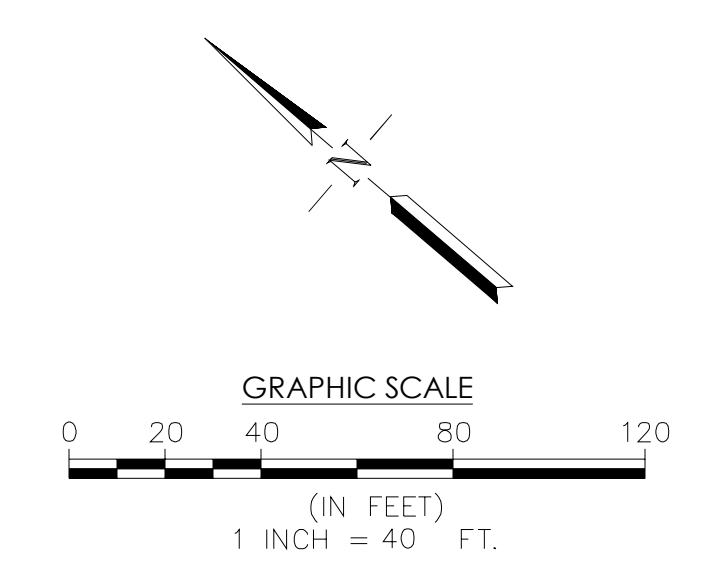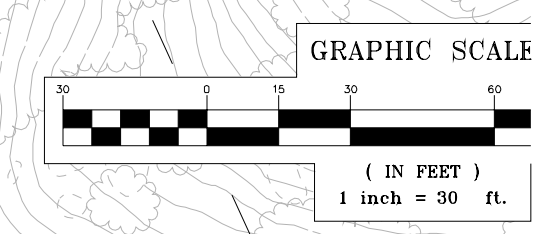


**SC-2**

	DATE	RECORD DRAWING	SCALE		PROJECT		DEPARTMENT OF PUBLIC WORKS AND PLANNING				
DESIGNED: SA	3/12/2021	RESIDENT ENGINEER	AS SHOWN		SAND CREEK BRIDGE REPLACEMENT ON ENNIS ROAD		STAGE CONSTRUCTION - STAGE 2				
DRAWN: LS	3/12/2021	DATE							ROAD NO. 2824-2825	BRIDGE NO. 42C0697, BRLO-5942(238)	DRAWING NO. 11257
CHECKED: SA	3/12/2021							4670 Willow Rd., Ste 250 Pleasanton, CA 94588 925.396.7700	SHEET NO. 16	TOTAL 31	
FOR RIGHT OF WAY DATA AND ACCURATE ACCESS DETERMINATION, SEE DOCUMENTS IN THE DEPARTMENT OF PUBLIC WORKS AND PLANNING.											



P:\ENGIN\20141070\FRESNO-SAND\_CREEK\_BRIDGE\_ON\_ENNIS\_ROAD\ENG\SHEETS\DETOUR.DWG

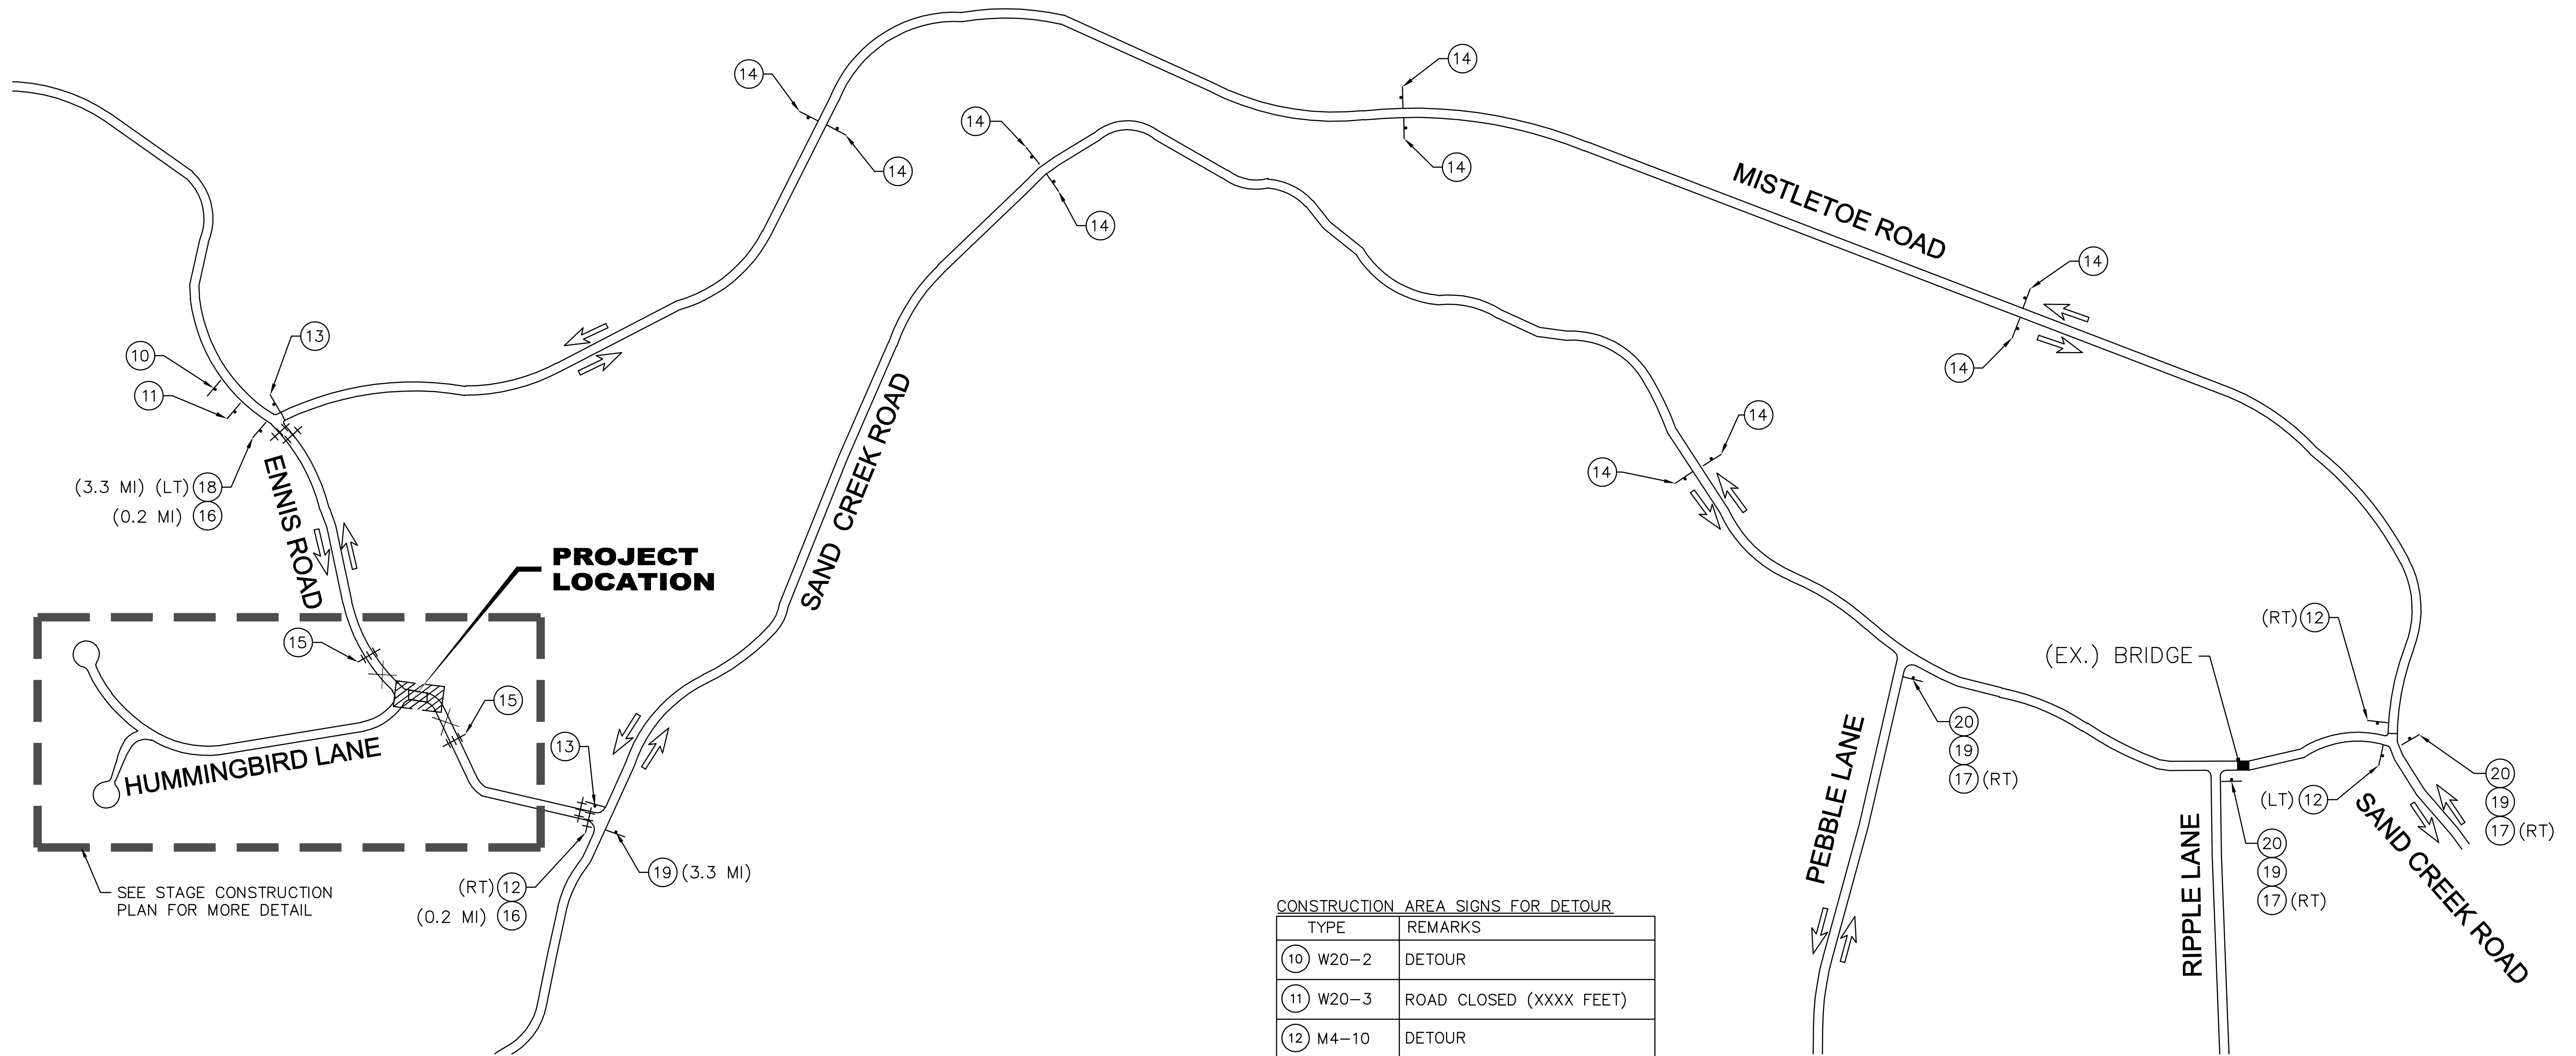

(3.3 MI) (LT) 18  
(0.2 MI) 16

**PROJECT LOCATION**

HUMMINGBIRD LANE

SEE STAGE CONSTRUCTION PLAN FOR MORE DETAIL

(RT) 12  
(0.2 MI) 16

(19) (3.3 MI)


CONSTRUCTION AREA SIGNS FOR DETOUR	
TYPE	REMARKS
10 W20-2	DETOUR
11 W20-3	ROAD CLOSED (XXXX FEET)
12 M4-10	DETOUR
13 M4-8A	END DETOUR
14 M4-8	DETOUR
15 R11-2	ROAD CLOSED
16 R11-3a	ROAD CLOSED XX MILES AHEAD LOCAL TRAFFIC ONLY
17 W1-6	"ARROW"
18 M4-9	DETOUR
19 SC3 (CA)	DETOUR
20 MOD	ROAD CLOSED AHEAD ON ENNIS ROAD LOCAL TRAFFIC ONLY USE MISTLETOE ROAD

**NOTES:**

1. LOCATION OF CONSTRUCTION AREA SIGNS SHOWN ARE APPROXIMATE. EXACT LOCATION WILL BE DETERMINED BY THE ENGINEER.
2. ALL SIGNS ARE STATIONARY MOUNTED.
3. SIGNAGE SHALL COMPLY WITH 2014 CA MUTCD.

**LEGEND:**

- PROPOSED ROADSIDE SIGN
- × ROADWAY CLOSURE
- ← DIRECTION OF TRAFFIC
- ++ TYPE III BARRICADE

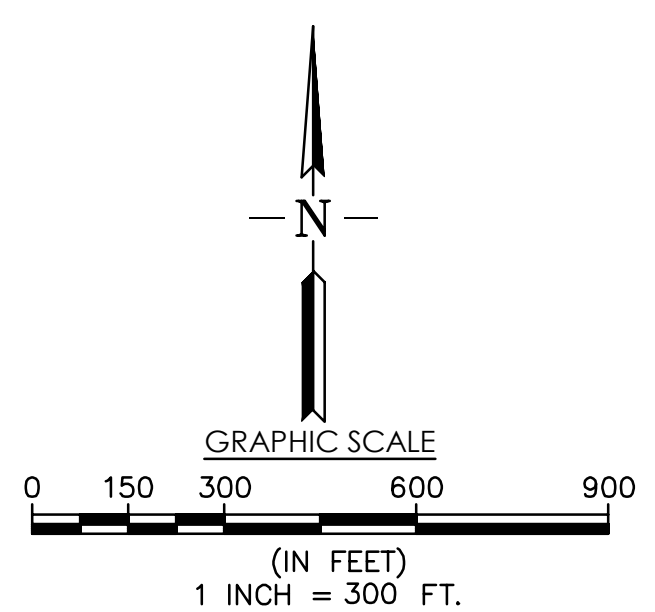


DE-1

	DATE	RECORD DRAWING	SCALE	<b>BKF</b>	PROJECT	DEPARTMENT OF PUBLIC WORKS AND PLANNING
DESIGNED: SA	3/12/2021	RESIDENT ENGINEER	AS SHOWN		<b>SAND CREEK BRIDGE REPLACEMENT ON ENNIS ROAD</b>	<b>DETOUR PLAN</b>
DRAWN: LS	3/12/2021				ROAD NO. 2824-2825	BRIDGE NO. 42C0697, BRLO-5942(238)
CHECKED: SA	3/12/2021				DRAWING NO. 11257	SHEET NO. 17
FOR RIGHT OF WAY DATA AND ACCURATE ACCESS DETERMINATION, SEE DOCUMENTS IN THE DEPARTMENT OF PUBLIC WORKS AND PLANNING.						


FOR ACCURATE RIGHT OF WAY AND ACCESS DATA, SEE 'ROADWAY PLANS'




**PROFILE GRADE**  
NO SCALE

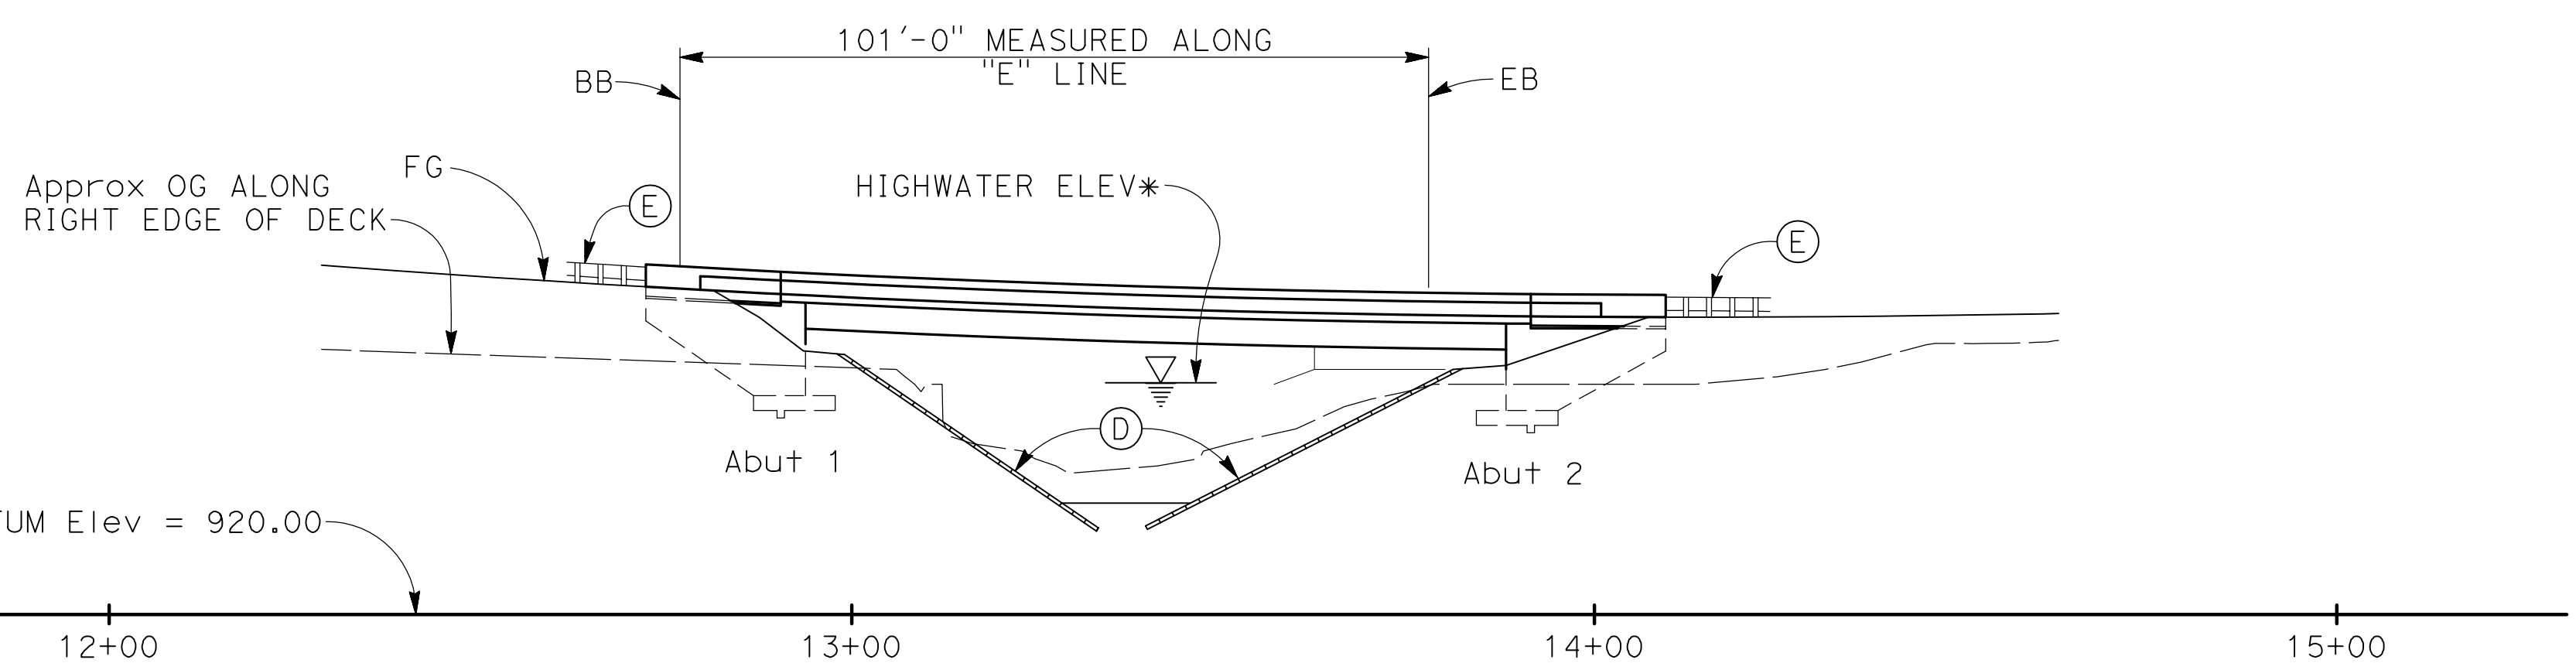

**DEVELOPED ELEVATION** \* SEE "HYDROLOGIC SUMMARY" ON "FOUNDATION PLAN" SHEET  
1" = 20'

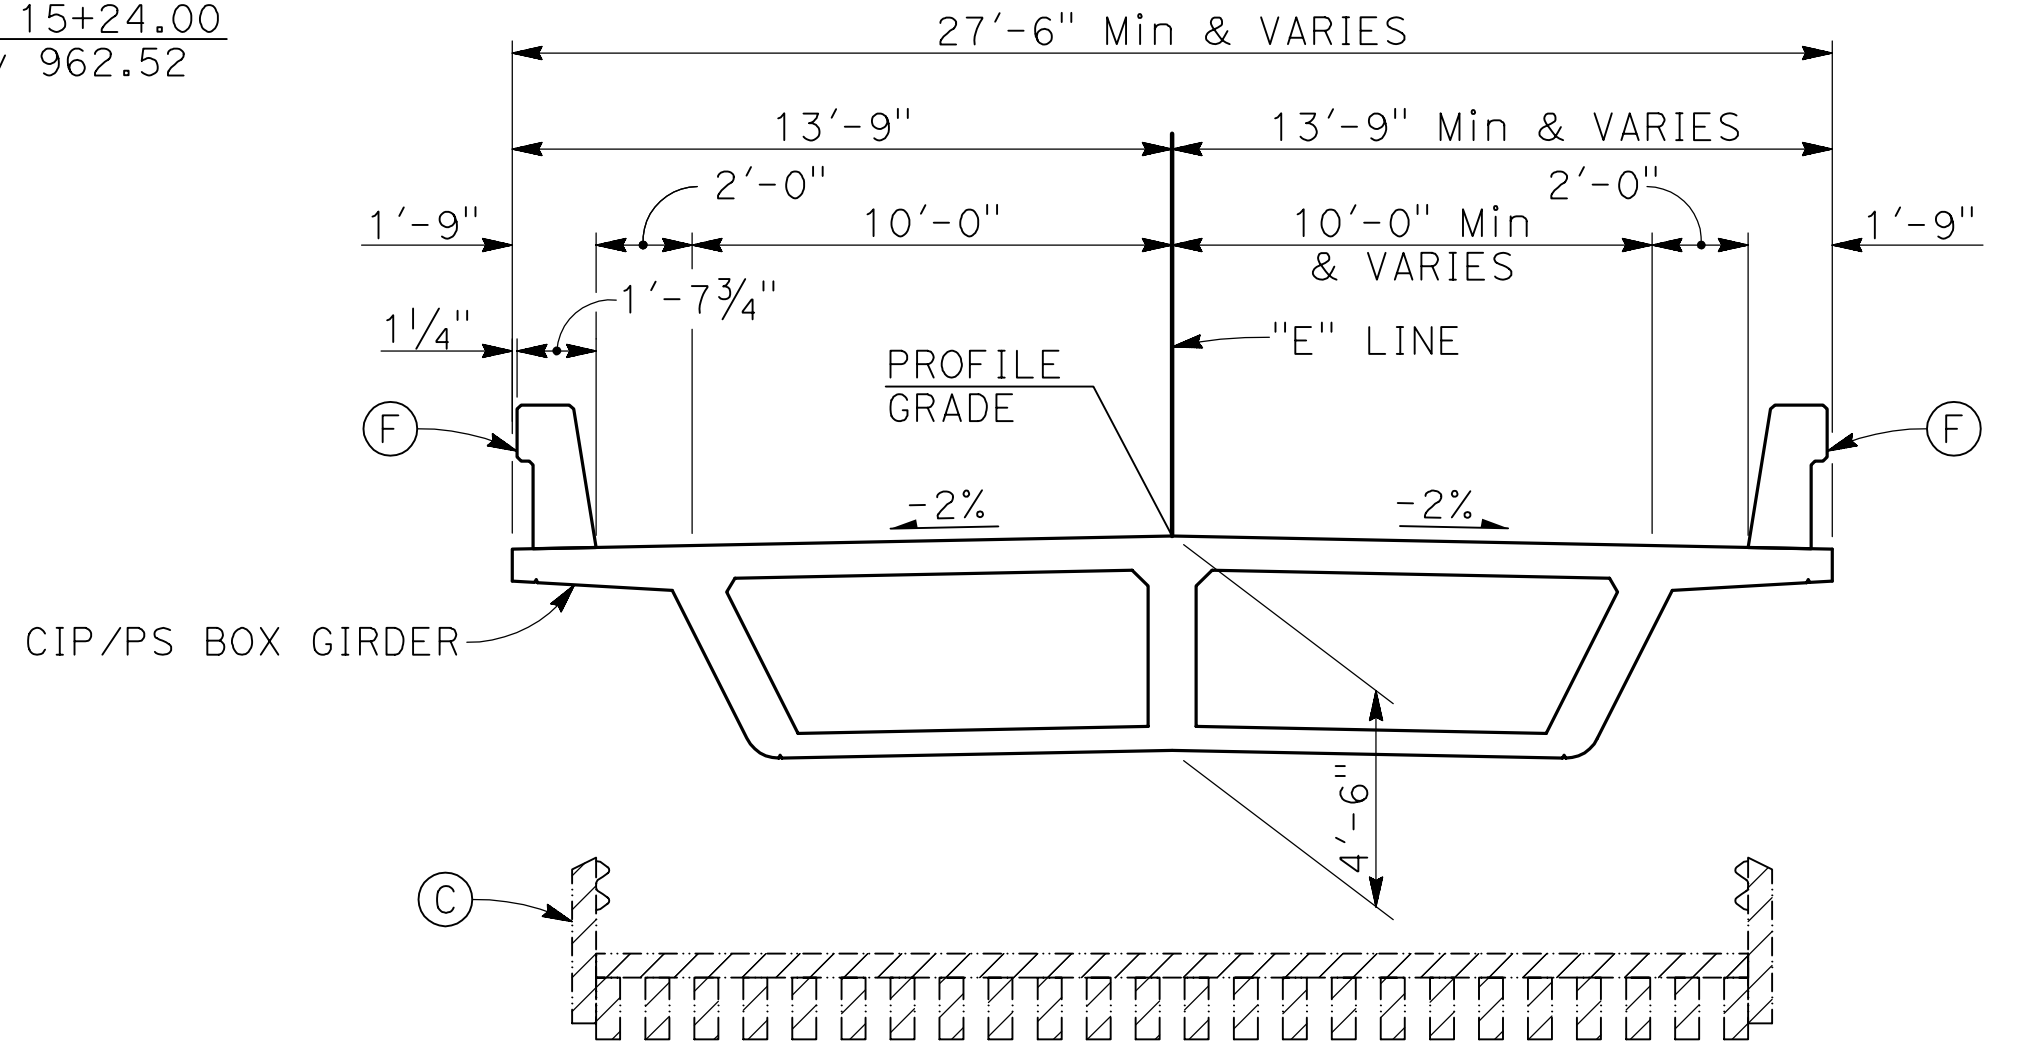

**TYPICAL SECTION**  
1/4" = 1'-0"

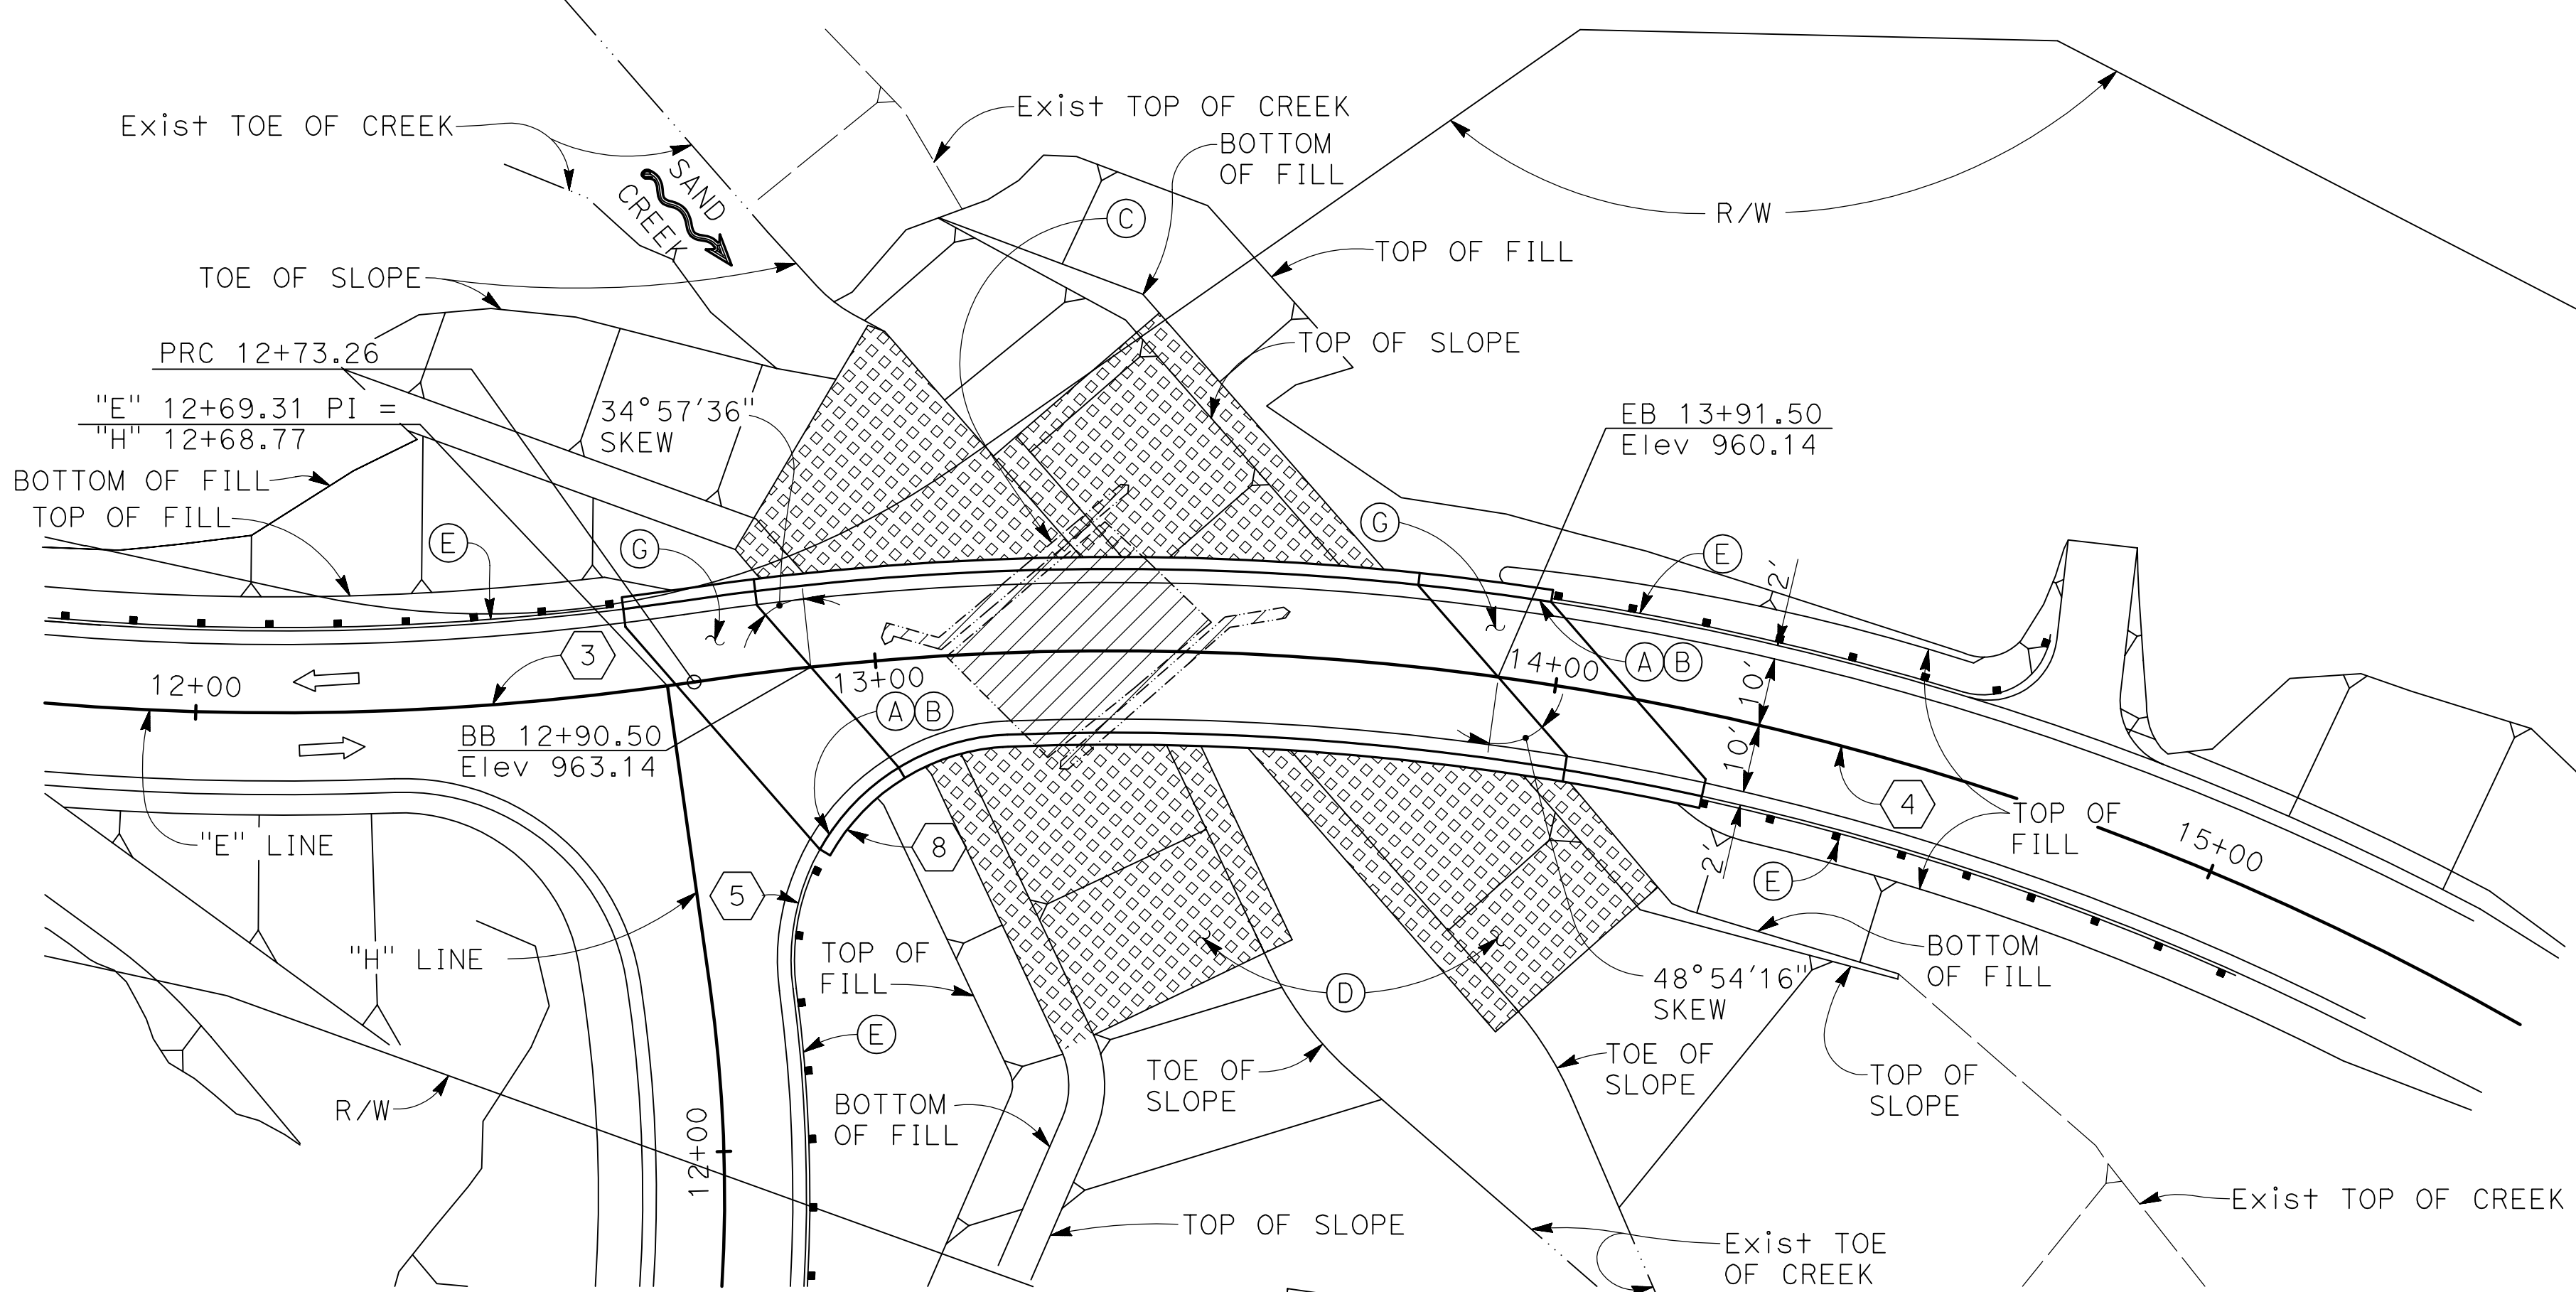

**PLAN**  
1" = 20'


- 3  
Curve Data  
Layout Line  
R = 410'  
Δ = 31°10'58"  
T = 114.41'  
L = 223.14'
- 4  
Curve Data  
Layout Line  
R = 415'  
Δ = 38°18'08"  
T = 144.12'  
L = 277.43'
- 5  
Curve Data  
Layout Line  
R = 33'  
Δ = 95°16'50"  
T = 36.19'  
L = 54.88'
- 8  
Curve Data  
Layout Line  
R = 31.25'  
Δ = 58°29'47"  
T = 17.50'  
L = 31.90'

- NOTES:
- (A) Paint "BRIDGE No. 42C0697"
  - (B) Paint "SAND CREEK BRIDGE"
  - (C) Remove existing Sand Creek Bridge
  - (D) ACB Revetment System, see "ROADWAY PLANS"
  - (E) MGS, See "ROADWAY PLANS"
  - (F) Concrete Barrier Type 836
  - (G) Structure Approach Slab
1. For "GENERAL NOTES", see "DECK CONTOURS" sheet
  2. For "SPREAD FOOTING DATA TABLE", see "FOUNDATION PLAN" sheet

- LEGEND:
- Bridge Removal
  - Indicates Existing Structure
  - Indicates Traffic Direction


NOTE:  
THE CONTRACTOR MUST VERIFY ALL CONTROLLING FIELD DIMENSIONS BEFORE ORDERING OR FABRICATING ANY MATERIAL

DESIGNED: SGS		DATE: 1/25/21	RECORD DRAWING		SCALE: AS SHOWN	<b>BIGGS CARDOSA ASSOCIATES INC</b> STRUCTURAL ENGINEERS 5250 N. Palm Avenue, Suite 211 Fresno, California 93704 559-449-8686		PROJECT: SAND CREEK BRIDGE REPLACEMENT ON ENNIS ROAD		DEPARTMENT OF PUBLIC WORKS AND PLANNING	
DRAWN: AR		DATE: 1/25/21						ROAD NO. 2824-2825		BRIDGE NO. 42C0697, BRLO-5942(238)	GENERAL PLAN
CHECKED: ML		DATE: 1/25/21									

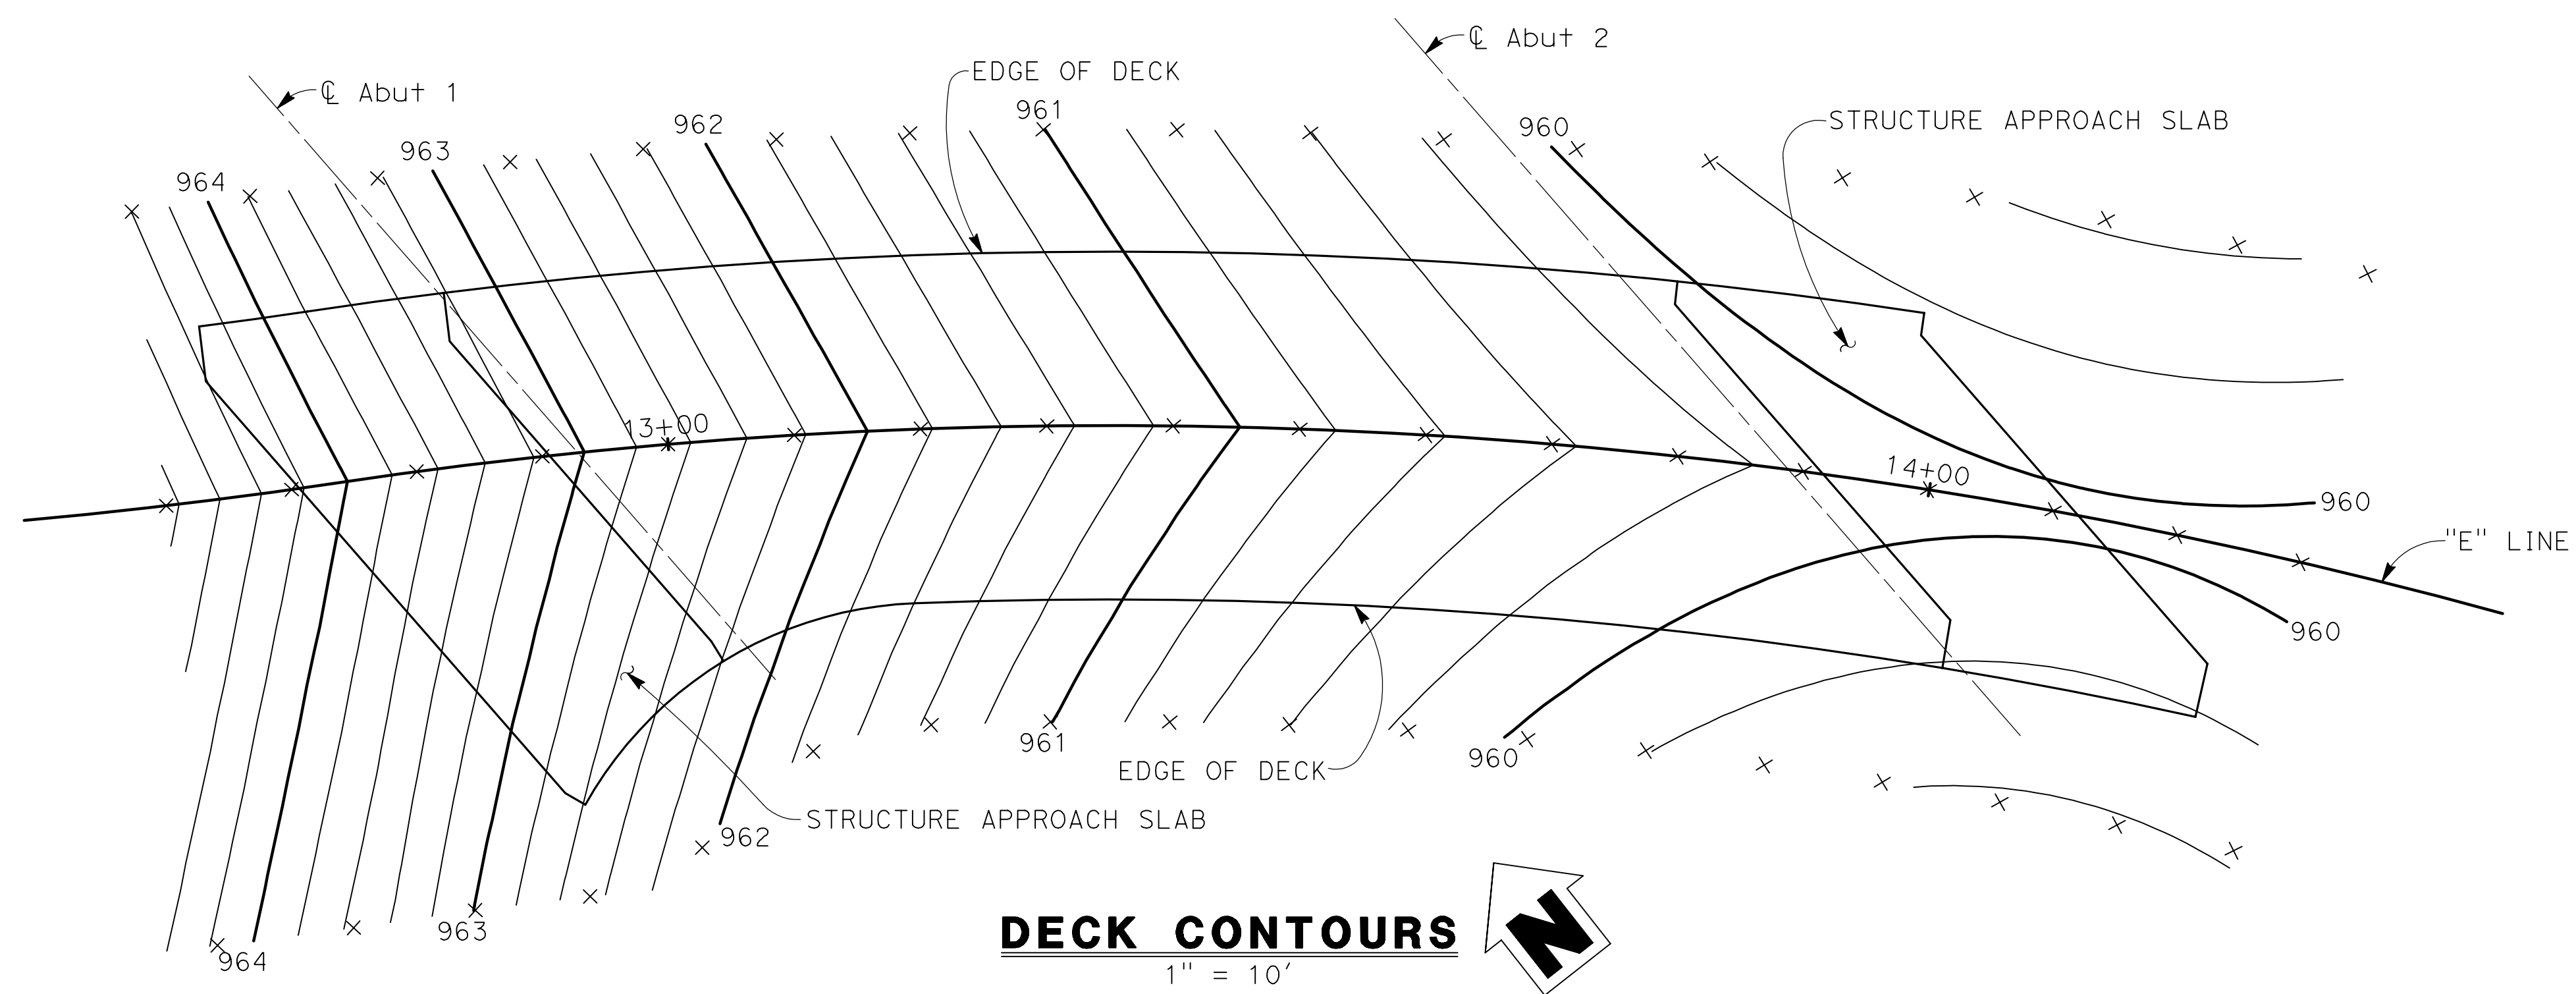


**DECK CONTOURS**  
1" = 10'

- NOTES:
1. Contours indicate top of deck elevation.
  2. x Indicates 10 foot intervals measured along "E" Line.
  3. Contour interval = 0.2'
  4. Contours do not include camber or falsework settlement.

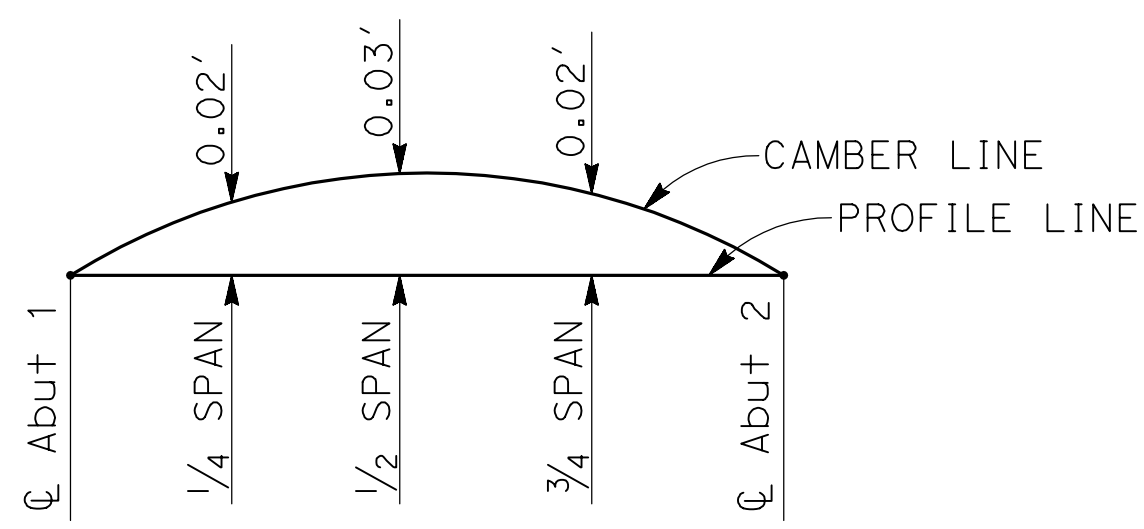

NOTE:  
Camber does not include allowance for falsework settlement

**CAMBER DIAGRAM**  
NO SCALE

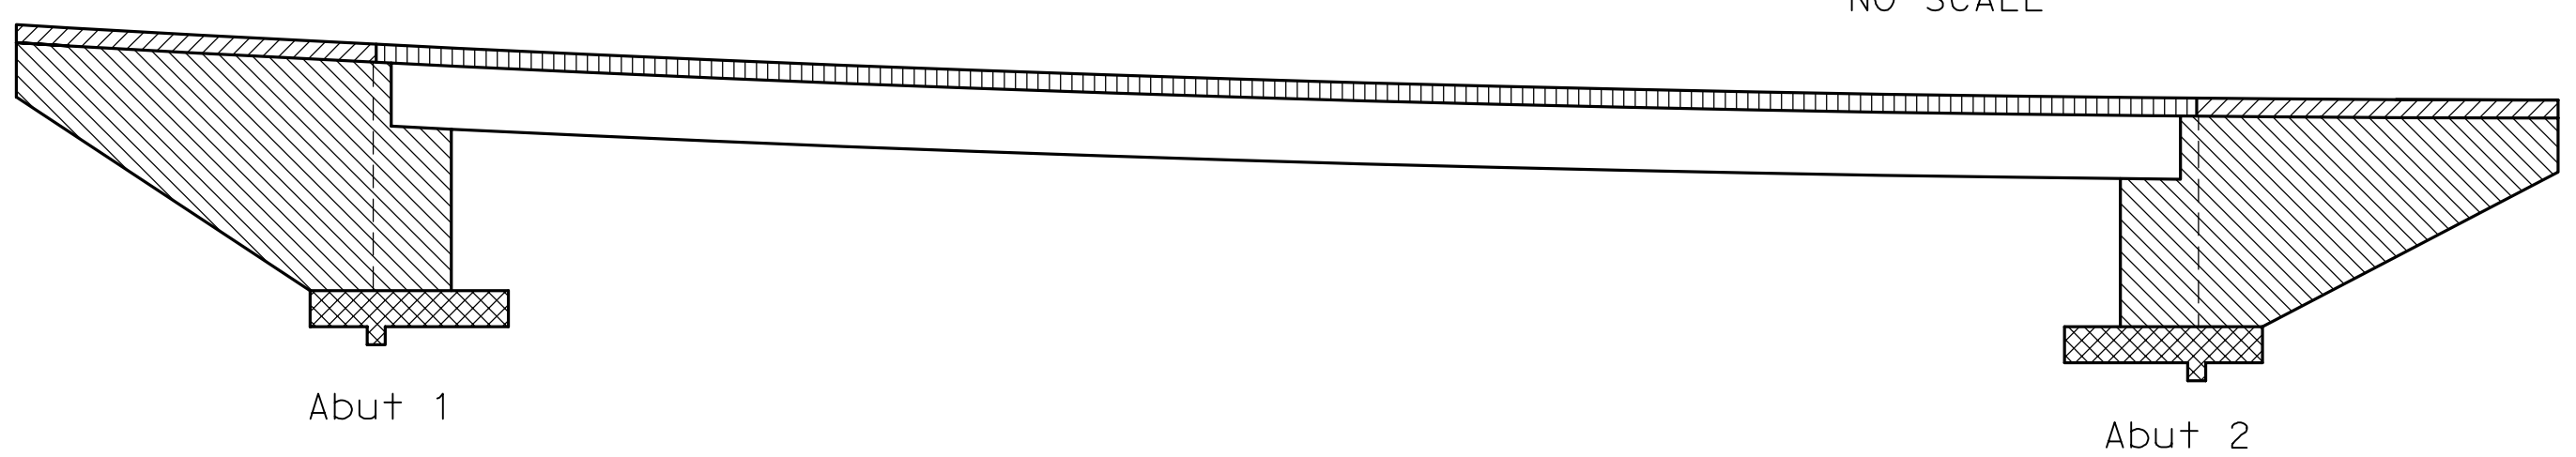

- LEGEND:
- STRUCTURAL CONCRETE, BRIDGE (f'c = 4.0 ksi AT 28 DAYS)
  - STRUCTURAL CONCRETE, BRIDGE
  - STRUCTURAL CONCRETE, BRIDGE FOOTING
  - STRUCTURAL CONCRETE, BRIDGE (POLYMER FIBER) (f'c = 4.0 ksi AT 28 DAYS)
  - STRUCTURAL CONCRETE, APPROACH SLAB

**CONCRETE STRENGTH AND TYPE LIMITS**  
NO SCALE

NOTE:  
THE CONTRACTOR MUST VERIFY ALL CONTROLLING FIELD DIMENSIONS BEFORE ORDERING OR FABRICATING ANY MATERIAL

**GENERAL NOTES**  
**LOAD & RESISTANCE FACTOR DESIGN**


DESIGN: AASHTO LRFD Bridge Design Specifications, 6th Edition and California Amendments, preface dated January 2014

SEISMIC DESIGN: Caltrans Seismic Design Criteria (SDC) Version 1.7

DEAD LOAD: Includes 35 psf for future wearing surface.

LIVE LOAD: HL93 and permit design load

SEISMIC LOAD: Soil profile: C, Vs30 = 500 m IS  
Moment magnitude: M6.2  
Peak ground acceleration: 0.22g

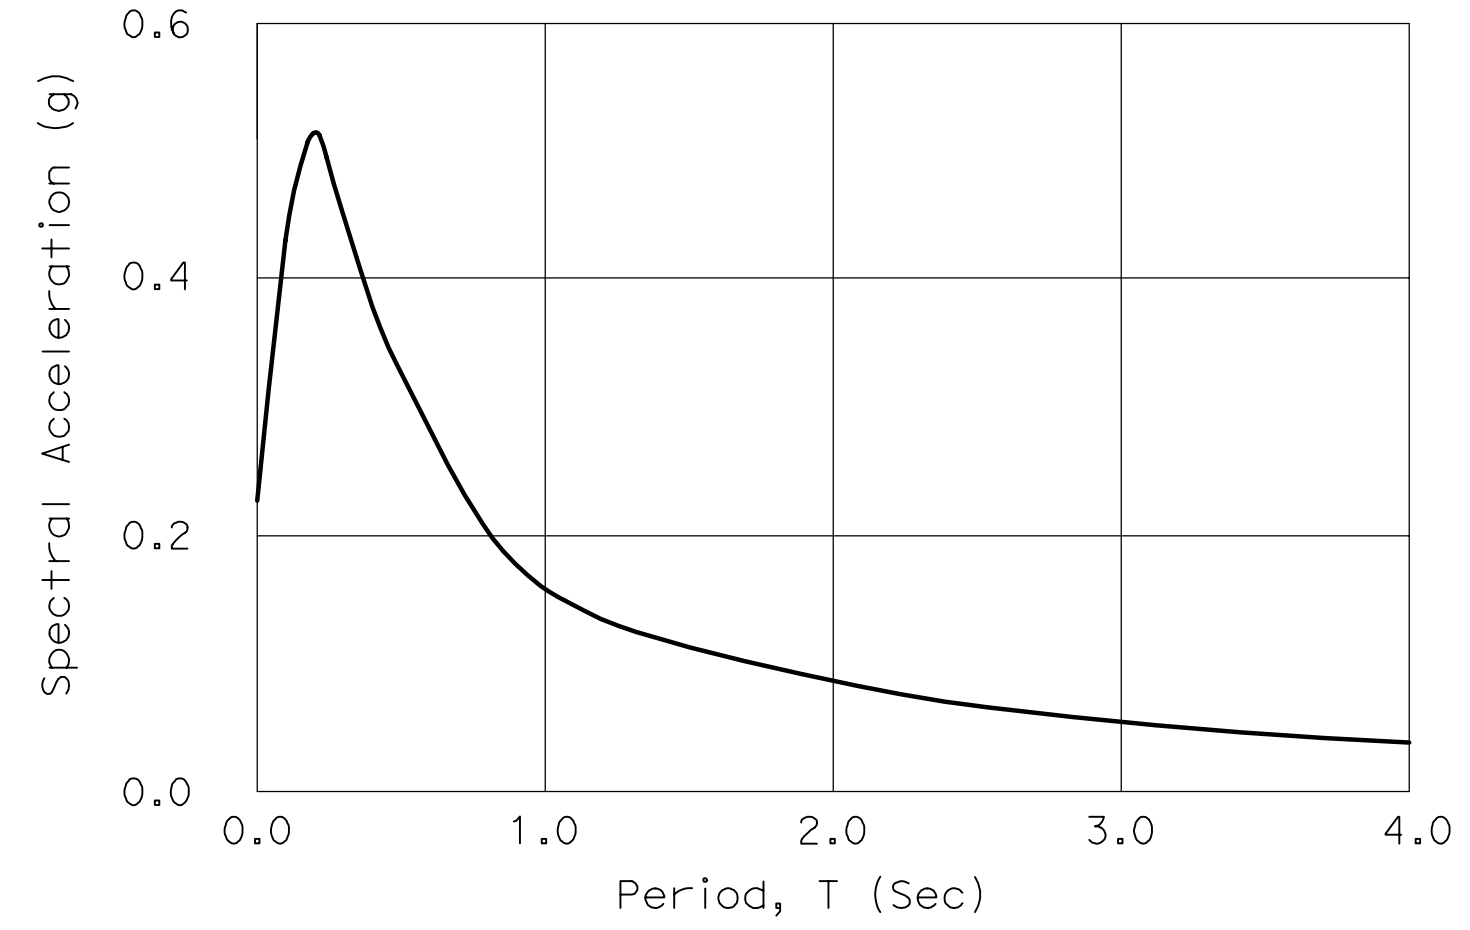

**ARS DESIGN CURVE**  
NO SCALE

CONCRETE: f<sub>y</sub> = 60 ksi  
f'c = 3.6 ksi (except as shown on "CONCRETE STRENGTH & TYPE LIMITS" diagram)  
n = 8

**CALTRANS 2015 STANDARD PLANS**

- A3A ABBREVIATIONS (SHEET 1 OF 3)
- A3B ABBREVIATIONS (SHEET 2 OF 3)
- A3C ABBREVIATIONS (SHEET 3 OF 3)
- A10A LEGEND-LINES AND SYMBOLS (SHEET 1 OF 5)
- RSP A10B LEGEND-LINES AND SYMBOLS (SHEET 2 OF 5)
- A10C LEGEND-LINES AND SYMBOLS (SHEET 3 OF 5)
- A10D LEGEND-LINES AND SYMBOLS (SHEET 4 OF 5)
- A10E LEGEND-LINES AND SYMBOLS (SHEET 5 OF 5)
- BO-1 BRIDGE DETAILS
- BO-5 BRIDGE DETAILS
- BO-13 BRIDGE DETAILS
- B6-21 JOINT SEALS (MAXIMUM MOVEMENT RATING = 2")
- B7-1 BOX GIRDER DETAILS
- RSP B8-5 CAST-IN-PLACE POST-TENSIONED GIRDER DETAILS
- B14-5 WATER SUPPLY LINE (DETAILS) (PIPE SIZES LESS THAN 4")


**CALTRANS 2018 STANDARD PLANS**

- RSP B11-79 CONCRETE BARRIER TYPE 836 DETAILS No. 1
- RSP B11-80 CONCRETE BARRIER TYPE 836 DETAILS No. 2

- LEGEND:
- Indicates Standard Plan sheet No.
  - Indicates Detail No.
  - Indicates Section No.
  - Indicates sheet No. shown on
  - Indicates Detail No.
  - Indicates sheet No. shown on


DESIGNED: SGS	DATE: 1/25/21	RECORD DRAWING: RESIDENT ENGINEER	SCALE: AS SHOWN	<b>BIGGS CARDOSA ASSOCIATES INC</b> STRUCTURAL ENGINEERS 5250 N. Palm Avenue, Suite 211 Fresno, California 93704 559-449-8686	PROJECT: SAND CREEK BRIDGE REPLACEMENT ON ENNIS ROAD		DEPARTMENT OF PUBLIC WORKS AND PLANNING
DRAWN: SMH	DATE: 1/25/21		ROAD NO. 2824-2825		BRIDGE NO. 42C0697, BRLO-5942(238)		DECK CONTOURS
CHECKED: ML	DATE: 1/25/21						DRAWING NO. 11257 SHEET NO. 19 TOTAL 31

FOR ACCURATE RIGHT OF WAY AND ACCESS DATA, SEE 'ROADWAY PLANS'

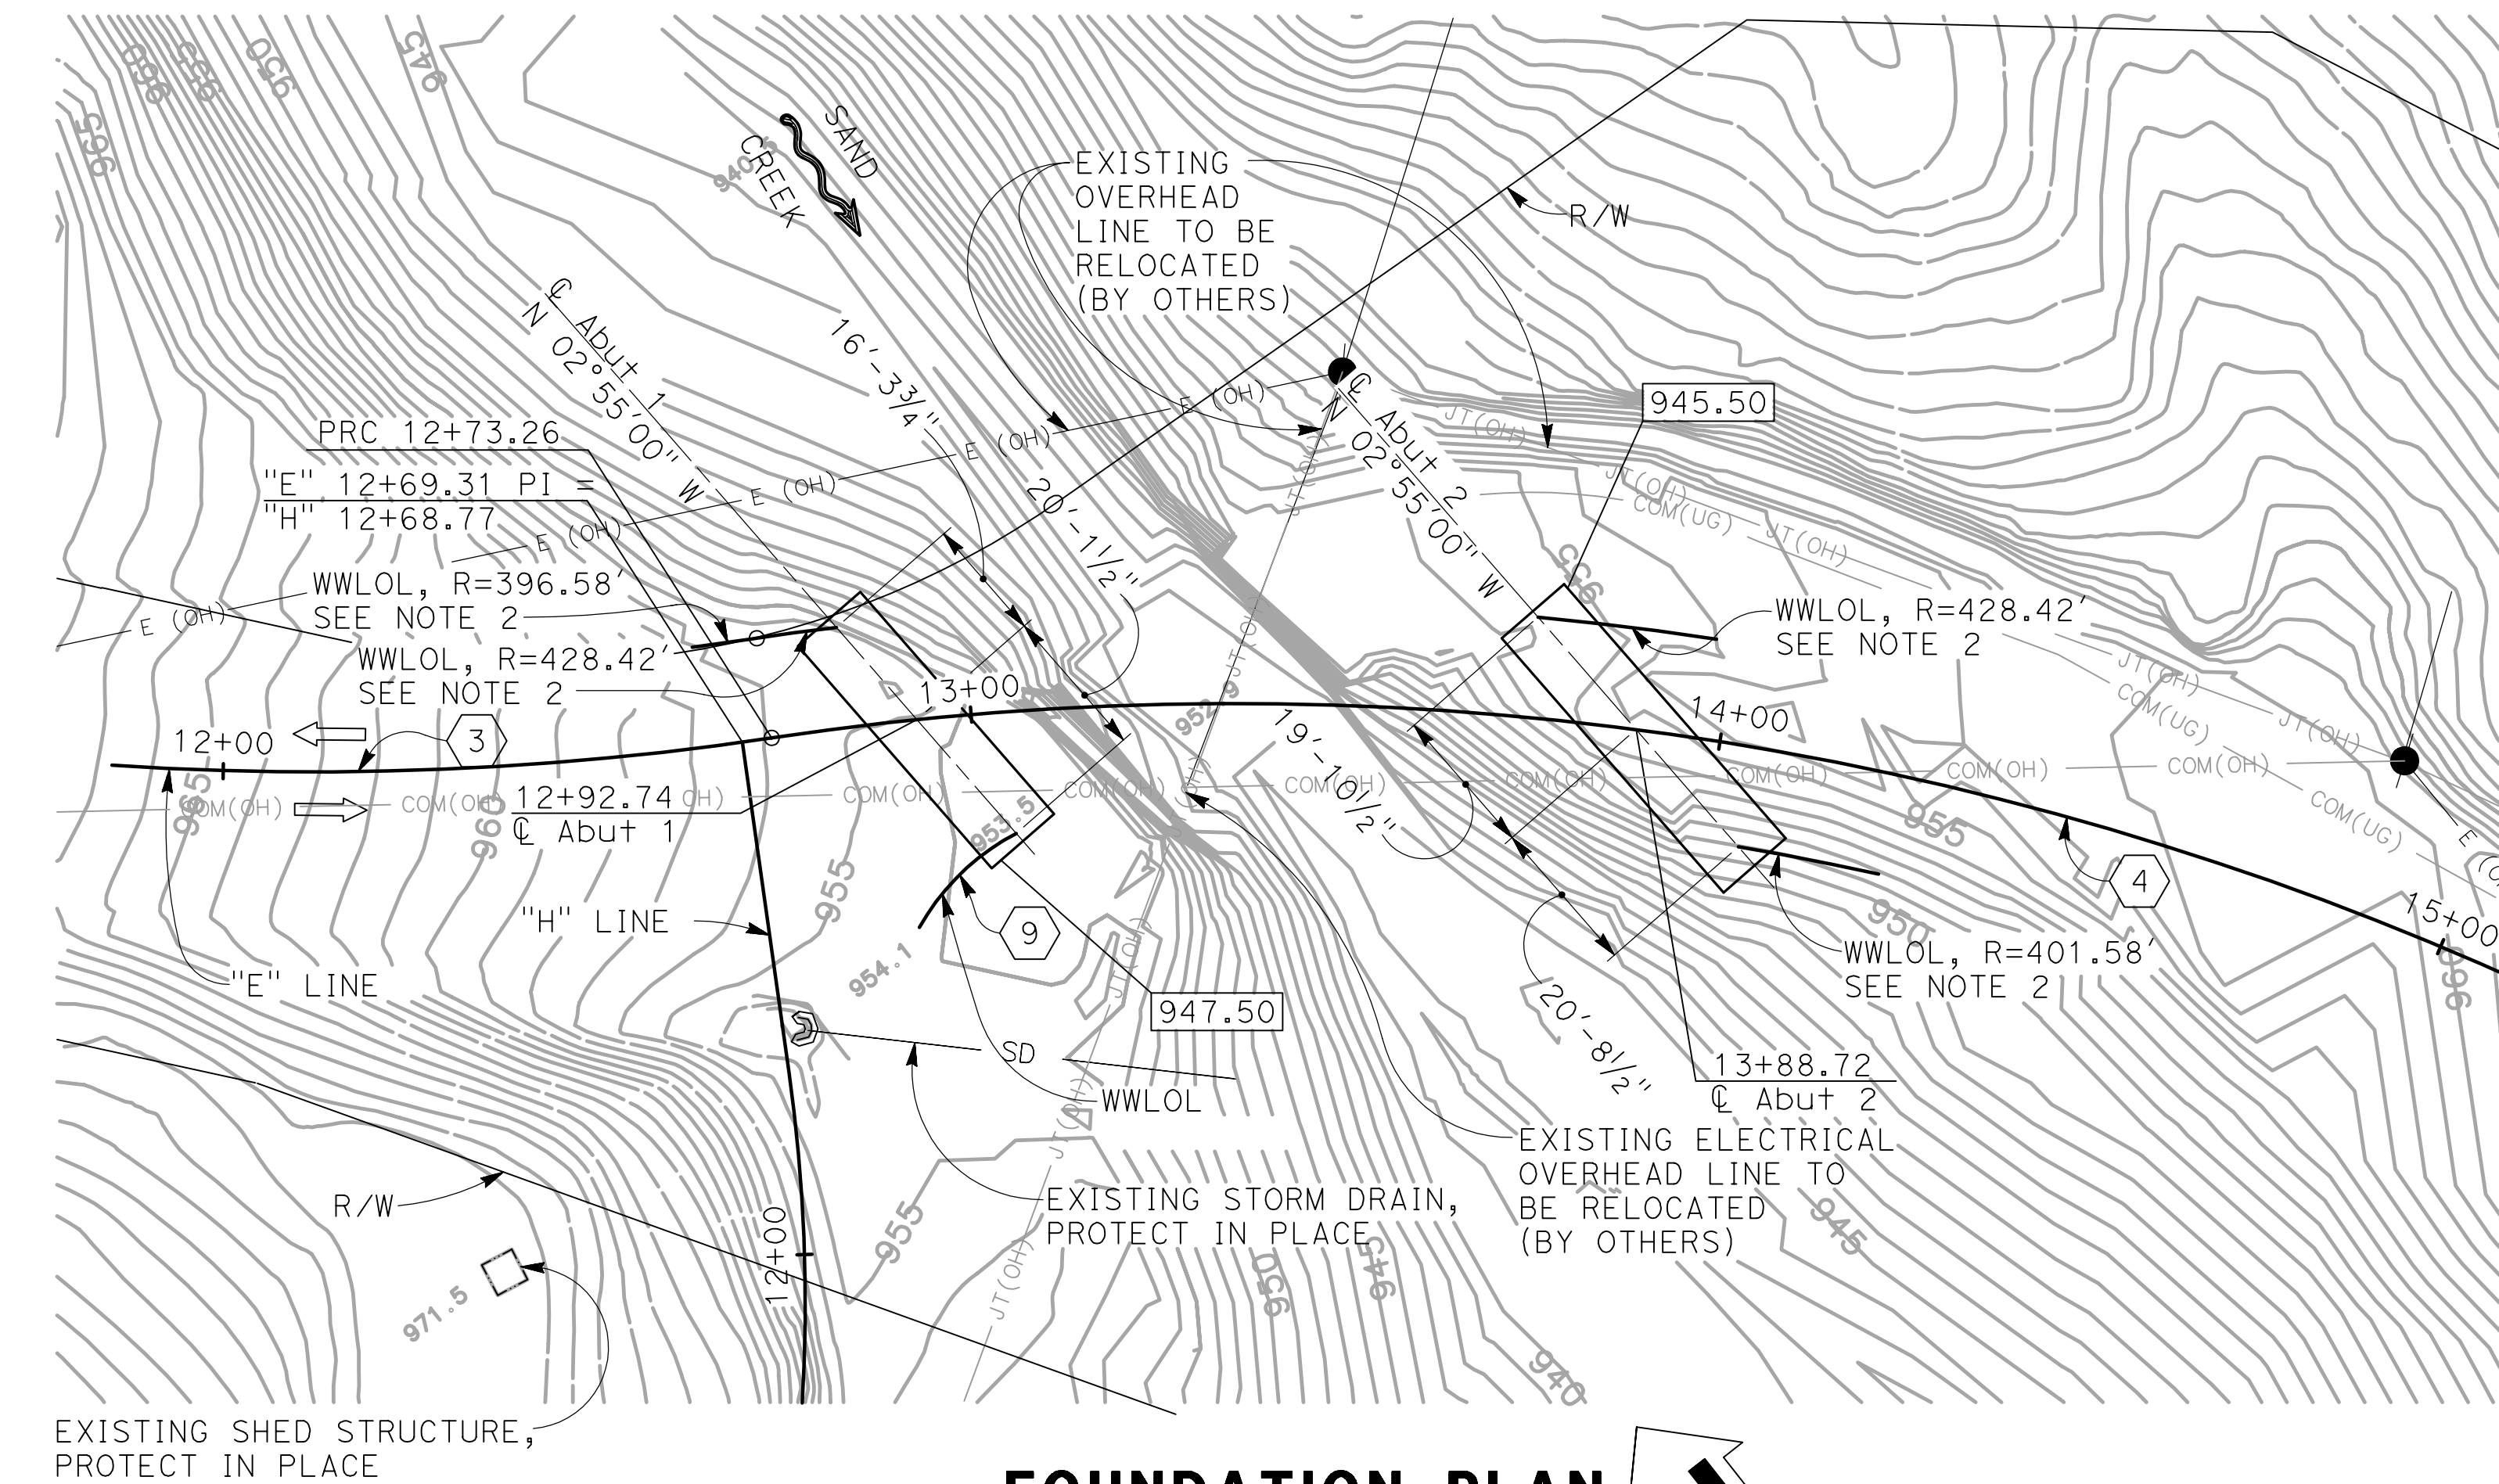

**FOUNDATION PLAN**

1" = 20'

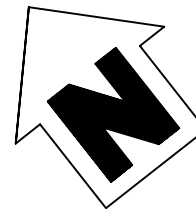

**SPREAD FOOTING DATA TABLE**

LOCATION	SERVICE <sup>2</sup> PERMISSIBLE NET CONTACT STRESS (SETTLEMENT) (ksf)	STRENGTH / CONSTRUCTION <sup>3</sup> FACTORED GROSS NOMINAL BEARING RESISTANCE $\phi_b = 0.45$ (ksf), SEE NOTE 4	EXTREME EVENT <sup>3</sup> FACTORED GROSS NOMINAL BEARING RESISTANCE $\phi_h = 1.00$ (ksf)
ABUTMENT 1	9.0	28.0	N/A
ABUTMENT 2	9.0	28.0	N/A

NOTES:


- Controlling load combination is the one resulting in the highest ratio of  $q_{gu}/q_R$  for foundations on soil, or  $q_{g \max}/q_R$  for foundation on rock.
- Controlling load combination for Service Limit State is the one resulting in the highest ratio of  $q_{nu}/q_{pn}$  for foundations on soil, or  $q_{g \max}/q_R$  for foundations on rock.
- Controlling load combination for Strength, Construction, and Extreme Event is the one resulting in the highest ratio of  $q_{gu}/q_R$  for foundations on soil, or  $q_{g \max}/q_R$  for foundations on rock.
- The value below is the Gross Nominal Bearing Capacity. The Resistance Factor of 0.45 has not been applied.

NOTE:  
THE CONTRACTOR MUST VERIFY ALL CONTROLLING FIELD DIMENSIONS BEFORE ORDERING OR FABRICATING ANY MATERIAL

Curve Data Layout Line	Curve Data Layout Line	Curve Data Layout Line	Curve Data Layout Line
R = 410'	R = 415'	R = 33'	R = 31.58'
$\Delta = 31^\circ 10' 58''$	$\Delta = 38^\circ 18' 08''$	$\Delta = 95^\circ 16' 50''$	$\Delta = 33^\circ 02' 06''$
T = 114.41'	T = 144.12'	T = 36.19'	T = 9.37'
L = 223.14'	L = 277.43'	L = 54.88'	L = 18.21'


- NOTES:  
1. Verify utility locations with "ROADWAY PLANS".  
2. WWLOL is concentric with "E" line.

- LEGEND:  
945.50 Indicates bottom of footing elevation  
29.6 Indicates spot elevation

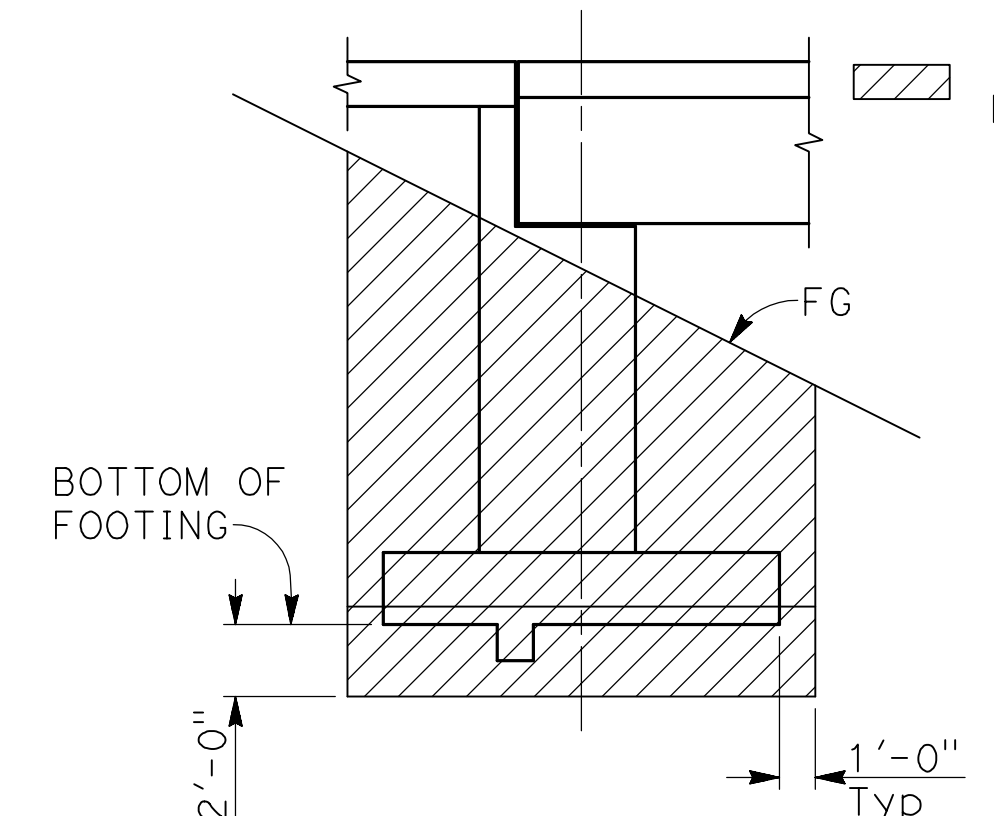

**LIMITS OF PAYMENT FOR EXCAVATION**

NO SCALE

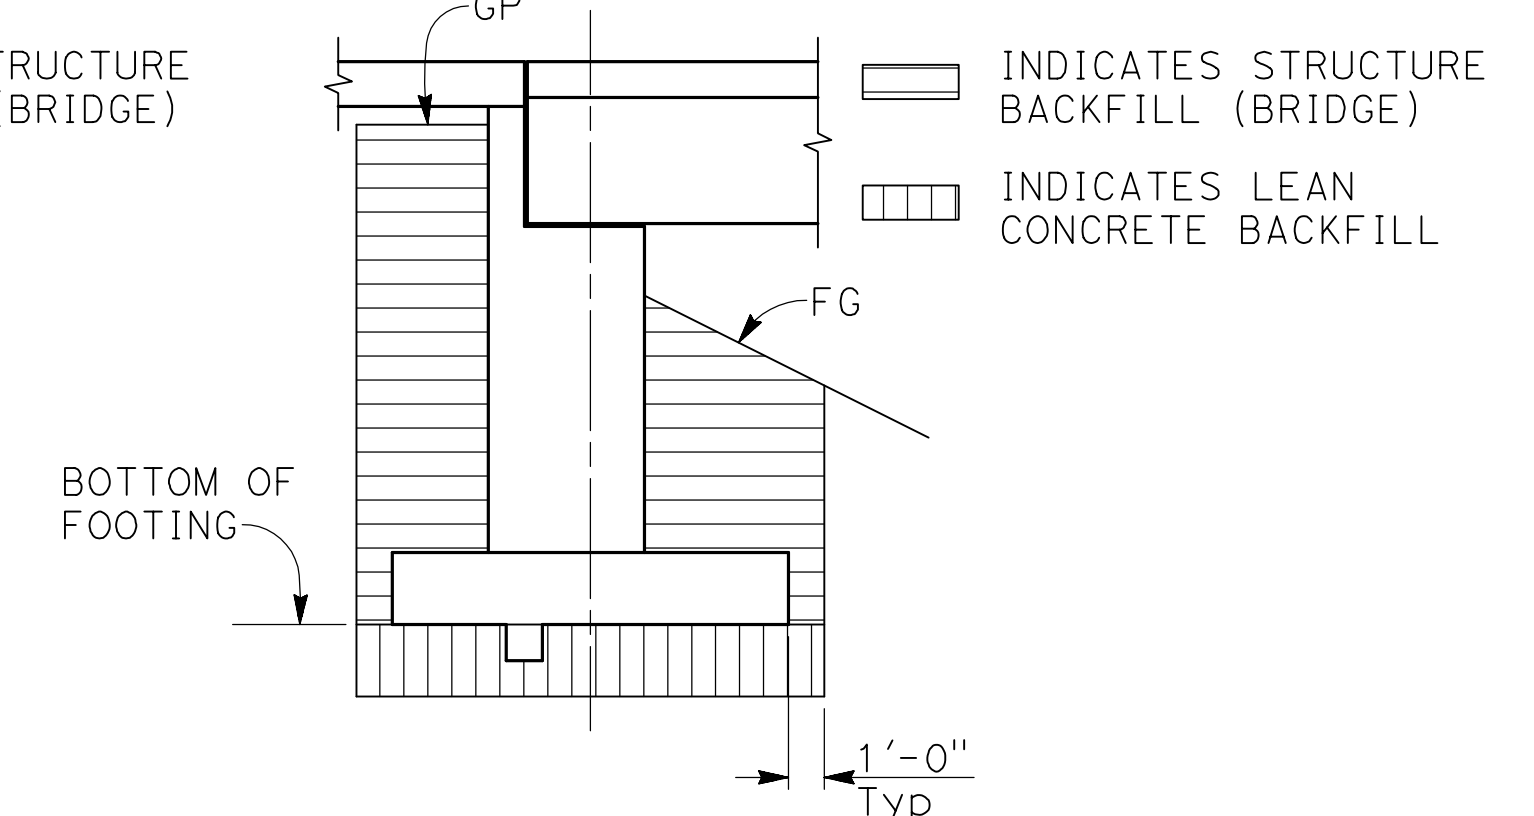

**LIMITS OF PAYMENT FOR BACKFILL**

NO SCALE

**HYDROLOGIC SUMMARY**

(PROVIDED BY AVILA & ASSOCIATES - 11/6/2019)

DRAINAGE AREA: 18.2 SQUARE MILES	DESIGN FLOOD FREQUENCY (YEARS)	DESIGN FLOOD DISCHARGE (CUBIC FEET PER SECOND)	DESIGN FLOOD WATER SURFACE (ELEVATION AT BRIDGE)
	50	2770	950.2
	100	3345	951.2

FLOOD PLAIN DATA ARE BASED UPON INFORMATION AVAILABLE WHEN THE PLANS WERE PREPARED AND ARE SHOWN TO MEET FEDERAL REQUIREMENTS. THE ACCURACY OF SAID INFORMATION IS NOT WARRANTED BY BIGGS CARDOSA ASSOCIATES AND INTERESTED OR AFFECTED PARTIES SHOULD MAKE THEIR OWN INVESTIGATION.

**BENCH MARK AND DATUM**


MONUMENT	COORDINATES		ELEVATION	DESCRIPTION/LOCATION
	NORTHING	EASTING		
HN1G	2002915.567	6372176.001	252.141	COORDINATE VALUES WERE GPS DERIVED IN CALIFORNIA STATE PLAN COORDINATES, ZONE 4, EPOCH 2011 (NAD83) USING CSDS CONTINUALLY MONITORING STATION "HN1G", LOCATED IN HANFORD, CA VERTICAL DATUM = NAVD 88

**SCOUR DATA TABLE**


SUPPORT No.	LONG TERM (DEGRADATION AND CONTRACTION) SCOUR ELEVATION (ft)	SHORT TERM (LOCAL) SCOUR DEPTH (ft)
ABUTMENT 1	N/A	N/A
ABUTMENT 2	N/A	N/A

\* FOUNDATION IS EMBEDDED INTO ROCK. NO SCOUR ANALYSIS REQUIRED.


DESIGNED: SGS	DATE: 1/25/21	RECORD DRAWING: RESIDENT ENGINEER	SCALE: AS SHOWN	BIGGS CARDOSA ASSOCIATES INC STRUCTURAL ENGINEERS	PROJECT: SAND CREEK BRIDGE REPLACEMENT ON ENNIS ROAD	DEPARTMENT OF PUBLIC WORKS AND PLANNING
DRAWN: AR	DATE: 1/25/21			5250 N. Palm Avenue, Suite 211 Fresno, California 93704 559-449-8686	ROAD NO. 2824-2825 BRIDGE NO. 42C0697, BRLO-5942(238)	FUNDATION PLAN
CHECKED: ML	DATE: 1/25/21			BCA	DRAWING NO. 11257 SHEET NO. 20 TOTAL 31	

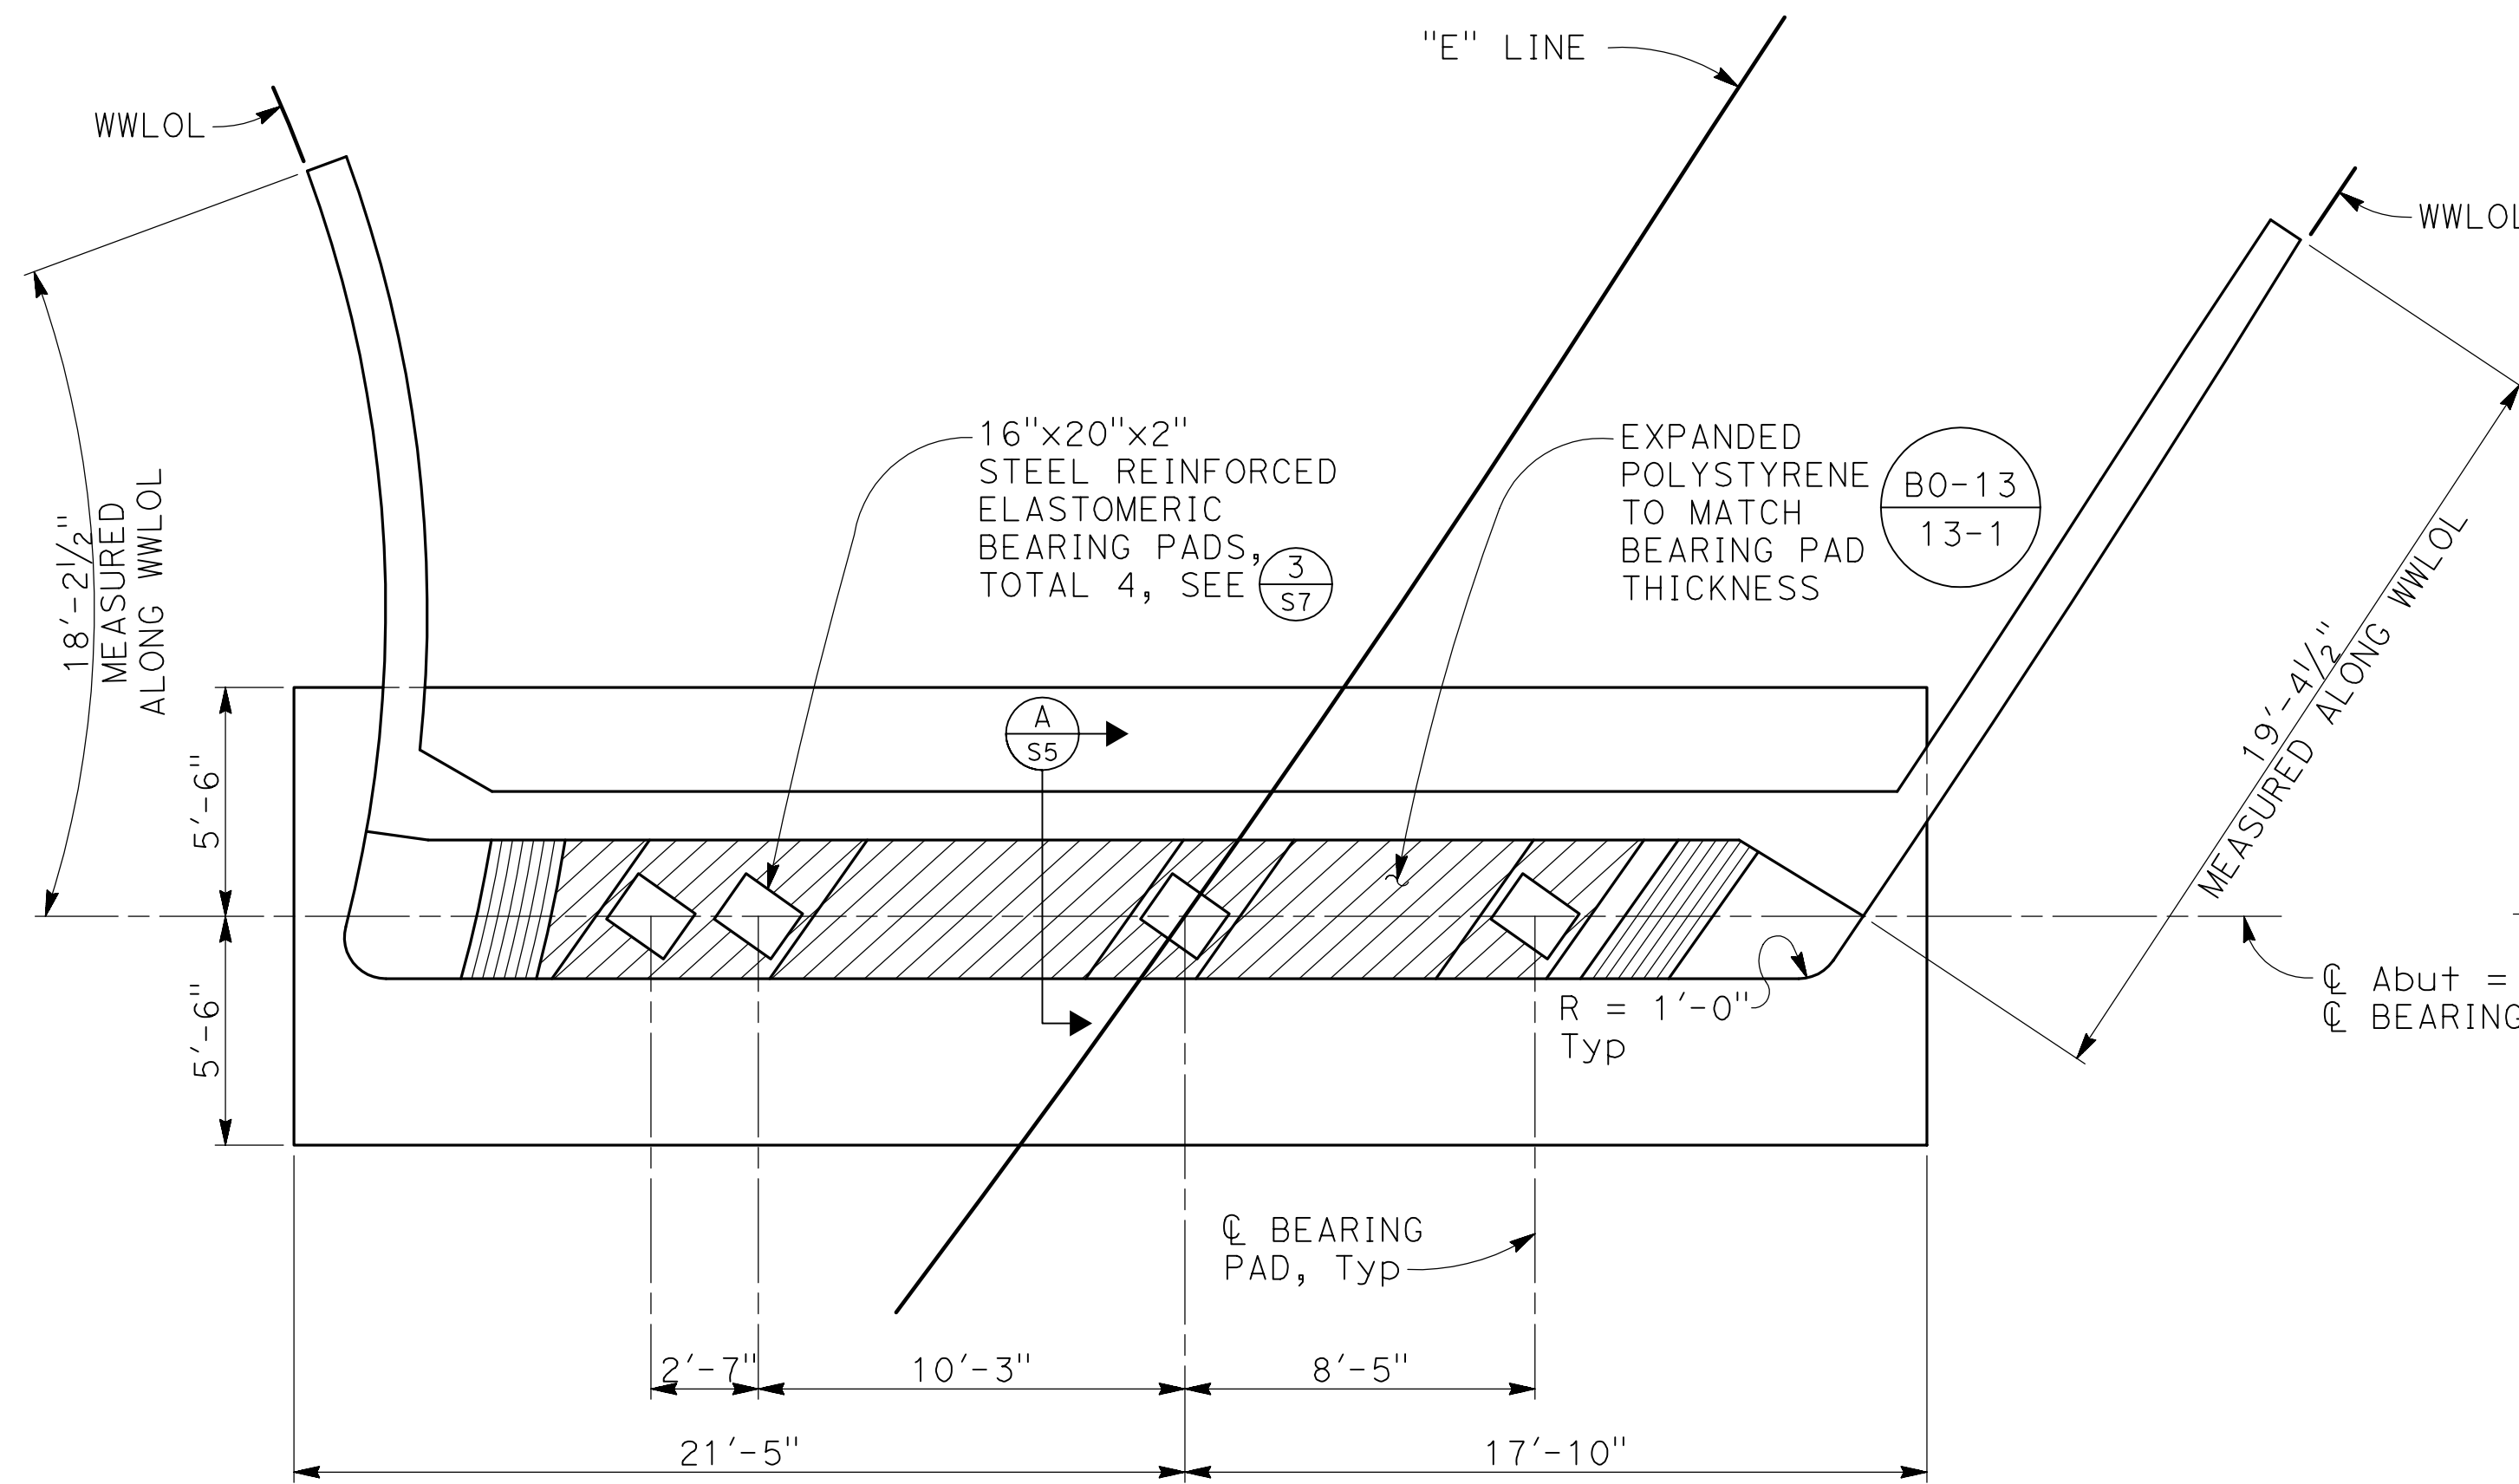


**ABUTMENT 1 PLAN**  
1/4" = 1'-0"

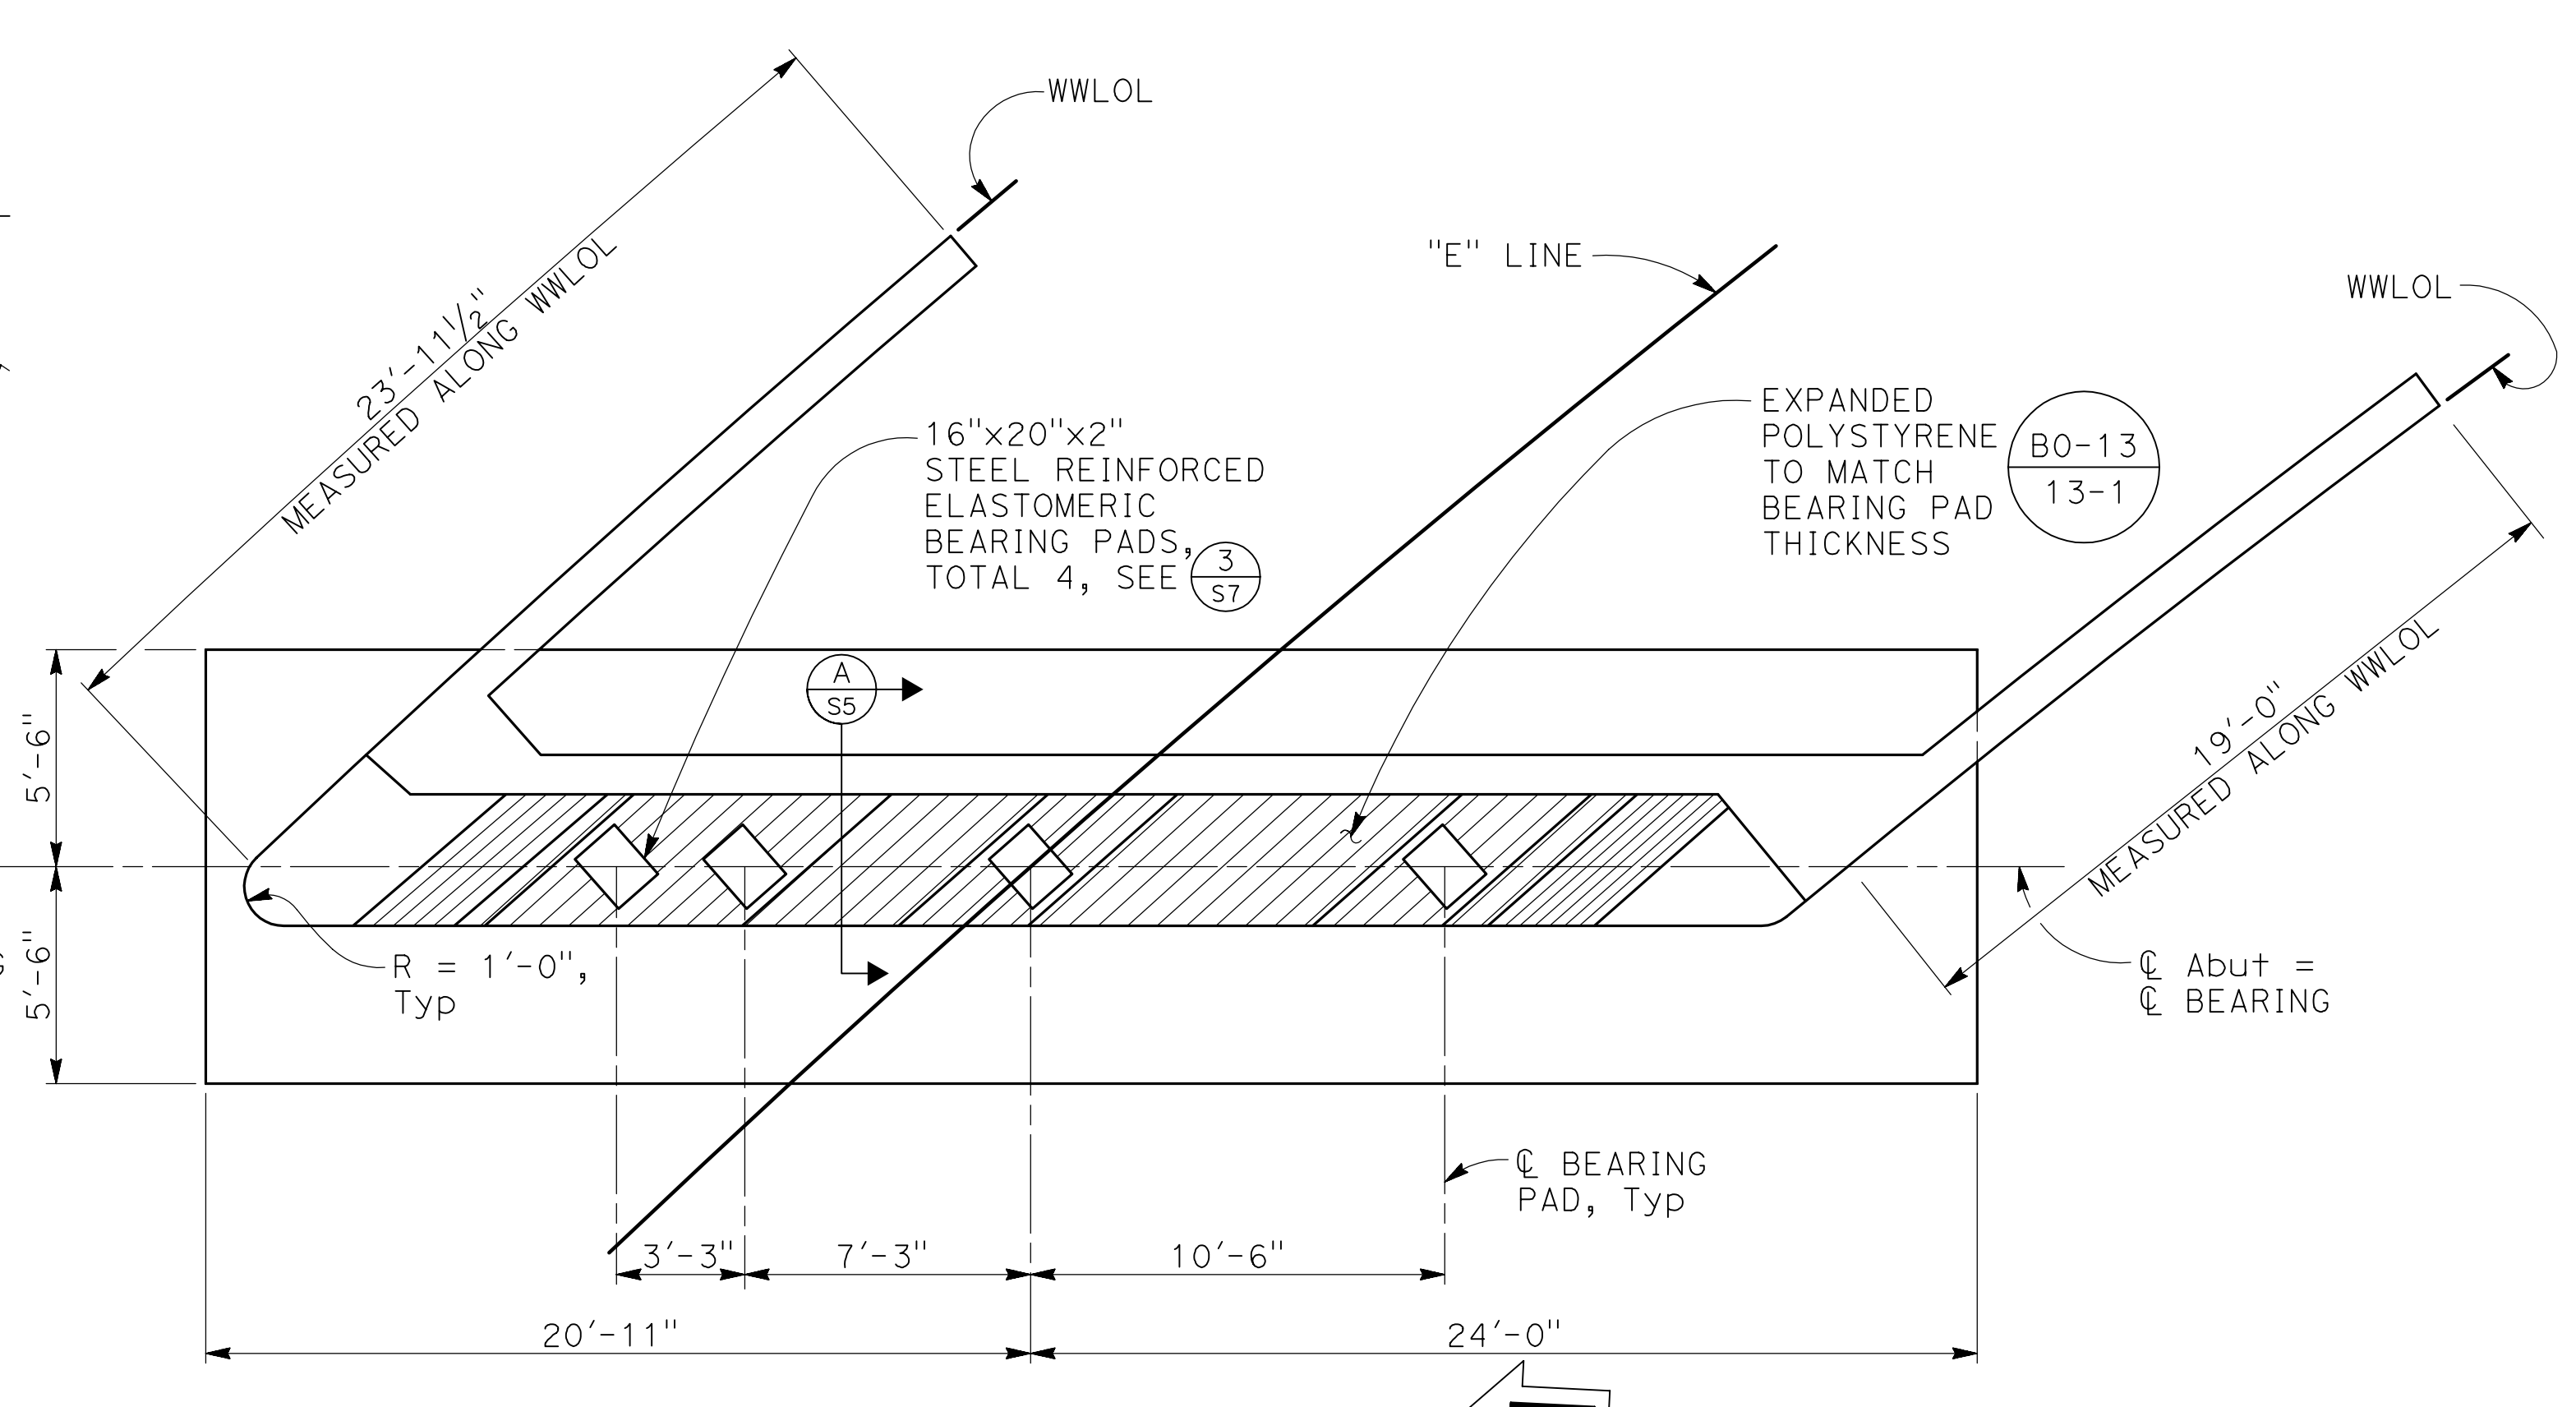

**ABUTMENT 2 PLAN**  
1/4" = 1'-0"

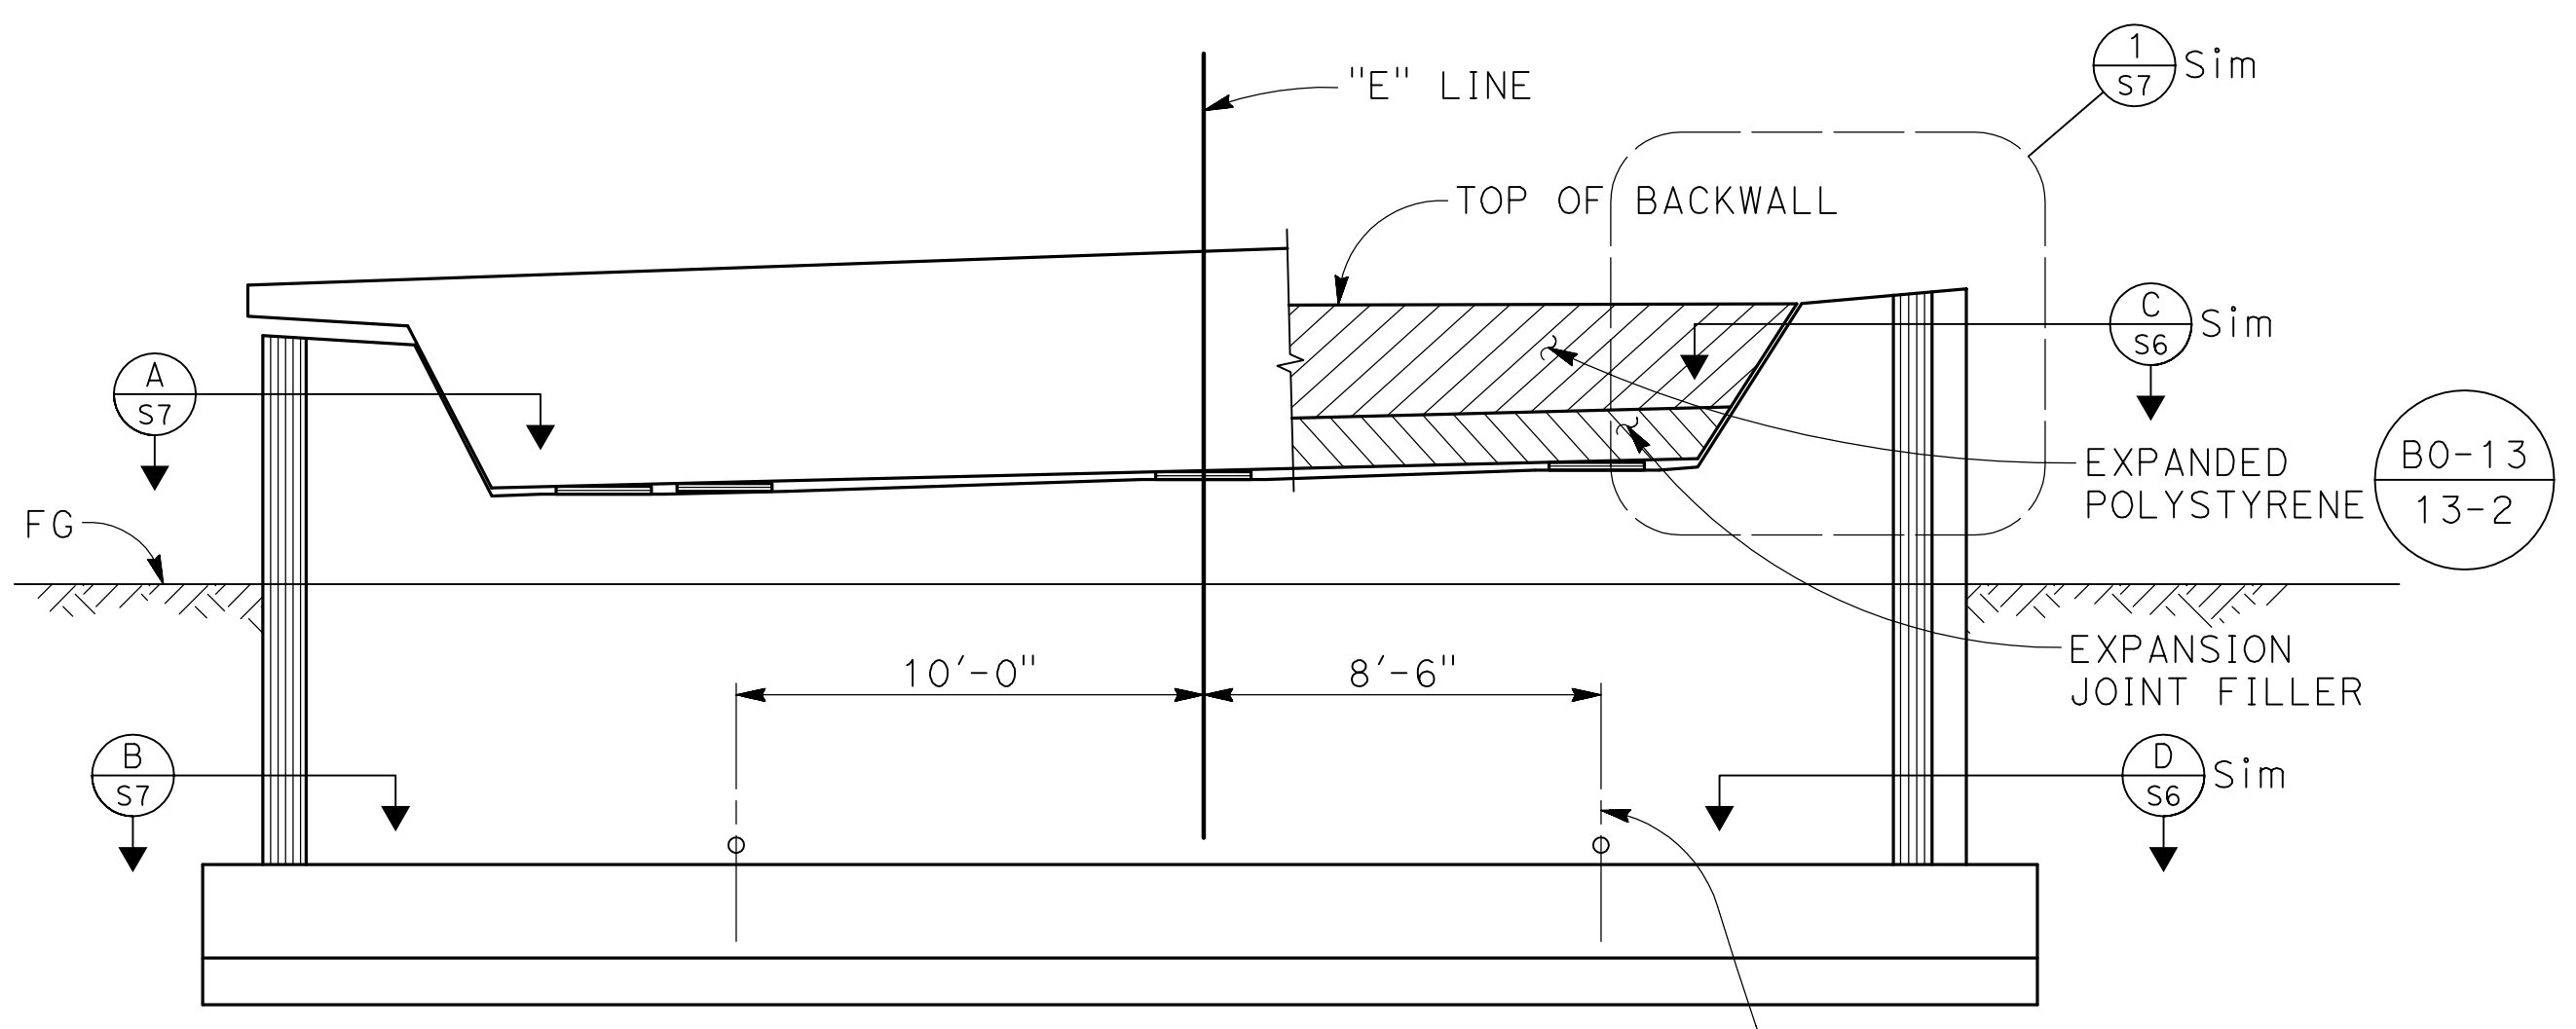


**ABUTMENT 1 ELEVATION**  
1/4" = 1'-0"

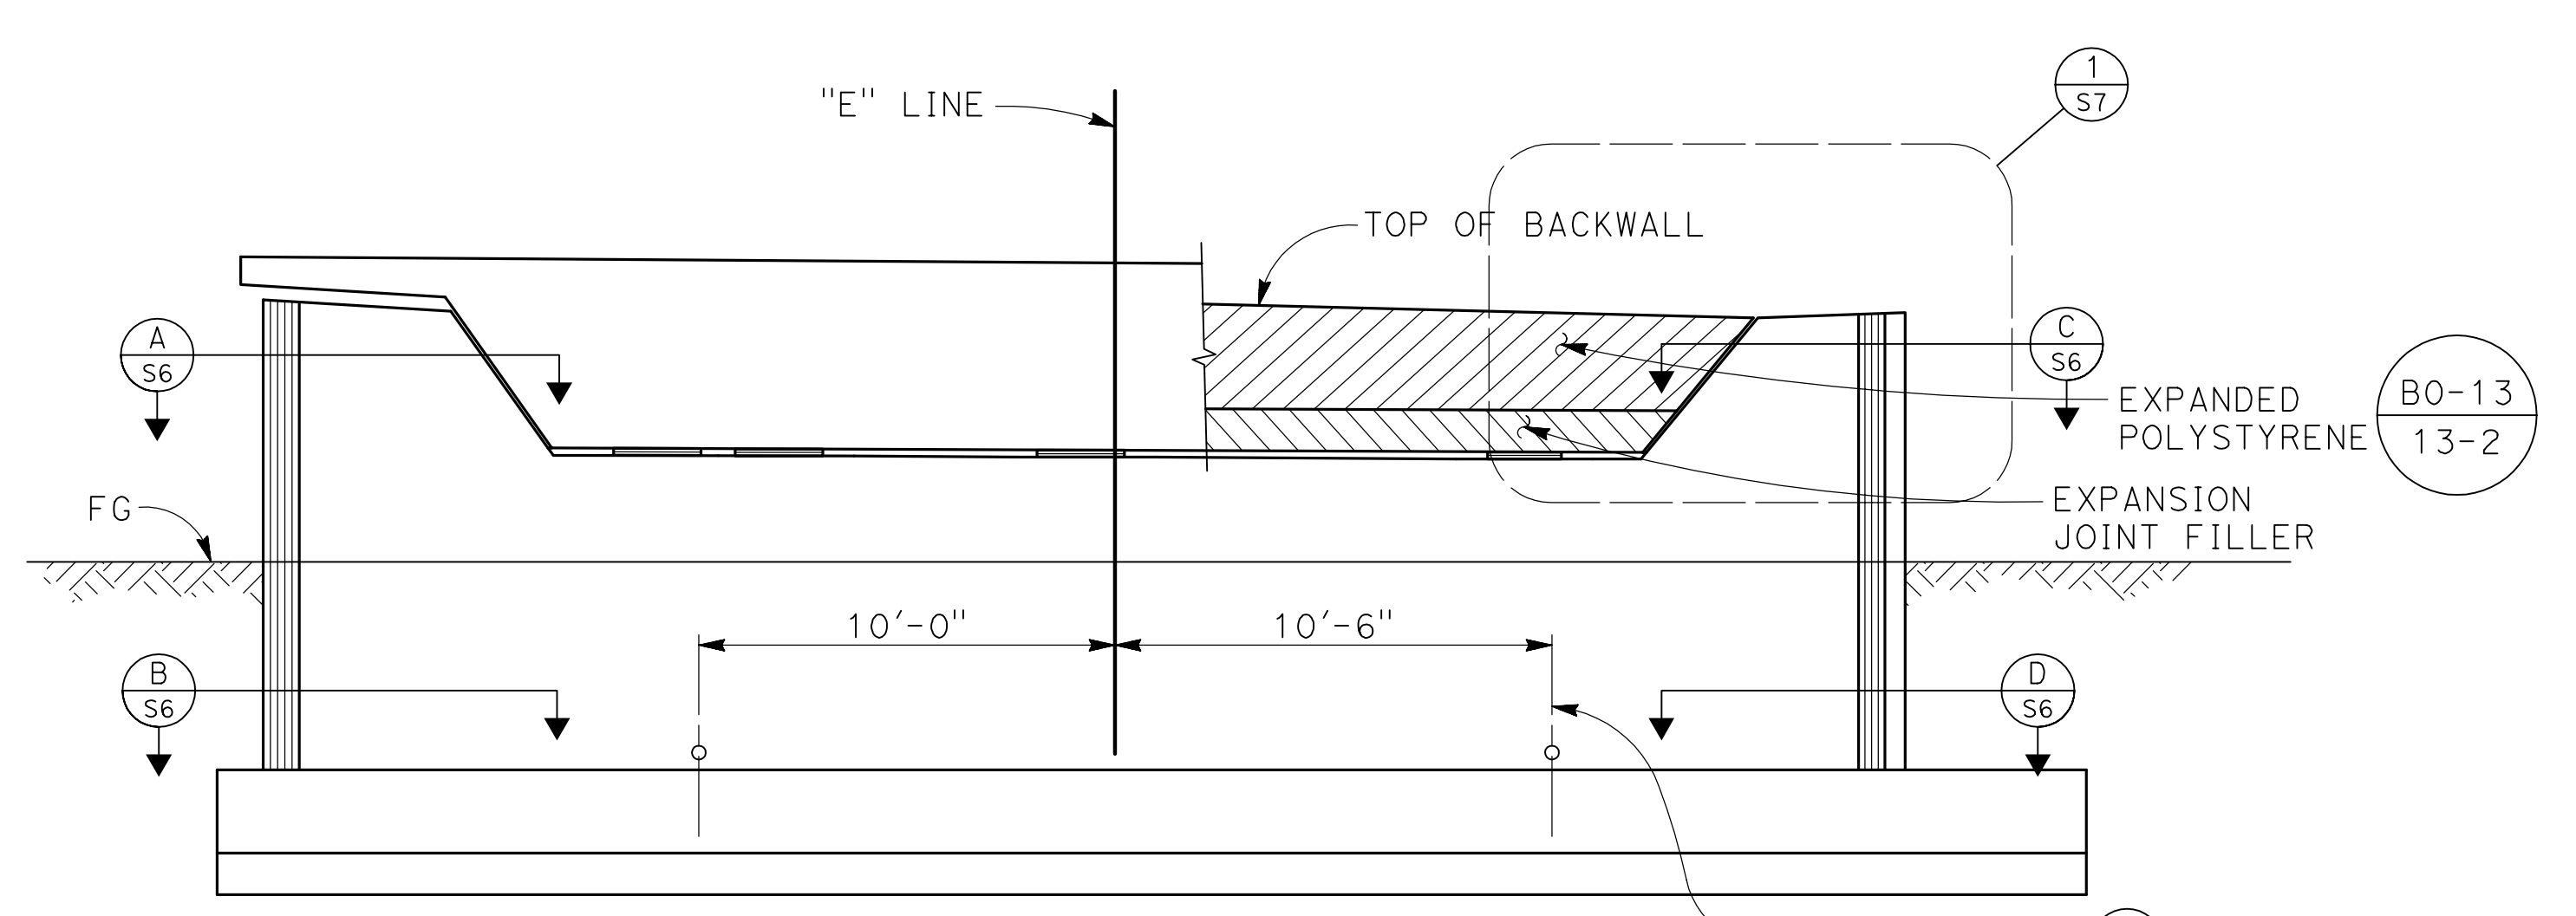


**ABUTMENT 2 ELEVATION**  
1/4" = 1'-0"

NOTE:  
THE CONTRACTOR MUST VERIFY ALL  
CONTROLLING FIELD DIMENSIONS BEFORE  
ORDERING OR FABRICATING ANY MATERIAL

DESIGNED: SGS		DATE: 1/25/21	RECORD DRAWING		SCALE: AS SHOWN	<b>BIGGS CARDOSA ASSOCIATES INC</b> STRUCTURAL ENGINEERS 5250 N. Palm Avenue, Suite 211 Fresno, California 93704 559-449-8686		PROJECT: SAND CREEK BRIDGE REPLACEMENT ON ENNIS ROAD		DEPARTMENT OF PUBLIC WORKS AND PLANNING	
DRAWN: AR		DATE: 1/25/21						ROAD NO. 2824-2825		BRIDGE NO. 42C0697, BRLO-5942(238)	ABUTMENT LAYOUT
CHECKED: ML		DATE: 1/25/21									DRAWING NO. 11257

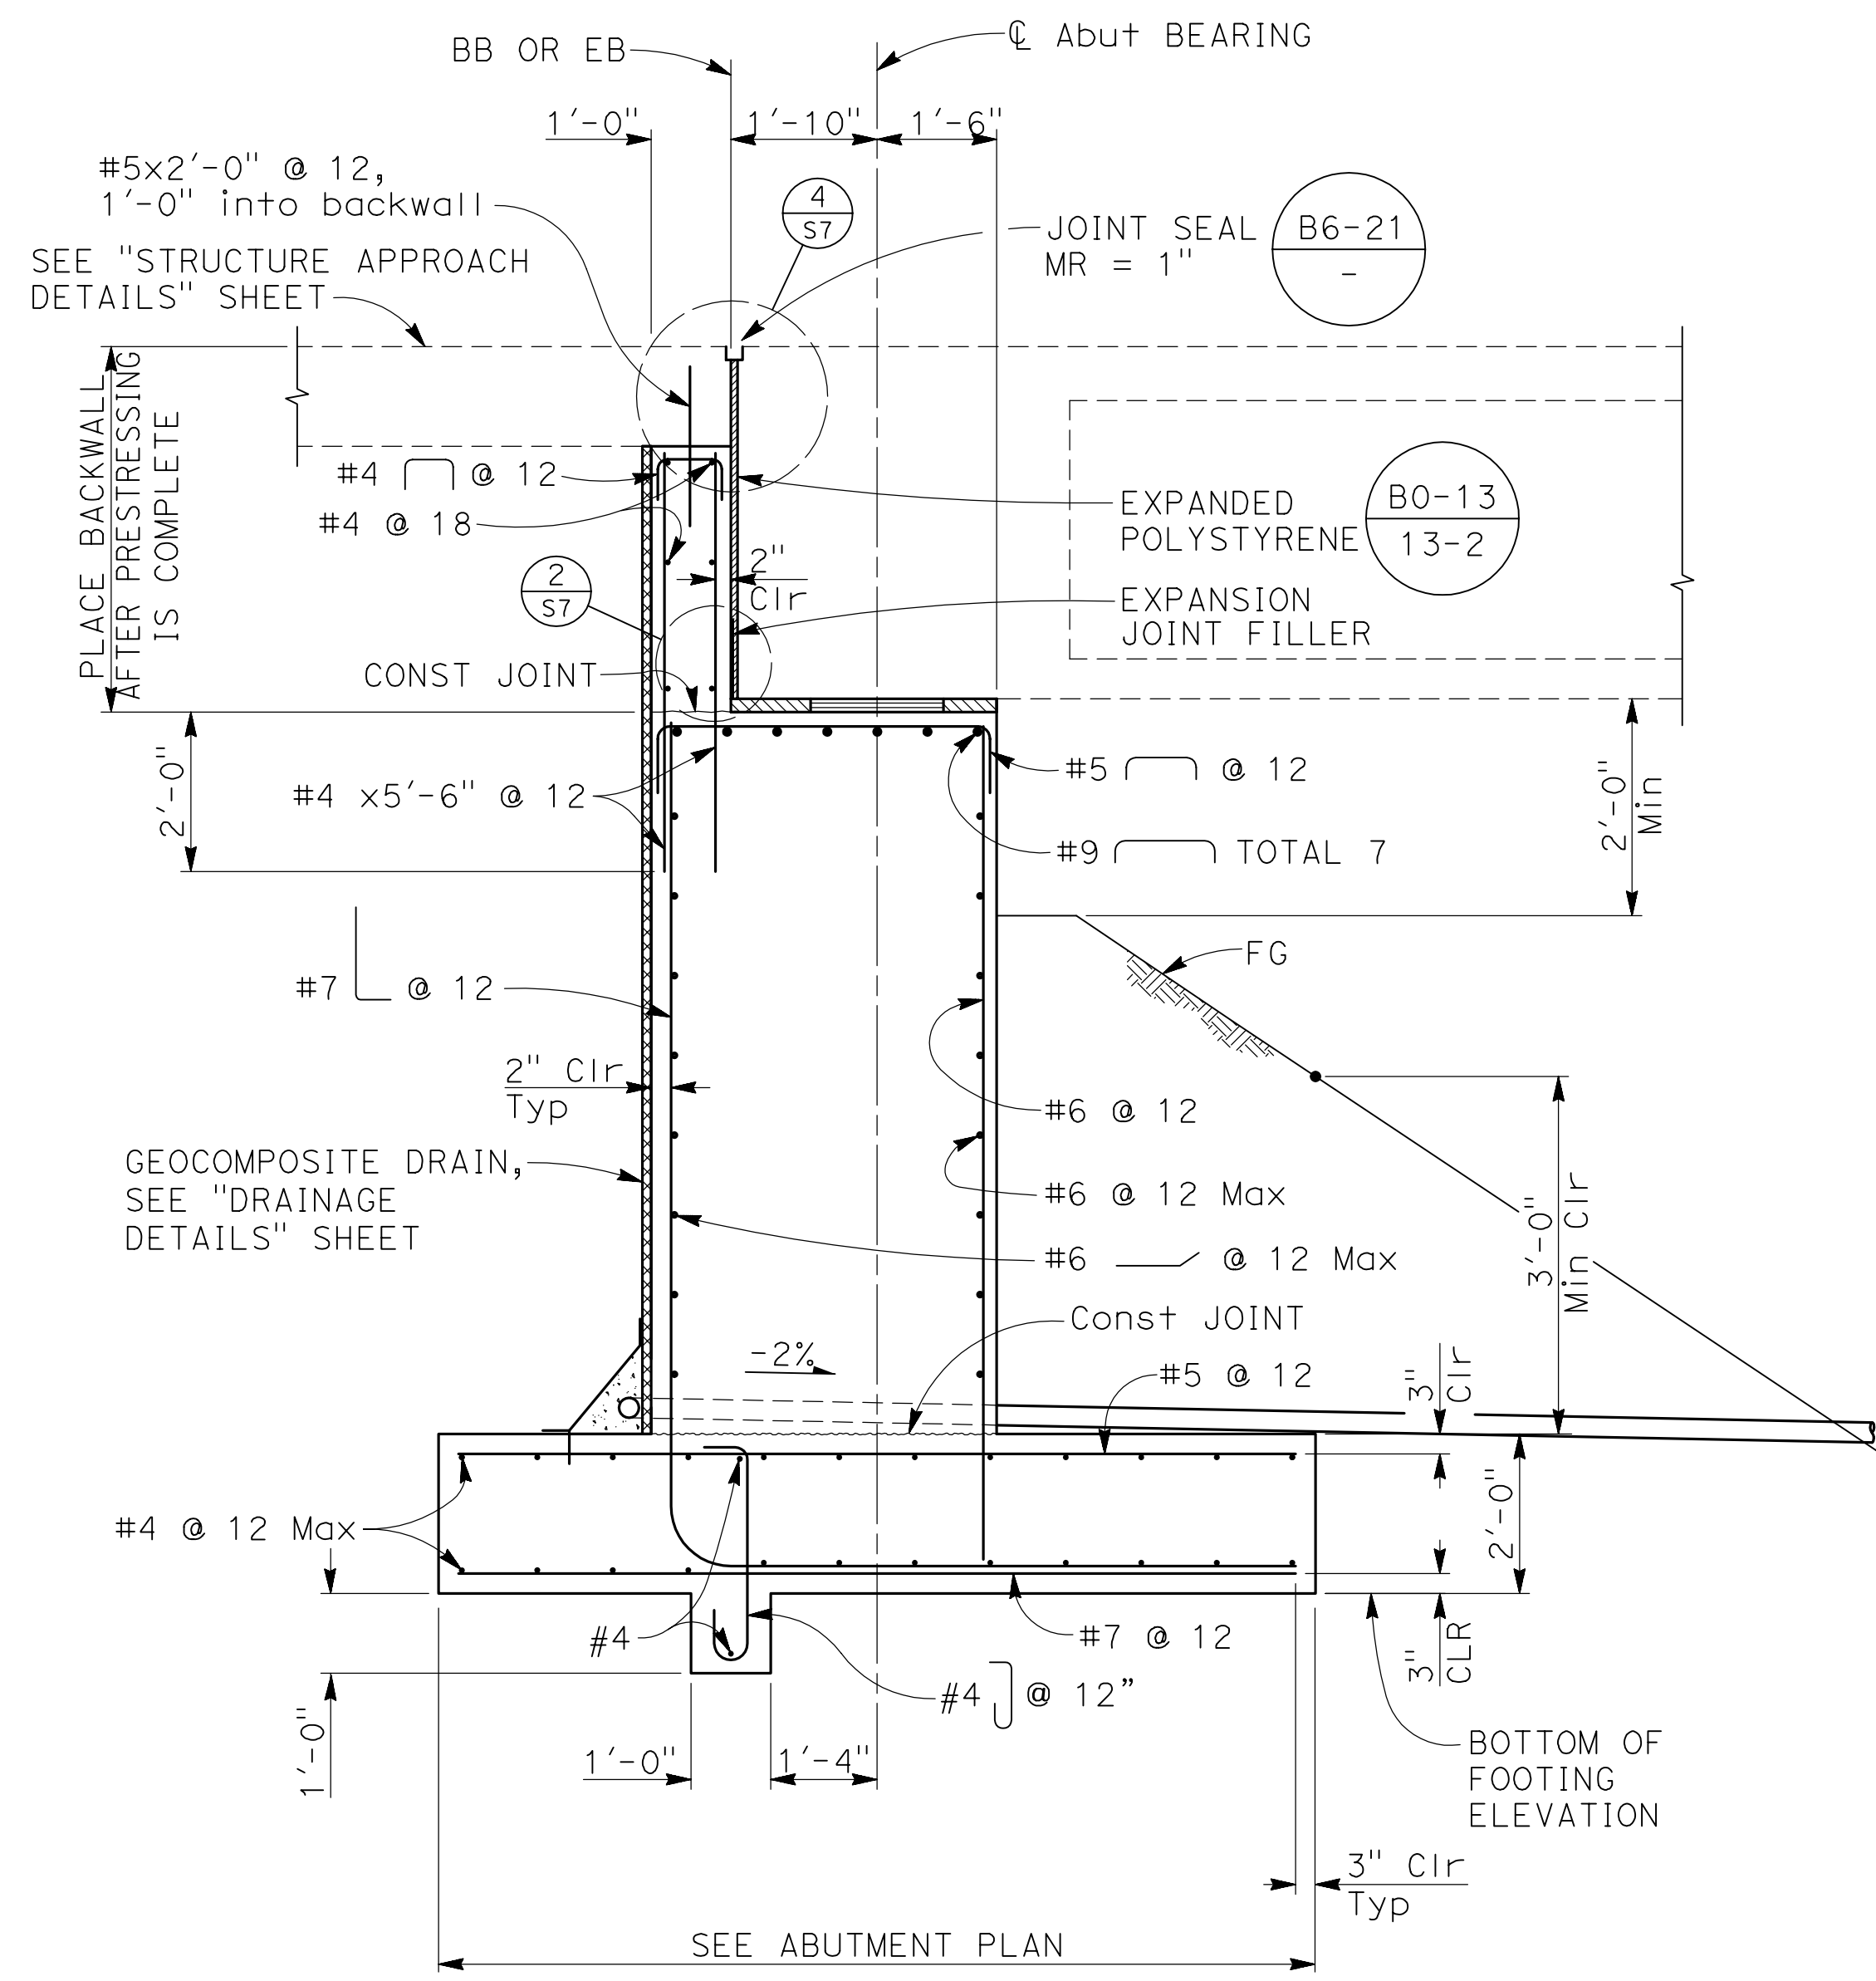

**SECTION A**  
1/2" = 1'-0" (S5)

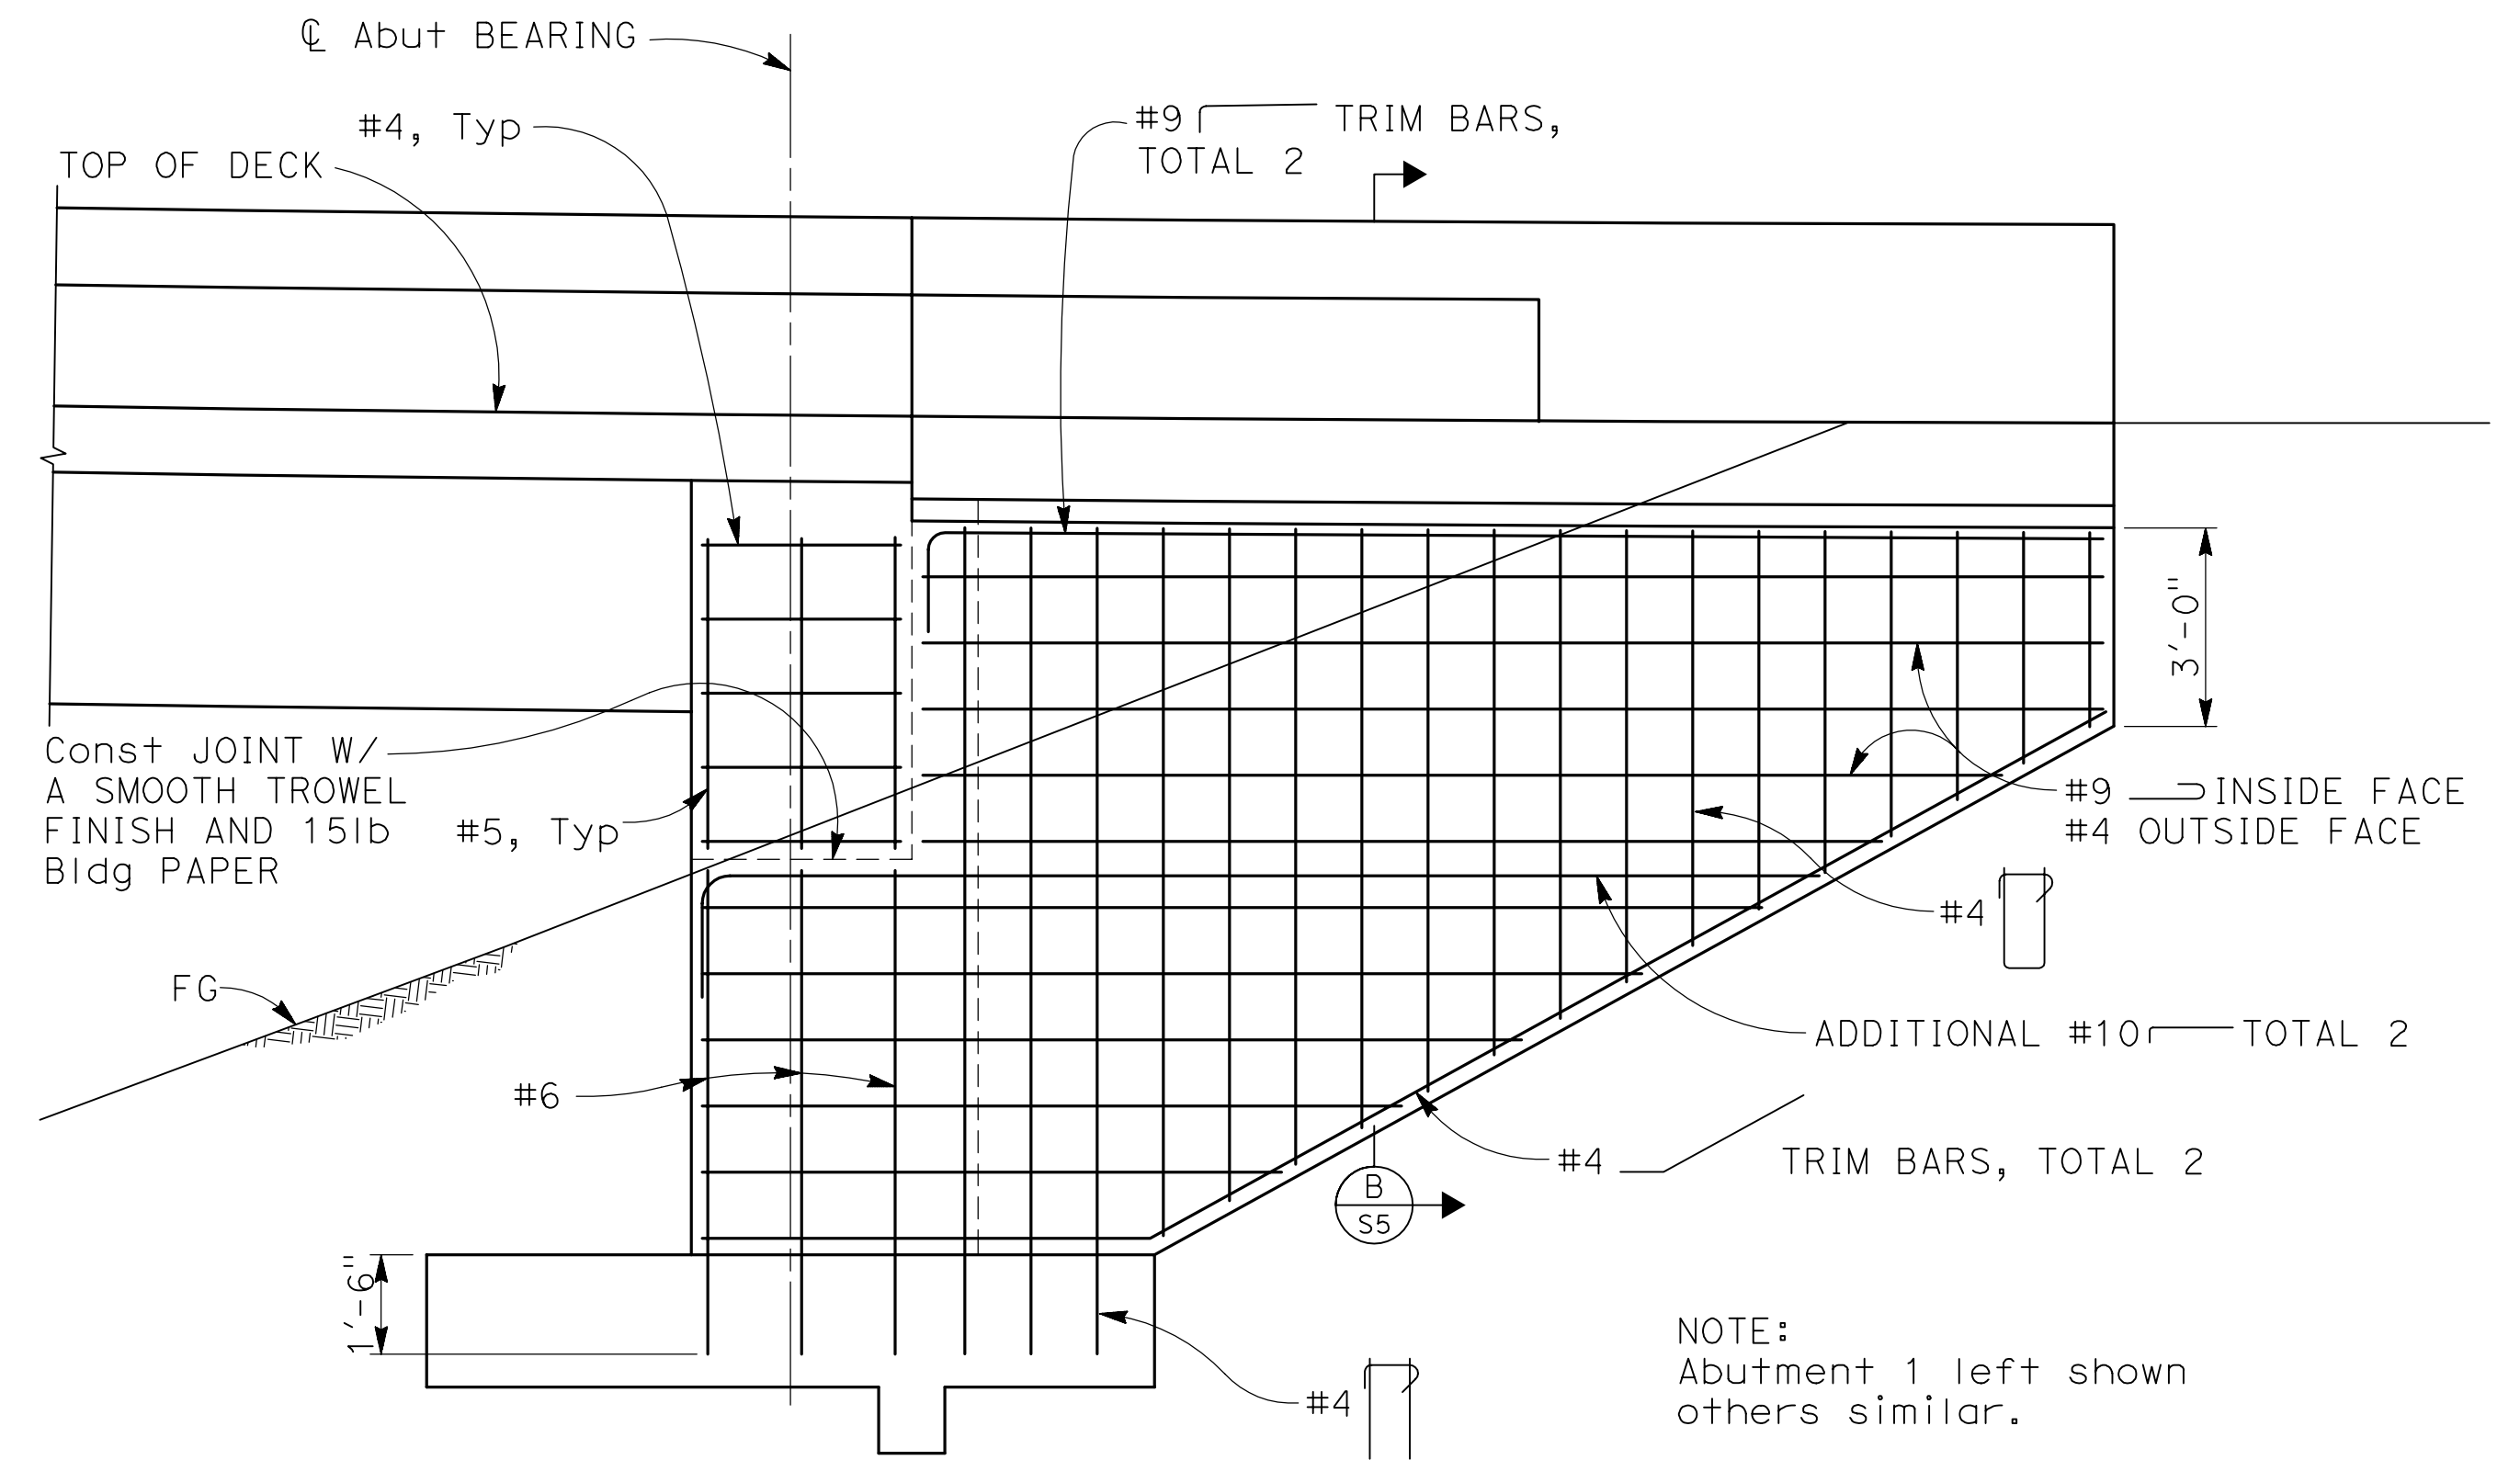


**ABUTMENT WINGWALL ELEVATION**  
3/8" = 1'-0"

NOTE:  
Abutment 1 left shown  
others similar.

STRUCTURE APPROACH  
SLAB, SEE "STRUCTURE  
APPROACH DETAILS" SHEET

GEOCOMPOSITE DRAIN, SEE  
"DRAINAGE DETAILS" SHEET

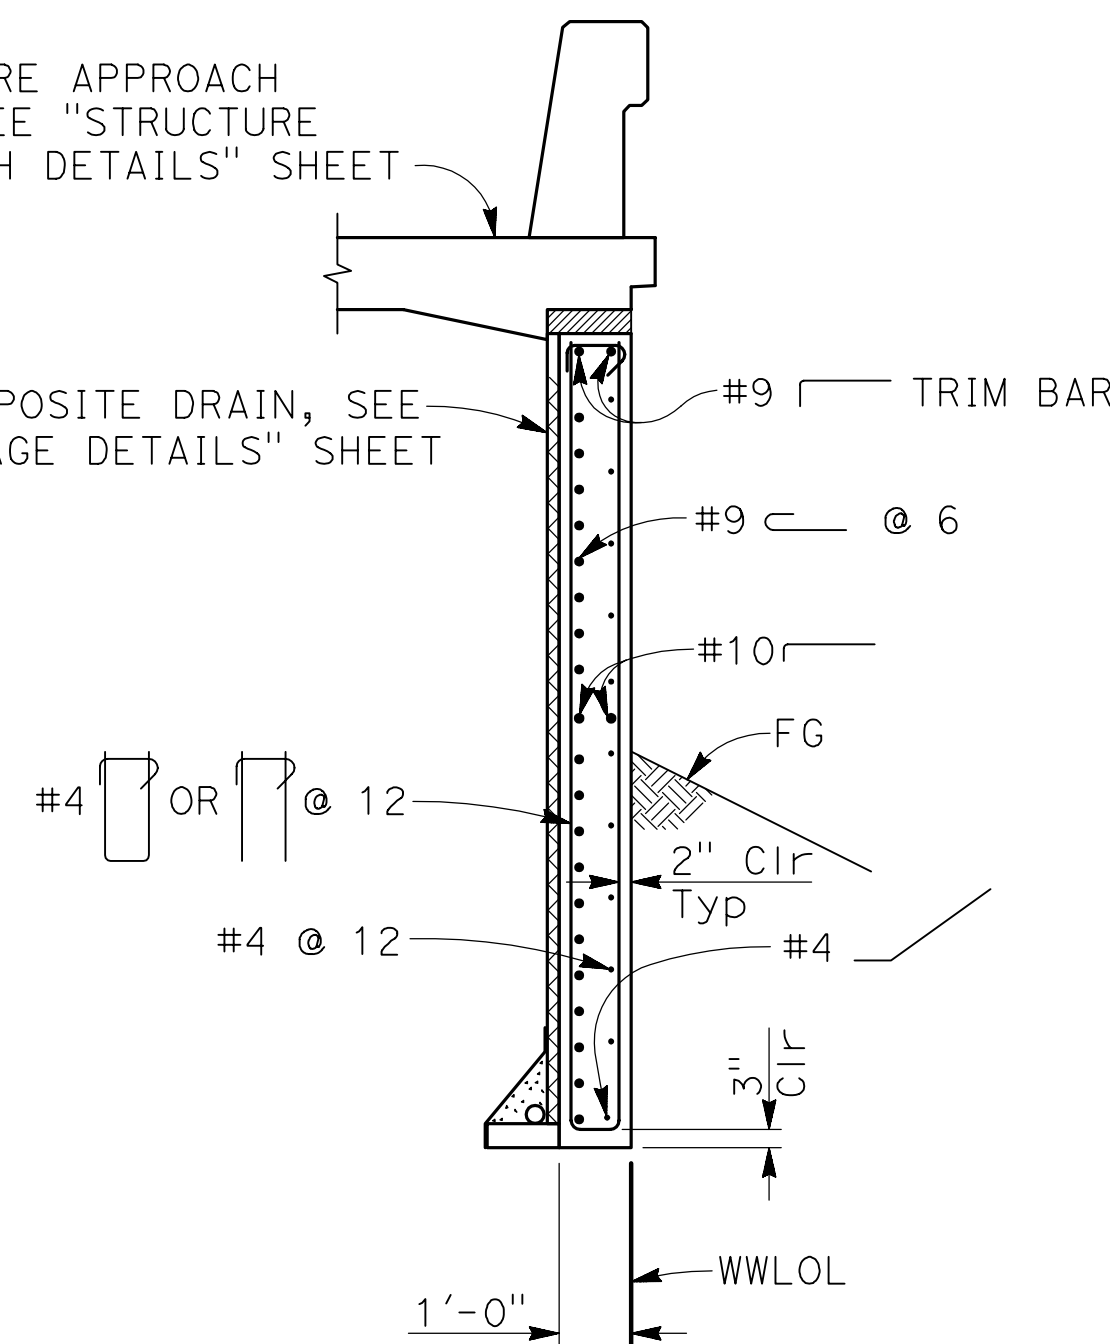


**SECTION B**  
3/8" = 1'-0" (S5)

NOTE:  
THE CONTRACTOR MUST VERIFY ALL  
CONTROLLING FIELD DIMENSIONS BEFORE  
ORDERING OR FABRICATING ANY MATERIAL

RECORD DRAWING		SCALE
DESIGNED: SGS	DATE: 1/25/21	AS SHOWN
DRAWN: AR	DATE: 1/25/21	
CHECKED: ML	DATE: 1/25/21	

**BIGGS CARDOSA  
ASSOCIATES INC**  
STRUCTURAL ENGINEERS


5250 N. Palm Avenue, Suite 211  
Fresno, California 93704  
559-449-8686

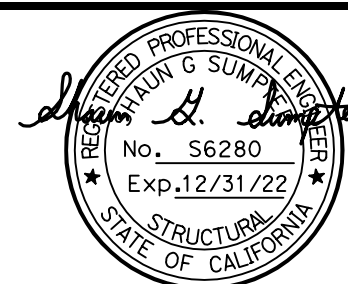

PROJECT  
**SAND CREEK BRIDGE REPLACEMENT  
ON ENNIS ROAD**

ROAD NO. 2824-2825

BRIDGE NO. 42C0697, BRLO-5942(238)

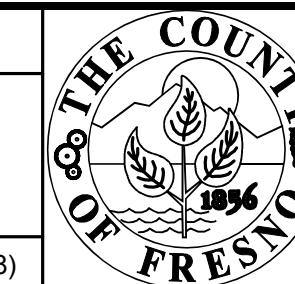





DEPARTMENT OF PUBLIC WORKS AND PLANNING

**ABUTMENT DETAILS No. 1**

DRAWING NO. 11257

SHEET NO. 22

TOTAL 31

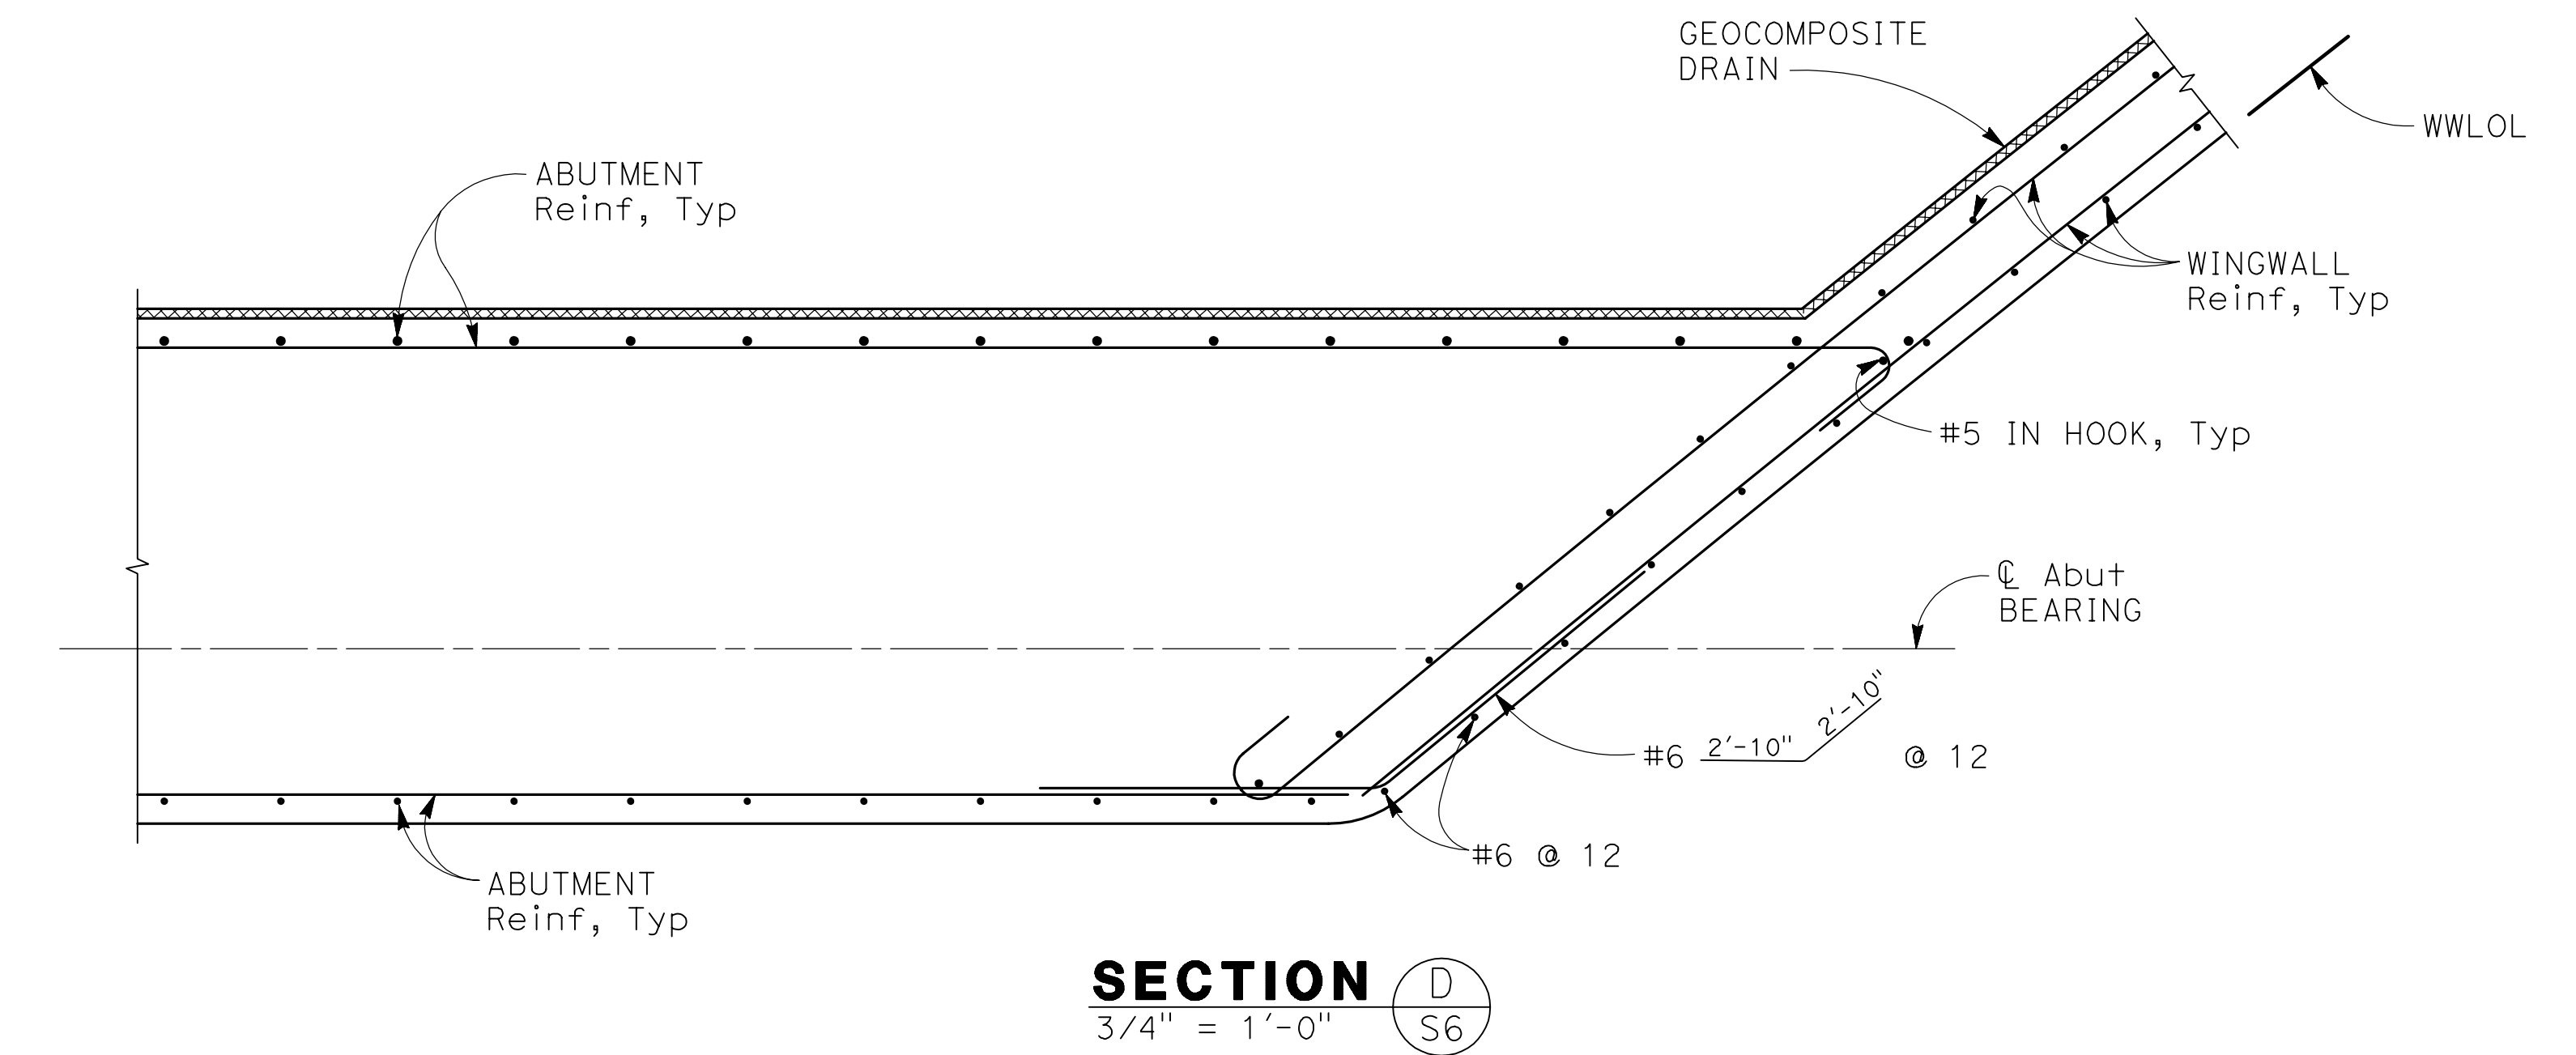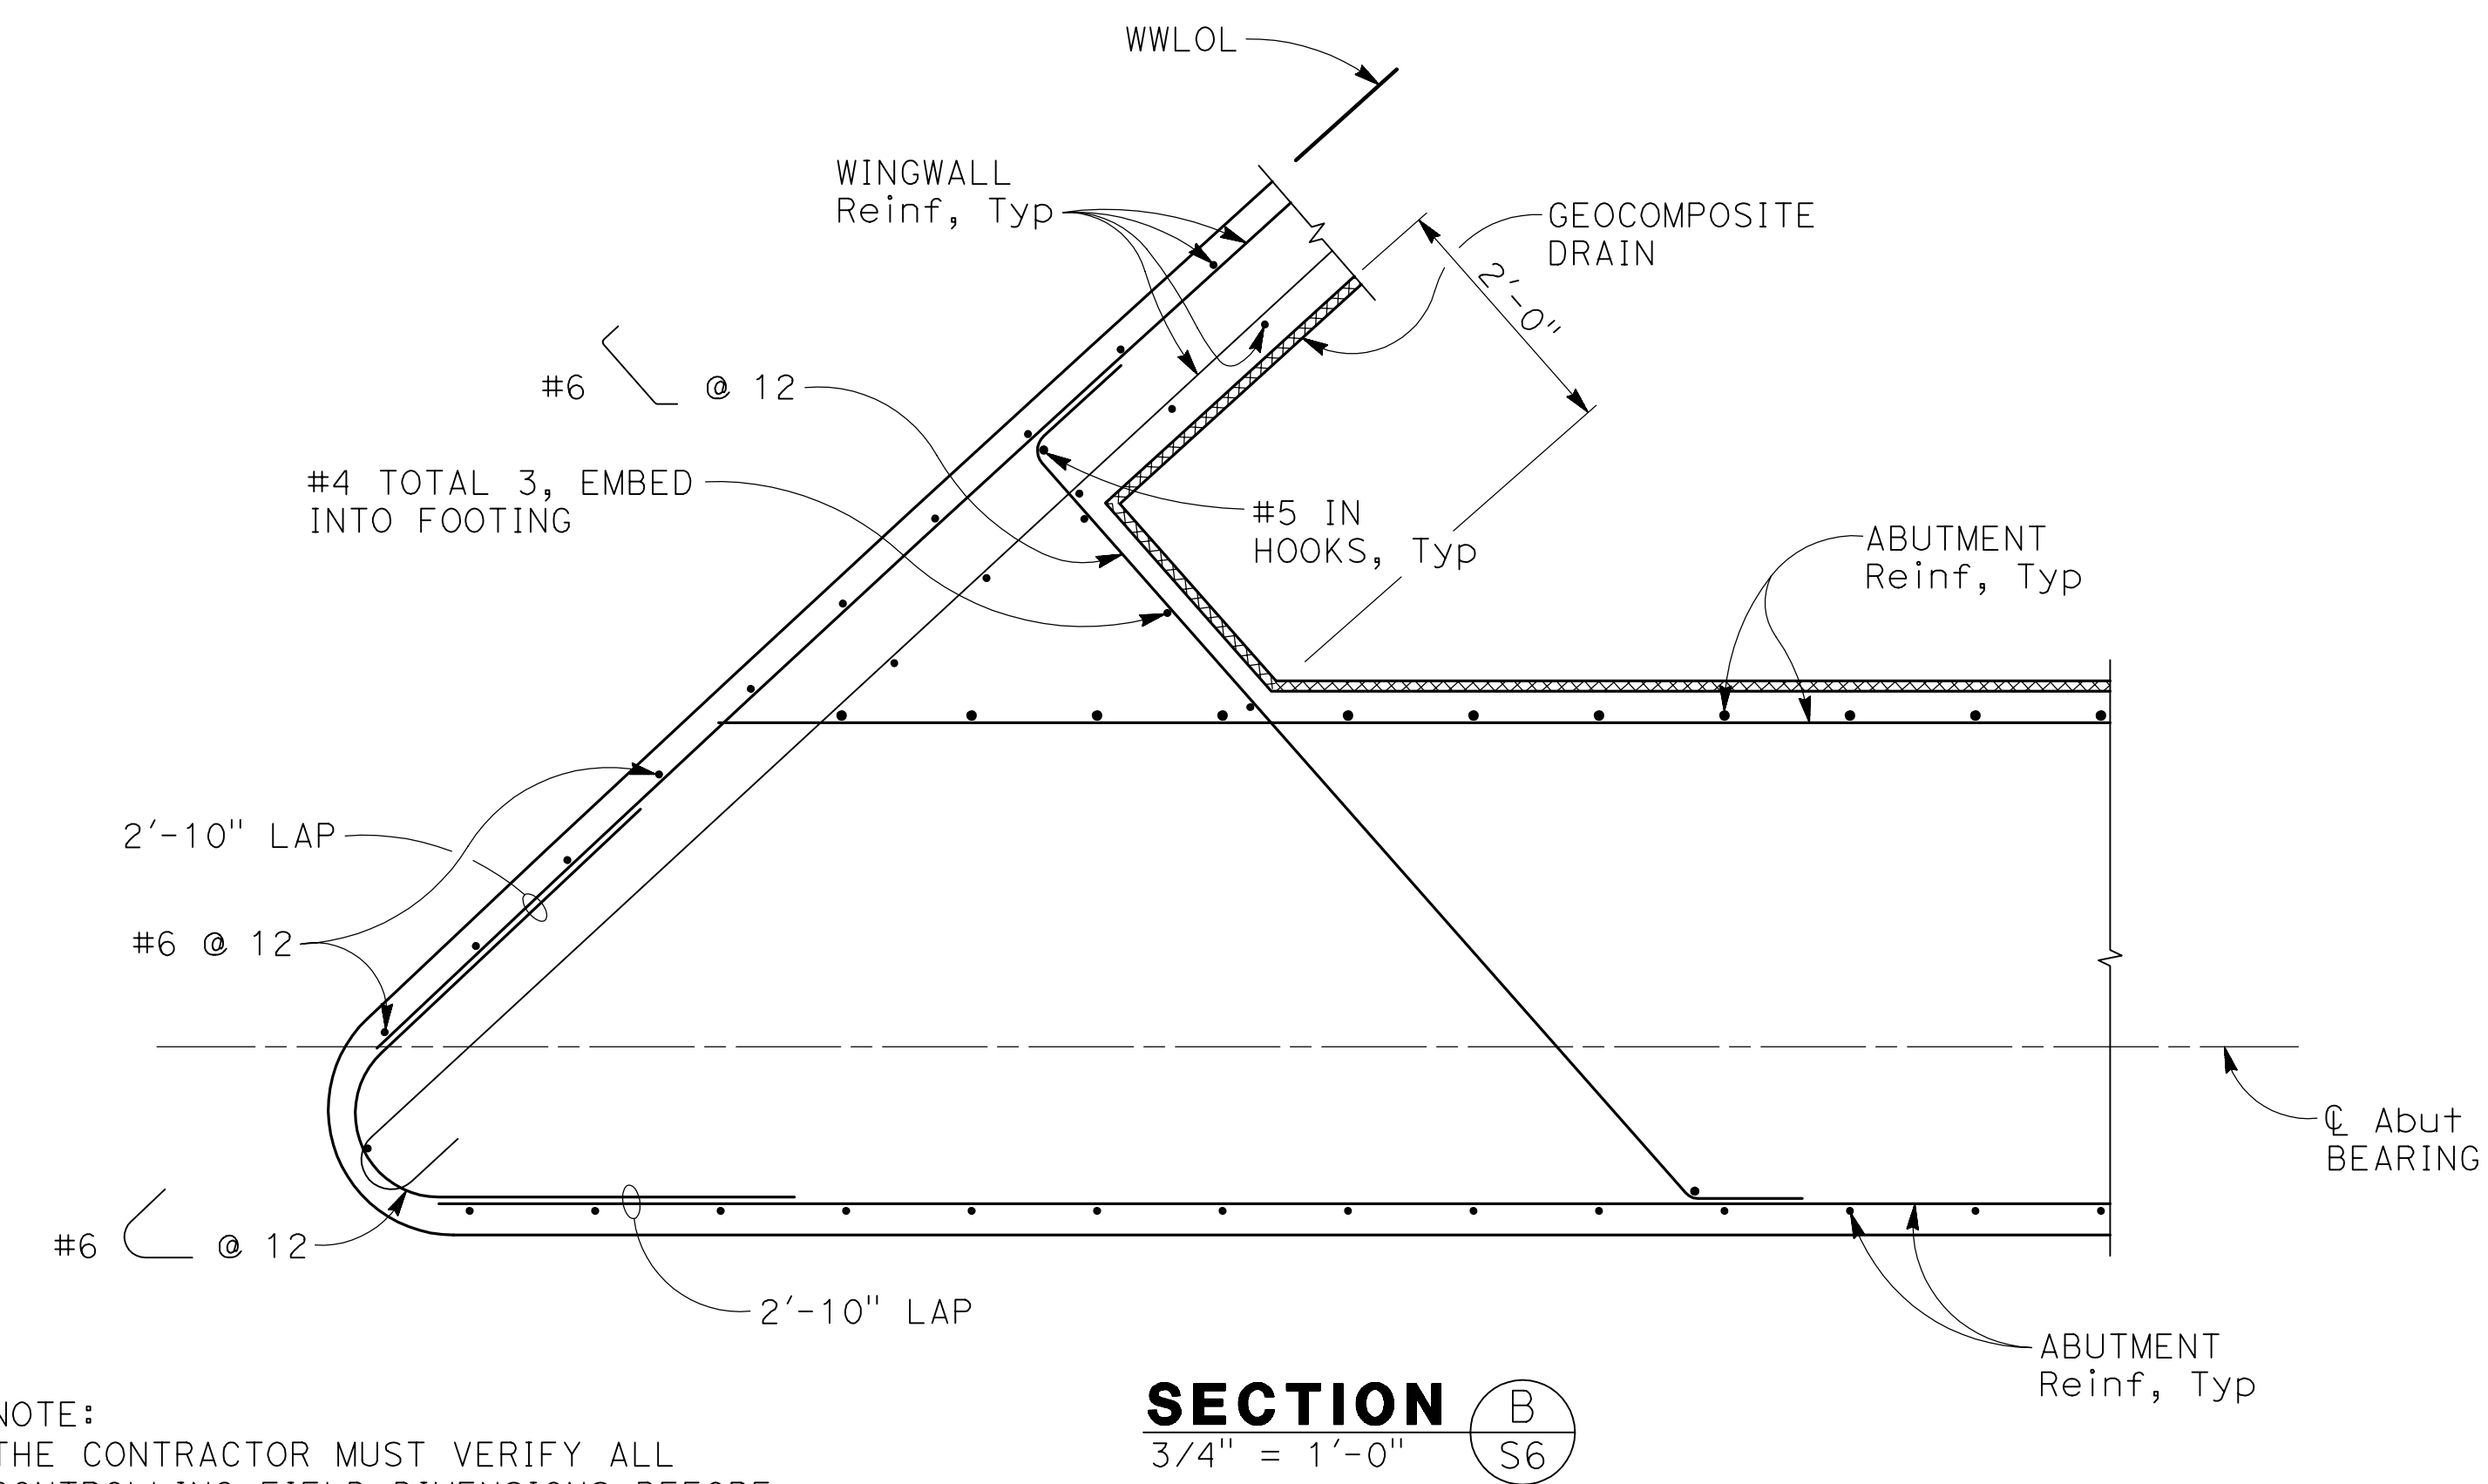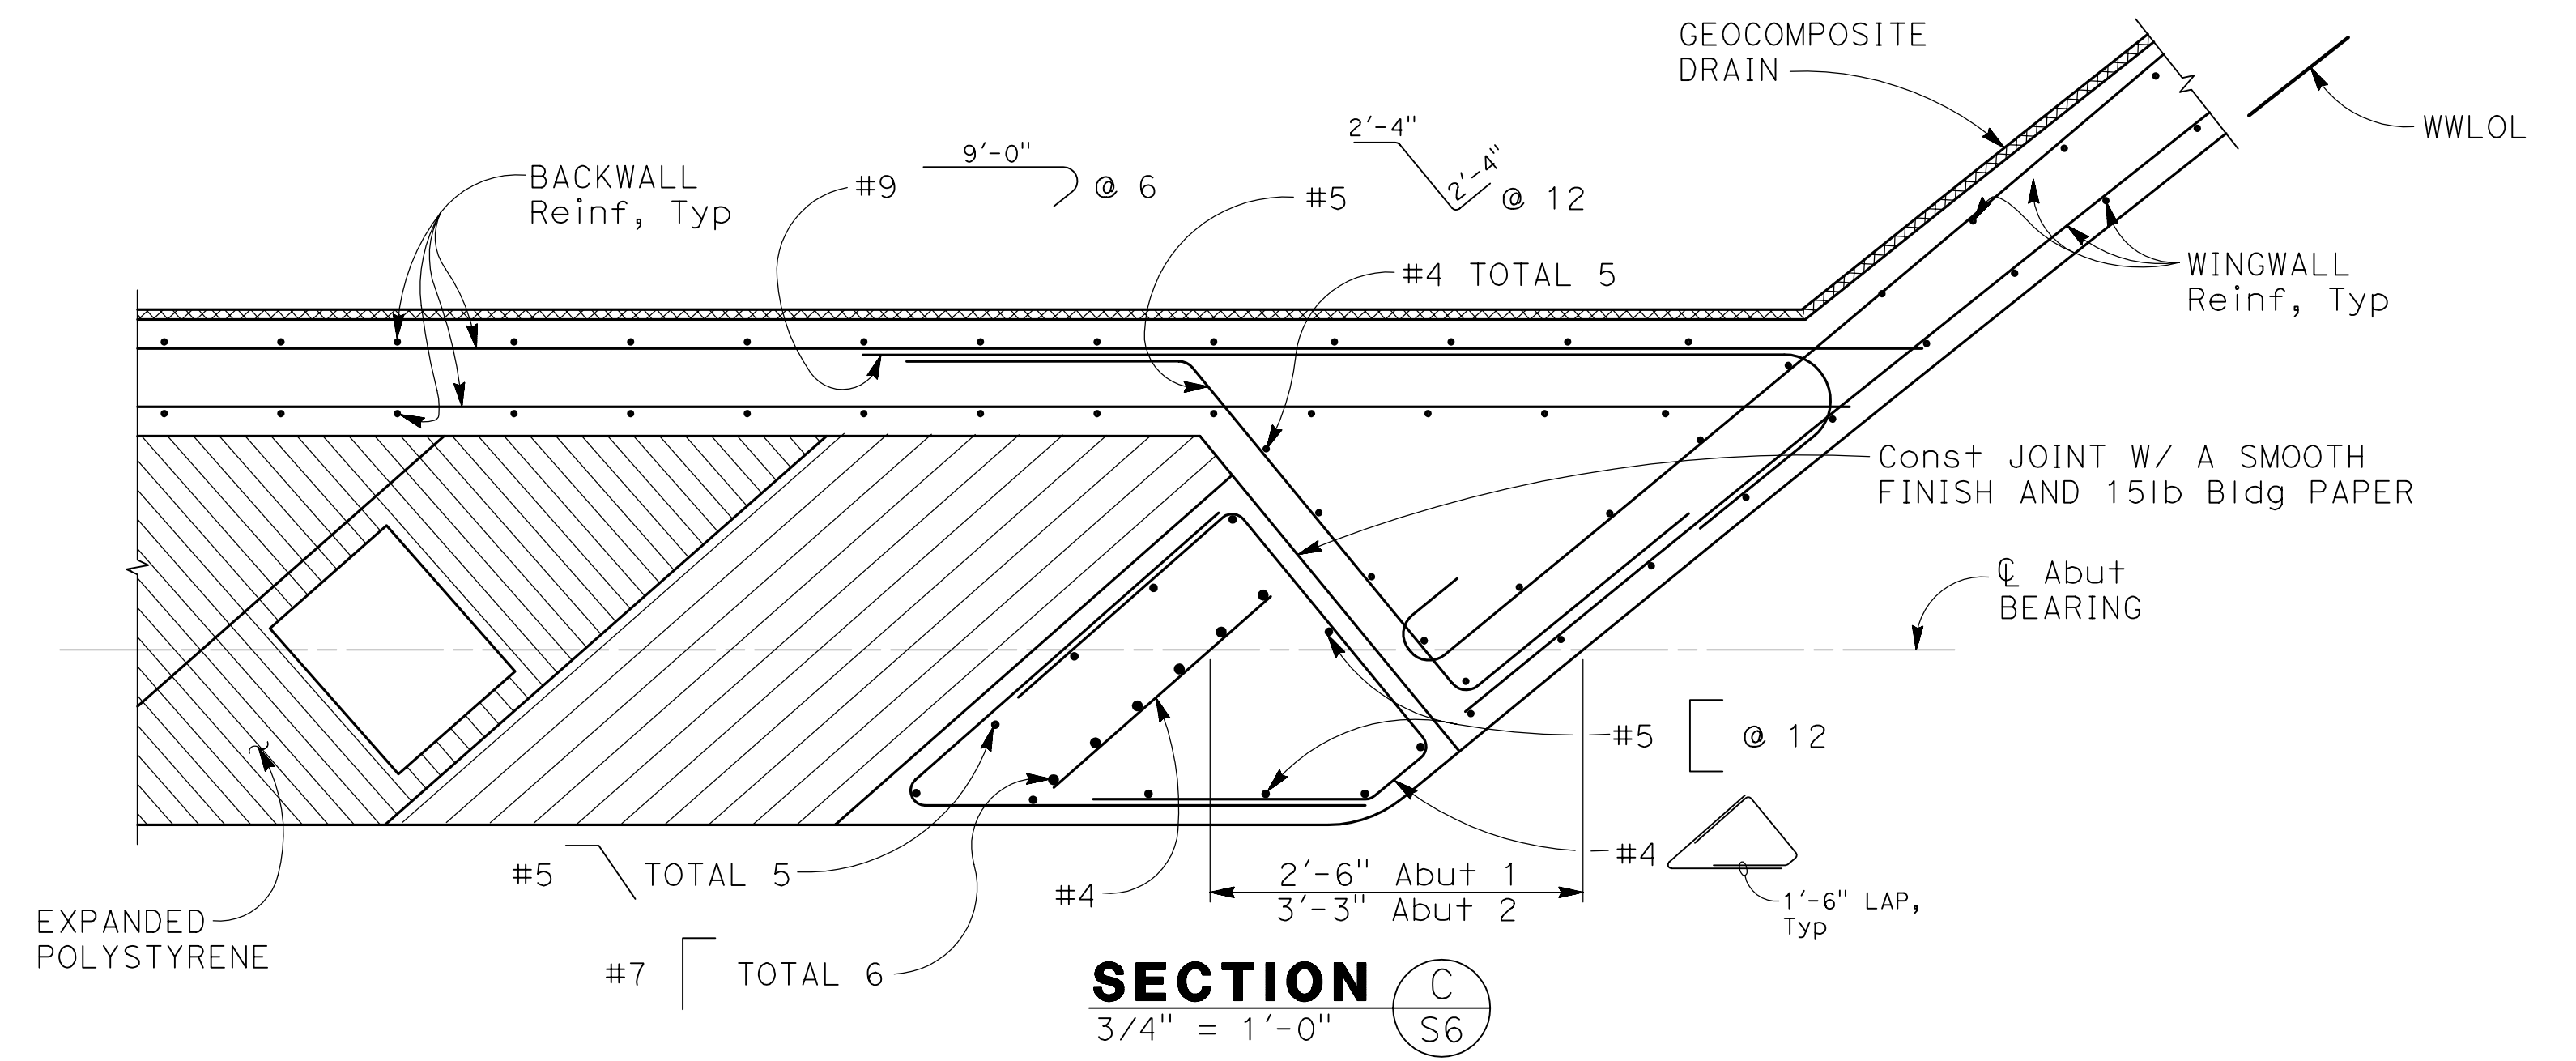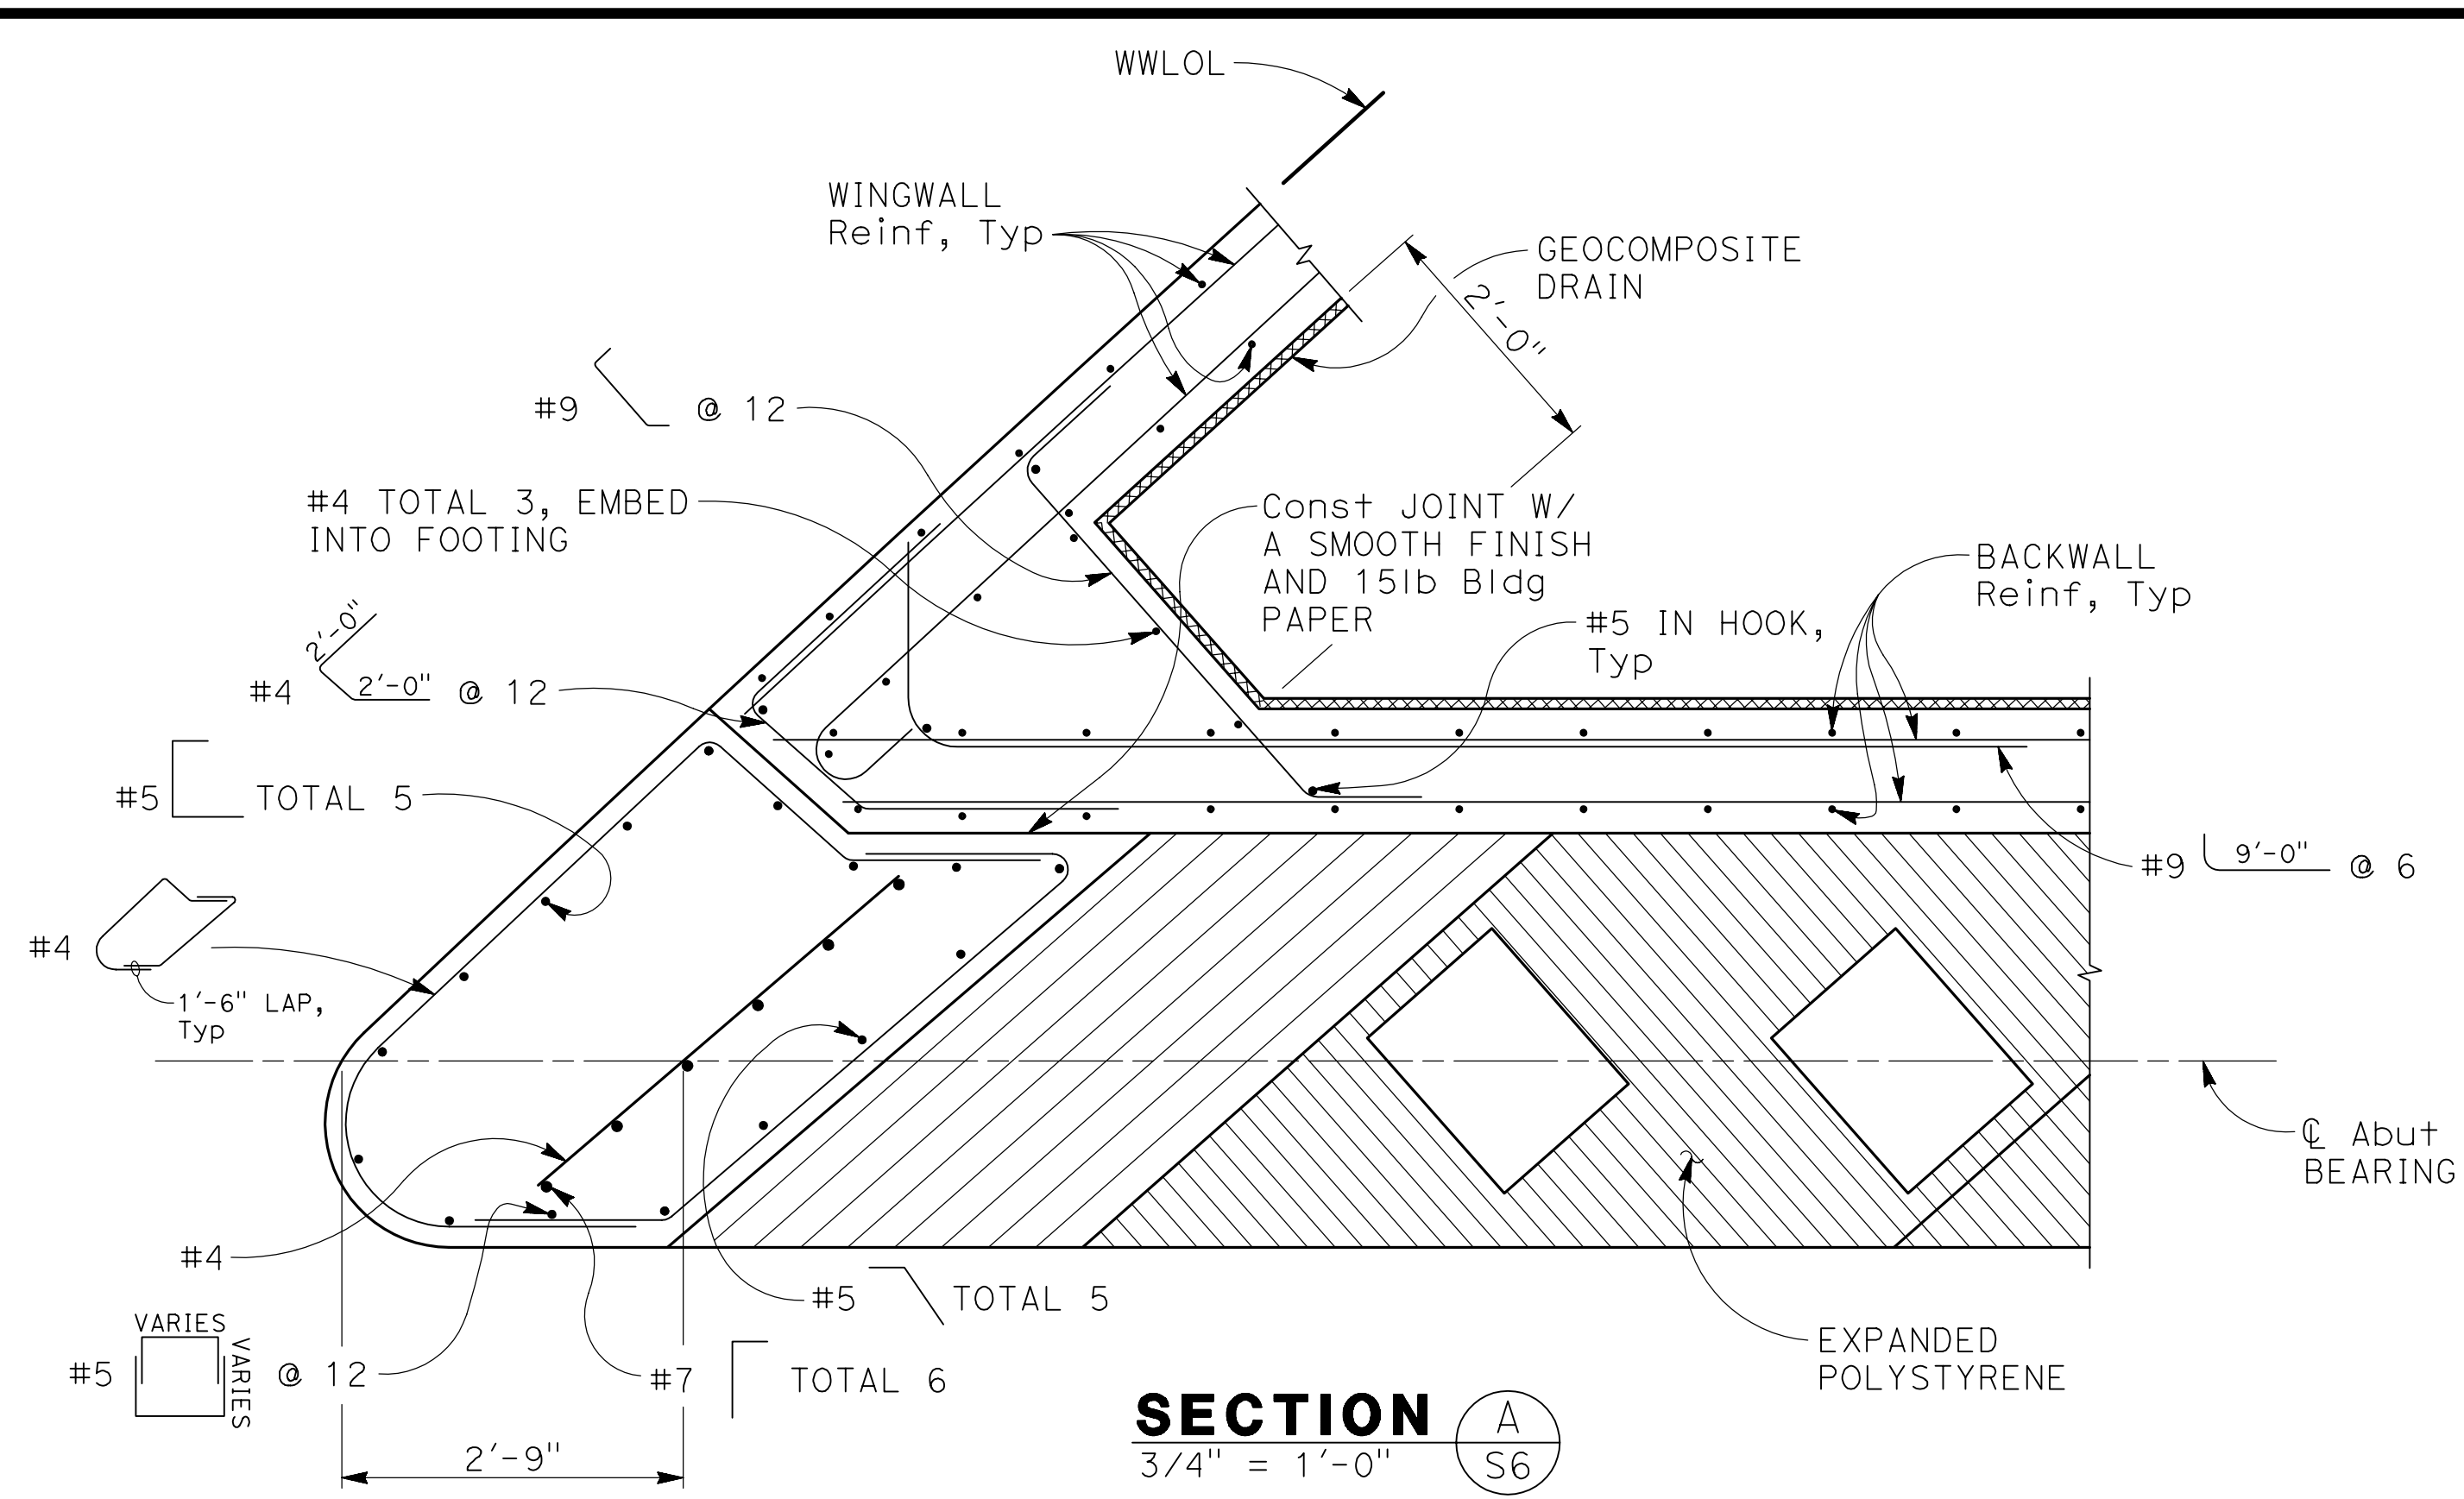


NOTE:  
THE CONTRACTOR MUST VERIFY ALL  
CONTROLLING FIELD DIMENSIONS BEFORE  
ORDERING OR FABRICATING ANY MATERIAL

S-6


RECORD DRAWING		SCALE
DESIGNED: SGS	DATE: 1/25/21	AS SHOWN
DRAWN: AR	DATE: 1/25/21	
CHECKED: ML	DATE: 1/25/21	

SCALE  
AS SHOWN

**BIGGS CARDOSA ASSOCIATES INC**  
STRUCTURAL ENGINEERS  
5250 N. Palm Avenue, Suite 211  
Fresno, California 93704  
559-449-8686

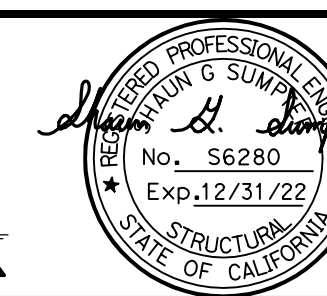


PROJECT  
**SAND CREEK BRIDGE REPLACEMENT ON ENNIS ROAD**  
ROAD NO. 2824-2825 BRIDGE NO. 42C0697, BRLO-5942(238)

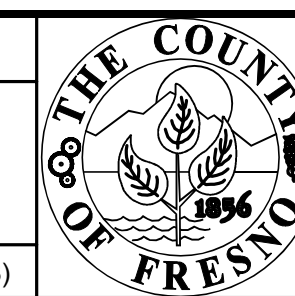

DEPARTMENT OF PUBLIC WORKS AND PLANNING  
**ABUTMENT DETAILS No. 2**  
DRAWING NO. 11257 SHEET NO. 23 TOTAL 31

201513456

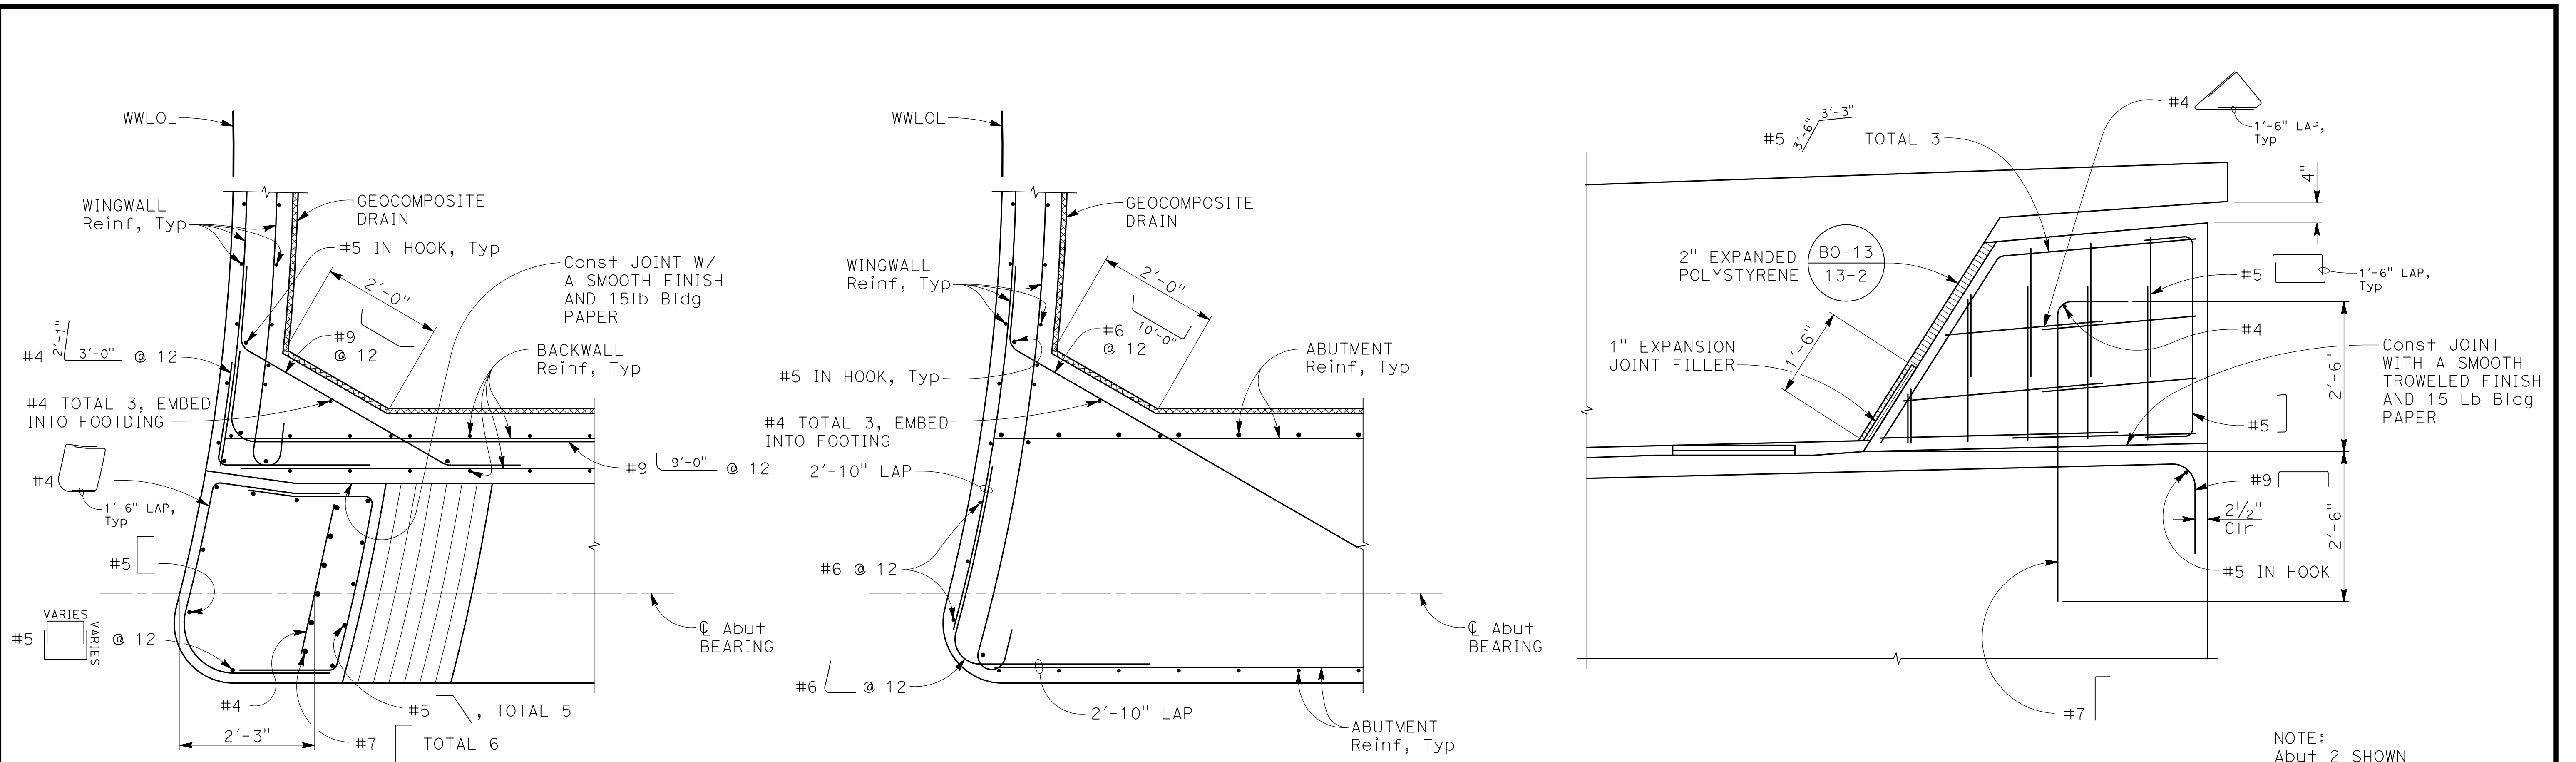


**SECTION A**  
3/4" = 1'-0" (S7)

**SECTION B**  
3/4" = 1'-0" (S7)


**DETAIL 1**  
3/4" = 1'-0" (S7)

NOTE:  
Abut 2 SHOWN  
Abut 1 SIMILAR

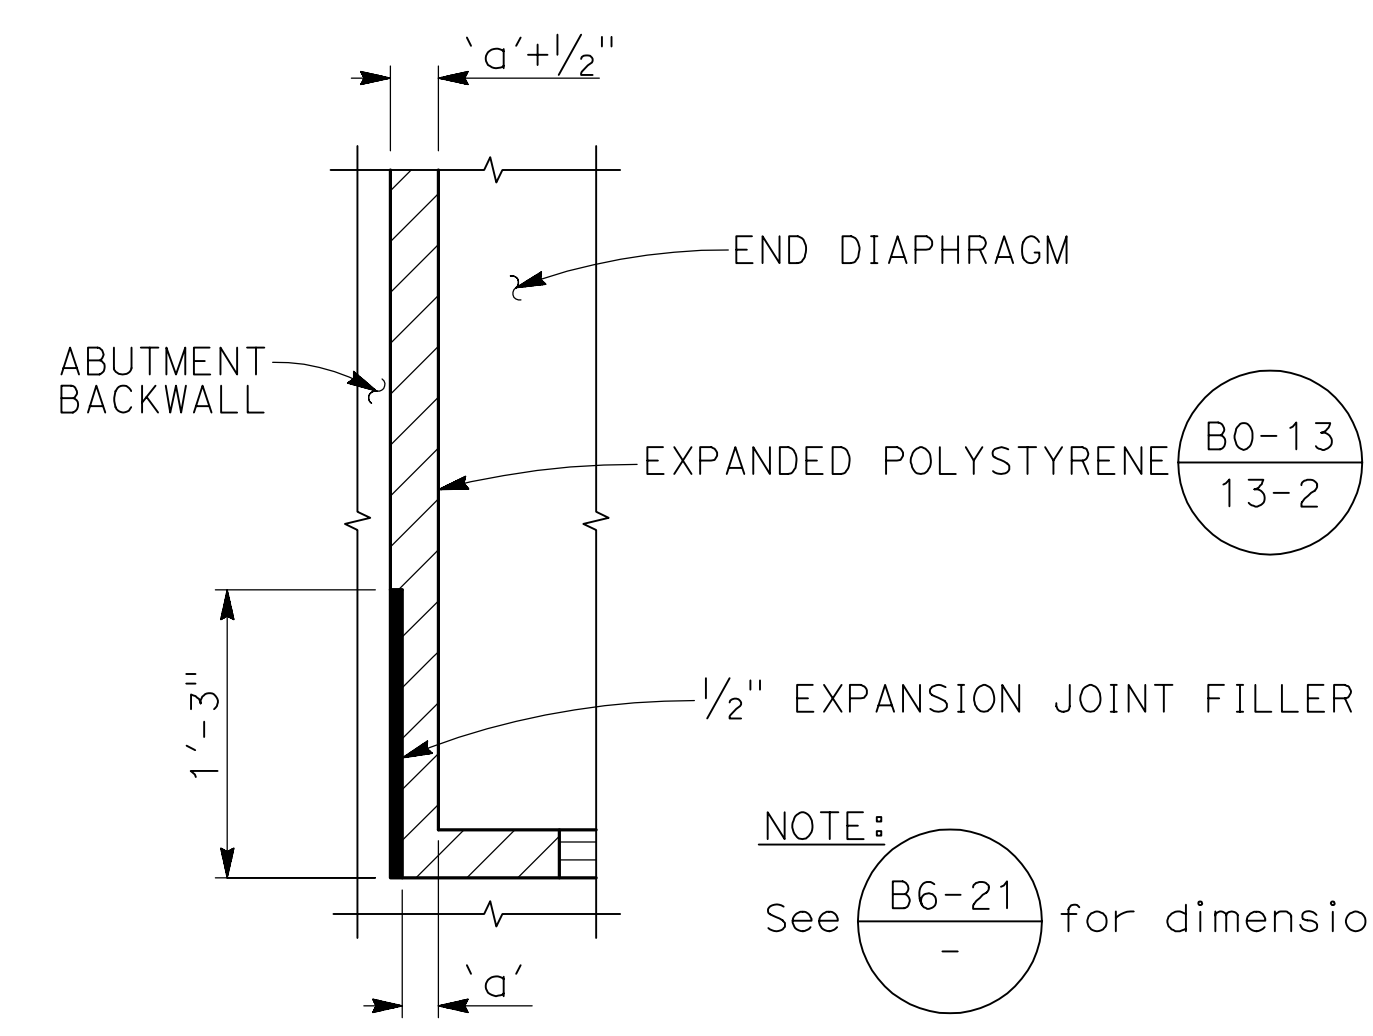


**DETAIL 2**  
NO SCALE (S7)

NOTE:  
See (B6-21) for dimension 'a'  
and see (A/S5) for Movement Rating

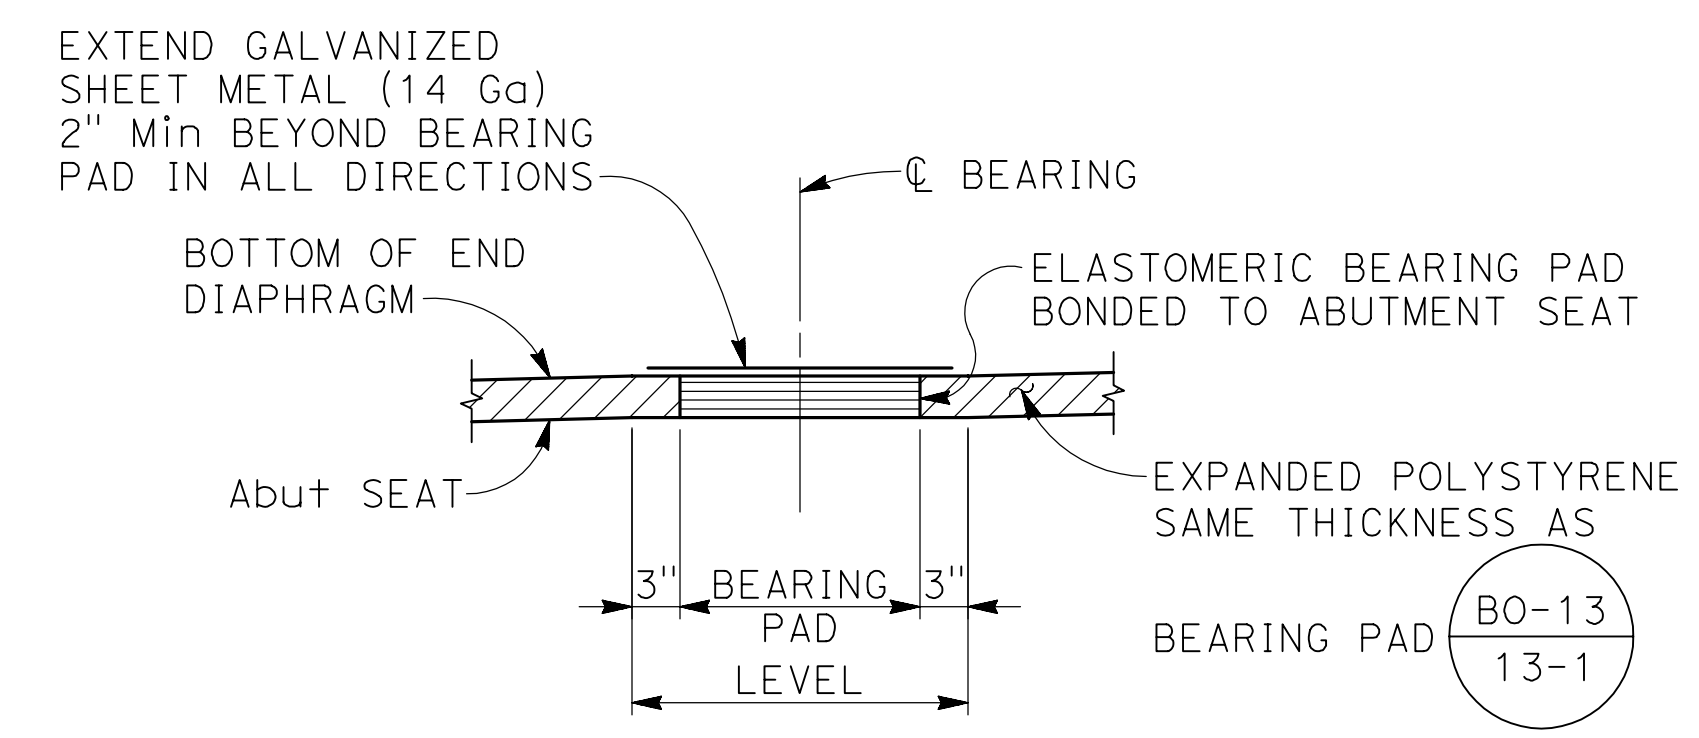

**DETAIL 3**  
1" = 1'-0" (S7)

NOTE:  
Coat top of bearing pad with grease

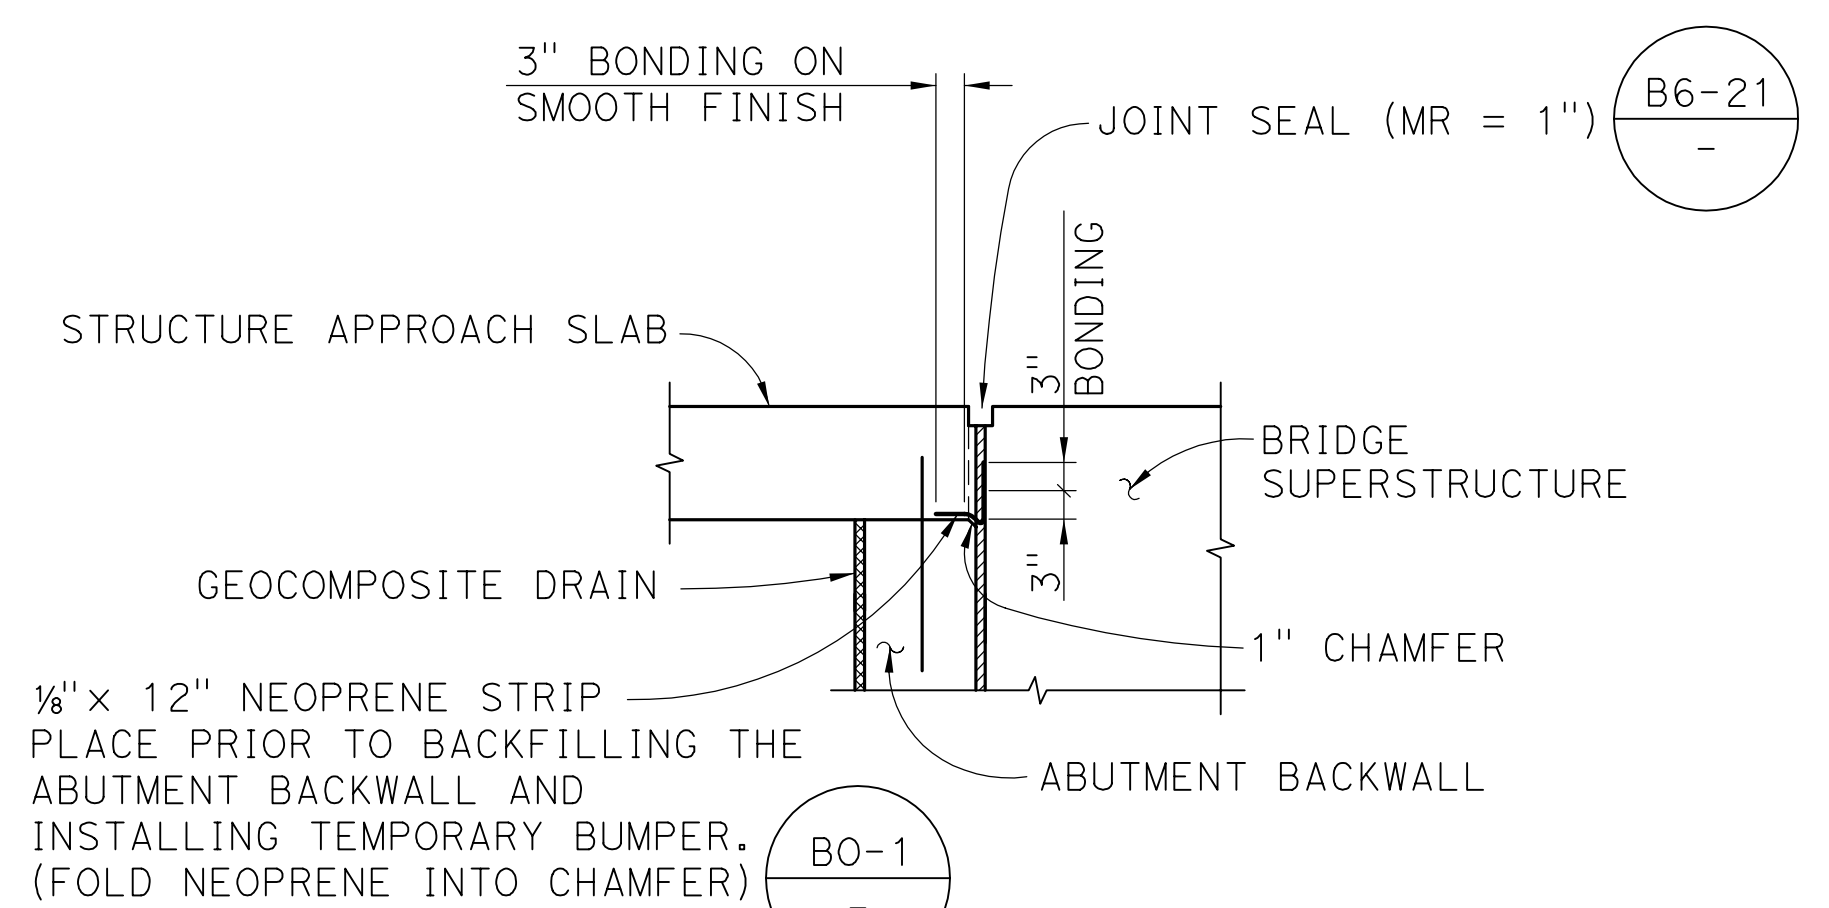


**JOINT PROTECTION DETAIL 4**  
NO SCALE (S7)

NOTE:  
THE CONTRACTOR MUST VERIFY ALL CONTROLLING FIELD DIMENSIONS BEFORE ORDERING OR FABRICATING ANY MATERIAL

DESIGNED: SGS		DATE: 1/25/21	RECORD DRAWING		SCALE	<b>BIGGS CARDOSA ASSOCIATES INC</b> STRUCTURAL ENGINEERS 5250 N. Palm Avenue, Suite 211 Fresno, California 93704 559-449-8686		PROJECT		DEPARTMENT OF PUBLIC WORKS AND PLANNING	
DRAWN: AR		DATE: 1/25/21	RESIDENT ENGINEER	DATE	AS SHOWN			SAND CREEK BRIDGE REPLACEMENT ON ENNIS ROAD		ABUTMENT DETAILS No. 3	
CHECKED: ML		DATE: 1/25/21						ROAD NO. 2824-2825		BRIDGE NO. 42C0697, BRLO-5942(238)	DRAWING NO. 11257





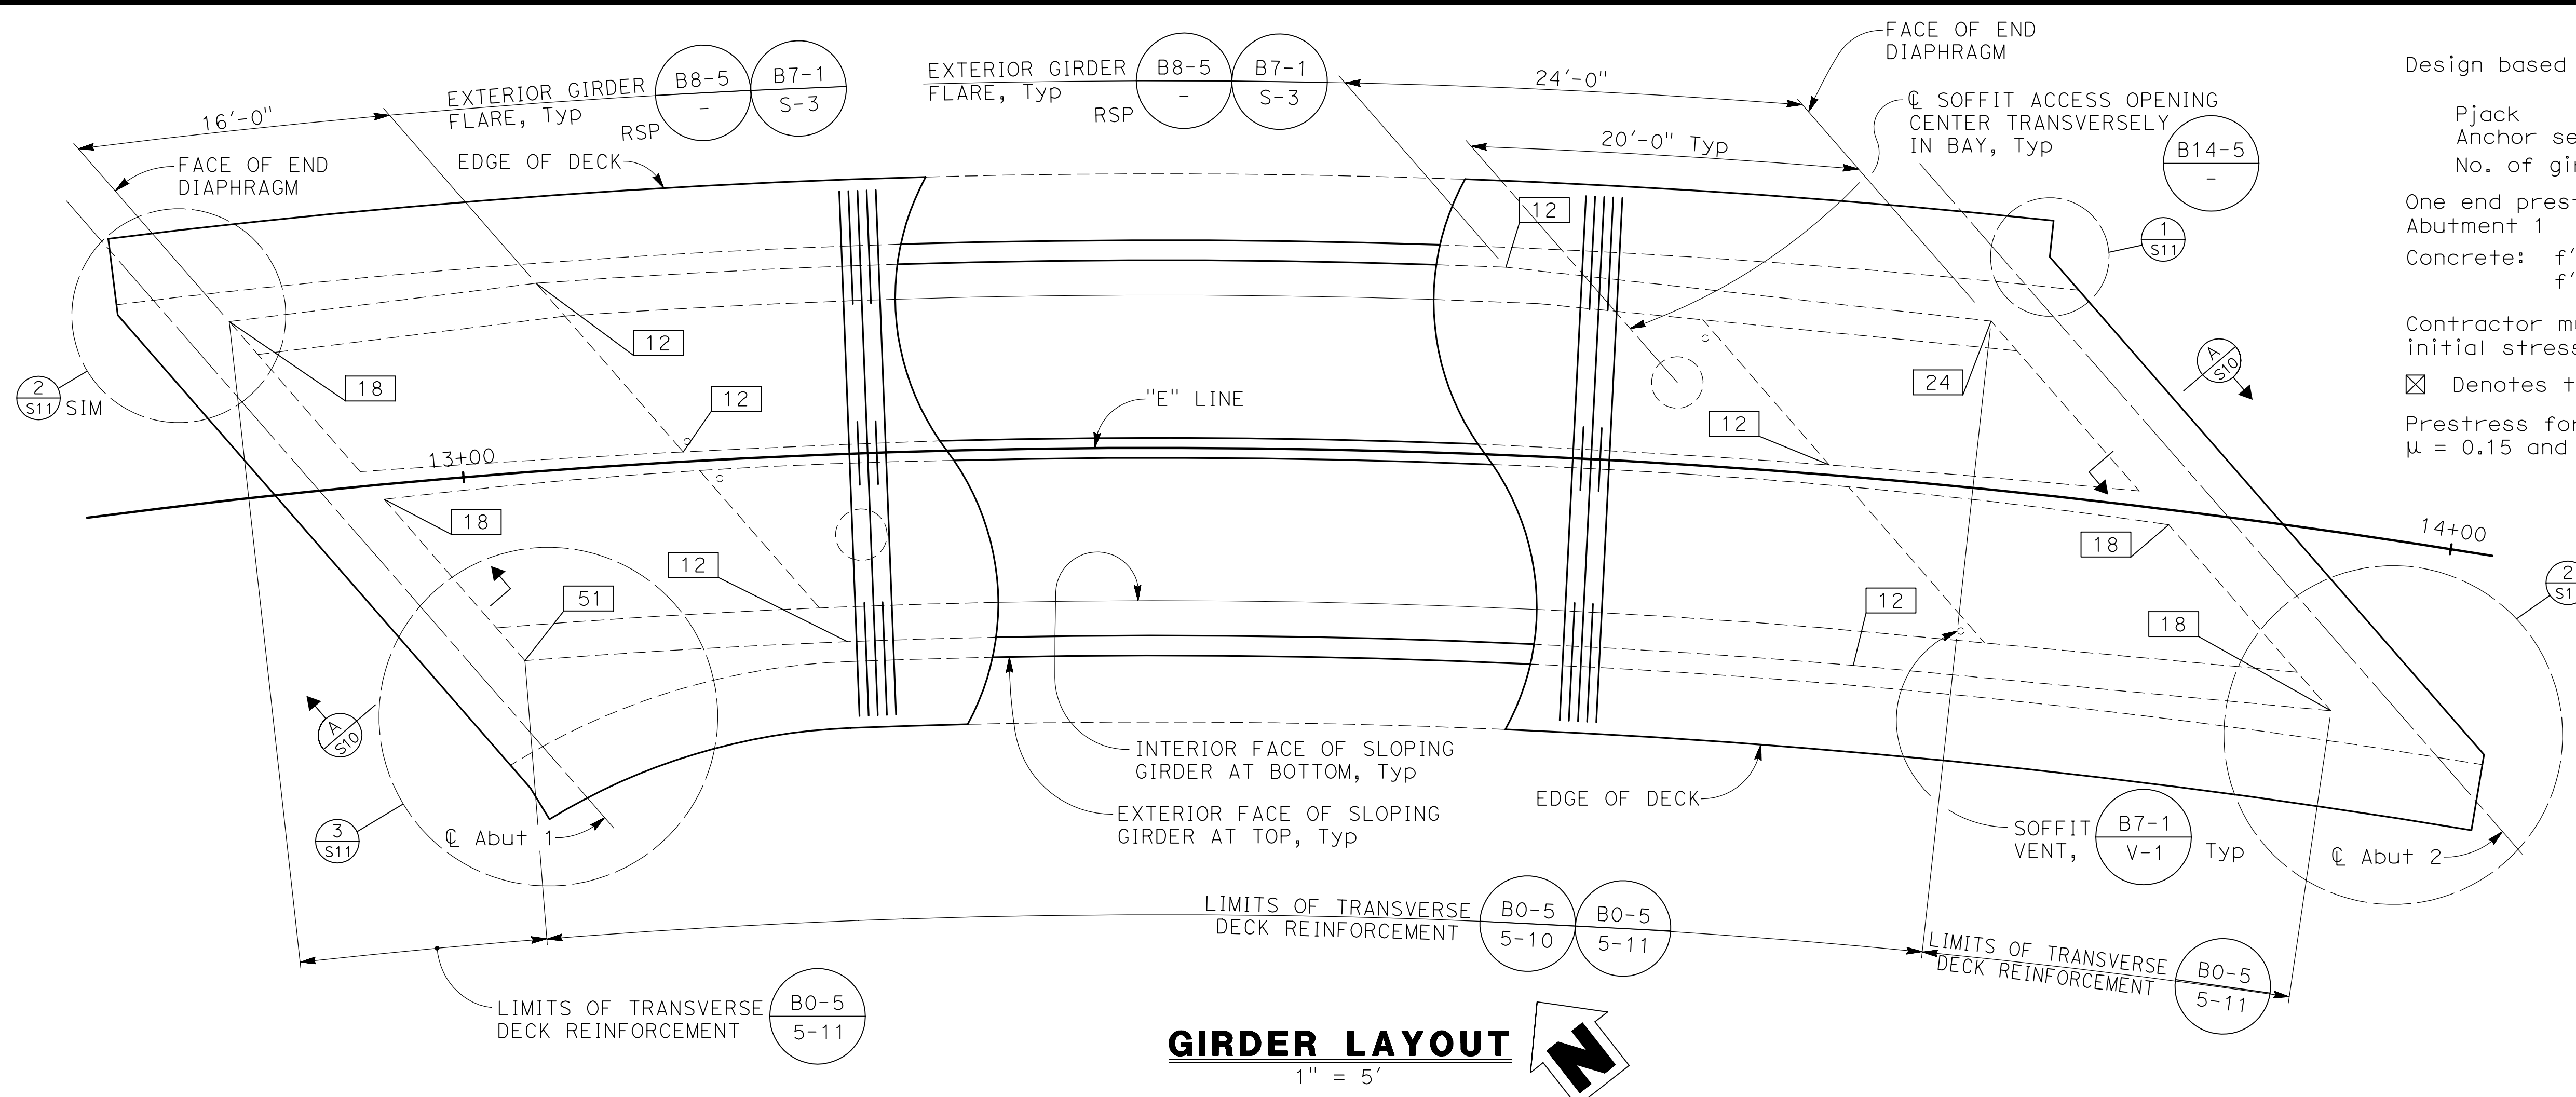

**PRESTRESSING NOTES**

Design based on 270 ksi Low Relaxation Strand:

Pjack = 5900 kips  
 Anchor set = 3/8 in  
 No. of girders = 3

One end prestressing shall be performed from Abutment 1


Concrete:  $f'c = 4000$  psi @ 28 days  
 $f'ci = 3500$  psi @ time of stressing

Contractor must submit elongation calculations based on initial stress at  $\square = 0.939$  times jacking stress

$\square$  Denotes theoretical point of no movement

Prestress force design is based on friction coefficient  $\mu = 0.15$  and friction wobble coefficient  $k=0.0002/ft.$

**GIRDER LAYOUT**  
 1" = 5'

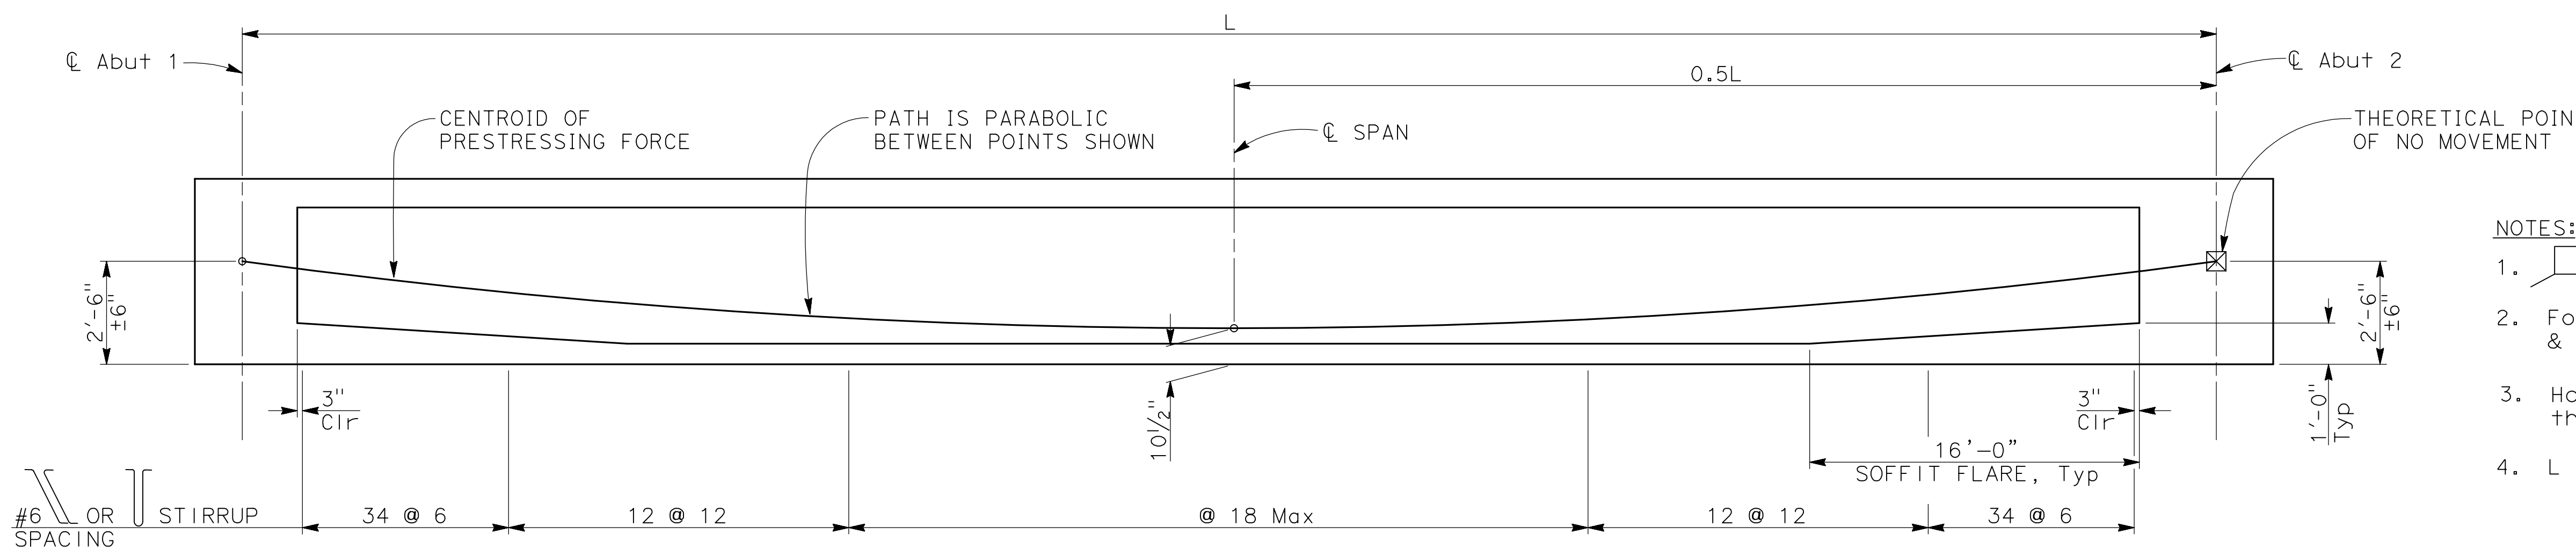


**LONGITUDINAL SECTION**  
 NO SCALE


- NOTES:**
- Indicates girder stem width in inches
  - For "CAMBER DIAGRAM" and "CONCRETE STRENGTH & TYPE LIMITS", see "DECK CONTOURS" sheet.
  - Horizontal tendon radius must be greater than 400 feet.
  - L is measured along the  $\text{\O}$  of each girder.

NOTE:  
 THE CONTRACTOR MUST VERIFY ALL CONTROLLING FIELD DIMENSIONS BEFORE ORDERING OR FABRICATING ANY MATERIAL

DESIGNED: SGS	DATE: 1/25/21	RECORD DRAWING		SCALE	<b>BIGGS CARDOSA ASSOCIATES INC</b> STRUCTURAL ENGINEERS 5250 N. Palm Avenue, Suite 211 Fresno, California 93704 559-449-8686	PROJECT		DEPARTMENT OF PUBLIC WORKS AND PLANNING	
DRAWN: AR	DATE: 1/25/21	RESIDENT ENGINEER	DATE	AS SHOWN		SAND CREEK BRIDGE REPLACEMENT ON ENNIS ROAD		GIRDER LAYOUT	
CHECKED: ML	DATE: 1/25/21					ROAD NO. 2824-2825		BRIDGE NO. 42C0697, BRLO-5942(238)	DRAWING NO. 11257

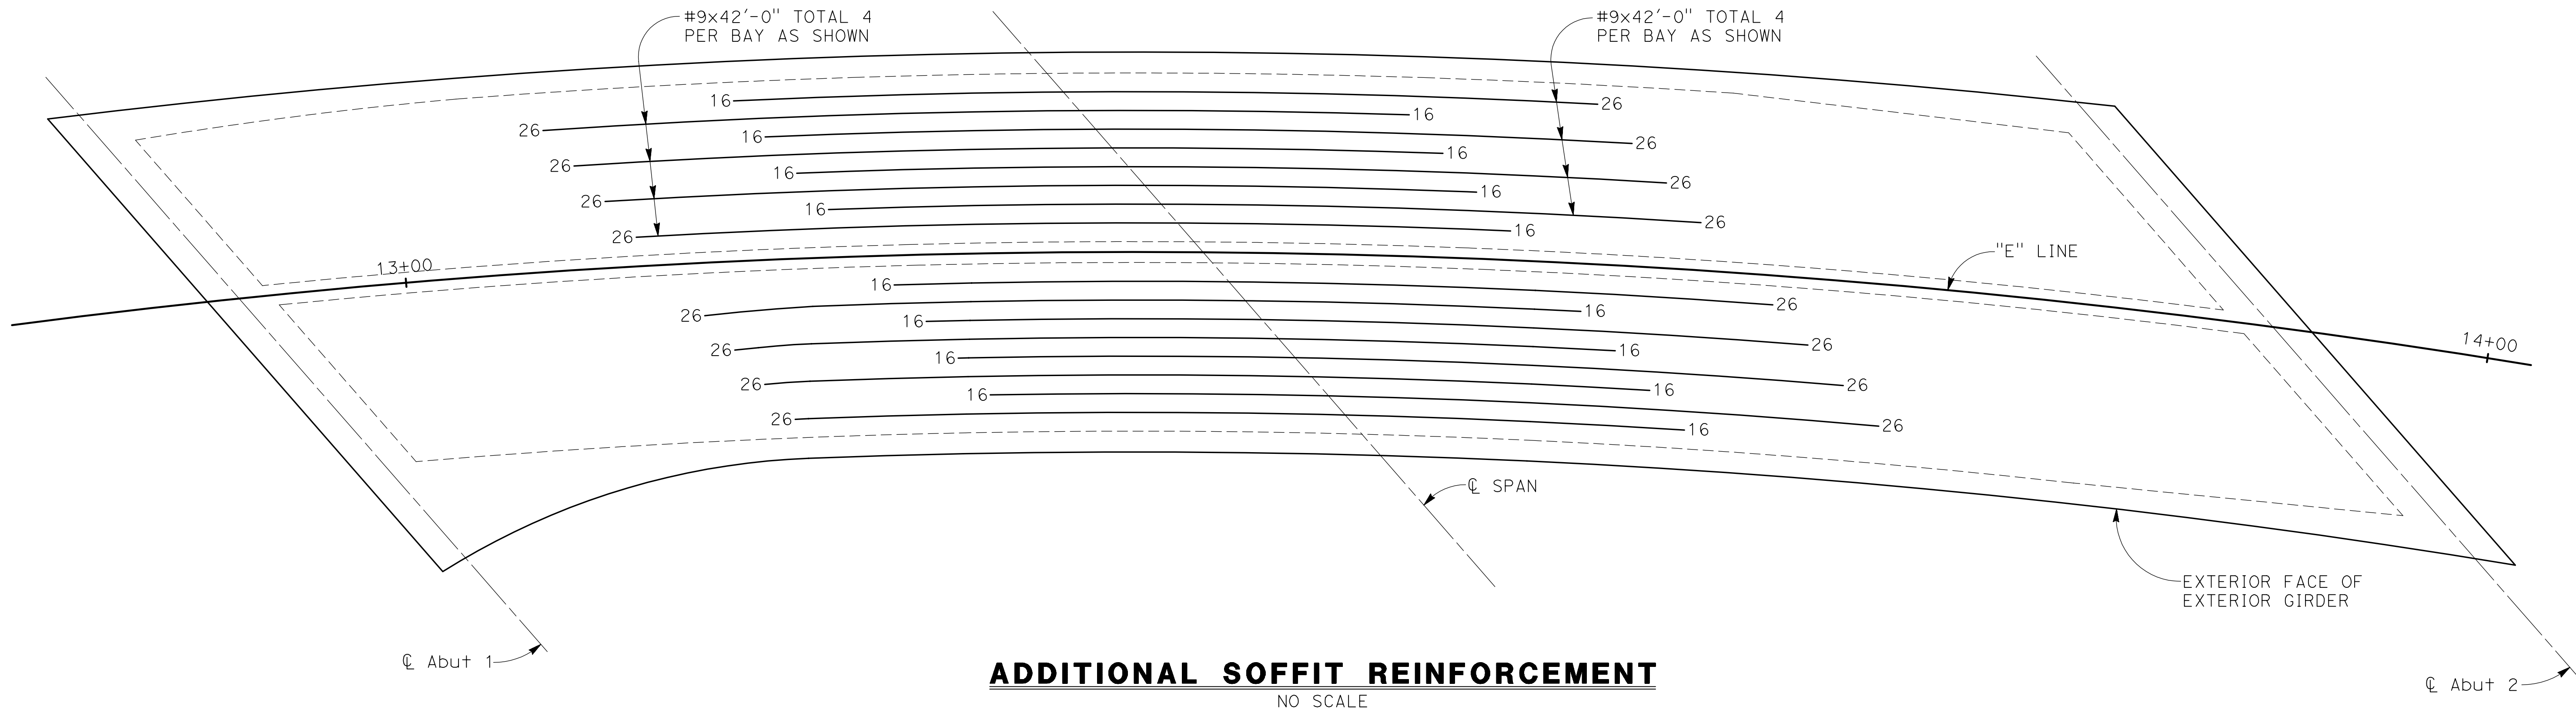

**ADDITIONAL SOFFIT REINFORCEMENT**  
NO SCALE

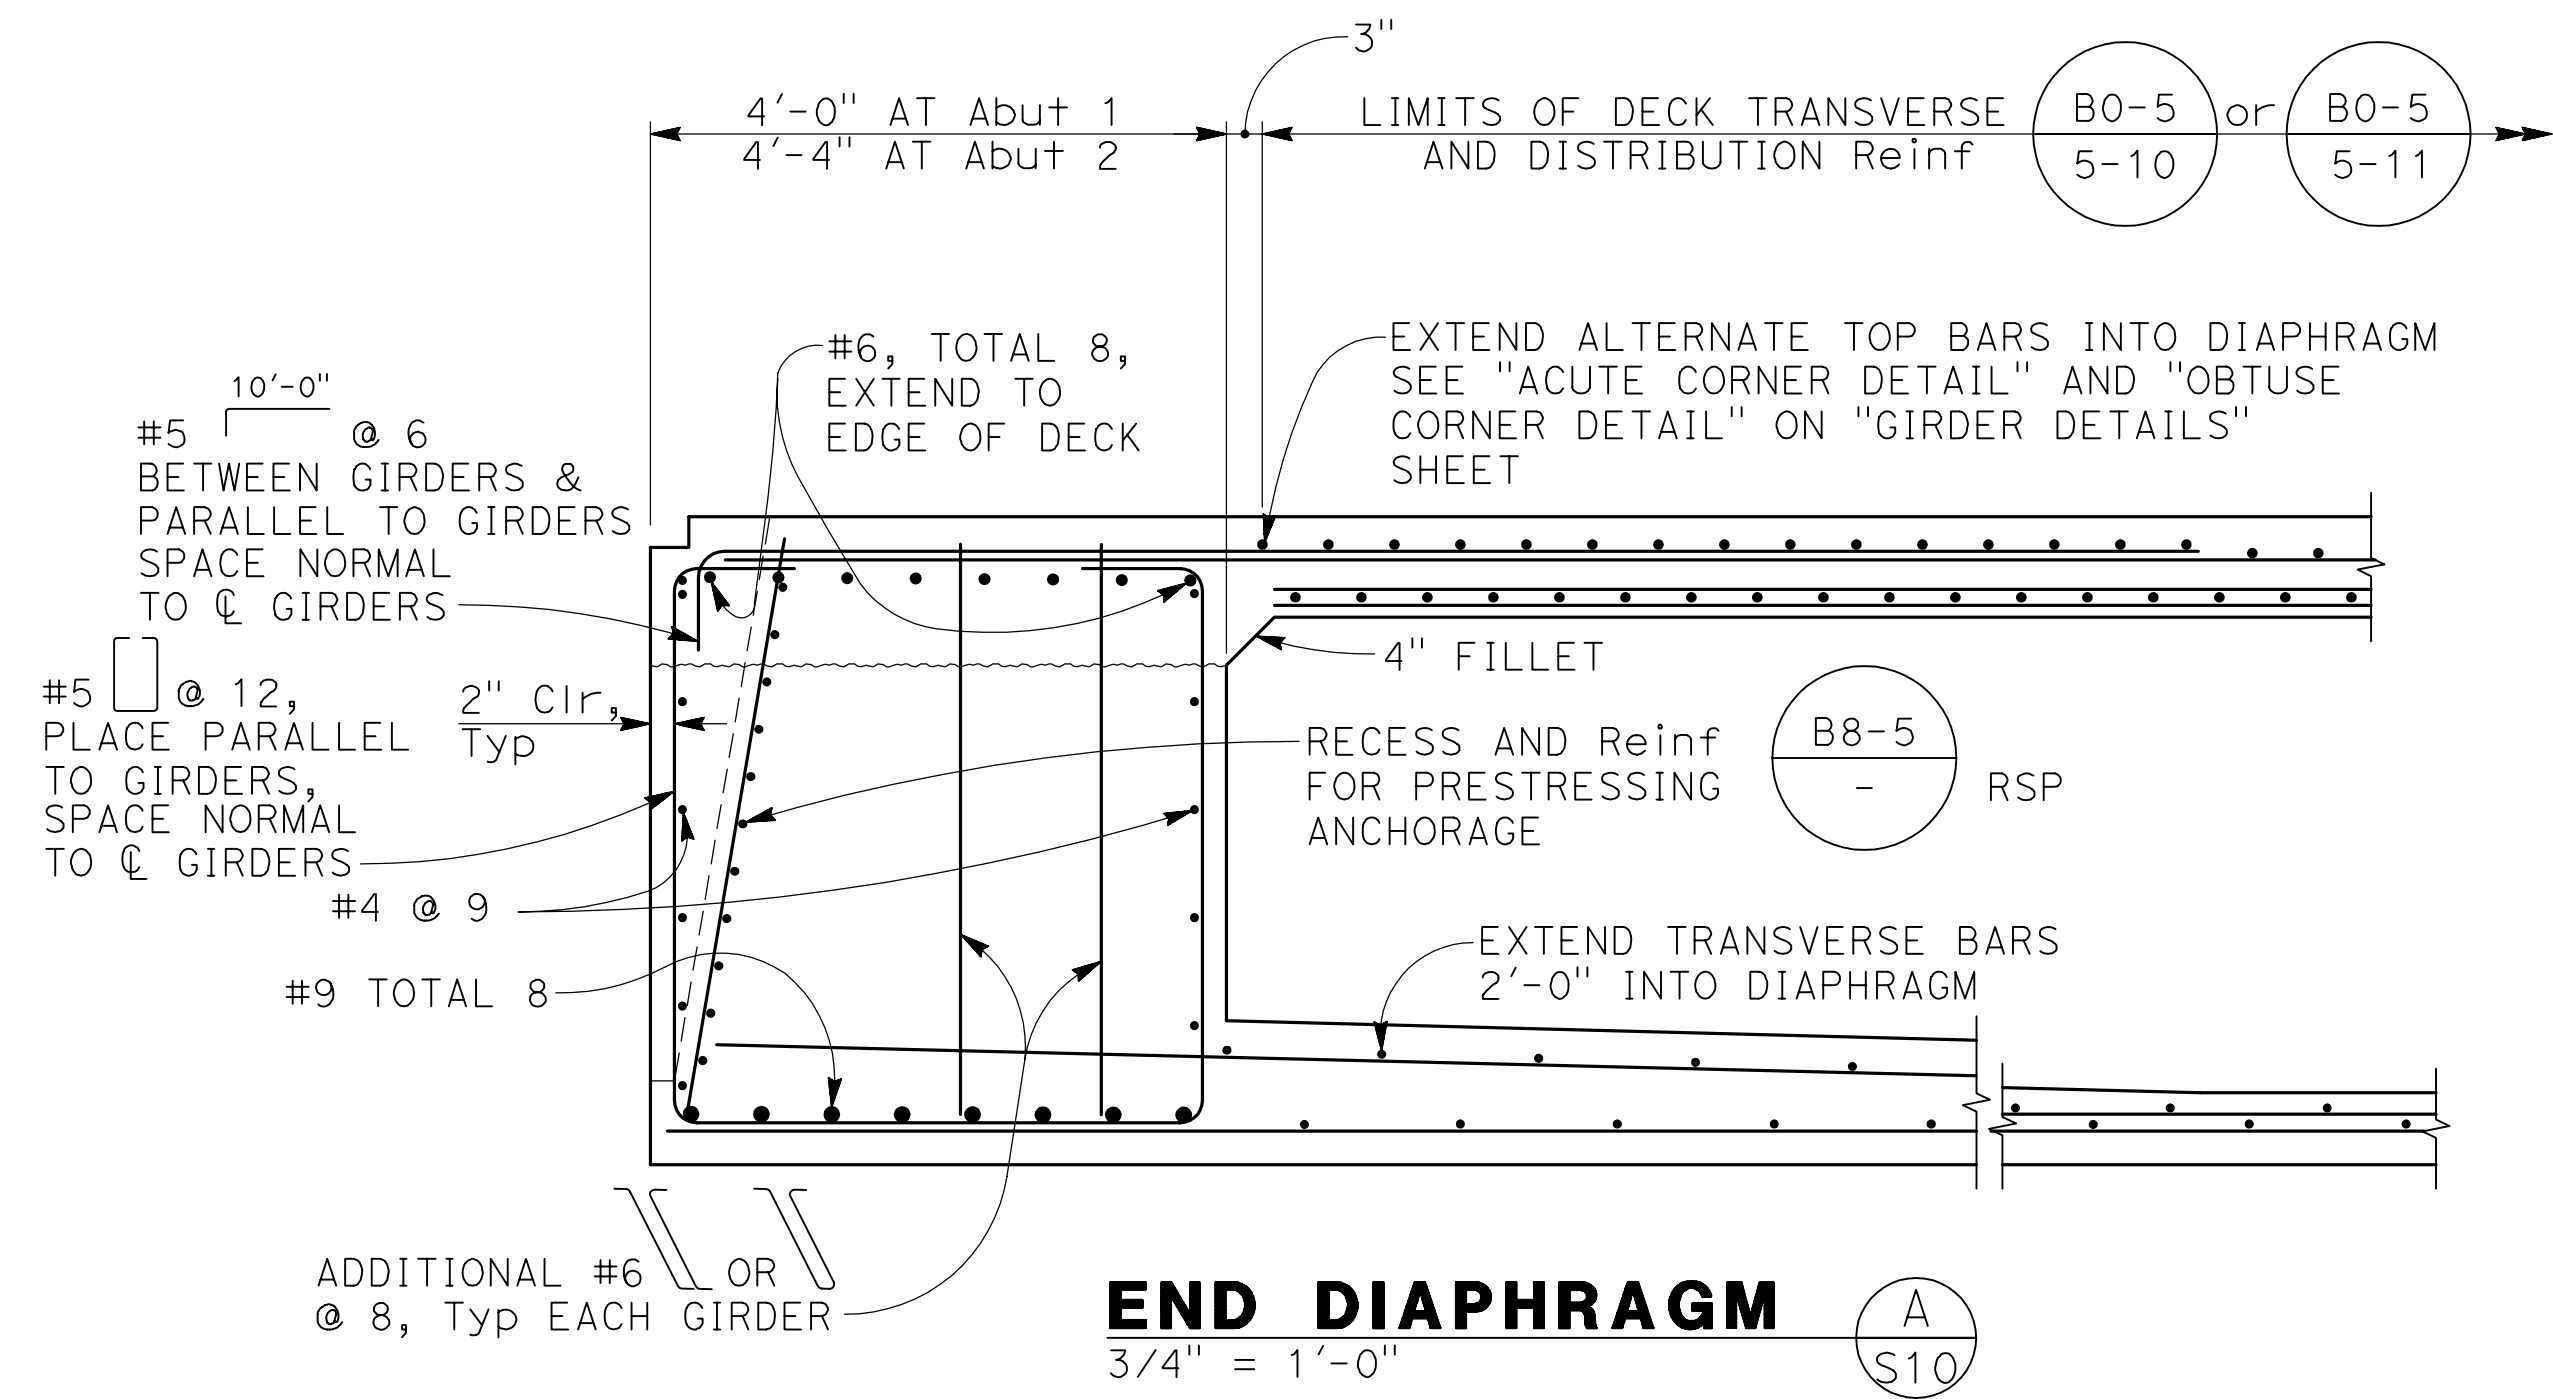

**END DIAPHRAGM**  
3/4" = 1'-0"

- NOTES:**
1. Reinforcement shown is in addition to reinforcement on "TYPICAL SECTION" sheet.
  2. All bars shall be evenly spaced within each bay.
  3. Reinforcement shall be placed parallel to "E" Line.
  4. Additional deck reinforcement not required. See "TYPICAL SECTION" sheet for all deck reinforcement.
  5. No splices allowed in #9x42'-0" additional reinforcement.
  6. Number at end of bar indicates distance in feet from CL Span.


NOTE:  
THE CONTRACTOR MUST VERIFY ALL CONTROLLING FIELD DIMENSIONS BEFORE ORDERING OR FABRICATING ANY MATERIAL

S-10


DESIGNED: SGS		DATE: 1/25/21	RECORD DRAWING		SCALE: AS SHOWN	<b>BIGGS CARDOSA ASSOCIATES INC</b> STRUCTURAL ENGINEERS 5250 N. Palm Avenue, Suite 211 Fresno, California 93704 559-449-8686		PROJECT: SAND CREEK BRIDGE REPLACEMENT ON ENNIS ROAD		DEPARTMENT OF PUBLIC WORKS AND PLANNING
DRAWN: AR		DATE: 1/25/21						BRIDGE NO. 42C0697, BRLO-5942(238)		GIRDER REINFORCEMENT
CHECKED: ML		DATE: 1/25/21						ROAD NO. 2824-2825		DRAWING NO. 11257 SHEET NO. 27 TOTAL 31

FOR RIGHT OF WAY DATA AND ACCURATE ACCESS DETERMINATION, SEE DOCUMENTS IN THE DEPARTMENT OF PUBLIC WORKS AND PLANNING.


2015194510

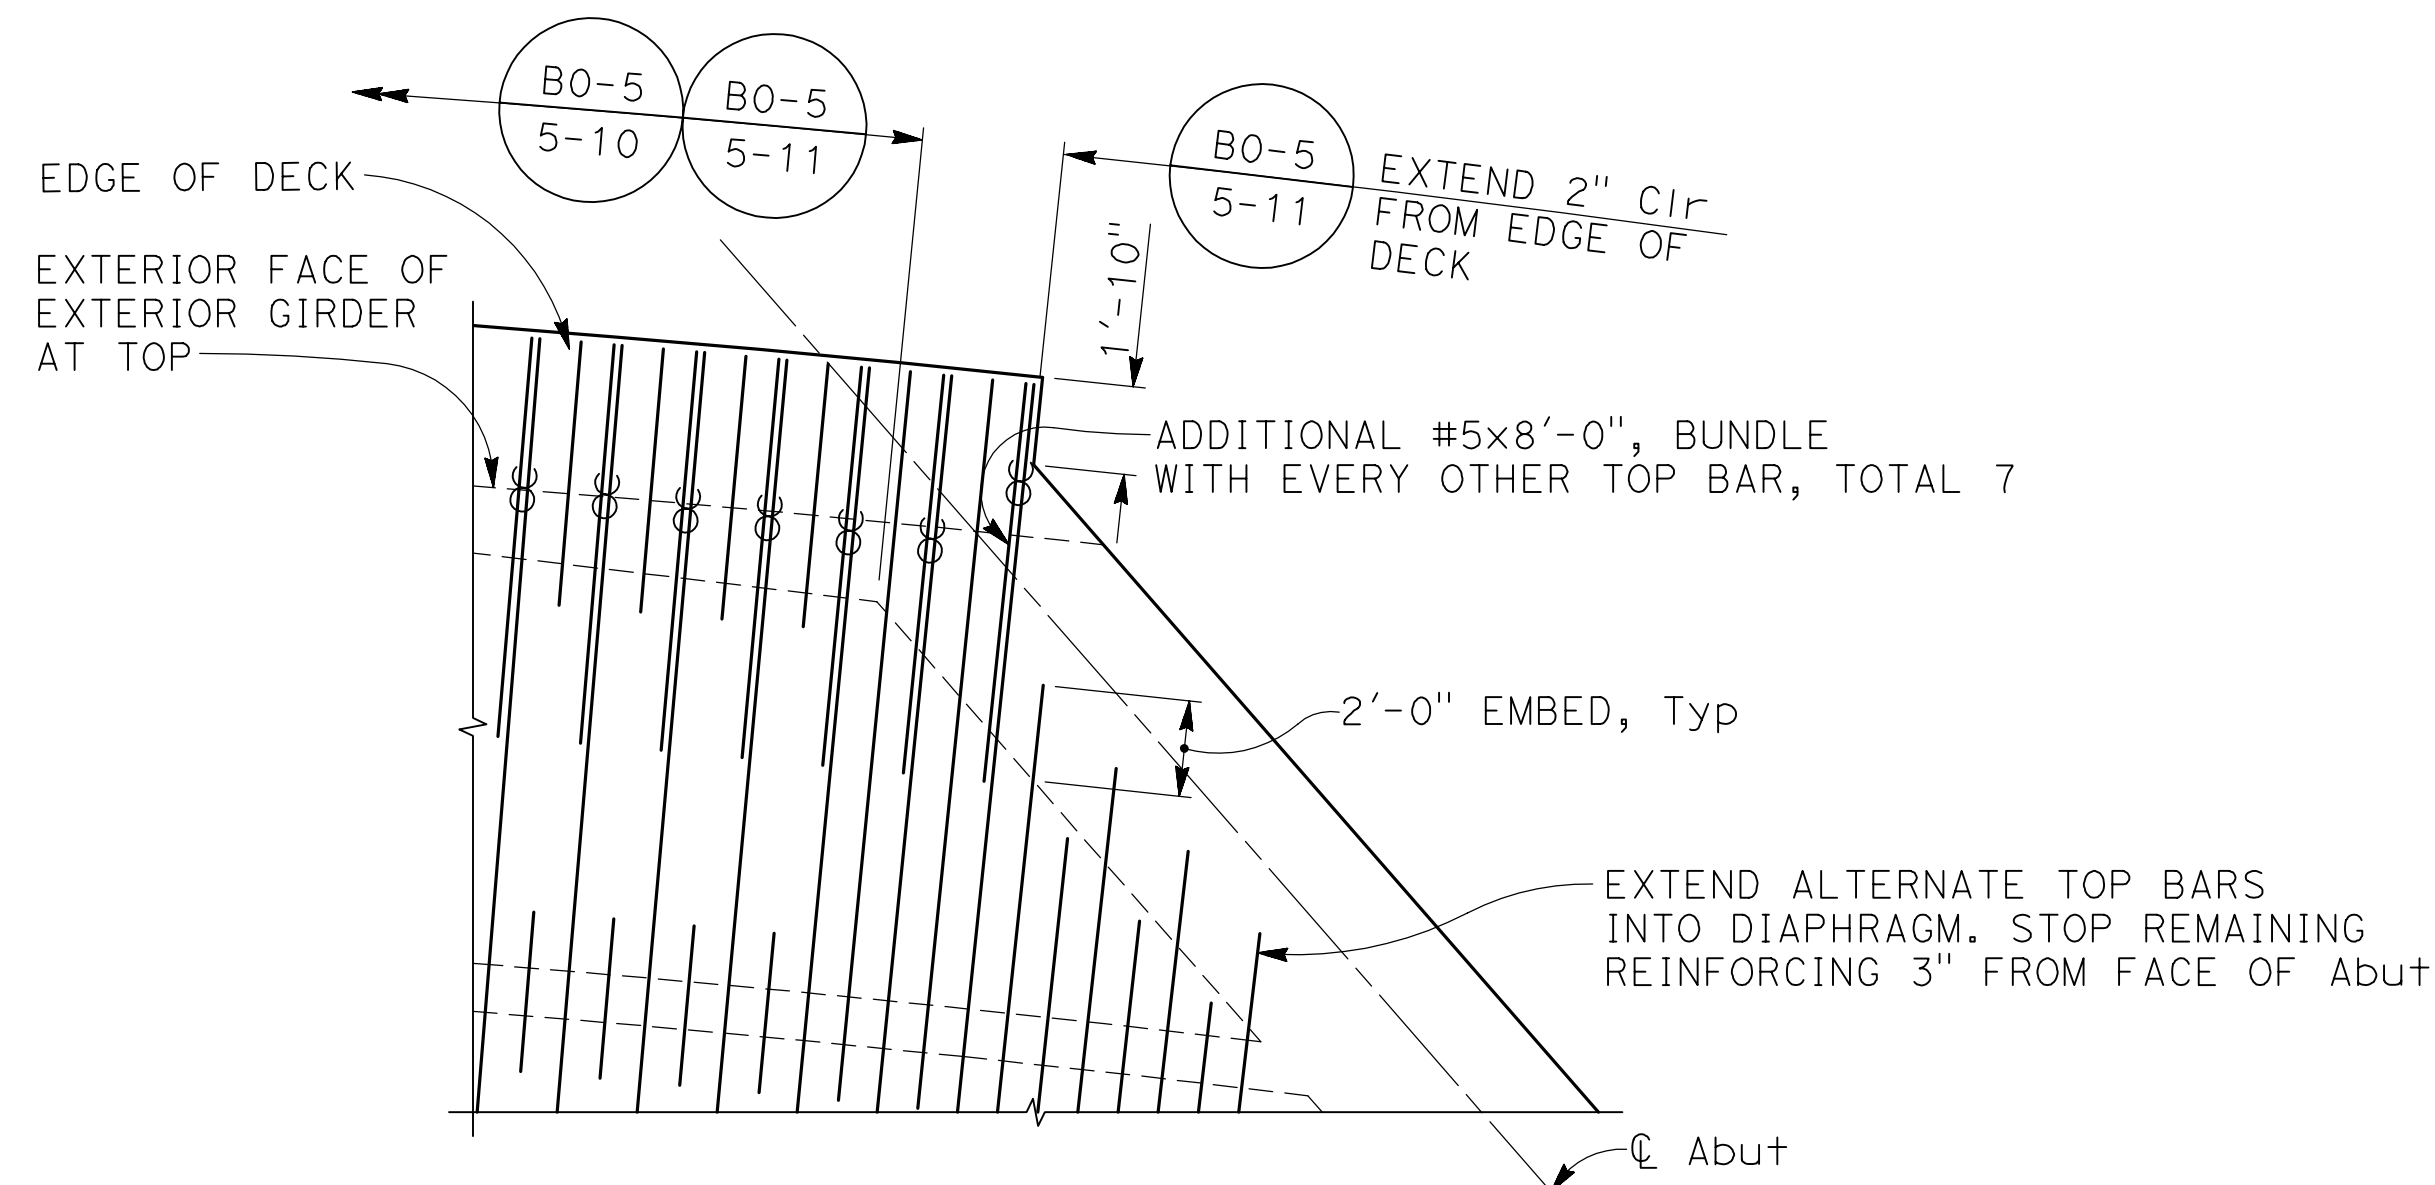


**OBTUSE CORNER DETAIL** (1)  
NO SCALE S11

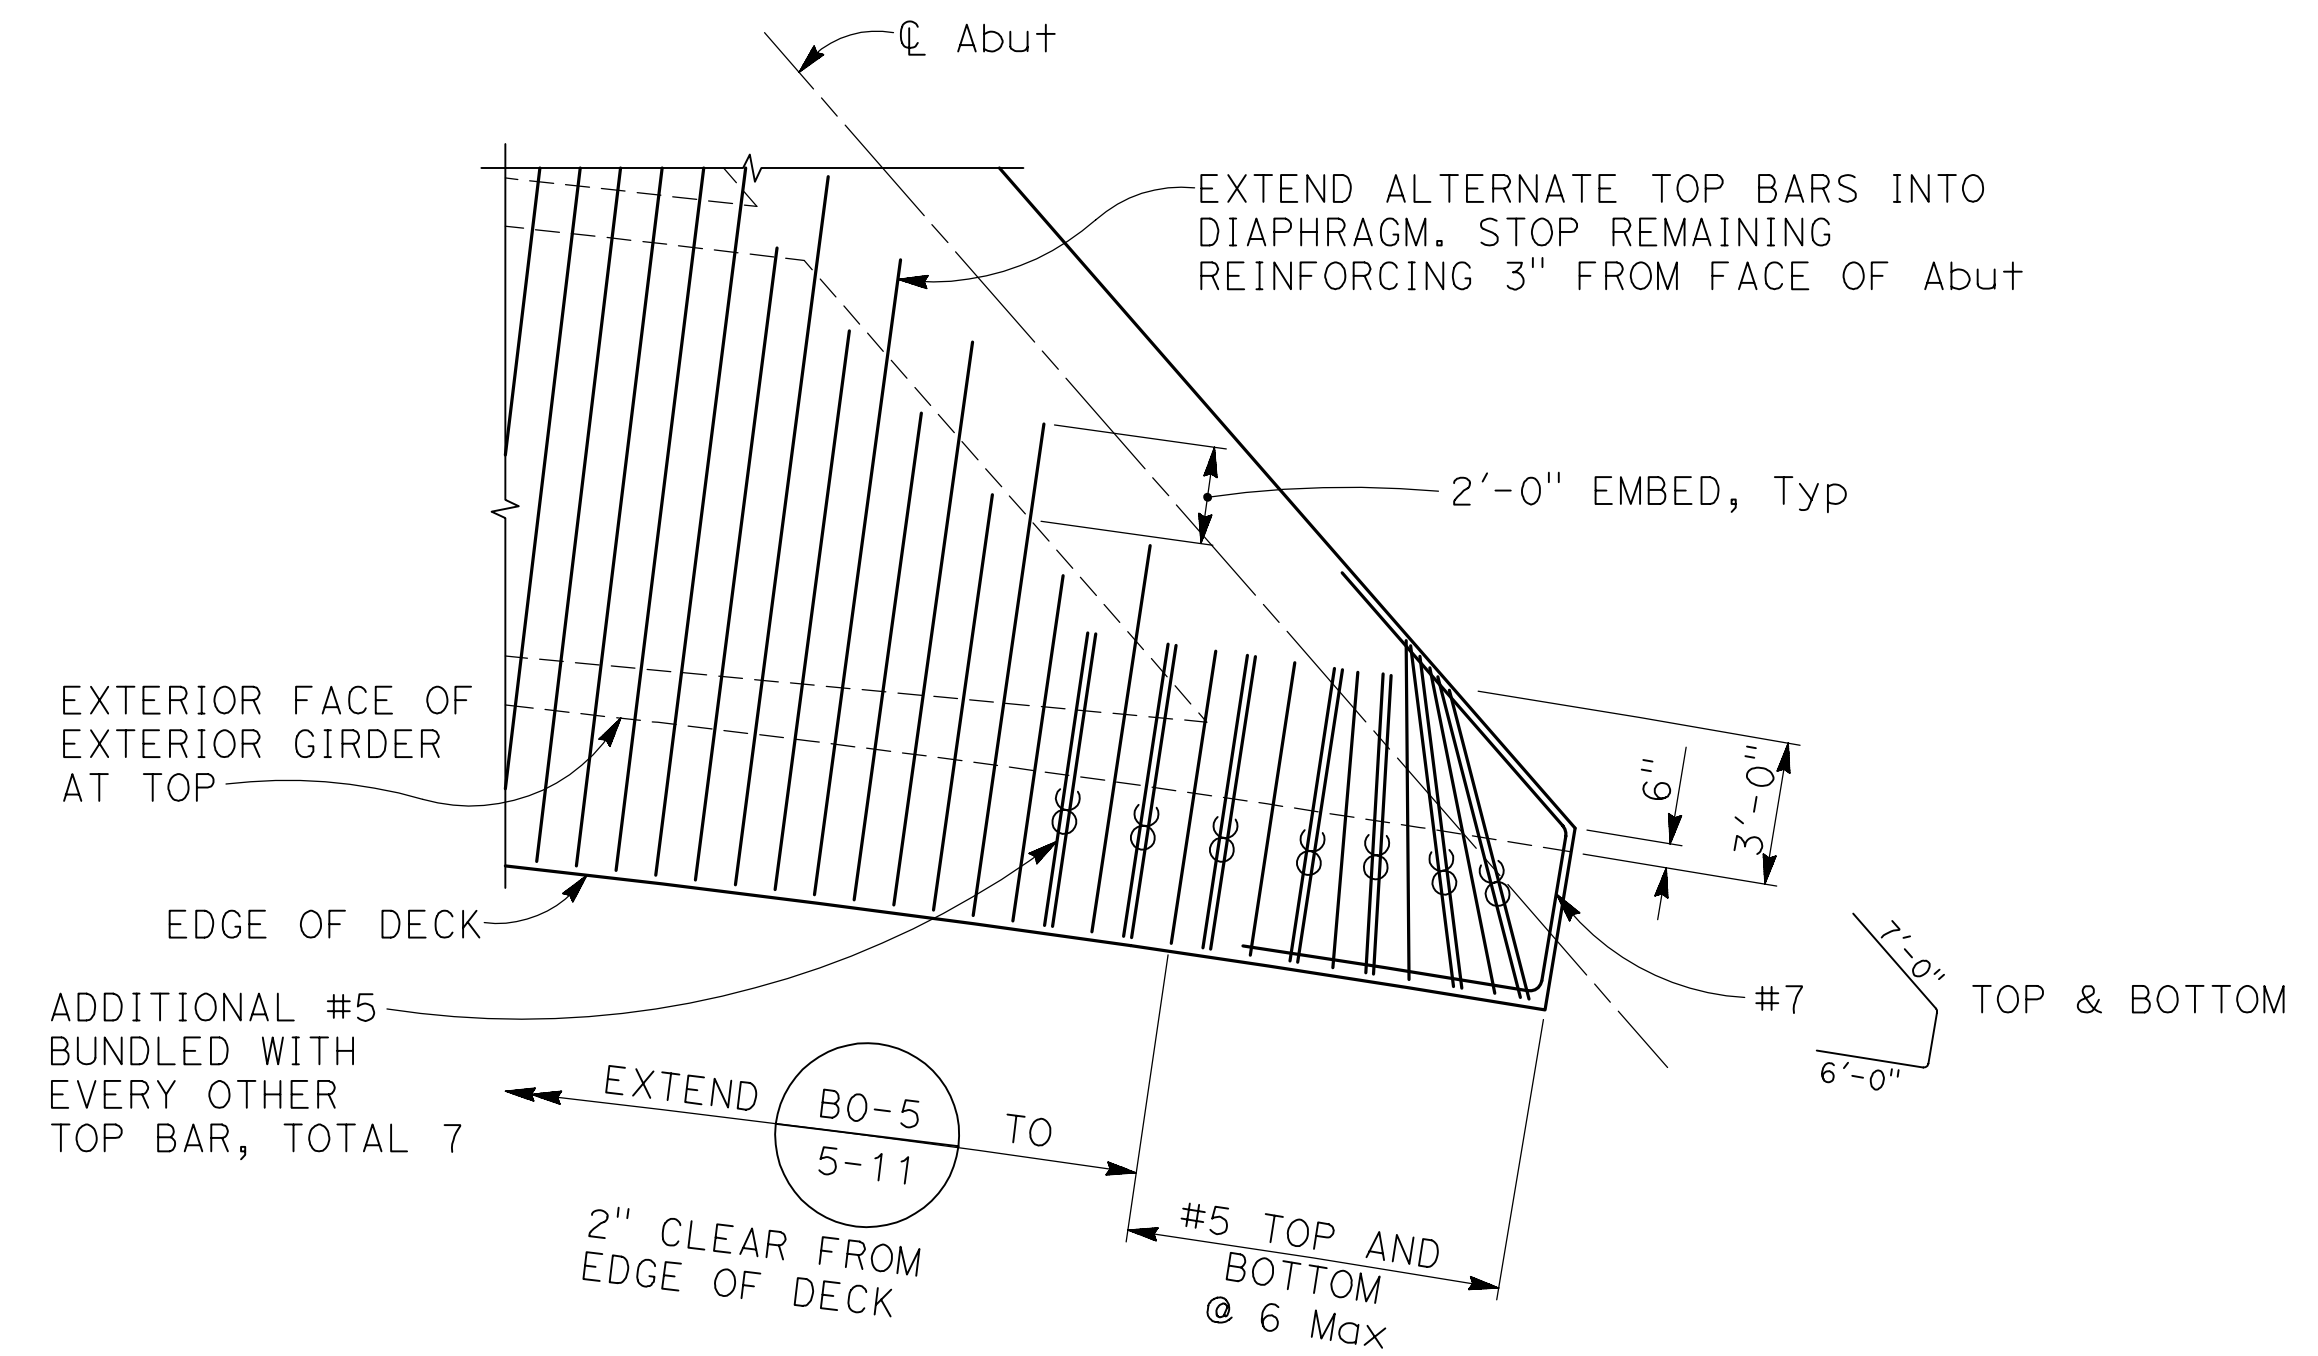

**ACUTE CORNER DETAIL** (2)  
NO SCALE S11

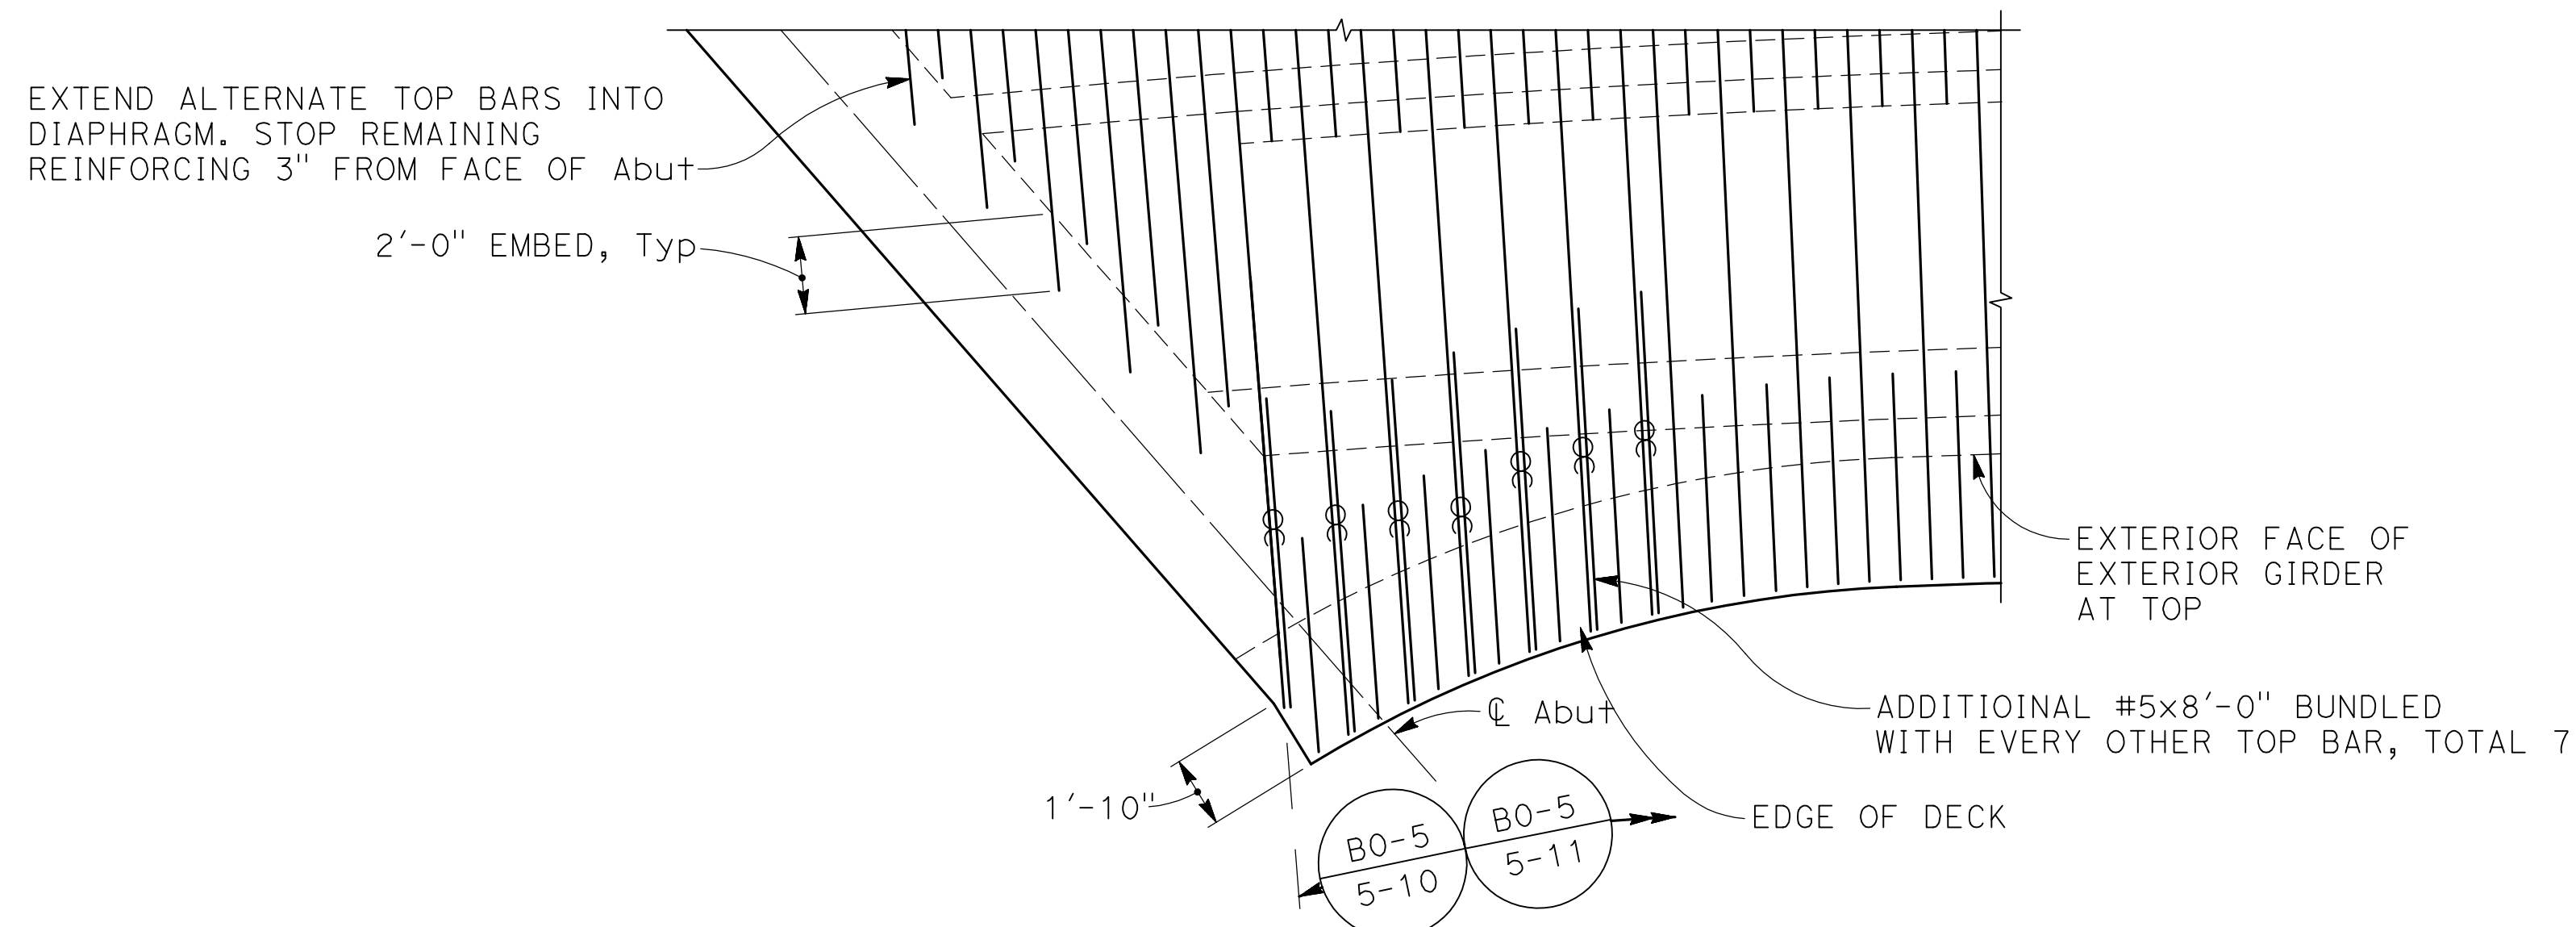

**OBTUSE CORNER DETAIL** (3)  
NO SCALE S11

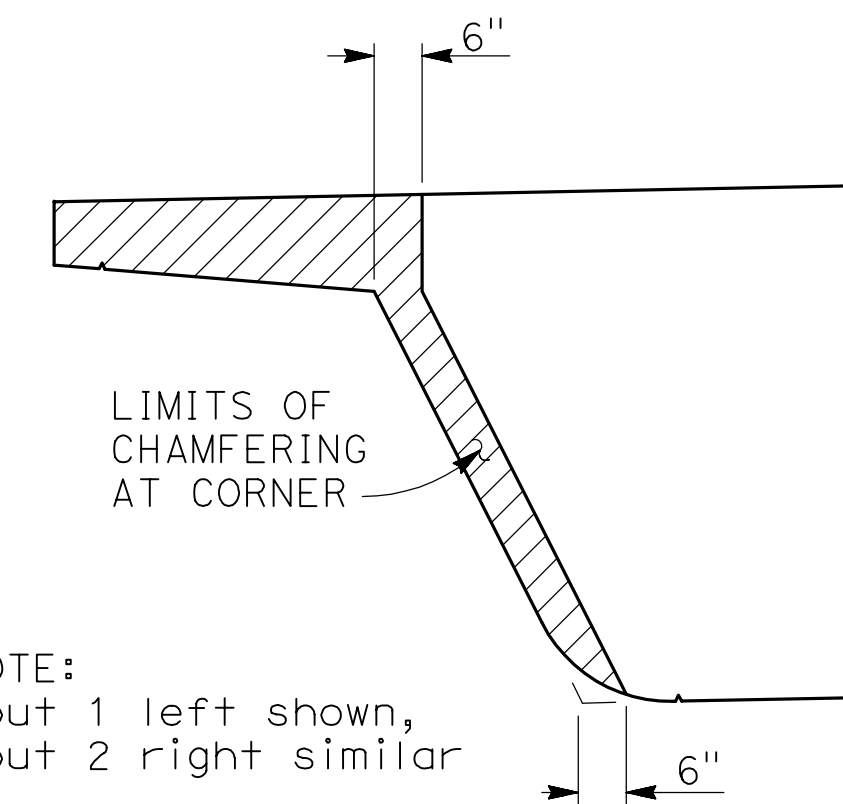


**SECTION A**  
1/2" = 1'-0" S11

NOTE:  
THE CONTRACTOR MUST VERIFY ALL CONTROLLING FIELD DIMENSIONS BEFORE ORDERING OR FABRICATING ANY MATERIAL

RECORD DRAWING		SCALE
DESIGNED: SGS	DATE: 1/25/21	AS SHOWN
DRAWN: SMH	DATE: 1/25/21	
CHECKED: ML	DATE: 1/25/21	

SCALE: AS SHOWN


**BIGGS CARDOSA ASSOCIATES INC**  
STRUCTURAL ENGINEERS  
5250 N. Palm Avenue, Suite 211  
Fresno, California 93704  
559-449-8686

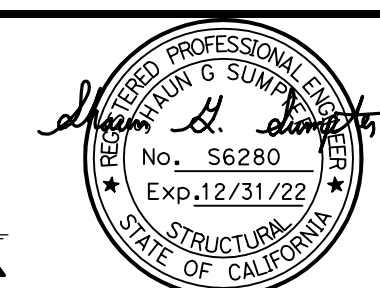

PROJECT: SAND CREEK BRIDGE REPLACEMENT ON ENNIS ROAD  
ROAD NO. 2824-2825 BRIDGE NO. 42C0697, BRLO-5942(238)




DEPARTMENT OF PUBLIC WORKS AND PLANNING  
GIRDER DETAILS  
DRAWING NO. 11257 SHEET NO. 28 TOTAL 31

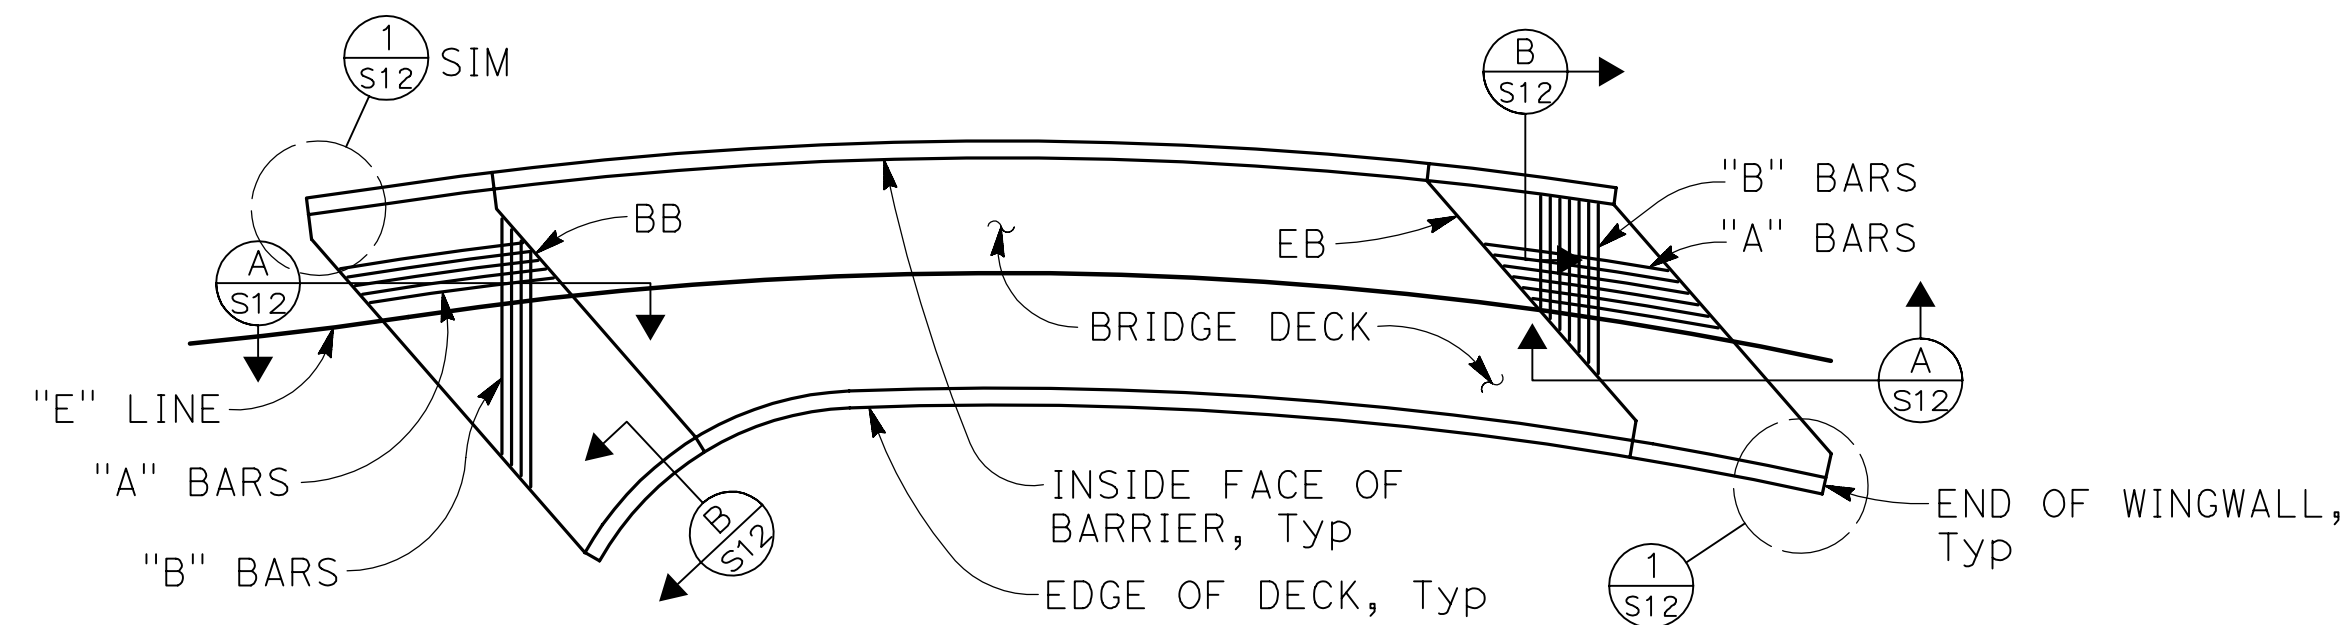

**PLAN**


1" = 20'

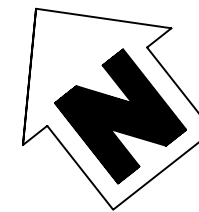

- NOTES:
1. Longitudinal construction joints, when permitted by the Engineer, shall be located on lane lines.
  2. For drainage details, see "DRAINAGE DETAILS" sheet.
  3. At the contractor's option, approach slab transverse reinforcement may be placed parallel to BB or EB. Spacing of transverse reinforcement is measured along  $\perp$  roadway.
  4. Provide cross slope to match deck surface grade. See "TYPICAL SECTION" and "DECK CONTOURS" sheets.
  5. Space "A" bars at 6" max at BB and 9" max at end of approach slab at the southwest approach slab quadrant.


LEGEND:

Remove all polystyrene after concrete is cured.

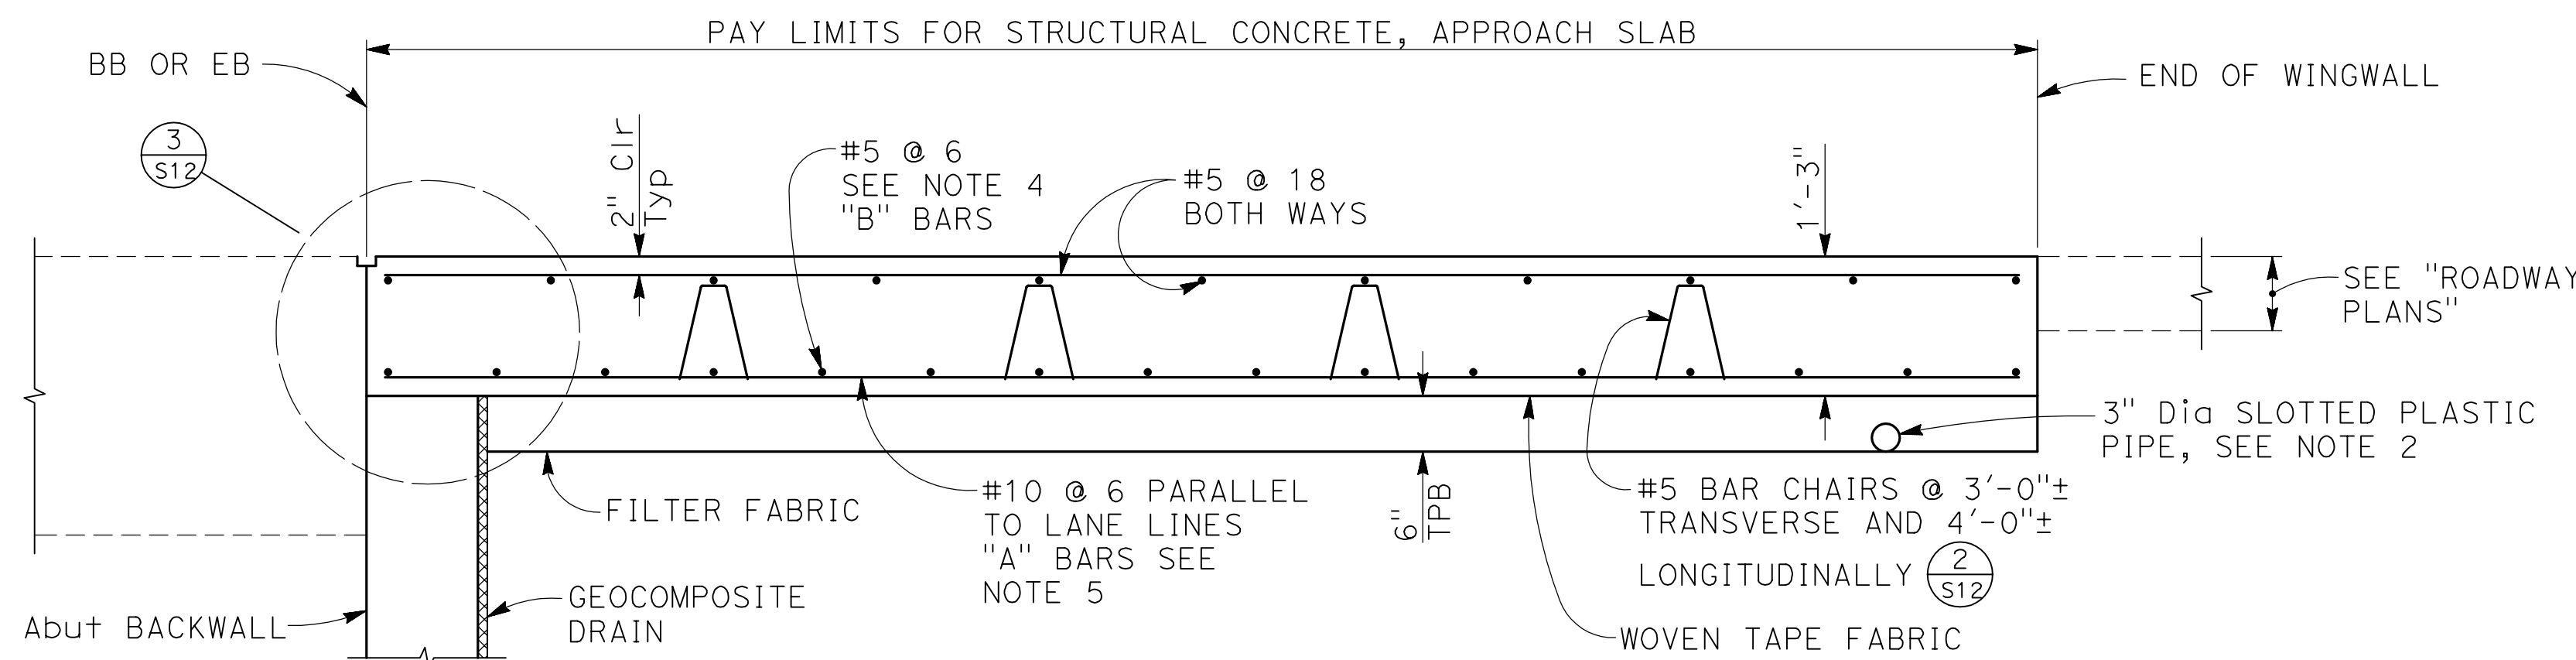


**SECTION A**

3/4" = 1'-0"

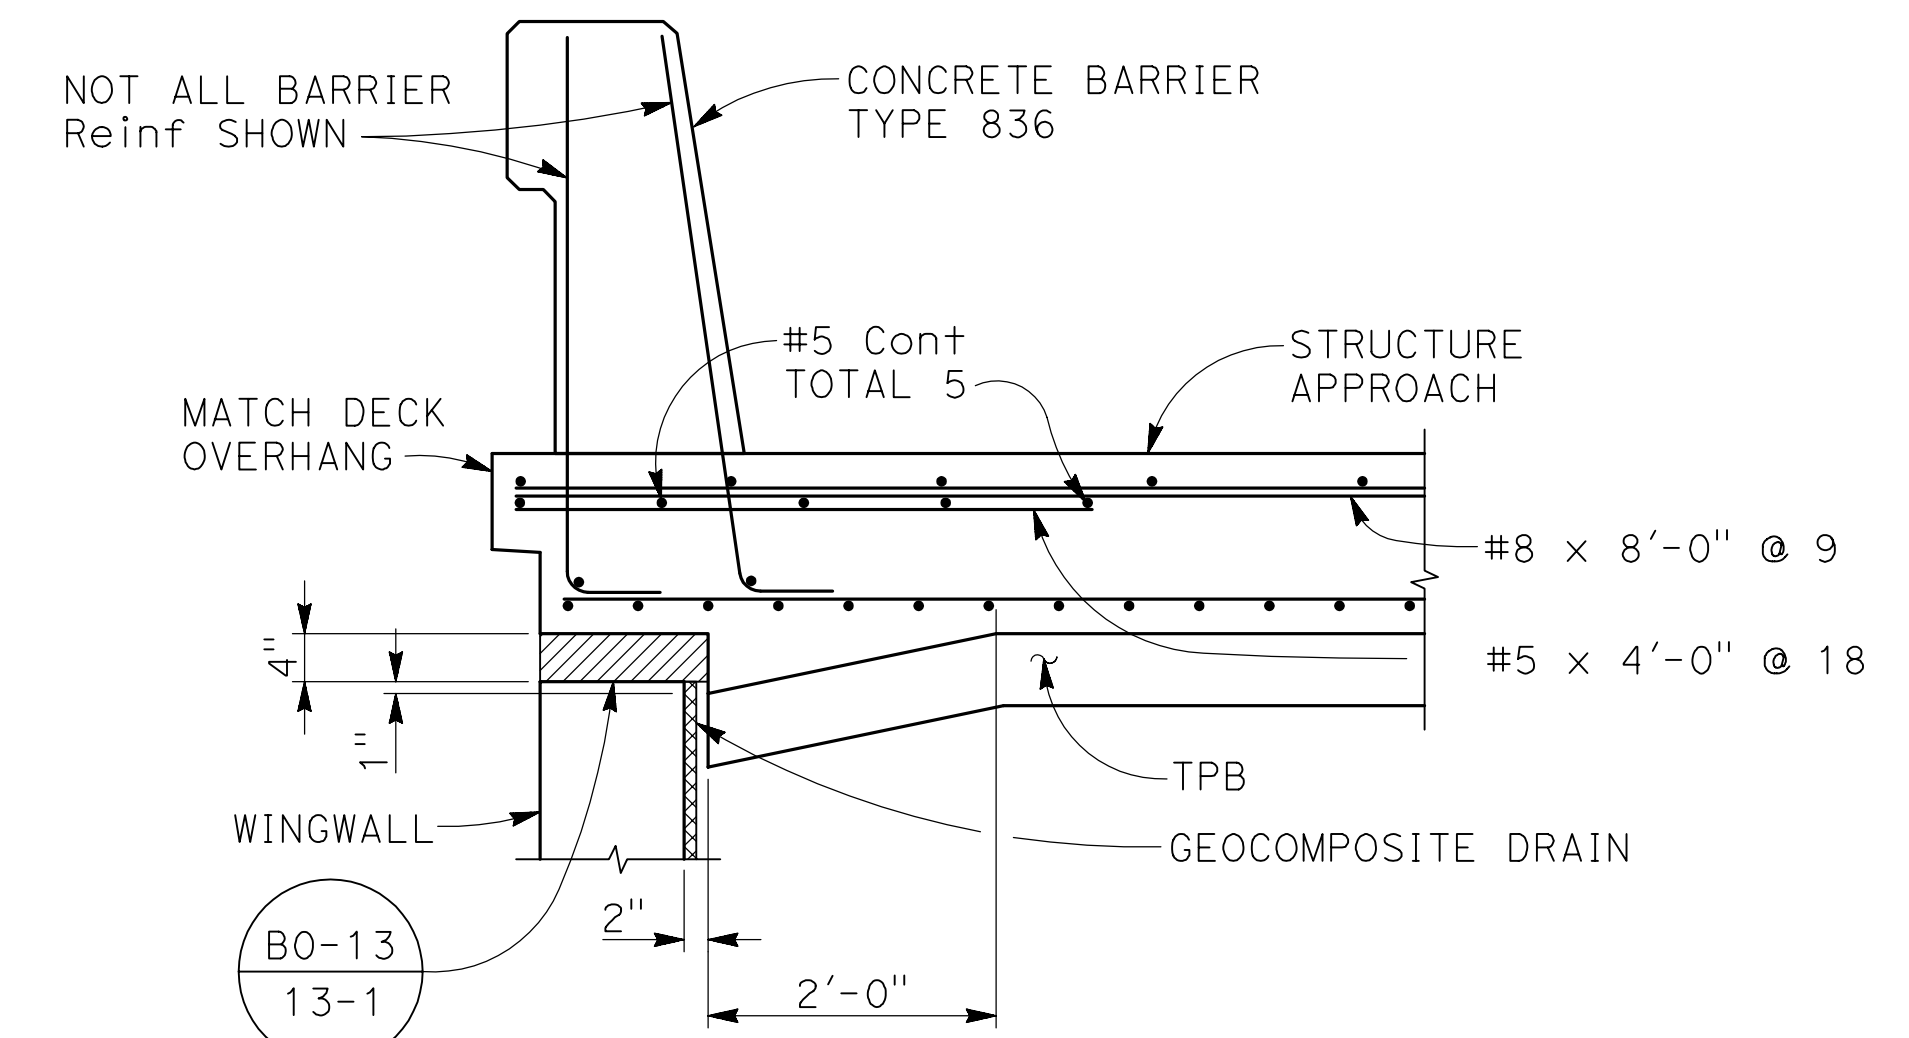



**SECTION B**

3/4" = 1'-0"

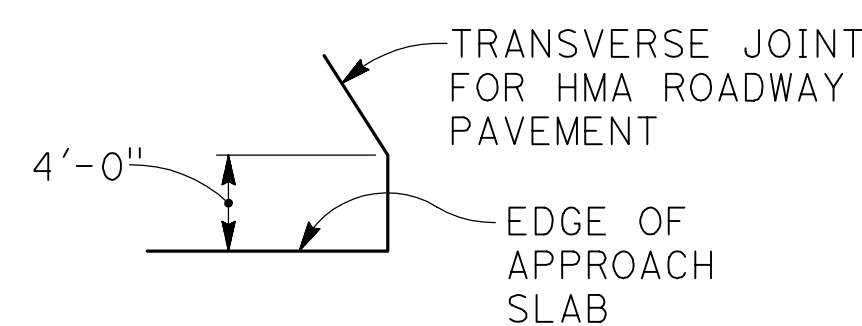



**DETAIL 1**

NO SCLAE

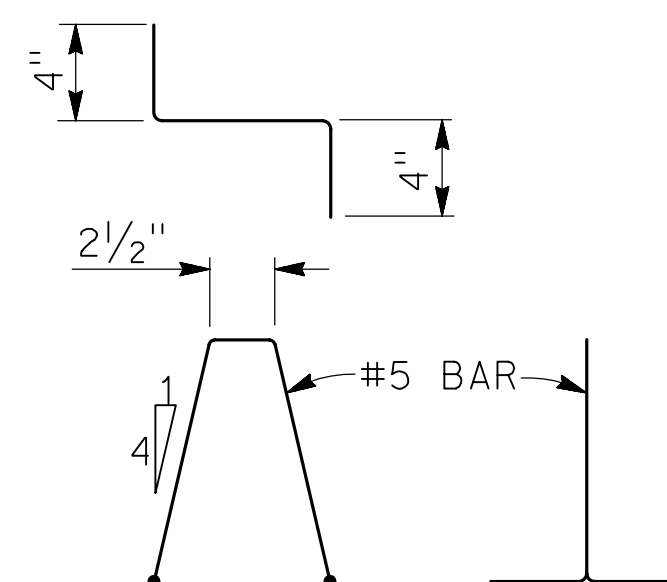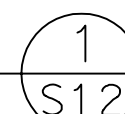


**BAR CHAIR DETAIL 2**

1 1/2" = 1'-0"

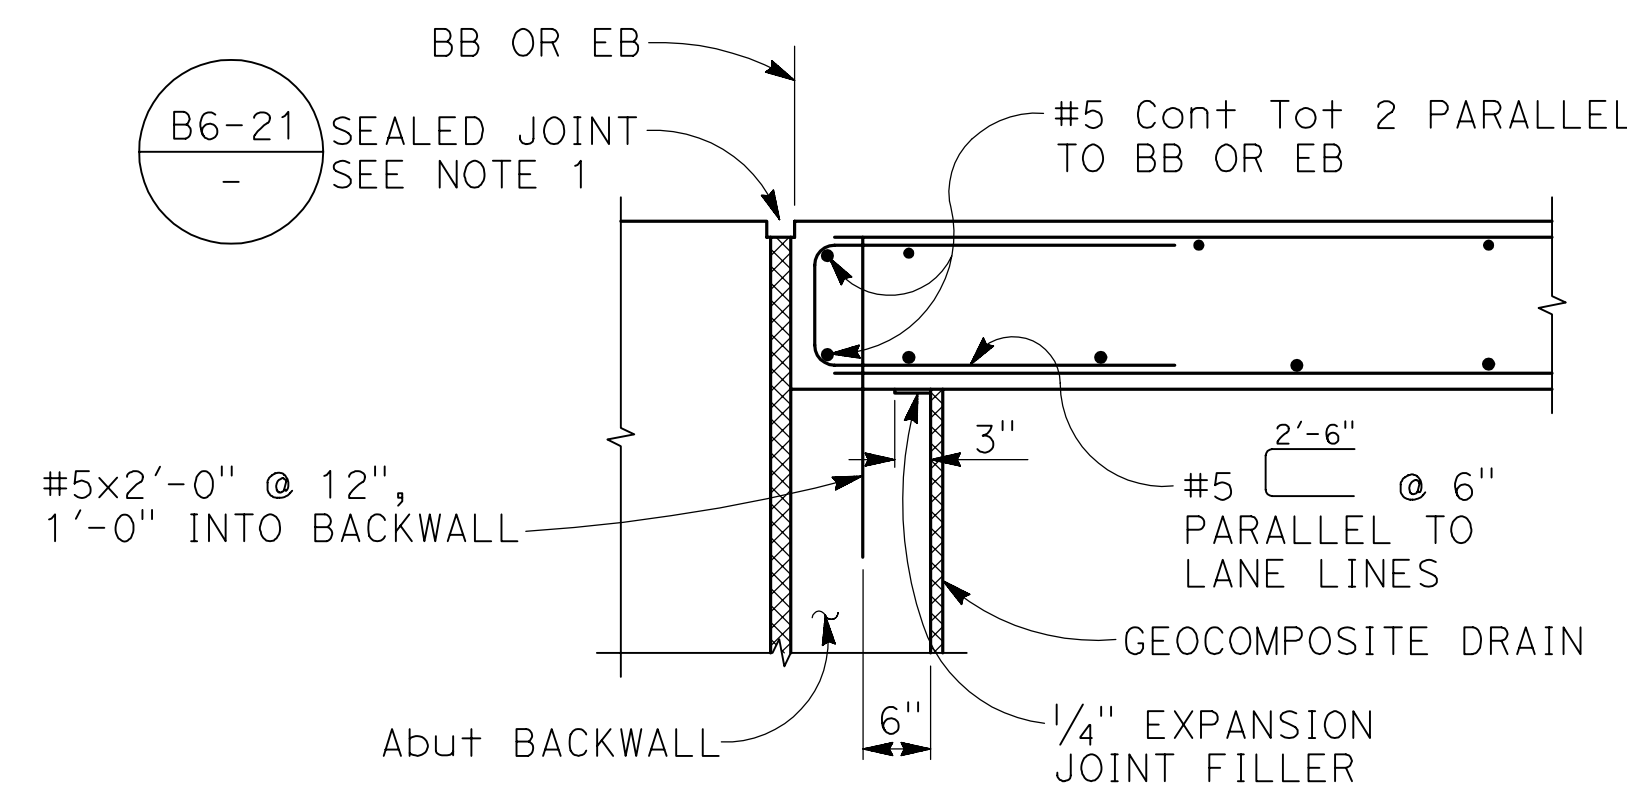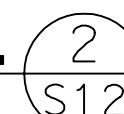


**SEAT TYPE ABUTMENT TIE DETAILS 3**

3/4" = 1'-0"

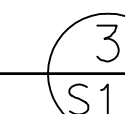


NOTE:  
THE CONTRACTOR MUST VERIFY ALL CONTROLLING FIELD DIMENSIONS BEFORE ORDERING OR FABRICATING ANY MATERIAL


RECORD DRAWING		SCALE	<b>BIGGS CARDOSA ASSOCIATES INC</b> STRUCTURAL ENGINEERS 5250 N. Palm Avenue, Suite 211 Fresno, California 93704 559-449-8686	PROJECT			DEPARTMENT OF PUBLIC WORKS AND PLANNING		
DESIGNED: SGS	DATE: 1/25/21	AS SHOWN		SAND CREEK BRIDGE REPLACEMENT ON ENNIS ROAD	ROAD NO. 2824-2825		BRIDGE NO. 42C0697, BRLO-5942(238)	STRUCTURE APPROACH DETAILS	
DRAWN: AR	DATE: 1/25/21							DRAWING NO. 11257	SHEET NO. 29
CHECKED: ML	DATE: 1/25/21							TOTAL 31	

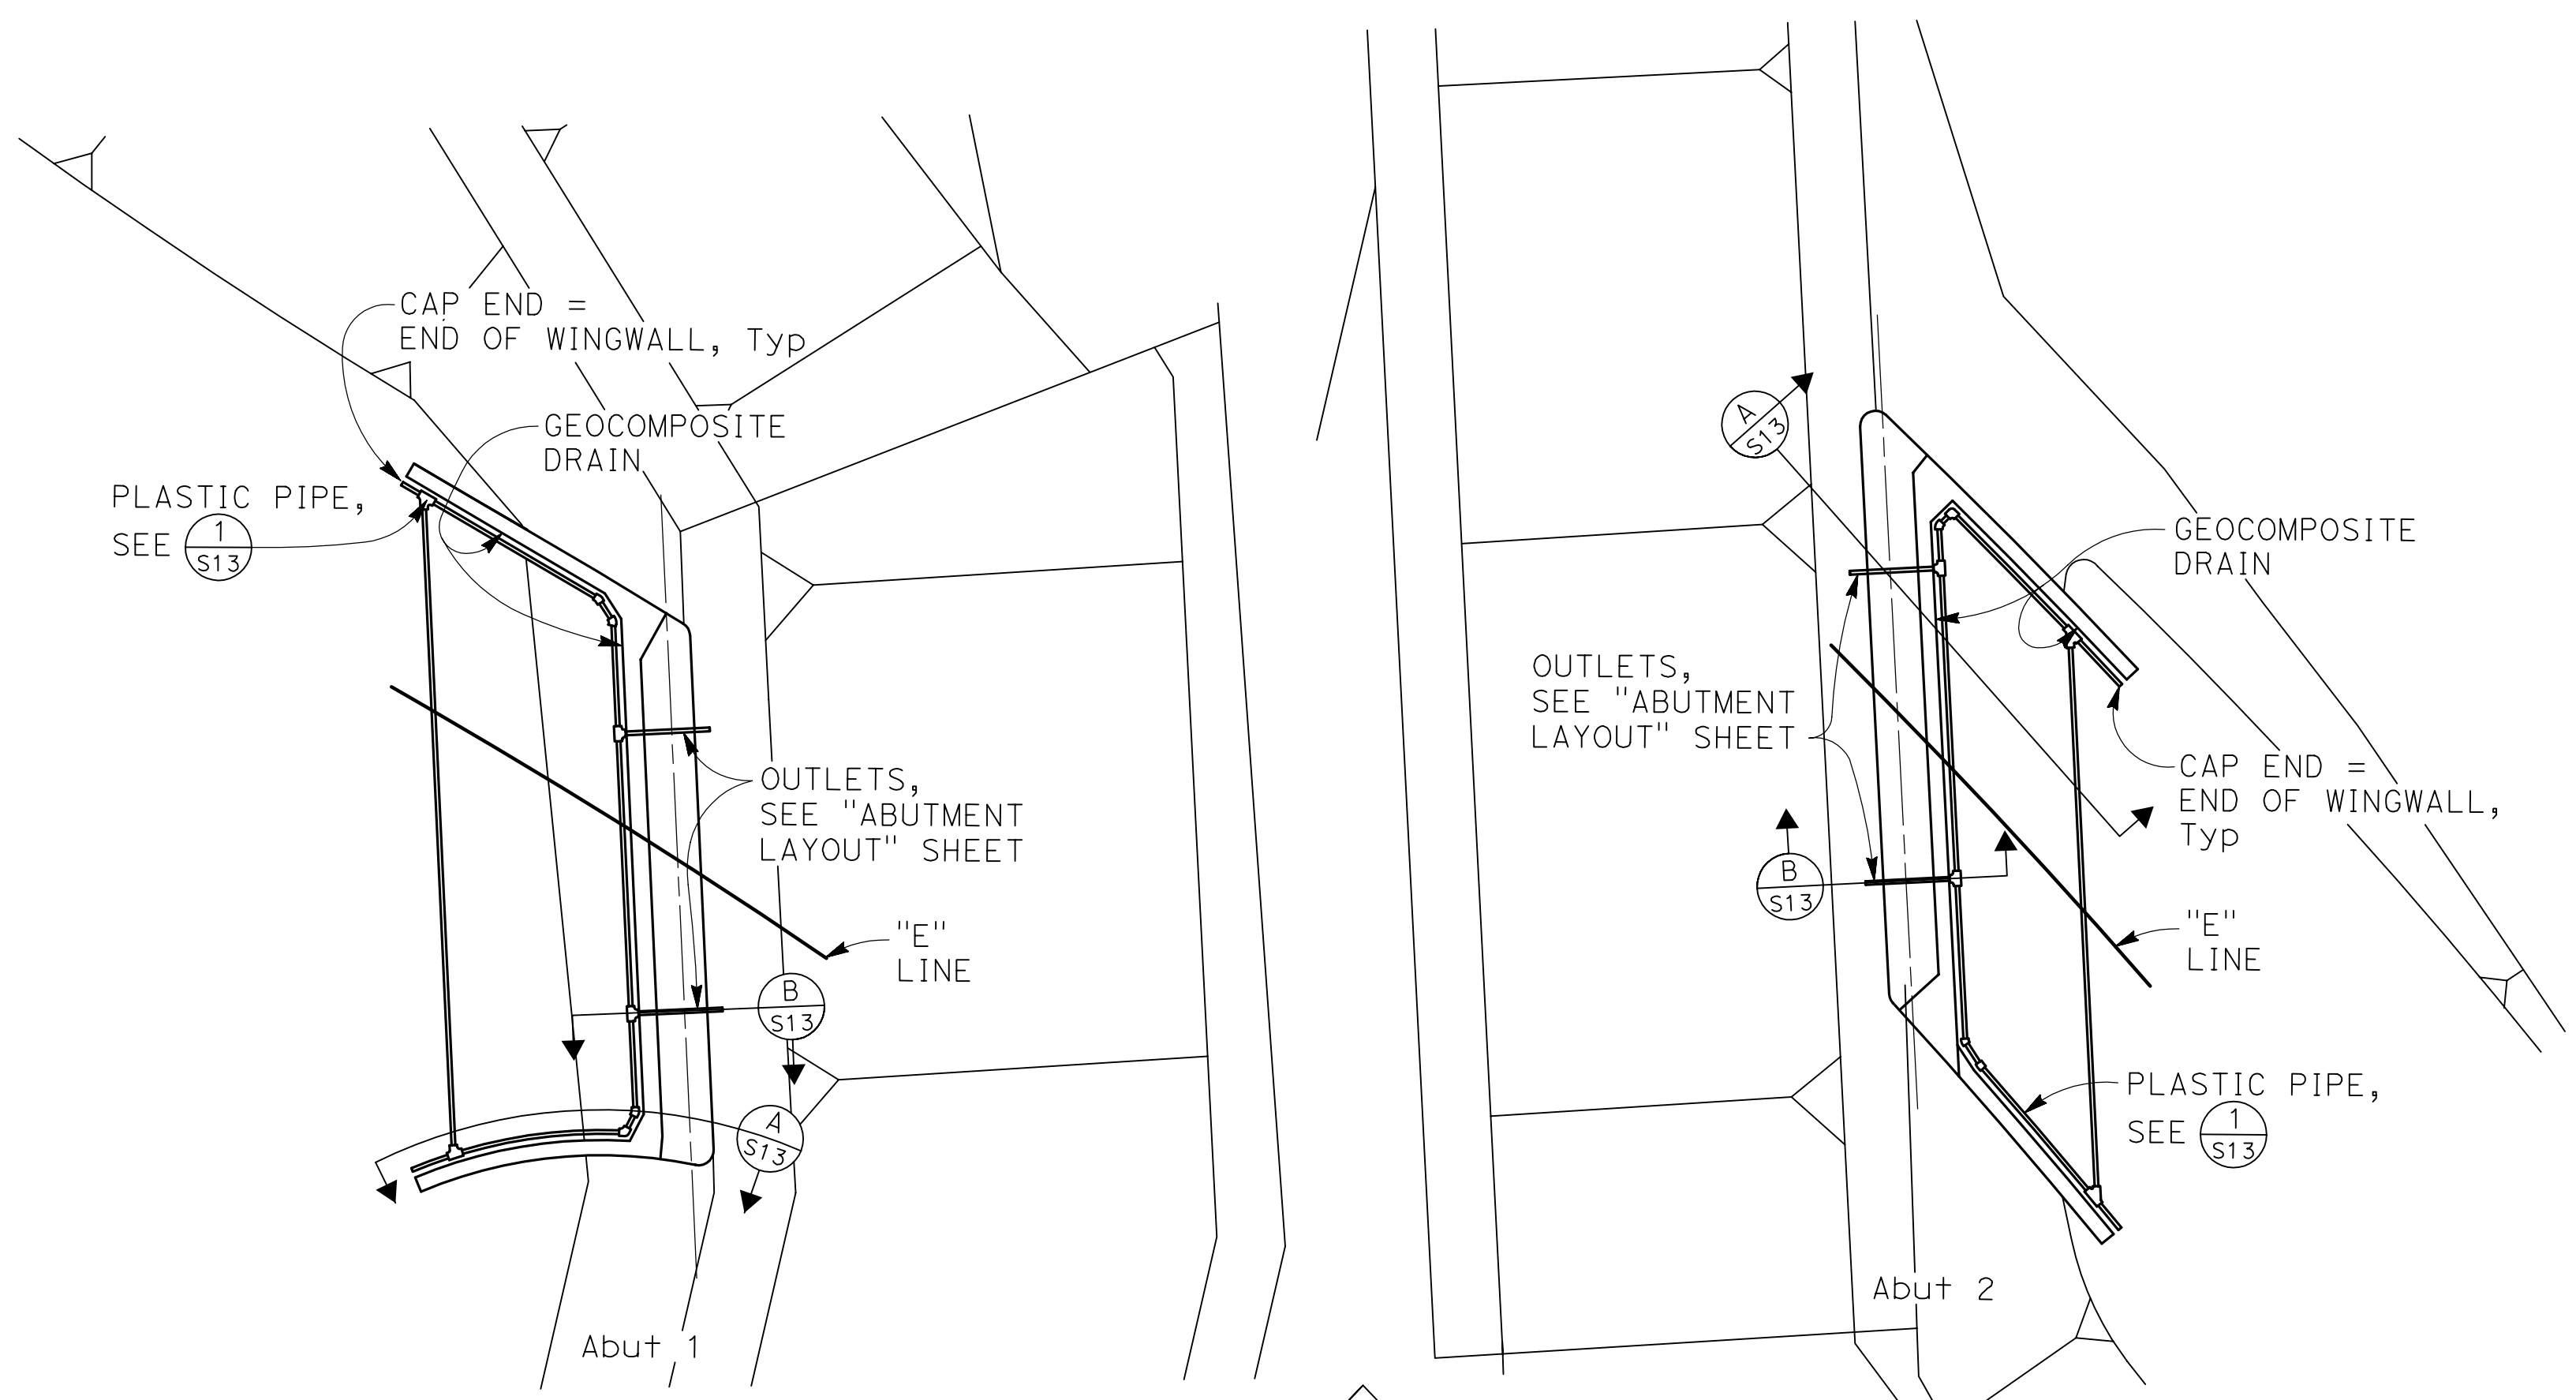

**PLAN**  
1" = 10'

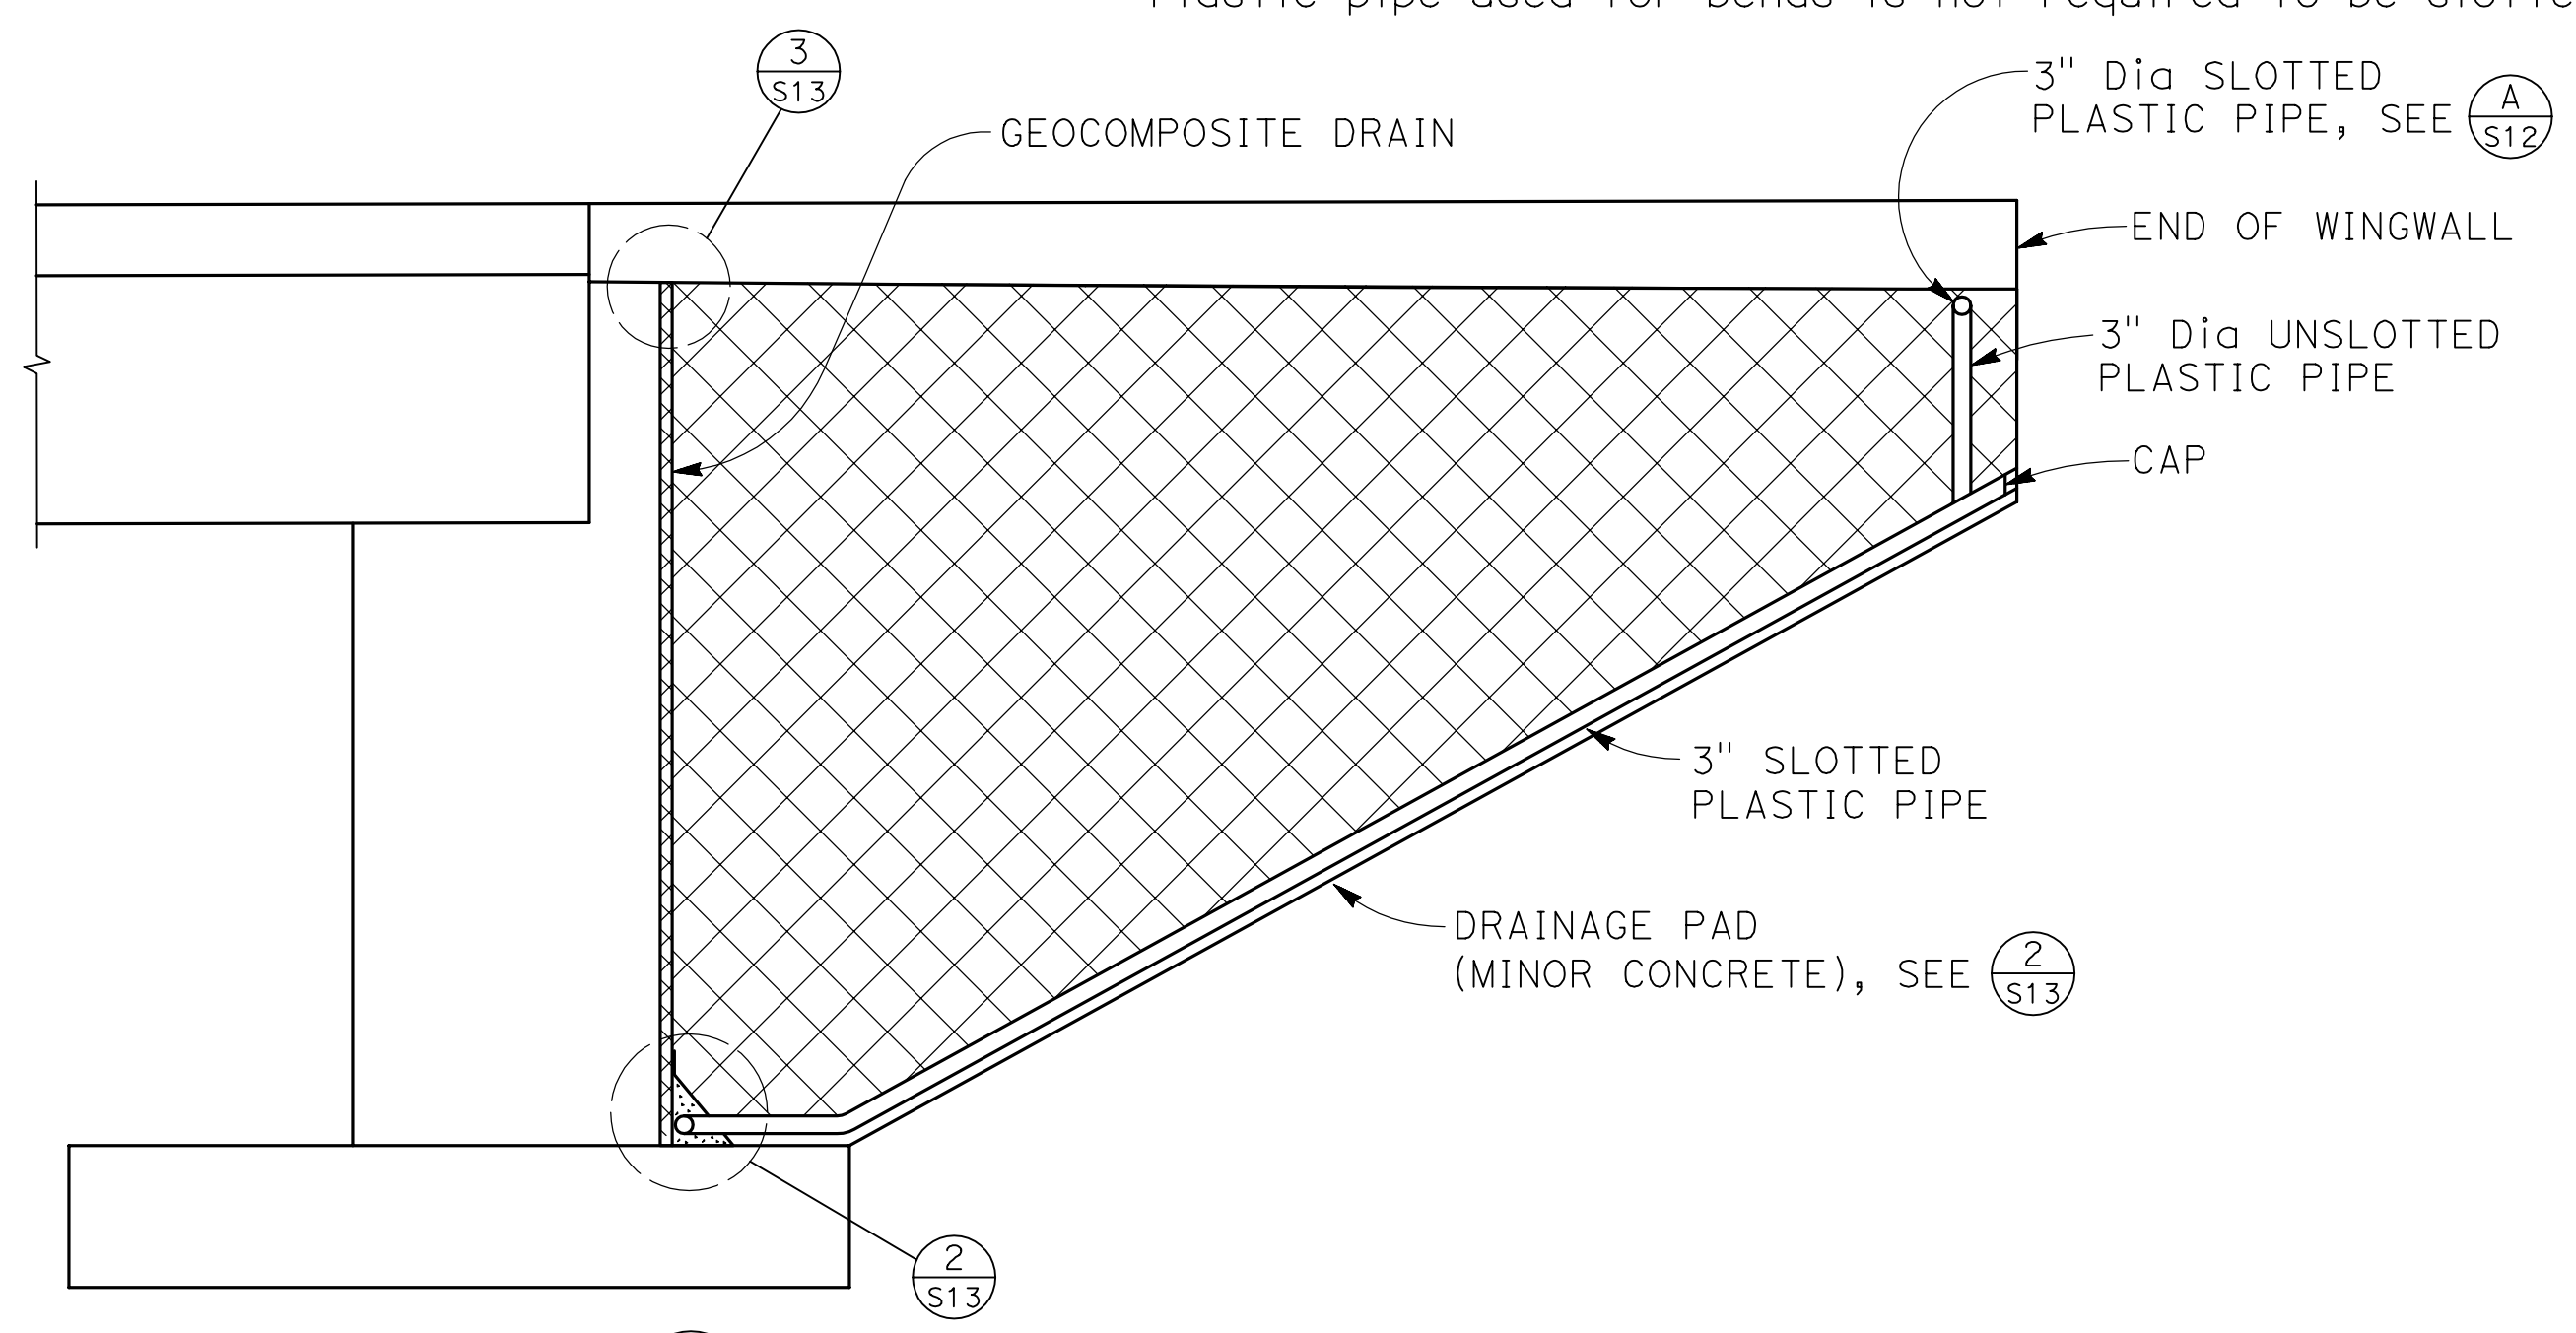


**SECTION A**  
3/8" = 1'-0"

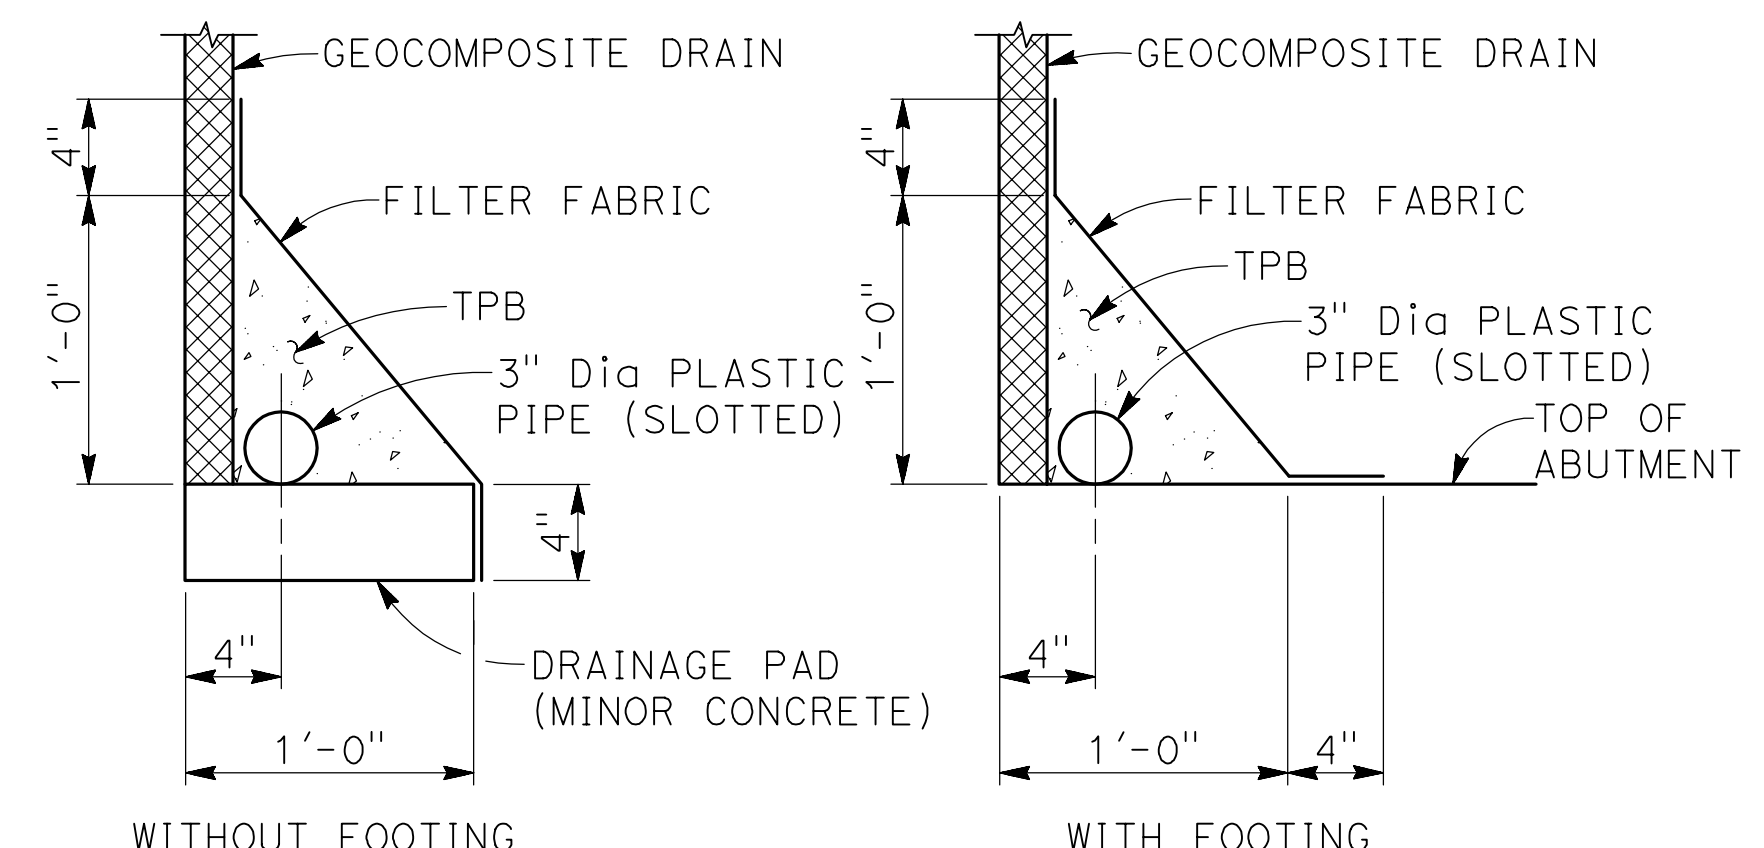


- NOTES:**
- 4" dia drains at locations shown on abutment elevations and at 25' max center to center along wingwall. Exposed wall drains shall be located 3"± above finished grade.
  - Geocomposite drain, cement treated permeable base, and 3" dia slotted plastic pipe continuous behind retaining wall or abutment. Cap ends of pipe. Provide "Tee" connection at each 4" dia drain.
  - Connect the low end of plastic pipe to the main outlet pipe as applicable.


**DETAIL 2**  
NO SCALE

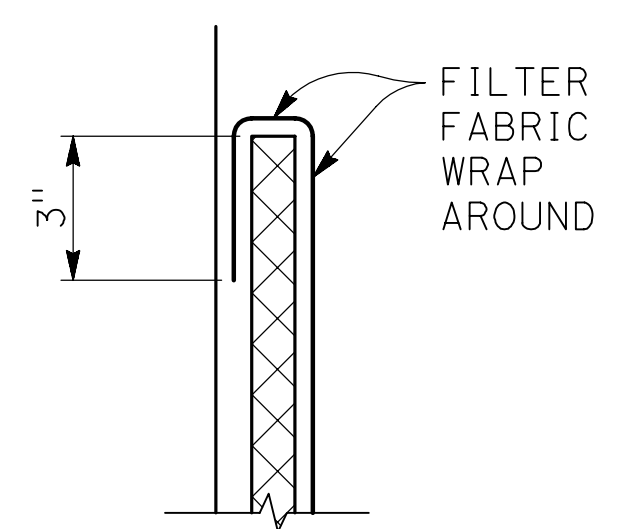

**DETAIL 3**  
1 1/2" = 1'-0"

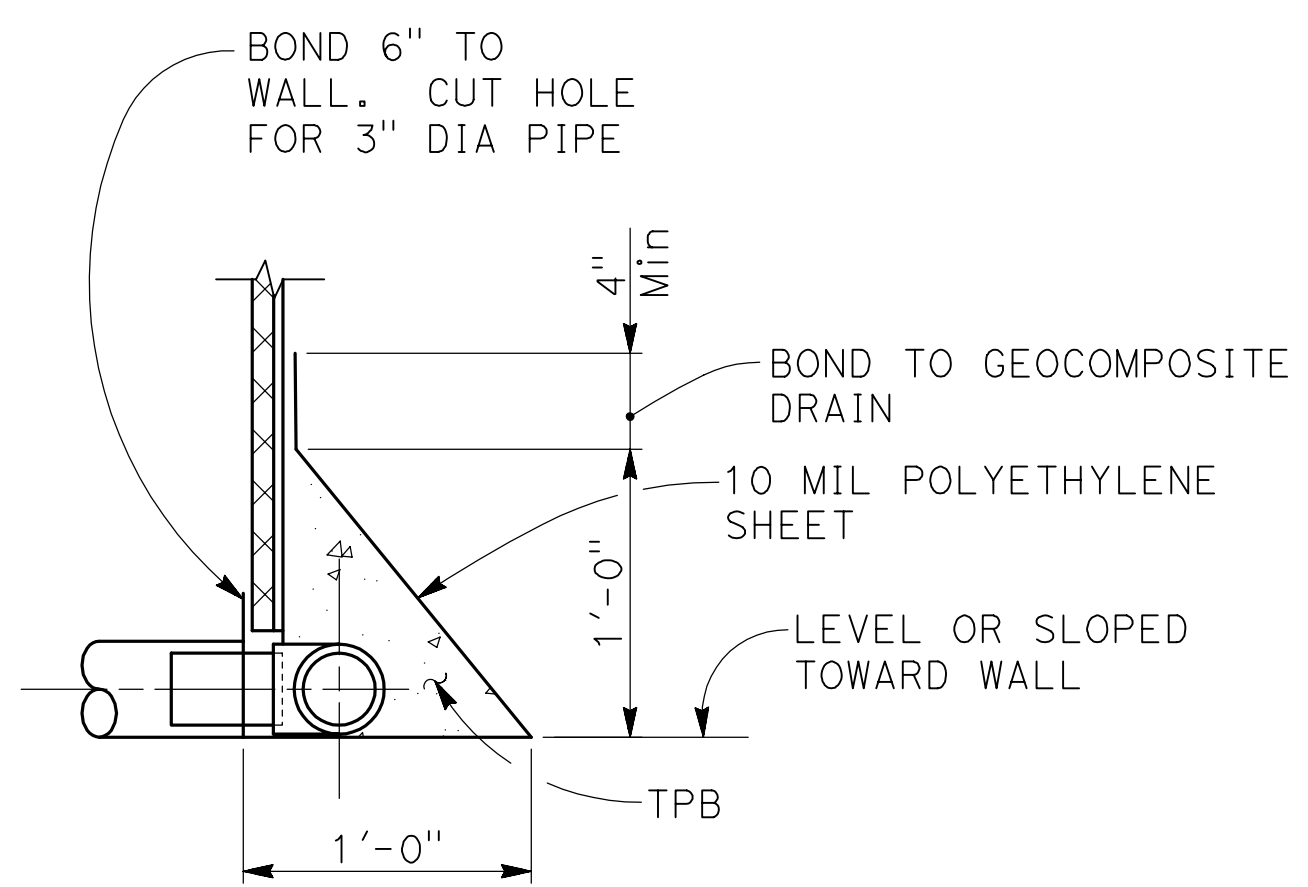

**SECTION B**  
1 1/2" = 1'-0"

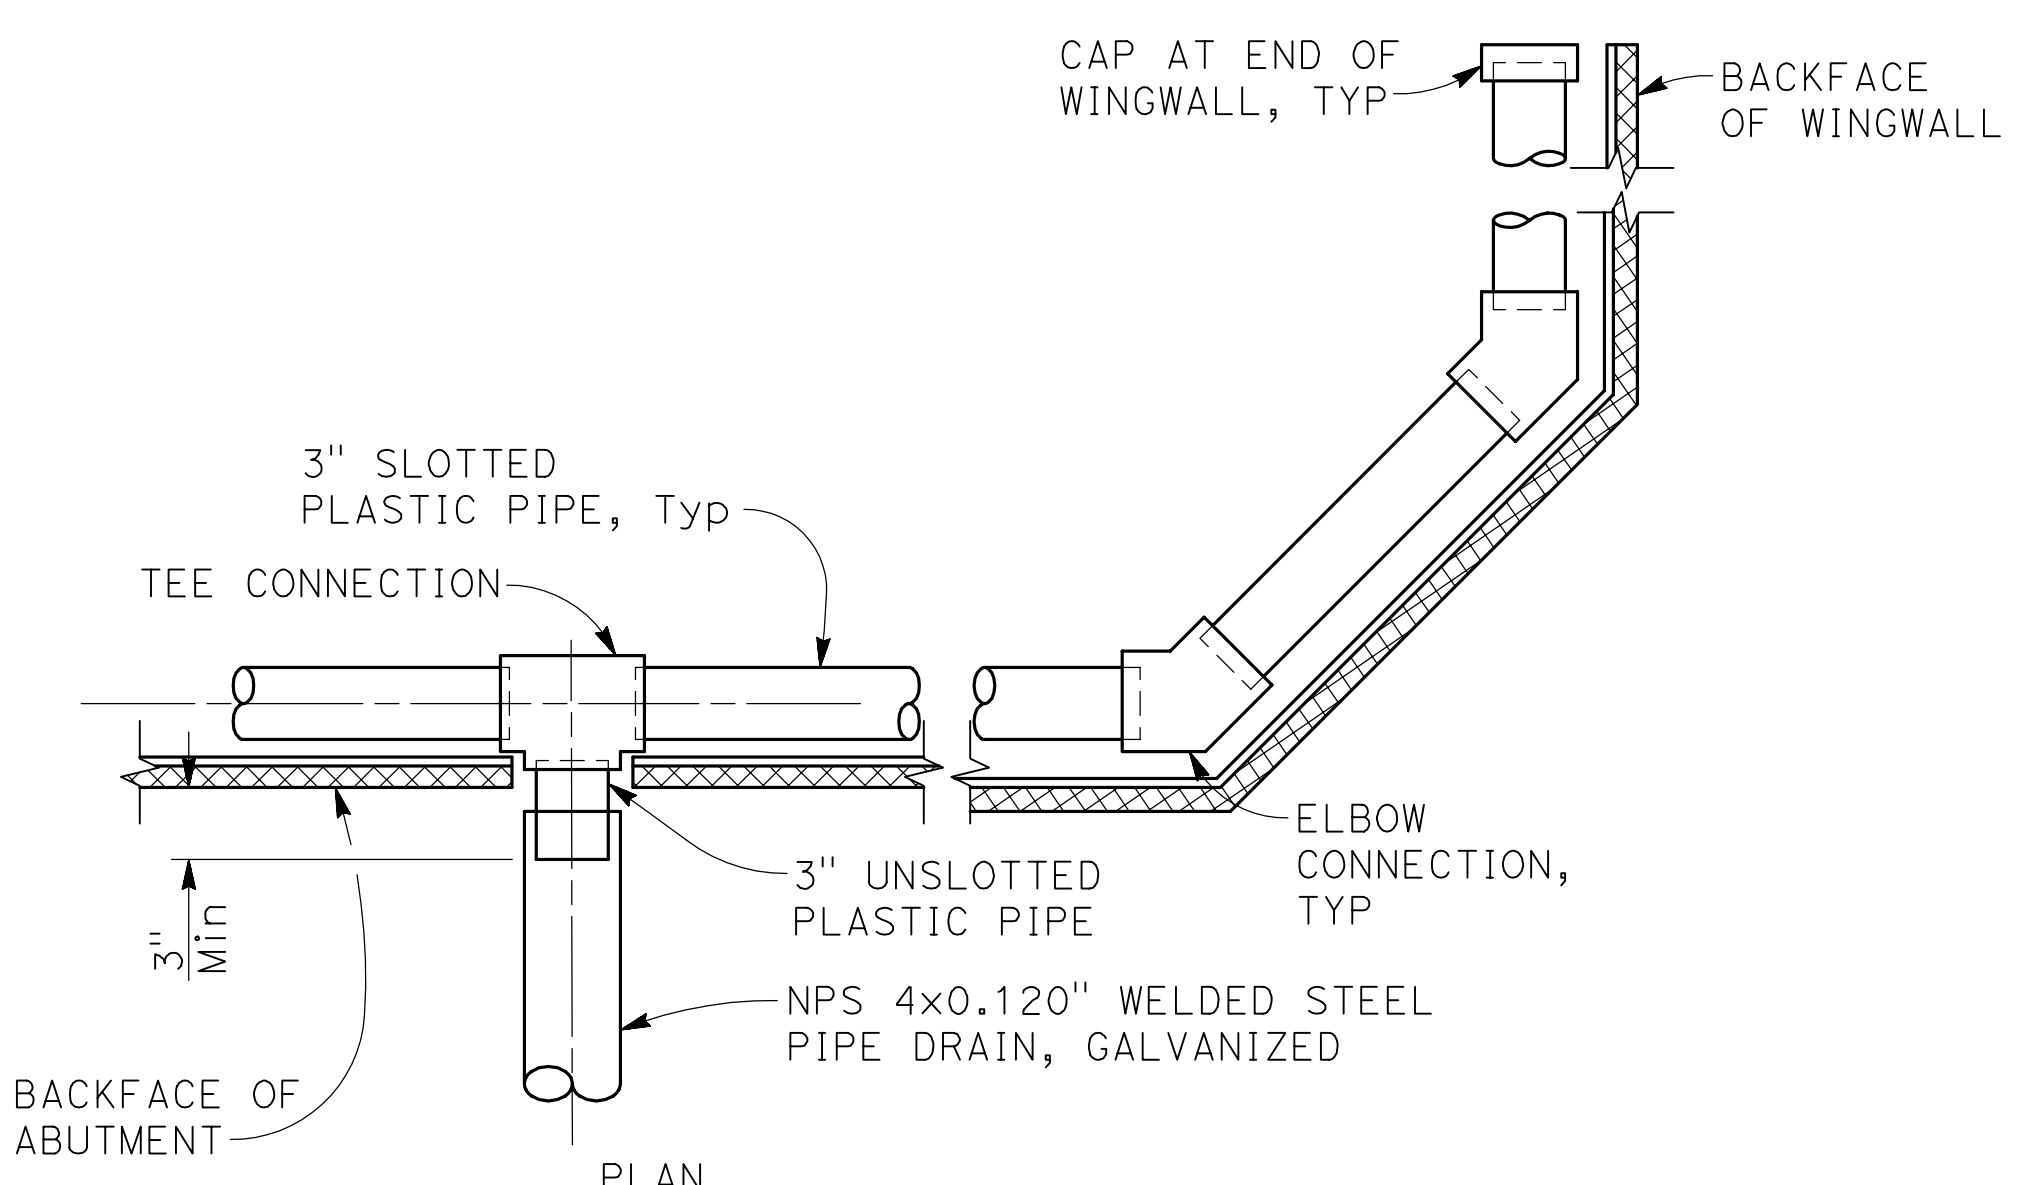

**DETAIL 1**  
1 1/2" = 1'-0"

**NOTE:**  
THE CONTRACTOR MUST VERIFY ALL CONTROLLING FIELD DIMENSIONS BEFORE ORDERING OR FABRICATING ANY MATERIAL

DESIGNED: SGS		DATE: 1/25/21	RECORD DRAWING		SCALE: AS SHOWN	<b>BIGGS CARDOSA ASSOCIATES INC</b> STRUCTURAL ENGINEERS 5250 N. Palm Avenue, Suite 211 Fresno, California 93704 559-449-8686		PROJECT: SAND CREEK BRIDGE REPLACEMENT ON ENNIS ROAD		
DRAWN: AR		DATE: 1/25/21	RESIDENT ENGINEER		DATE:			BRIDGE NO. 42C0697, BRLO-5942(238)		DEPARTMENT OF PUBLIC WORKS AND PLANNING
CHECKED: ML		DATE: 1/25/21						ROAD NO. 2824-2825		DRAINAGE DETAILS
FOR RIGHT OF WAY DATA AND ACCURATE ACCESS DETERMINATION, SEE DOCUMENTS IN THE DEPARTMENT OF PUBLIC WORKS AND PLANNING.										

Notes:  
 Standard Penetration Test Sampler: I.D. = 1.4"; O.D. = 2"  
 Modified California Sampler: I.D. = 2.5"; O.D. = 3"  
 Hammer Assembly: A 140 lb hammer with a 30" drop  
 (Automatic Hammer)

This LOTB sheet was prepared in accordance with the  
 Caltrans Soil & Rock, Logging, Classification, and  
 Presentation Manual (2010)

See Caltrans 2015 Standard Plans A10F, A10G and  
 A10H for Soil and Rock Legends.

All dimensions are in feet unless otherwise shown.

Base map is provided by Biggs Cardosa Associates  
 Inc 2016.

DIST	COUNTY	ROUTE	POST MILES TOTAL PROJECT	SHEET No	TOTAL SHEETS
6	Fresno	LOCAL			


10/28/16  
 GEOTECHNICAL PROFESSIONAL DATE

PLANS APPROVAL DATE


The County of Fresno or its officers  
 or agents shall not be responsible for the  
 accuracy or completeness of electronic copies  
 of this plan sheet.

PARIKH CONSULTANTS, INC.  
 2360 OUME DRIVE, SUITE A  
 SAN JOSE, CA 95131

REGISTERED PROFESSIONAL ENGINEER  
 GARY PARIKH  
 No. G.E. 666  
 Exp. 12/31/17  
 GEOTECHNICAL  
 STATE OF CALIFORNIA

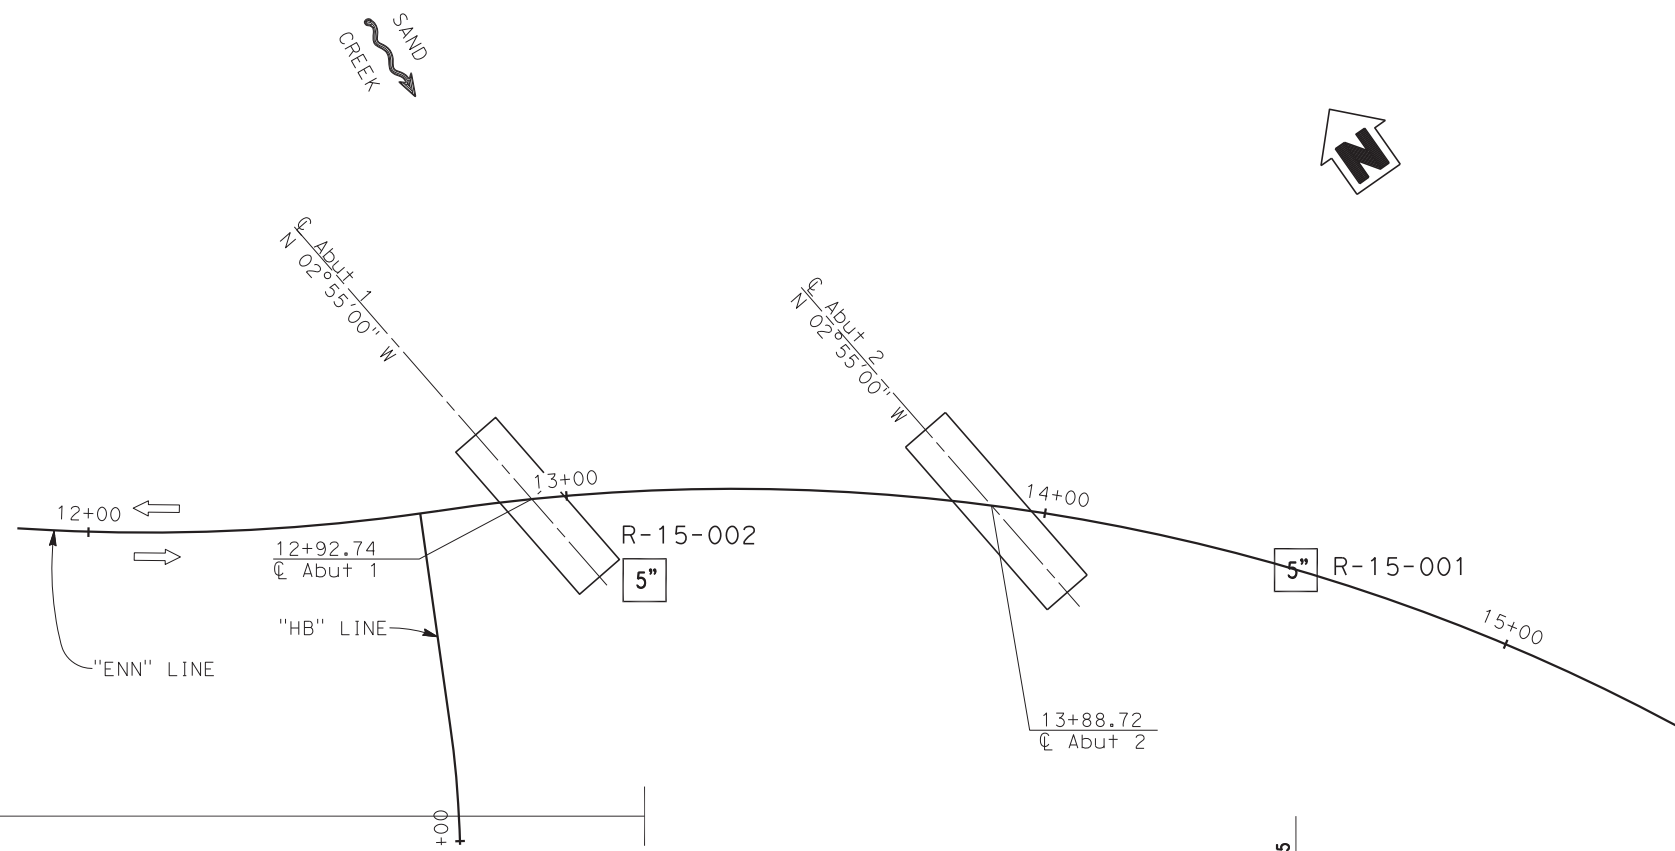

PLAN  
 1" = 20'

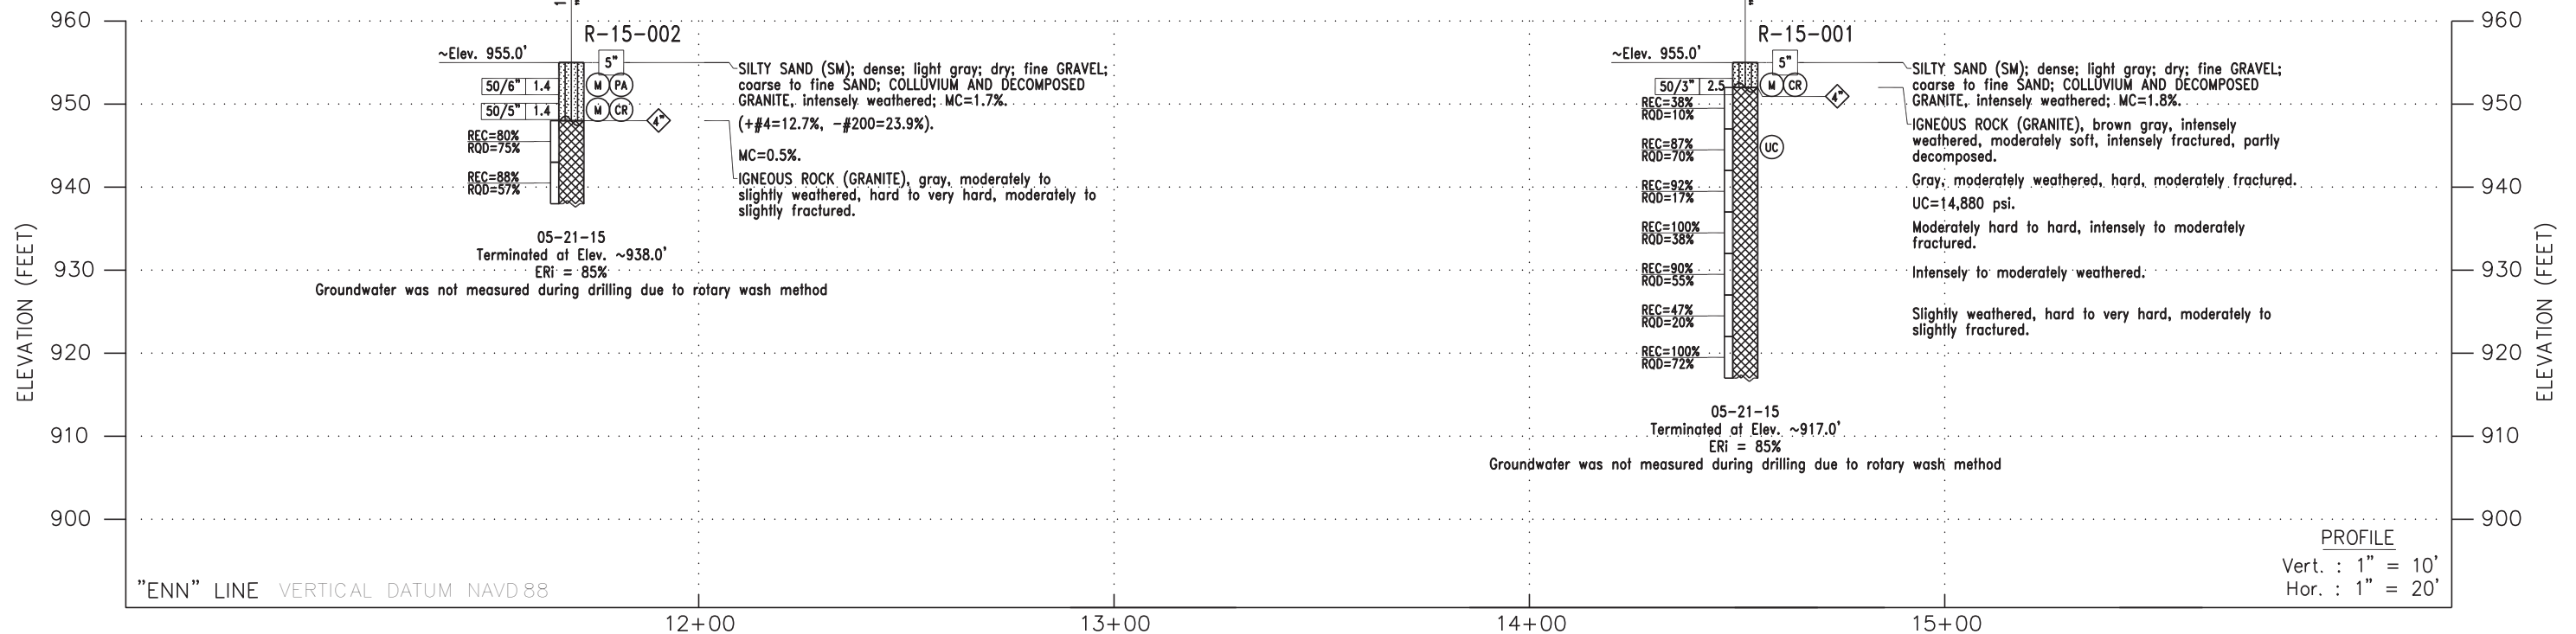

DRAWN BY	KIM OUYANG	V. SANTOS	PETER WEI
CHECKED BY	PETER WEI	FIELD INVESTIGATION BY:	PROJECT ENGINEER
		DATE: MAY 2015	

**BIGGS CARDOSA ASSOCIATES INC**  
 STRUCTURAL ENGINEERS

5250 N. Palm Avenue, Suite 211  
 Fresno, California 93704  
 559-449-8686



PROJECT  
 SAND CREEK BRIDGE REPLACEMENT  
 ON ENNIS ROAD

ROAD NO. BRIDGE NO. 42C-0099, BRLO-5942(238)



DEPARTMENT OF PUBLIC WORKS AND PLANNING

LOG OF TEST BORINGS

DRAWING NO. SHEET NO. 31 TOTAL 31