

AT-6
MAG IN AC
N: 2132779.434
E: 6499968.654
EL 1033.785



AT-5
NAIL (TO BE REMOVED)
N: 2132247.409
E: 6500468.927
EL 991.526

AT-4
MAG IN AC
N: 2132002.558
E: 6501095.716
EL 1007.692

AT-3
MAG IN AC
N: 2131256.648
E: 6500744.714
EL 991.985

AT-2
NAIL (TO BE REMOVED)
N: 2131540.680
E: 6500065.349
EL 965.188

AT-1
MAG IN AC
N: 2131902.818
E: 6499623.350
EL 991.513

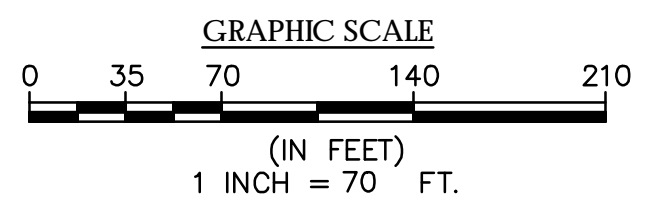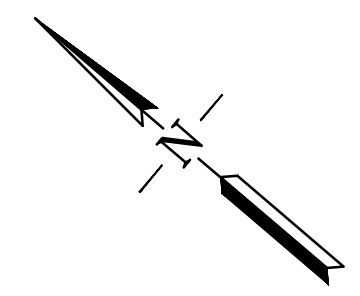









A-1

DESIGNED: SA		DATE	RECORD DRAWING		SCALE	PROJECT			DEPARTMENT OF PUBLIC WORKS AND PLANNING	
DRAWN: LS		3/12/2021	RESIDENT ENGINEER	DATE	AS SHOWN	SAND CREEK BRIDGE REPLACEMENT ON ENNIS ROAD			AERIAL SITE CONTROL PLAN	
CHECKED: SA		3/12/2021				ROAD NO. 2824-2825	BRIDGE NO. 42C0697, BRLO-5942(238)	DRAWING NO. 11257	SHEET NO. 3	TOTAL 31
FOR RIGHT OF WAY DATA AND ACCURATE ACCESS DETERMINATION, SEE DOCUMENTS IN THE DEPARTMENT OF PUBLIC WORKS AND PLANNING.										

THESE PLANS ARE FOR THE CONTRACTOR'S INFORMATION ONLY. THEY ARE NOT TO BE CONSIDERED TO BE PART OF THE CONTRACT DOCUMENTS AND SHALL HAVE NO BEARING WHATSOEVER ON THE INTERPRETATION OF THE STANDARD SPECIFICATIONS, THE STANDARD PLANS, THE SPECIAL PROVISIONS, NOR SHALL THEY HAVE ANY BEARING WHATSOEVER ON THE INTERPRETATION OF THE OTHER PUBLICATIONS REFERENCED THEREIN

\\BKF-OAK\VOL4\ENG14\20141070_FRESNO-SAND_CREEK_BRIDGE_ON_ENNIS_ROAD\ENG\SHEETS\A-1

\\BKF-OAK\VOL4\ENGL\20141070_FRESNO-SAND_CREEK_BRIDGE_ON_ENNIS_ROAD\ENGL\SHEETS\X-1

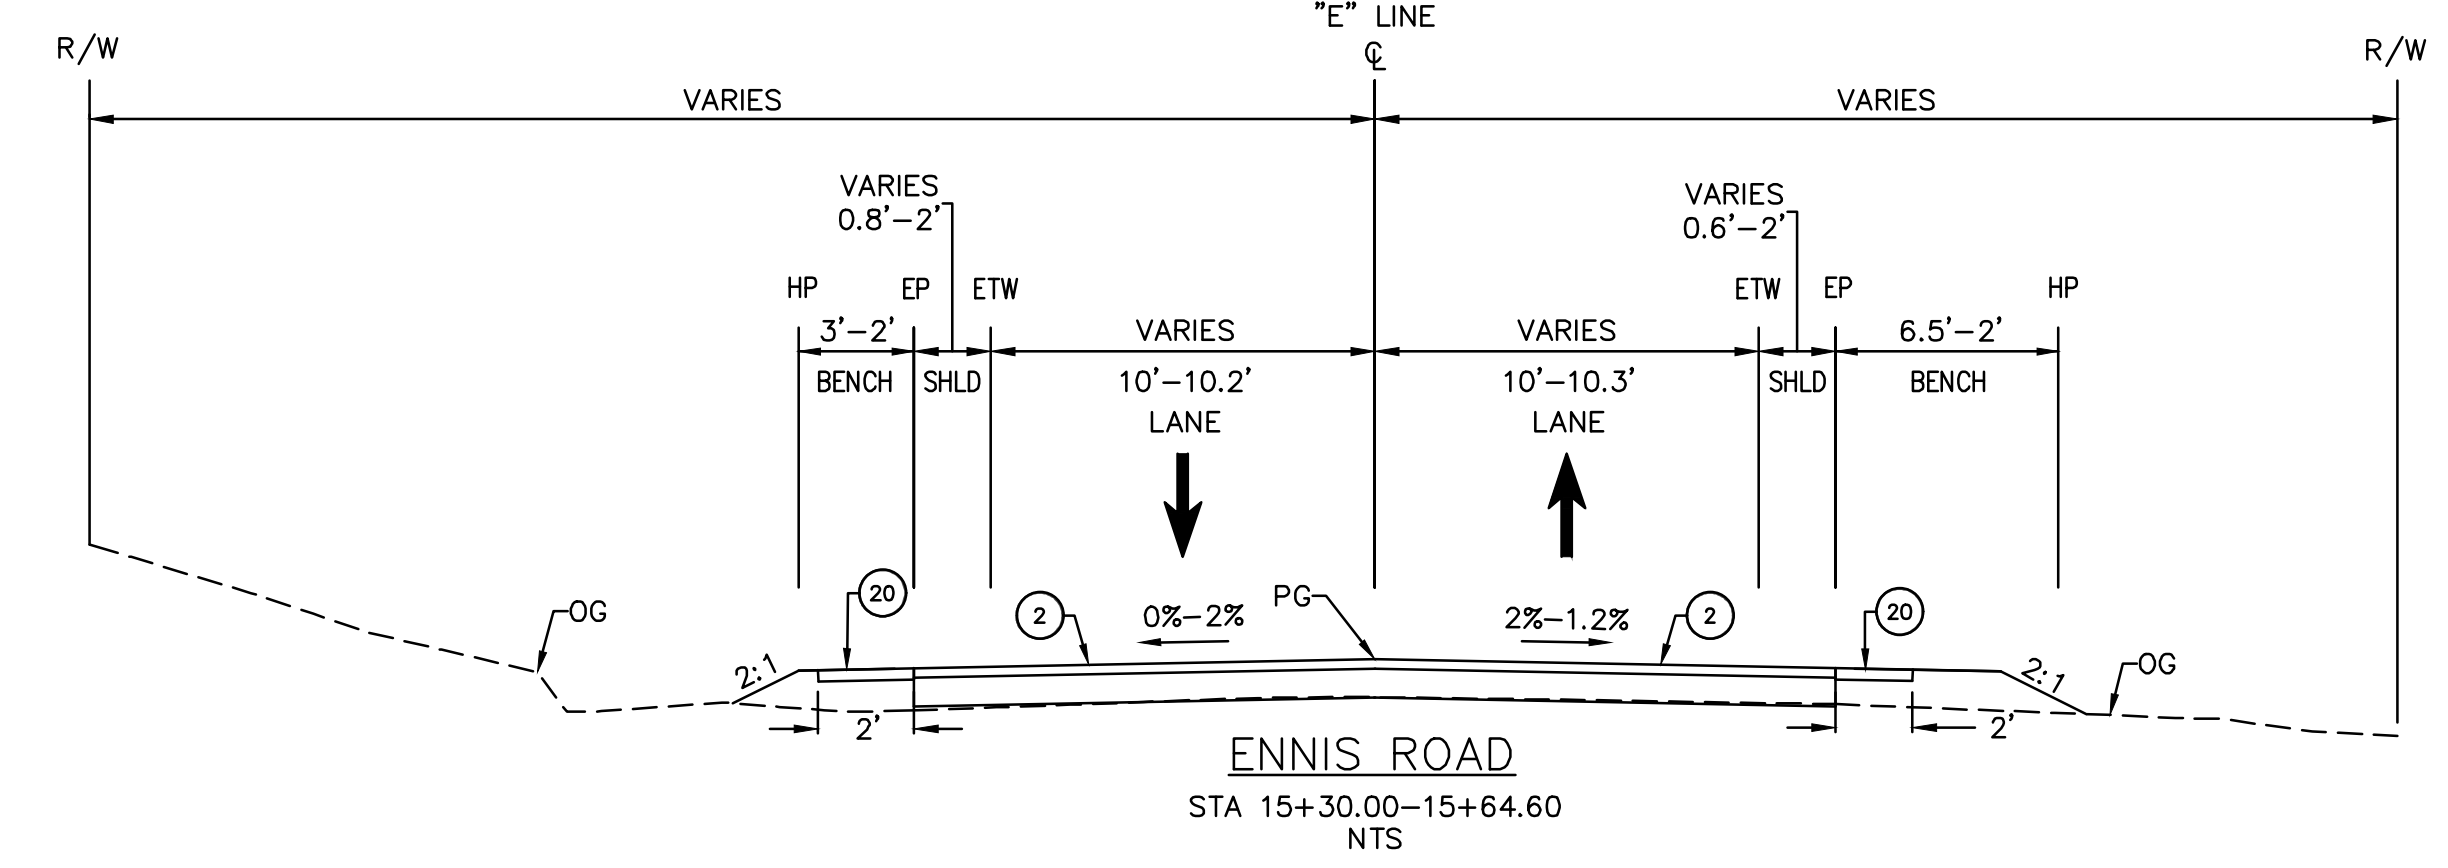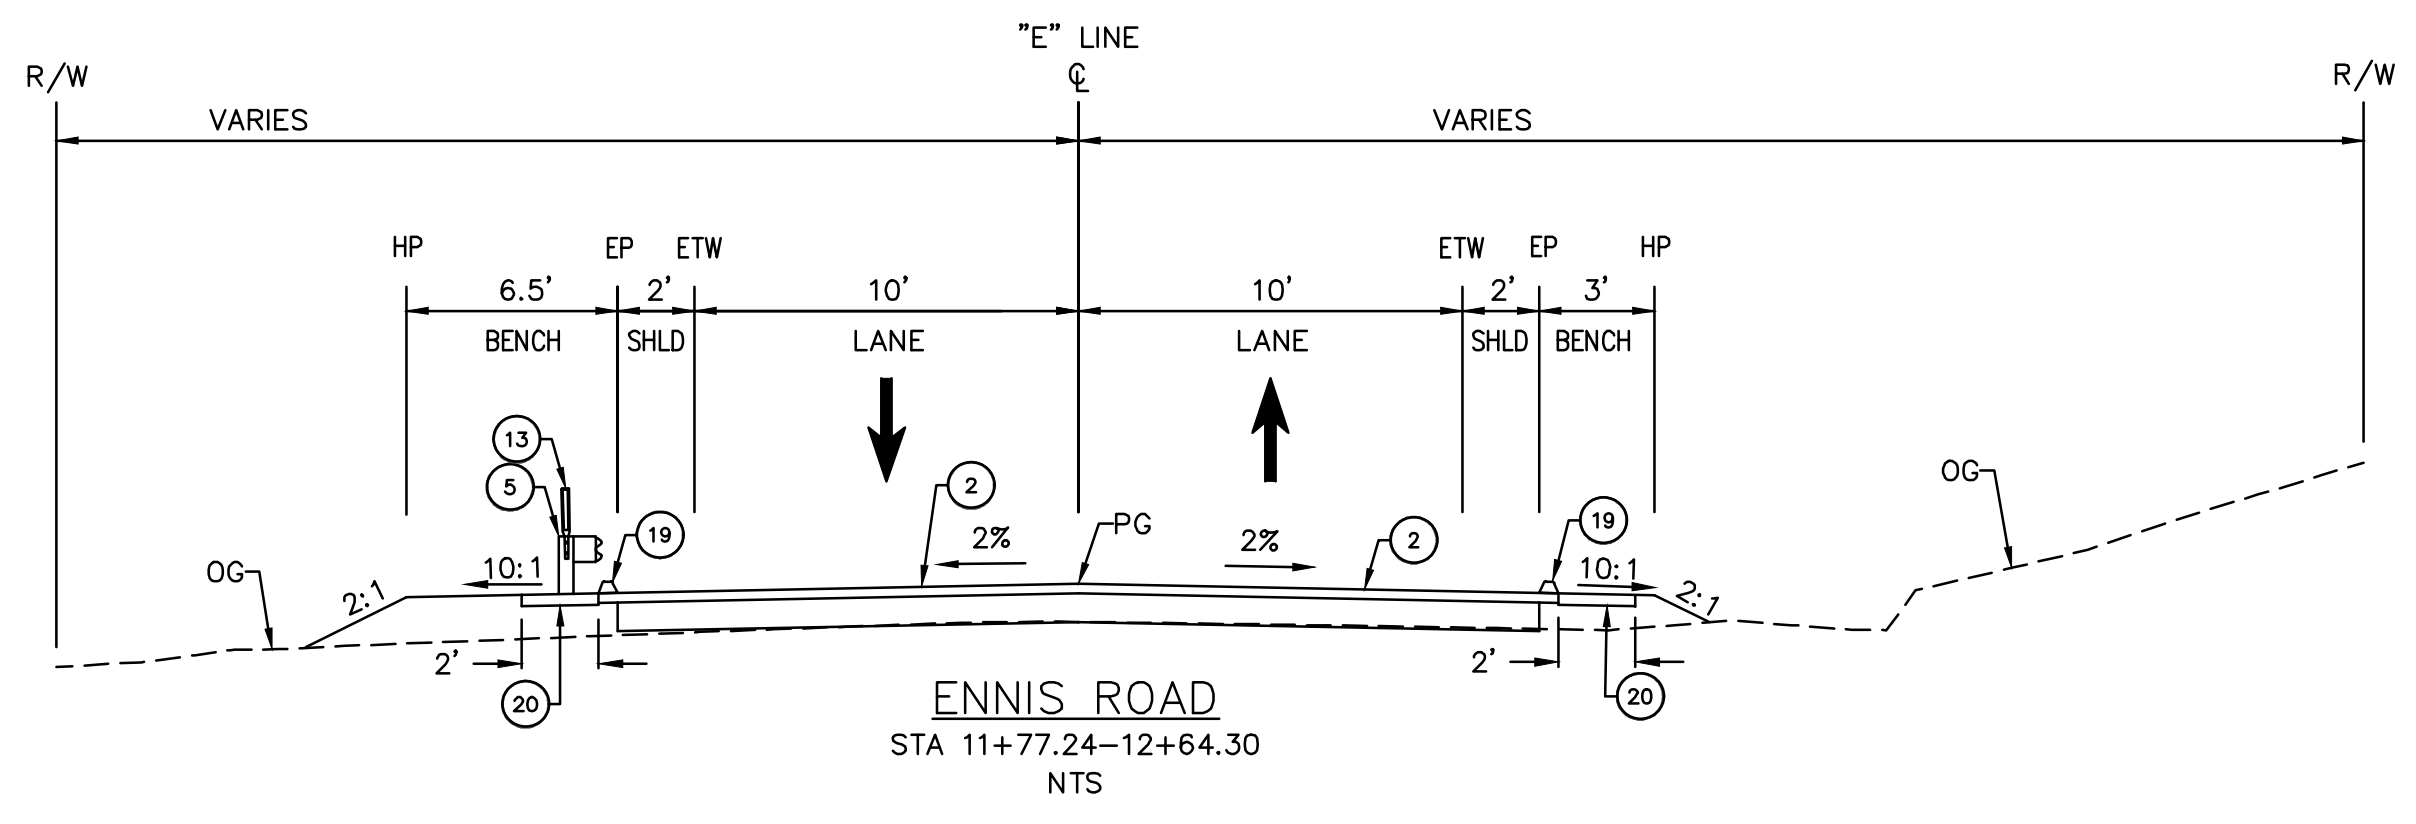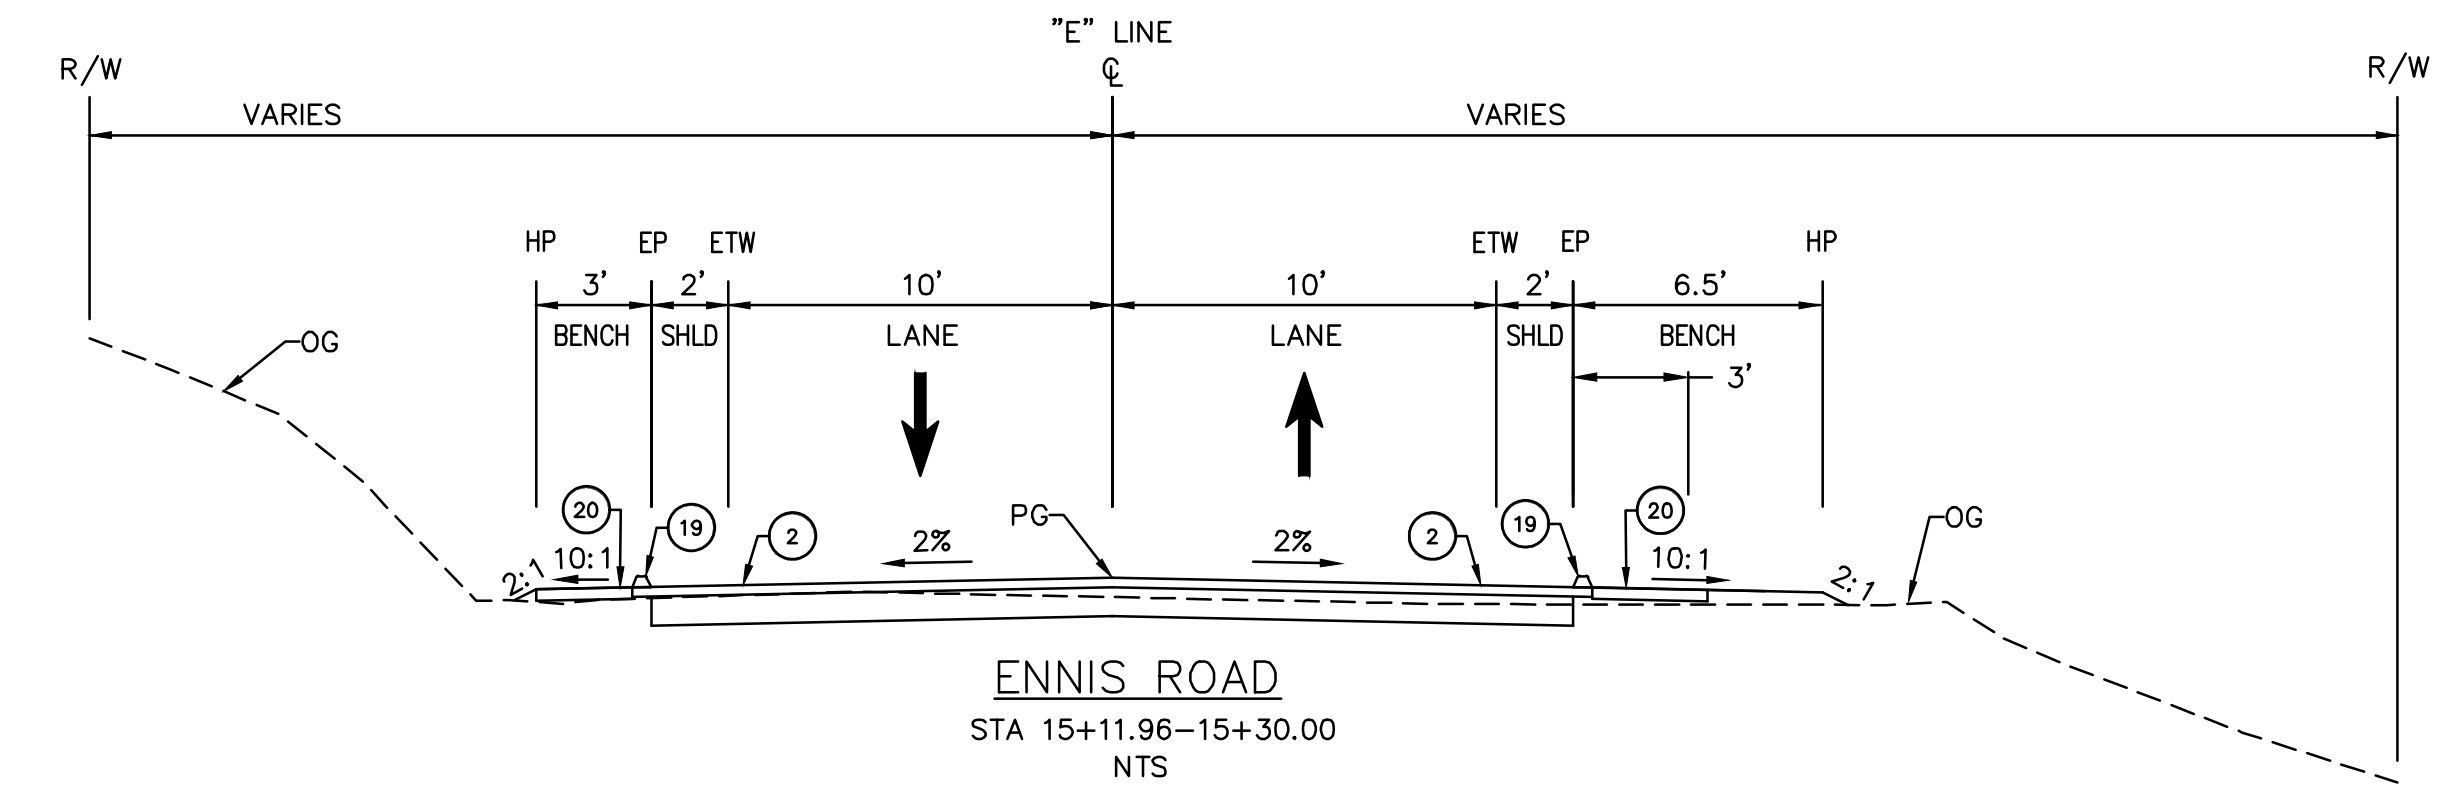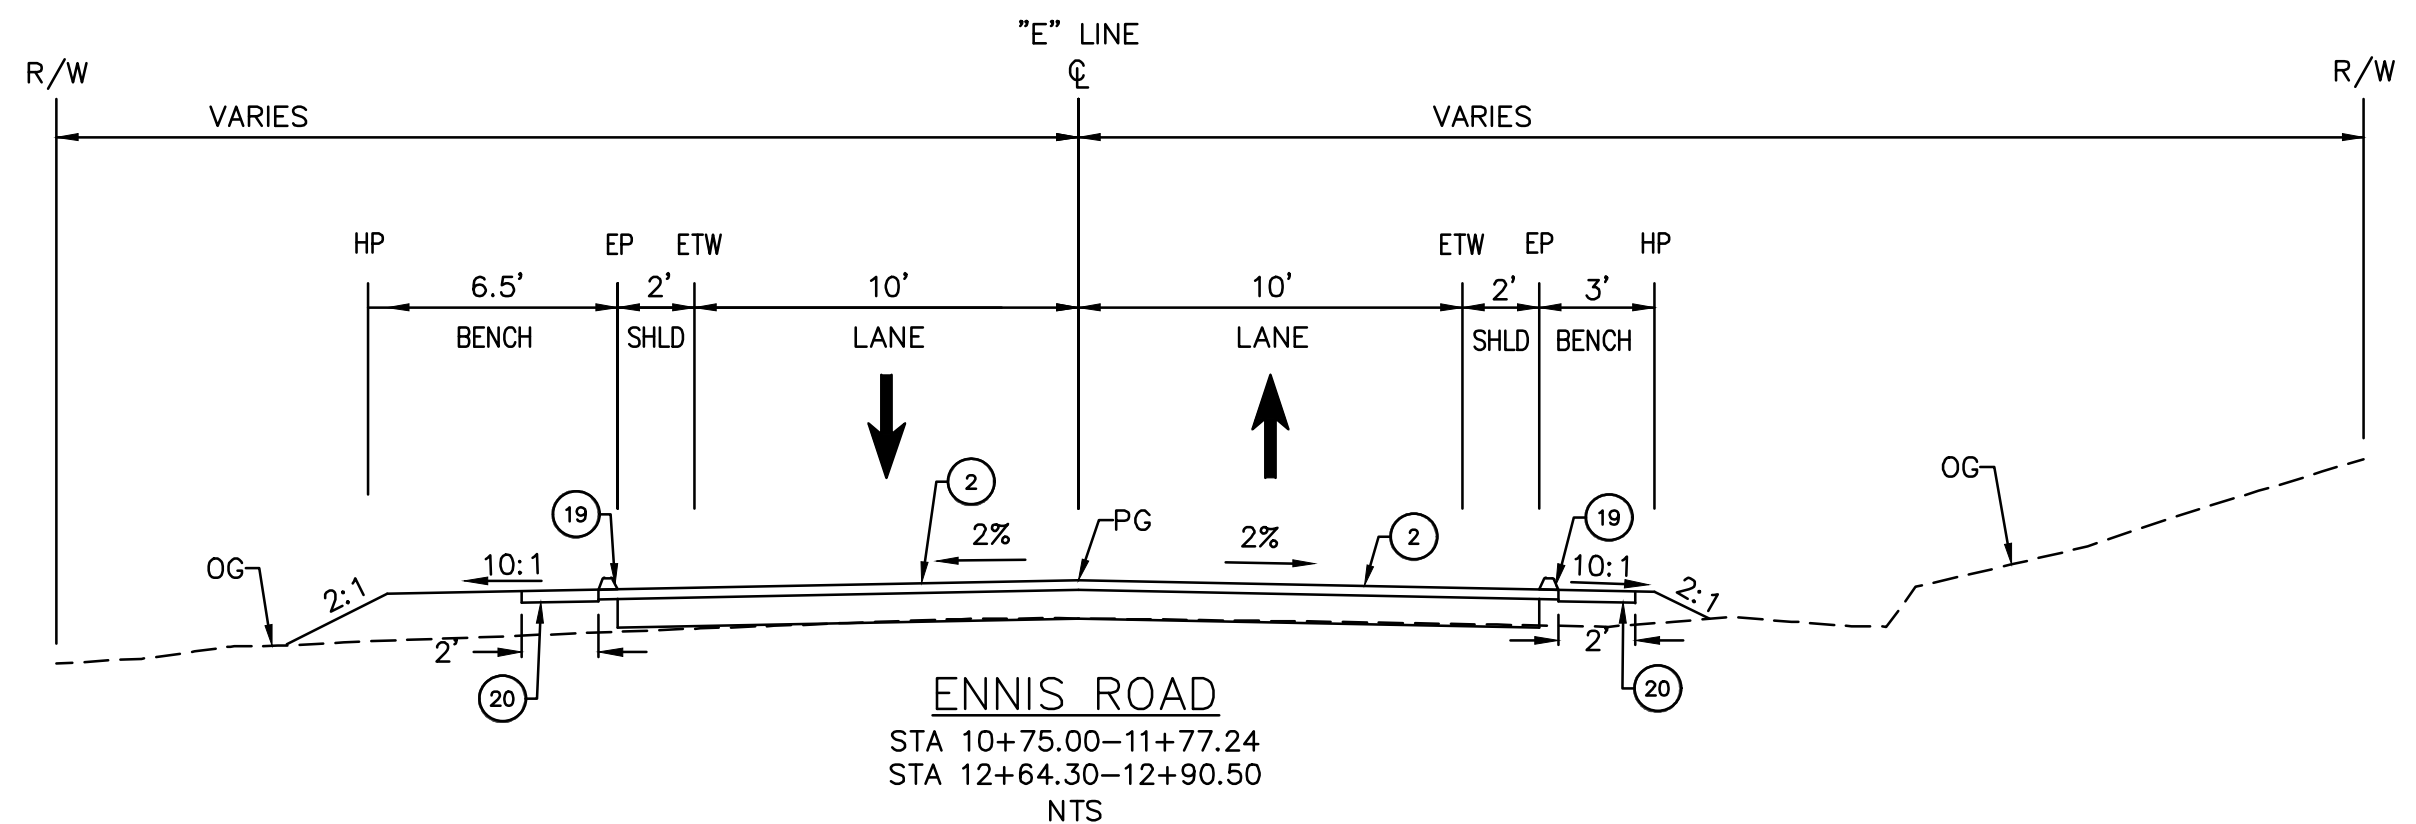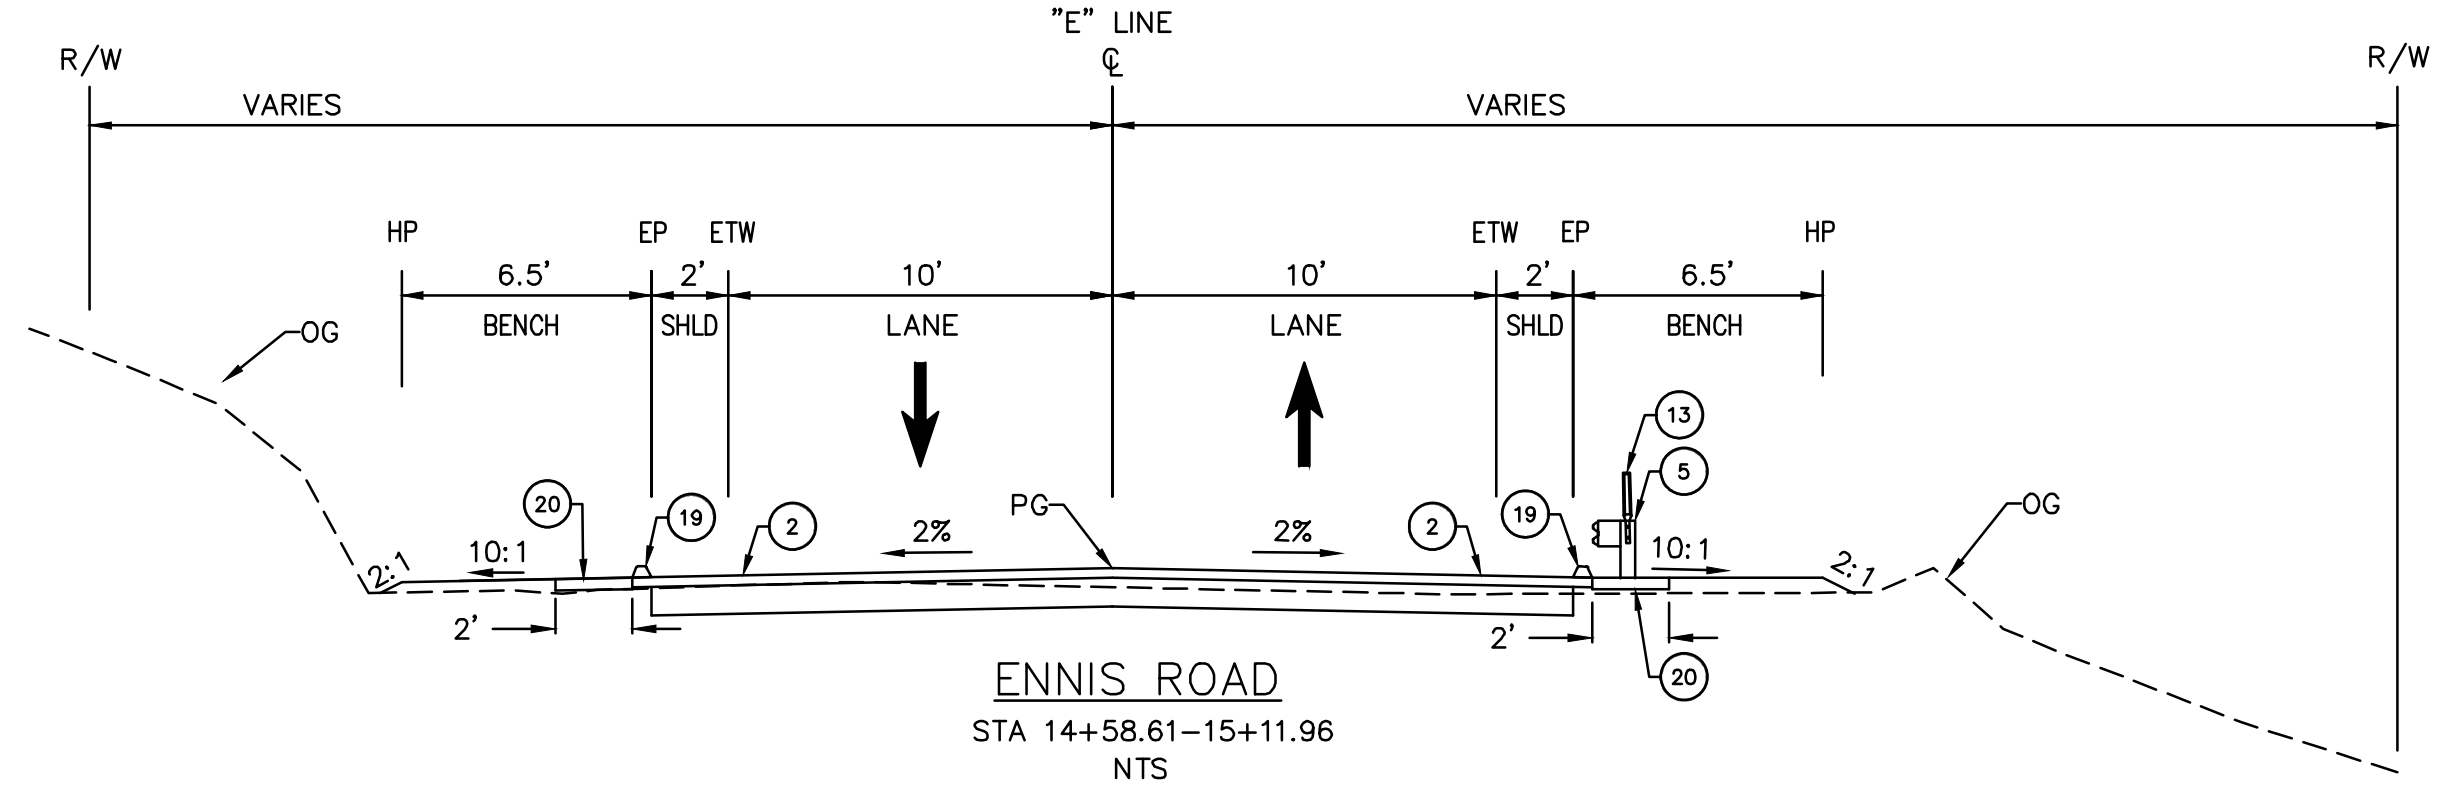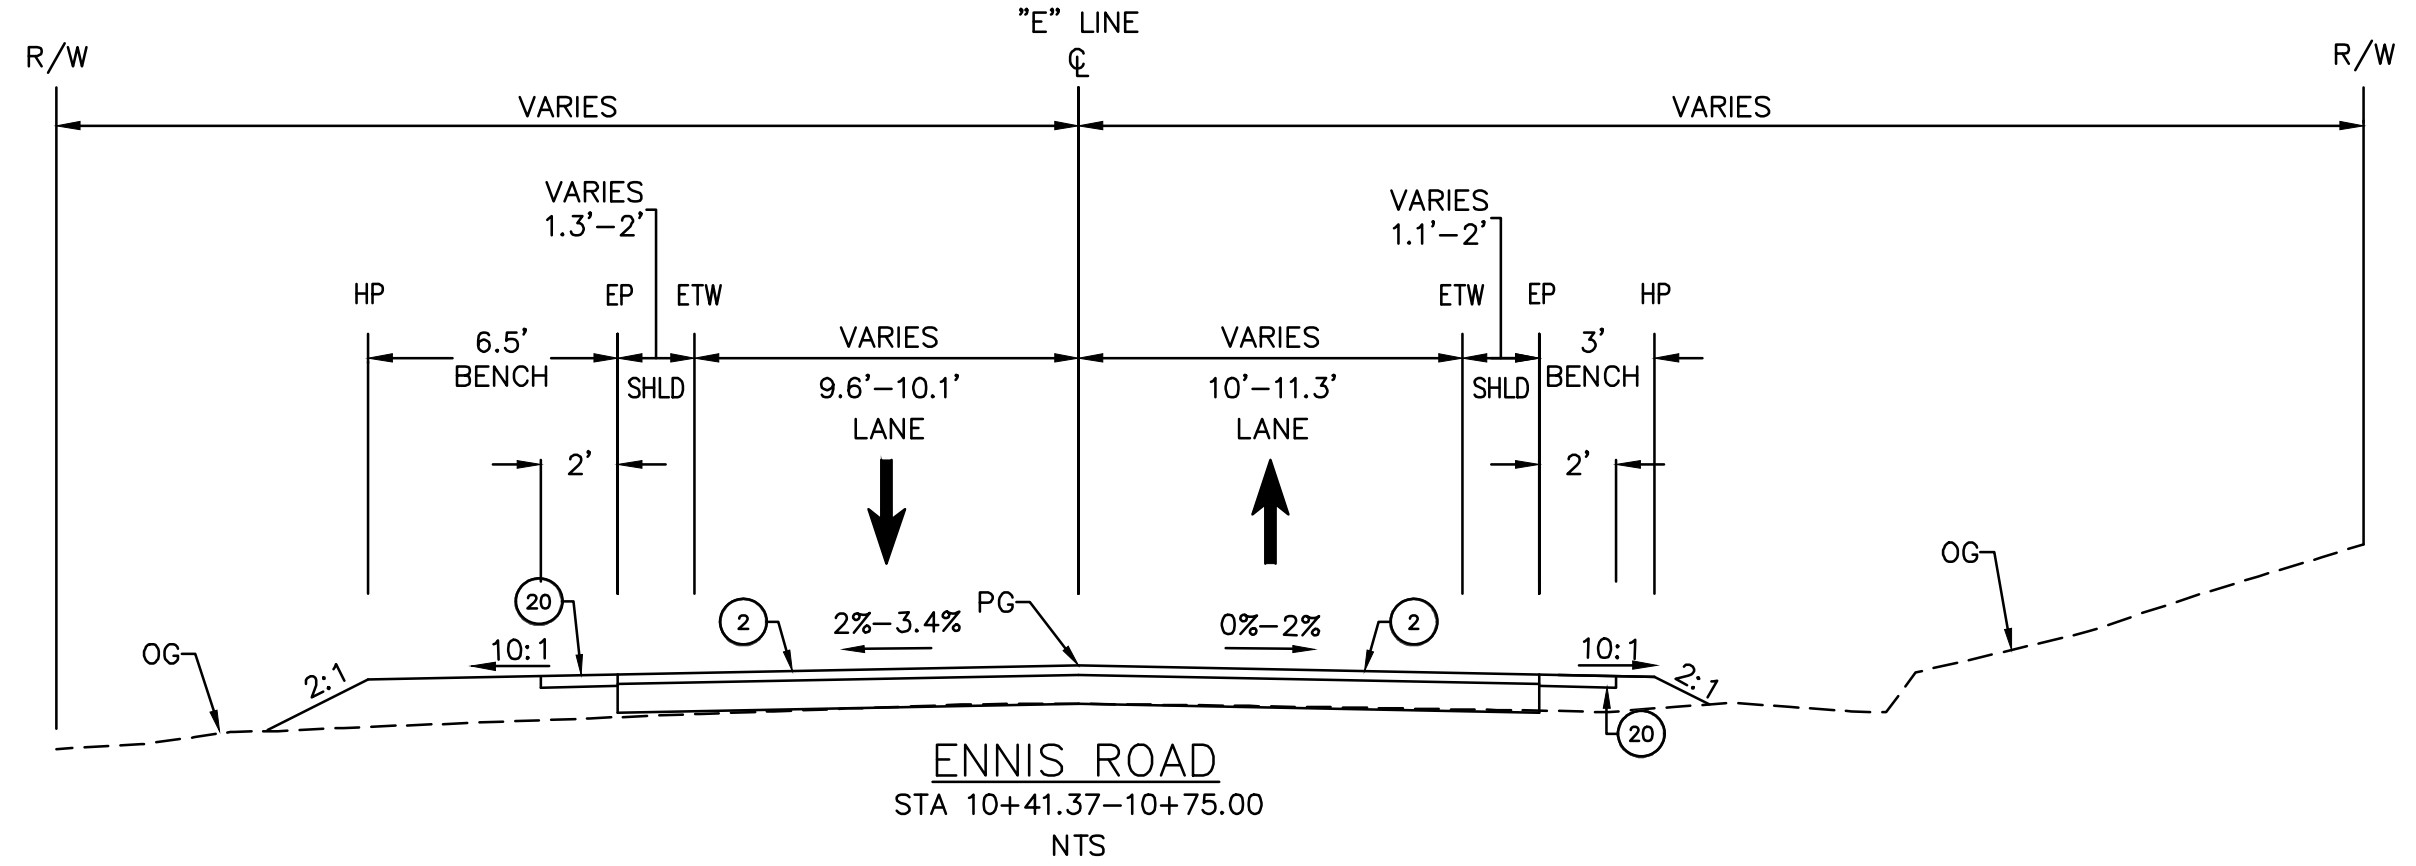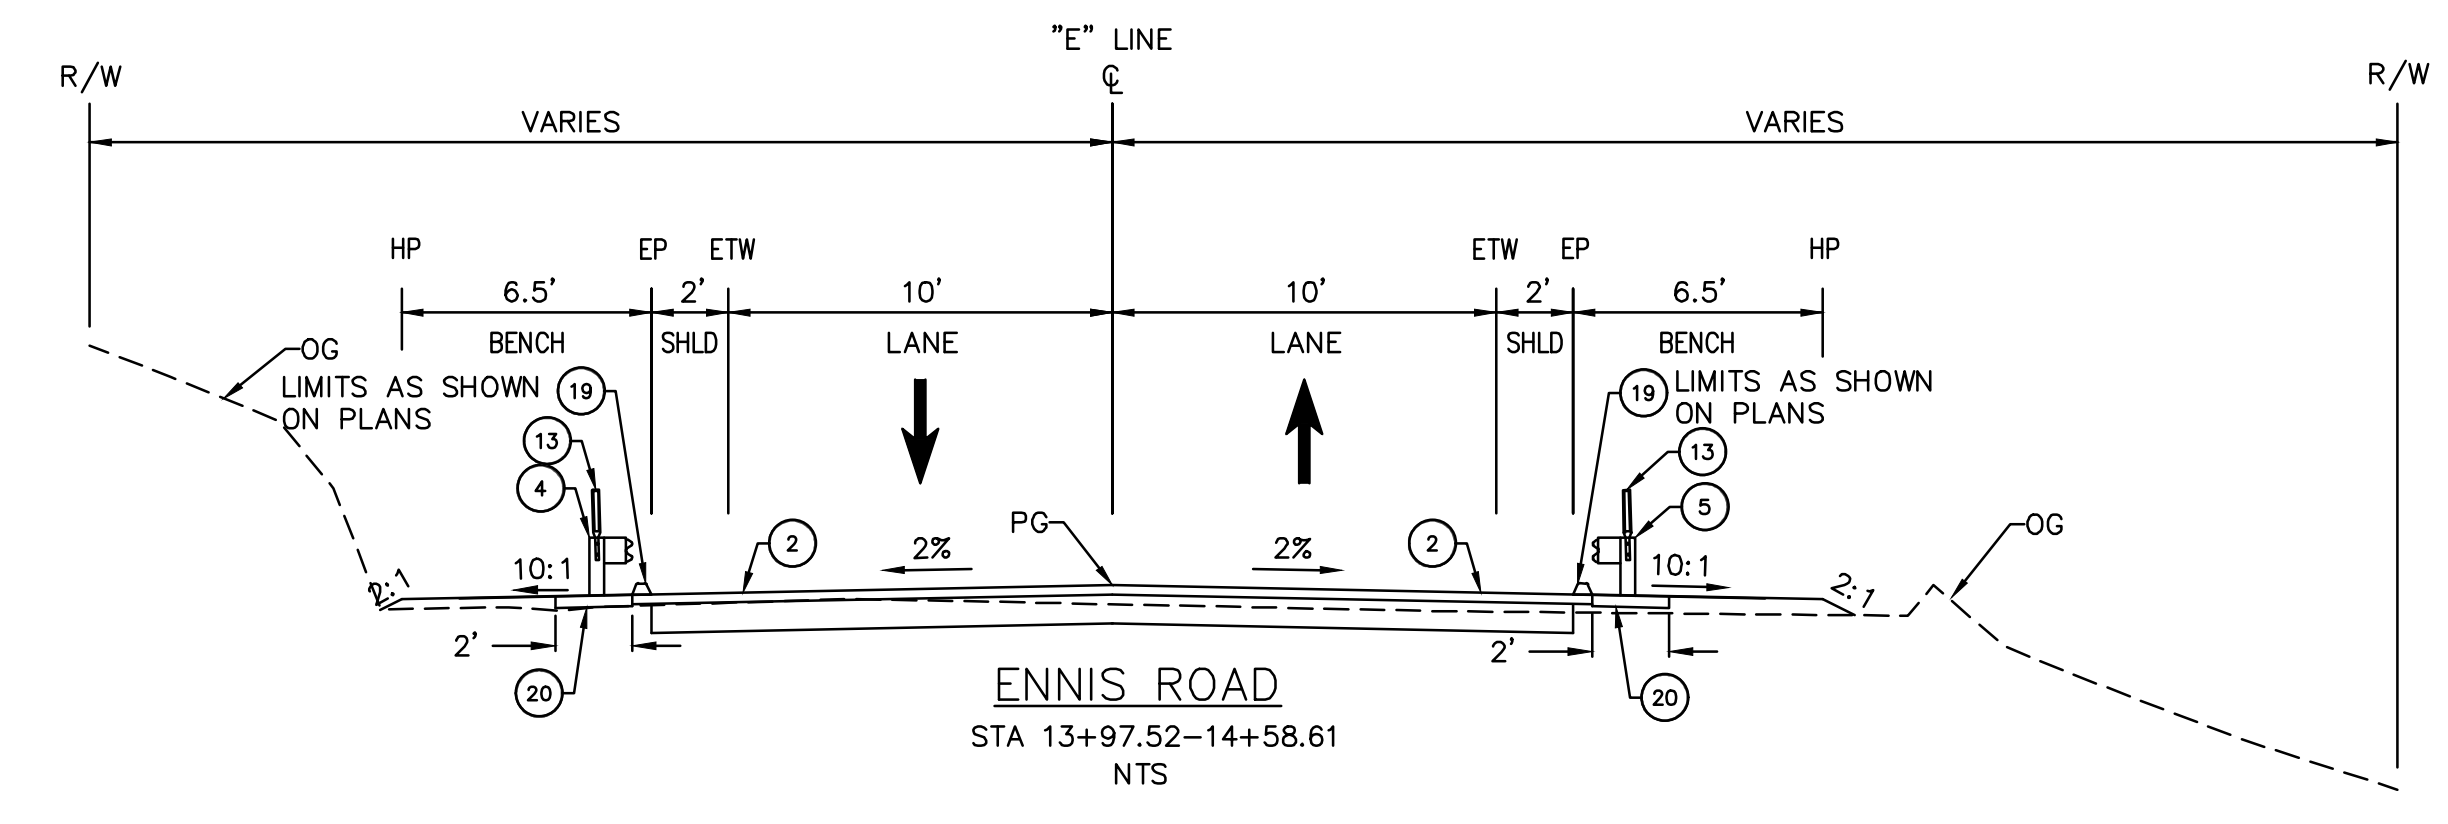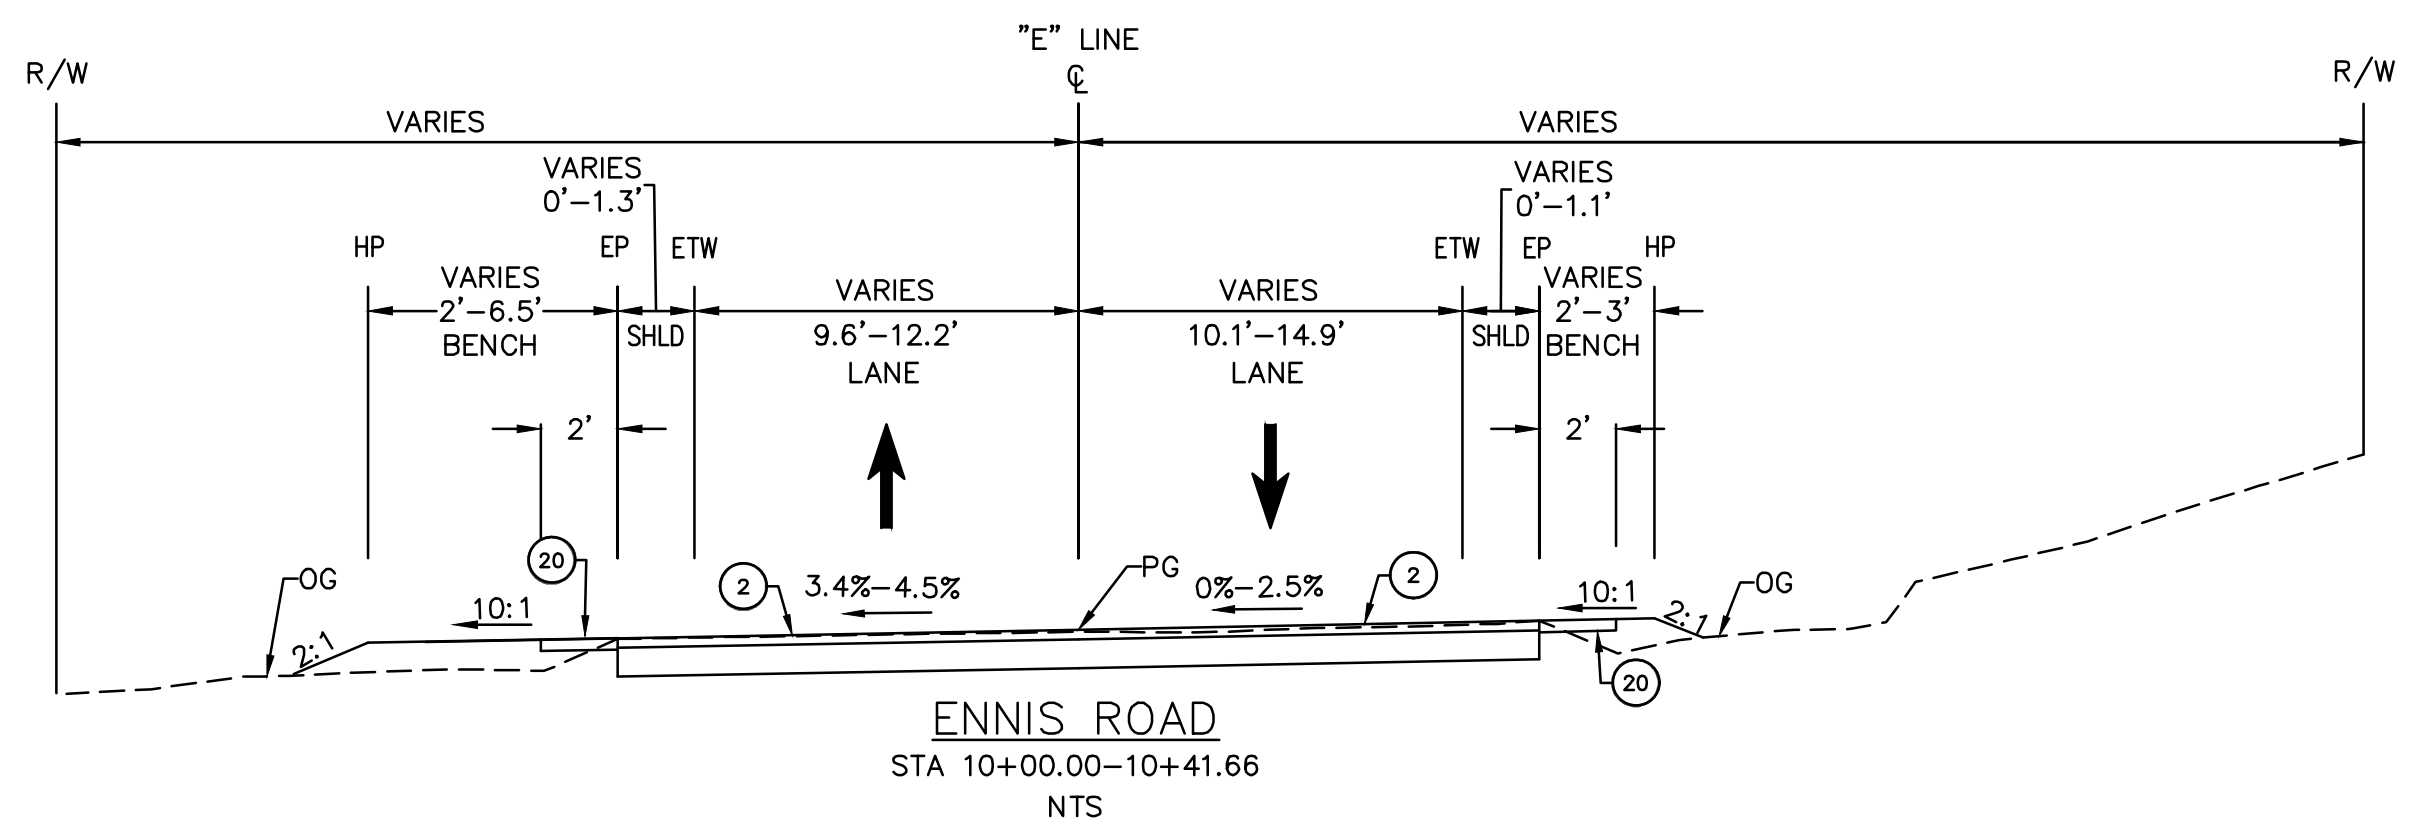

- CONSTRUCTION NOTES:**
- 2 CONSTRUCT 3" HMA OVER 9" AB
 - 4 CONSTRUCT GUARDRAIL SYSTEM STANDARD RAILING SECTION, PER CALTRANS RSP A77L1 WITH CALTRANS APPROVED 31" IN-LINE TERMINAL END TREATMENT, USING TYPE 12A LAYOUT PER CALTRANS RSP A77Q1
 - 5 CONSTRUCT GUARDRAIL SYSTEM STANDARD RAILING SECTION, PER CALTRANS RSP A77L1 WITH CALTRANS APPROVED 31" IN-LINE TERMINAL END TREATMENT, USING TYPE 12AA LAYOUT PER CALTRANS RSP A77Q4
 - 13 INSTALL MUTCD STANDARD TYPE E WHITE RETROREFLECTOR (2-SIDED) GUARDRAIL DELINEATOR; SPACING TO BE EVERY 20 FT
 - 19 CONSTRUCT HOT MIX ASPHALT DIKE TYPE C PER CALTRANS STANDARD PLAN RSP A87B PER PLACEMENT AS INDICATED ON CALTRANS STANDARD PLAN A77N4
 - 20 CONSTRUCT SHOULDER BACKING MATERIAL AT A DEPTH OF 0.30'




X-1

DESIGNED: SA	DATE: 3/12/2021	RECORD DRAWING		SCALE	PROJECT		DEPARTMENT OF PUBLIC WORKS AND PLANNING		
DRAWN: LS	DATE: 3/12/2021	RESIDENT ENGINEER	DATE	AS SHOWN				SAND CREEK BRIDGE REPLACEMENT ON ENNIS ROAD	TYPICAL SECTIONS
CHECKED: SA	DATE: 3/12/2021								
FOR RIGHT OF WAY DATA AND ACCURATE ACCESS DETERMINATION, SEE DOCUMENTS IN THE DEPARTMENT OF PUBLIC WORKS AND PLANNING.							SHEET NO. 4		
							TOTAL 31		

THESE PLANS ARE FOR THE CONTRACTOR'S INFORMATION ONLY. THEY ARE NOT TO BE CONSIDERED TO BE PART OF THE CONTRACT DOCUMENTS AND SHALL HAVE NO BEARING WHATSOEVER ON THE INTERPRETATION OF THE STANDARD SPECIFICATIONS, THE STANDARD PLANS, THE SPECIAL PROVISIONS, NOR SHALL THEY HAVE ANY BEARING WHATSOEVER ON THE INTERPRETATION OF THE OTHER PUBLICATIONS REFERENCED THEREIN

CONSTRUCTION NOTES:

- 2 CONSTRUCT 3" HMA OVER 9" AB
- 4 CONSTRUCT GUARDRAIL SYSTEM STANDARD RAILING SECTION, PER CALTRANS RSP A77L1 WITH CALTRANS APPROVED 31" IN-LINE TERMINAL END TREATMENT, USING TYPE 12A LAYOUT PER CALTRANS RSP A77Q1
- 5 CONSTRUCT GUARDRAIL SYSTEM STANDARD RAILING SECTION, PER CALTRANS RSP A77L1 WITH CALTRANS APPROVED 31" IN-LINE TERMINAL END TREATMENT, USING TYPE 12AA LAYOUT PER CALTRANS RSP A77Q4
- 13 INSTALL MUTCD STANDARD TYPE E WHITE RETROREFLECTOR (2-SIDED) GUARDRAIL DELINEATOR; SPACING TO BE EVERY 20 FT
- 19 CONSTRUCT HOT MIX ASPHALT DIKE TYPE C PER CALTRANS STANDARD PLAN RSP A87B PER PLACEMENT AS INDICATED ON CALTRANS STANDARD PLAN A77N4
- 20 CONSTRUCT SHOULDER BACKING MATERIAL AT A DEPTH OF 0.30'

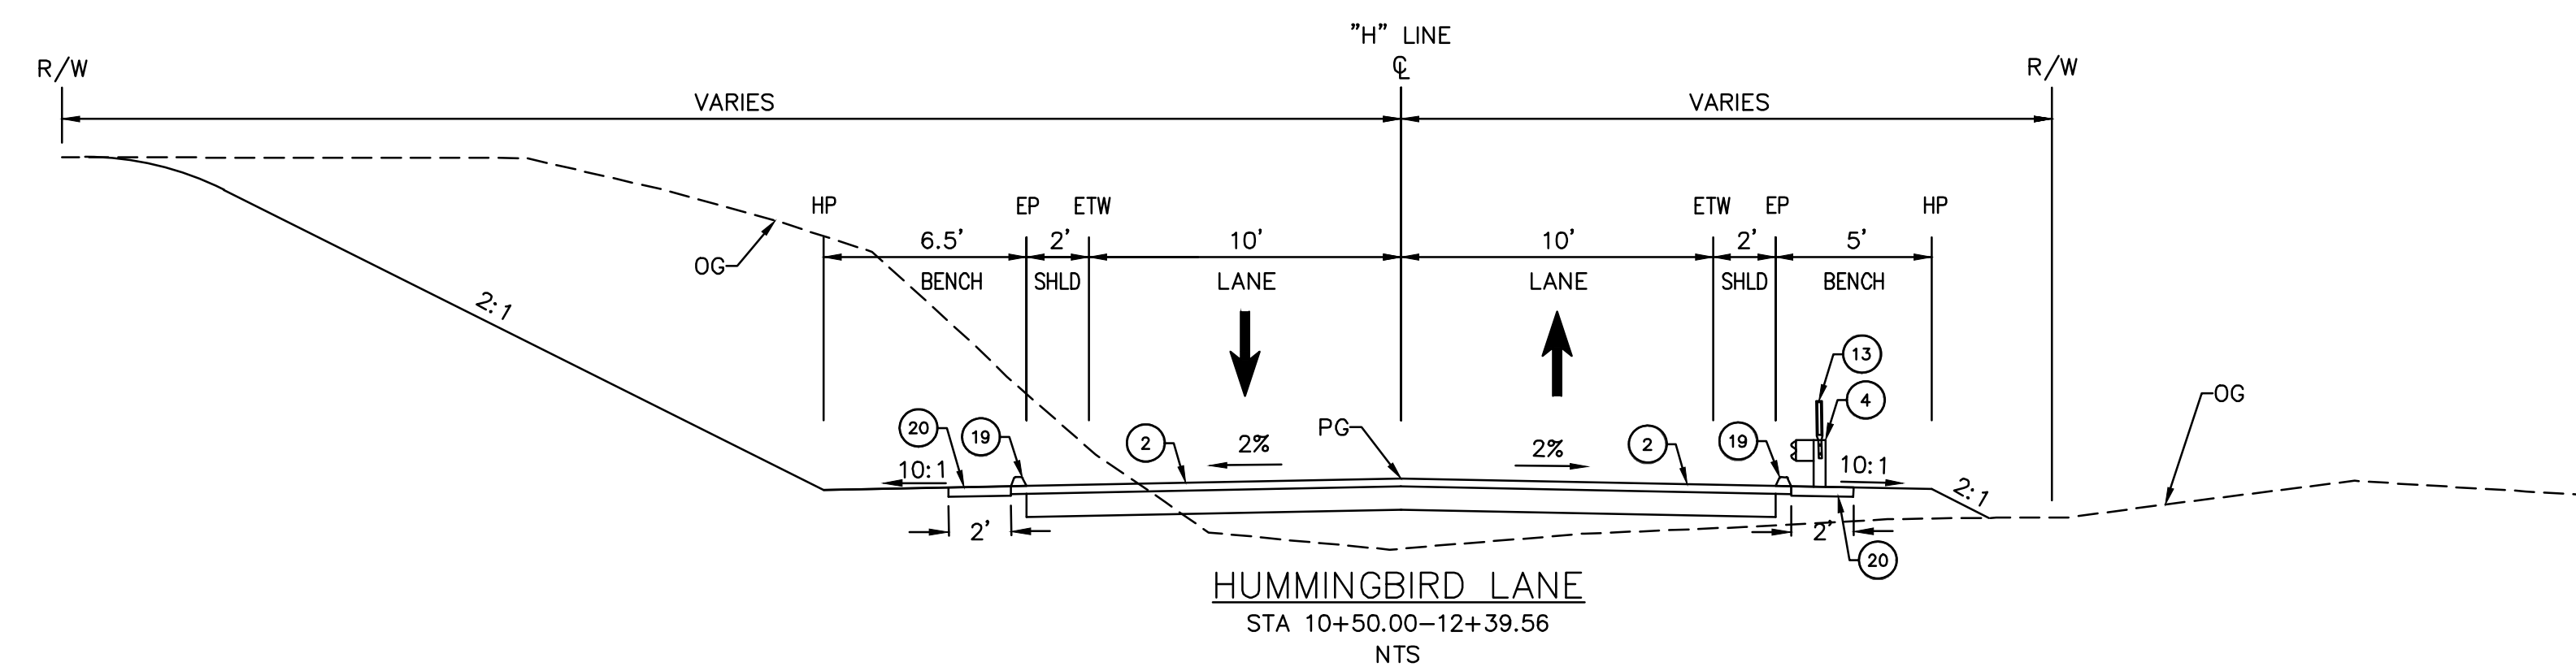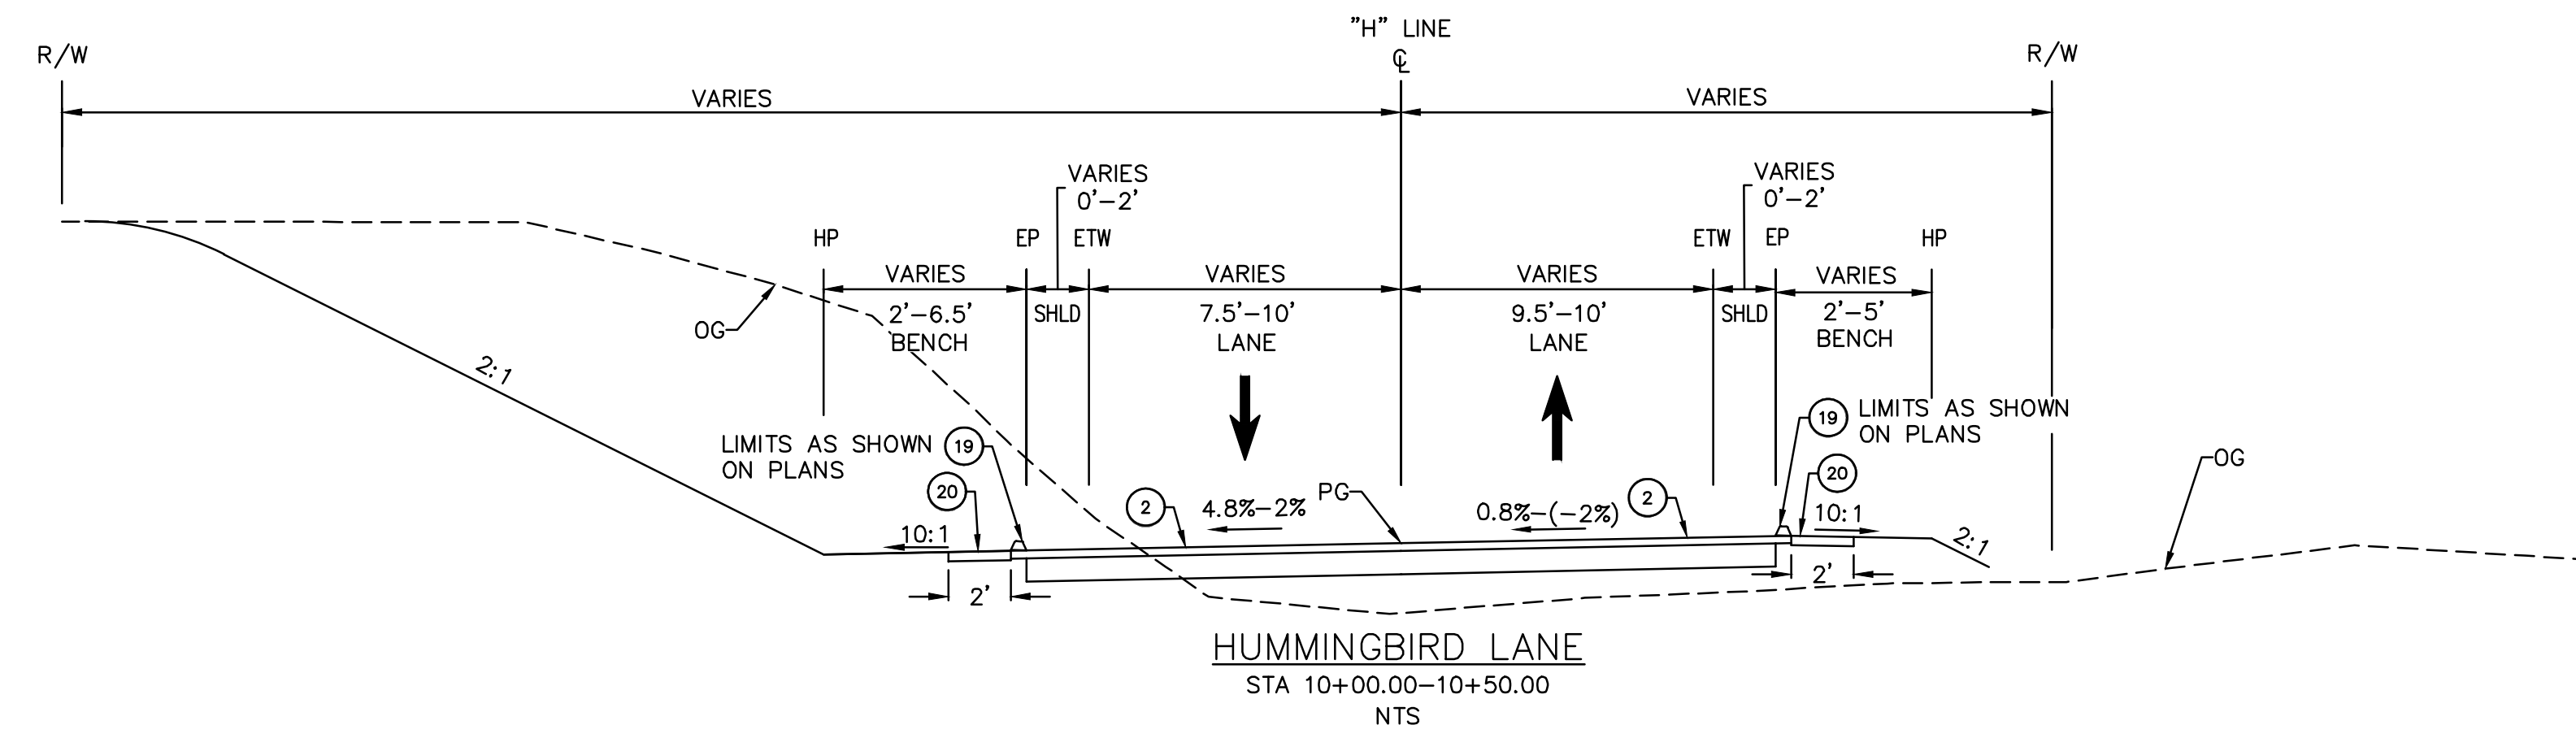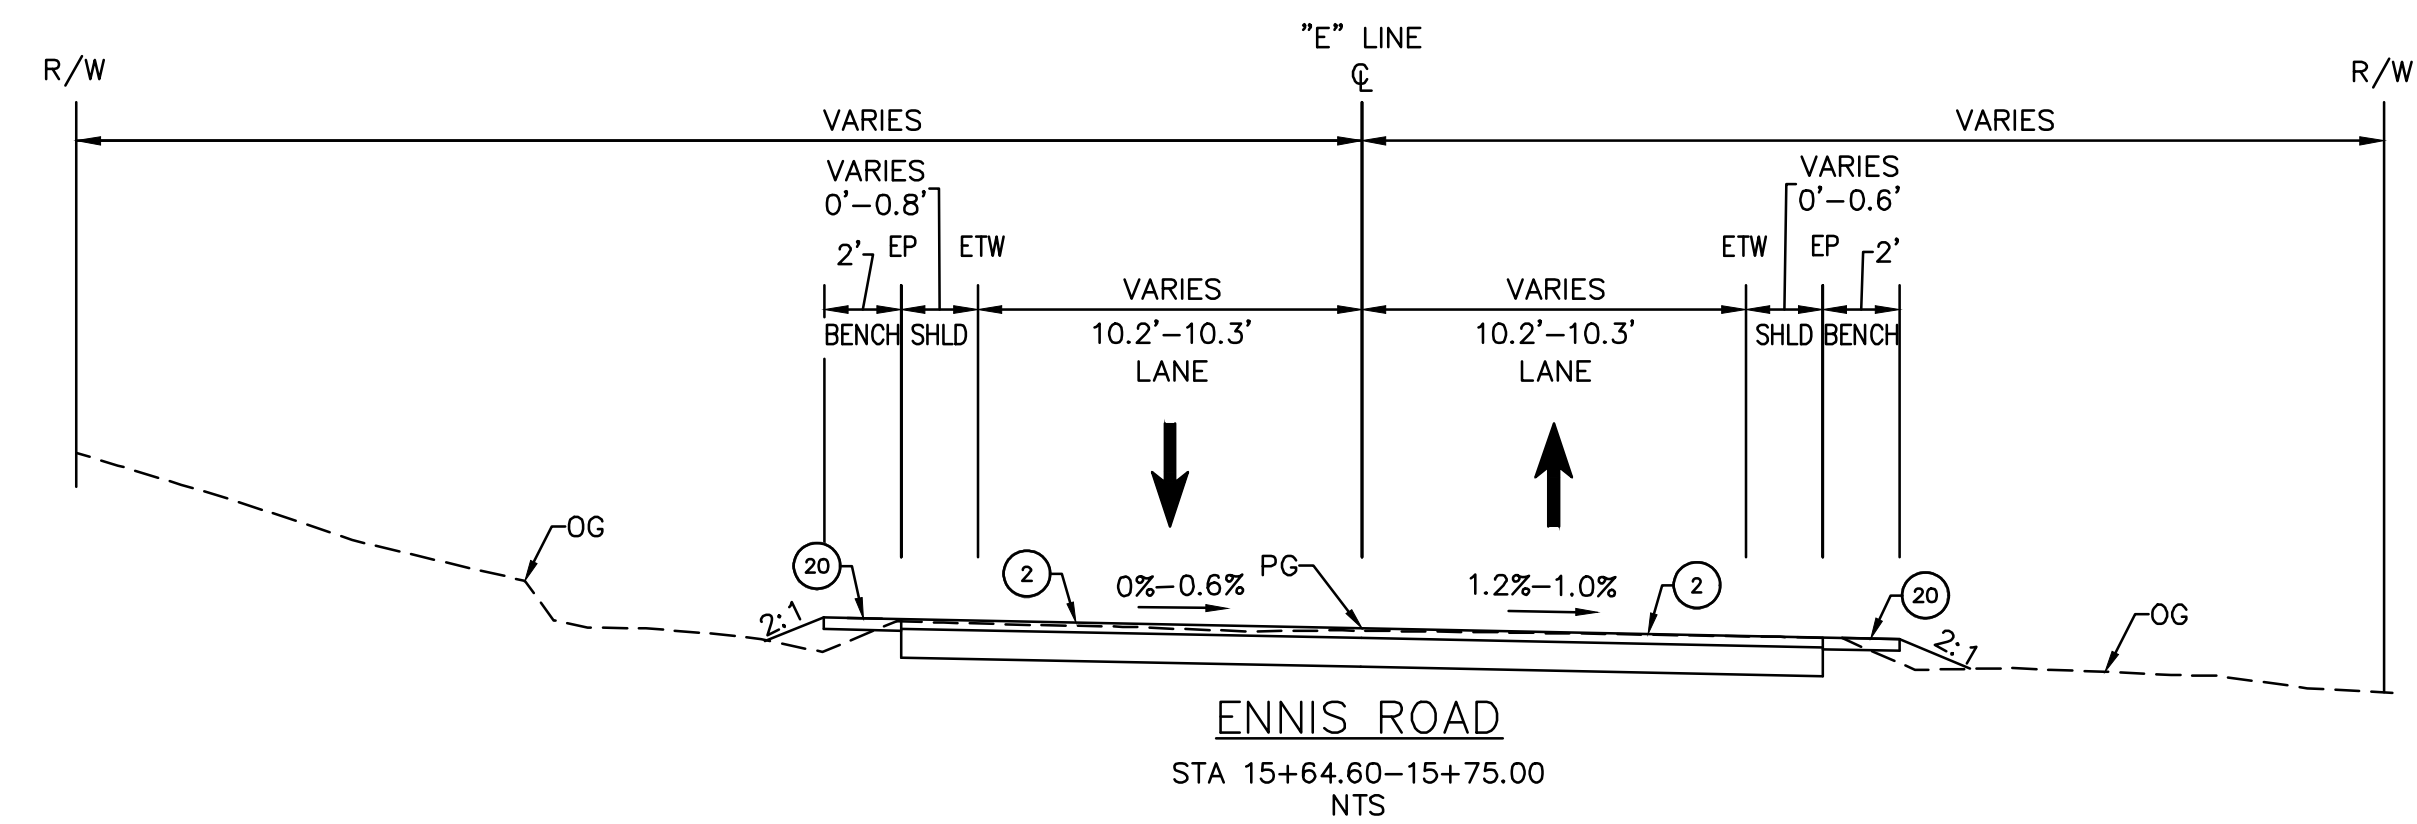


X-2

\\BKF-OAK\VOL4\ENGIN\4\20141070_FRESNO-SAND_CREEK_BRIDGE_ON_ENNIS_ROAD\ENGIN\4\SHEETS\X-1

	DATE	RECORD DRAWING	SCALE	PROJECT		DEPARTMENT OF PUBLIC WORKS AND PLANNING	
DESIGNED: SA	3/12/2021	RESIDENT ENGINEER	AS SHOWN	SAND CREEK BRIDGE REPLACEMENT ON ENNIS ROAD		TYPICAL SECTION	
DRAWN: LS	3/12/2021			ROAD NO. 2824-2825		BRIDGE NO. 42C0697, BRLO-5942(238)	DRAWING NO. 11257
CHECKED: SA	3/12/2021			SHEET NO. 5		TOTAL 31	
FOR RIGHT OF WAY DATA AND ACCURATE ACCESS DETERMINATION, SEE DOCUMENTS IN THE DEPARTMENT OF PUBLIC WORKS AND PLANNING.							

THESE PLANS ARE FOR THE CONTRACTOR'S INFORMATION ONLY. THEY ARE NOT TO BE CONSIDERED TO BE PART OF THE CONTRACT DOCUMENTS AND SHALL HAVE NO BEARING WHATSOEVER ON THE INTERPRETATION OF THE STANDARD SPECIFICATIONS, THE STANDARD PLANS, THE SPECIAL PROVISIONS, NOR SHALL THEY HAVE ANY BEARING WHATSOEVER ON THE INTERPRETATION OF THE OTHER PUBLICATIONS REFERENCED THEREIN

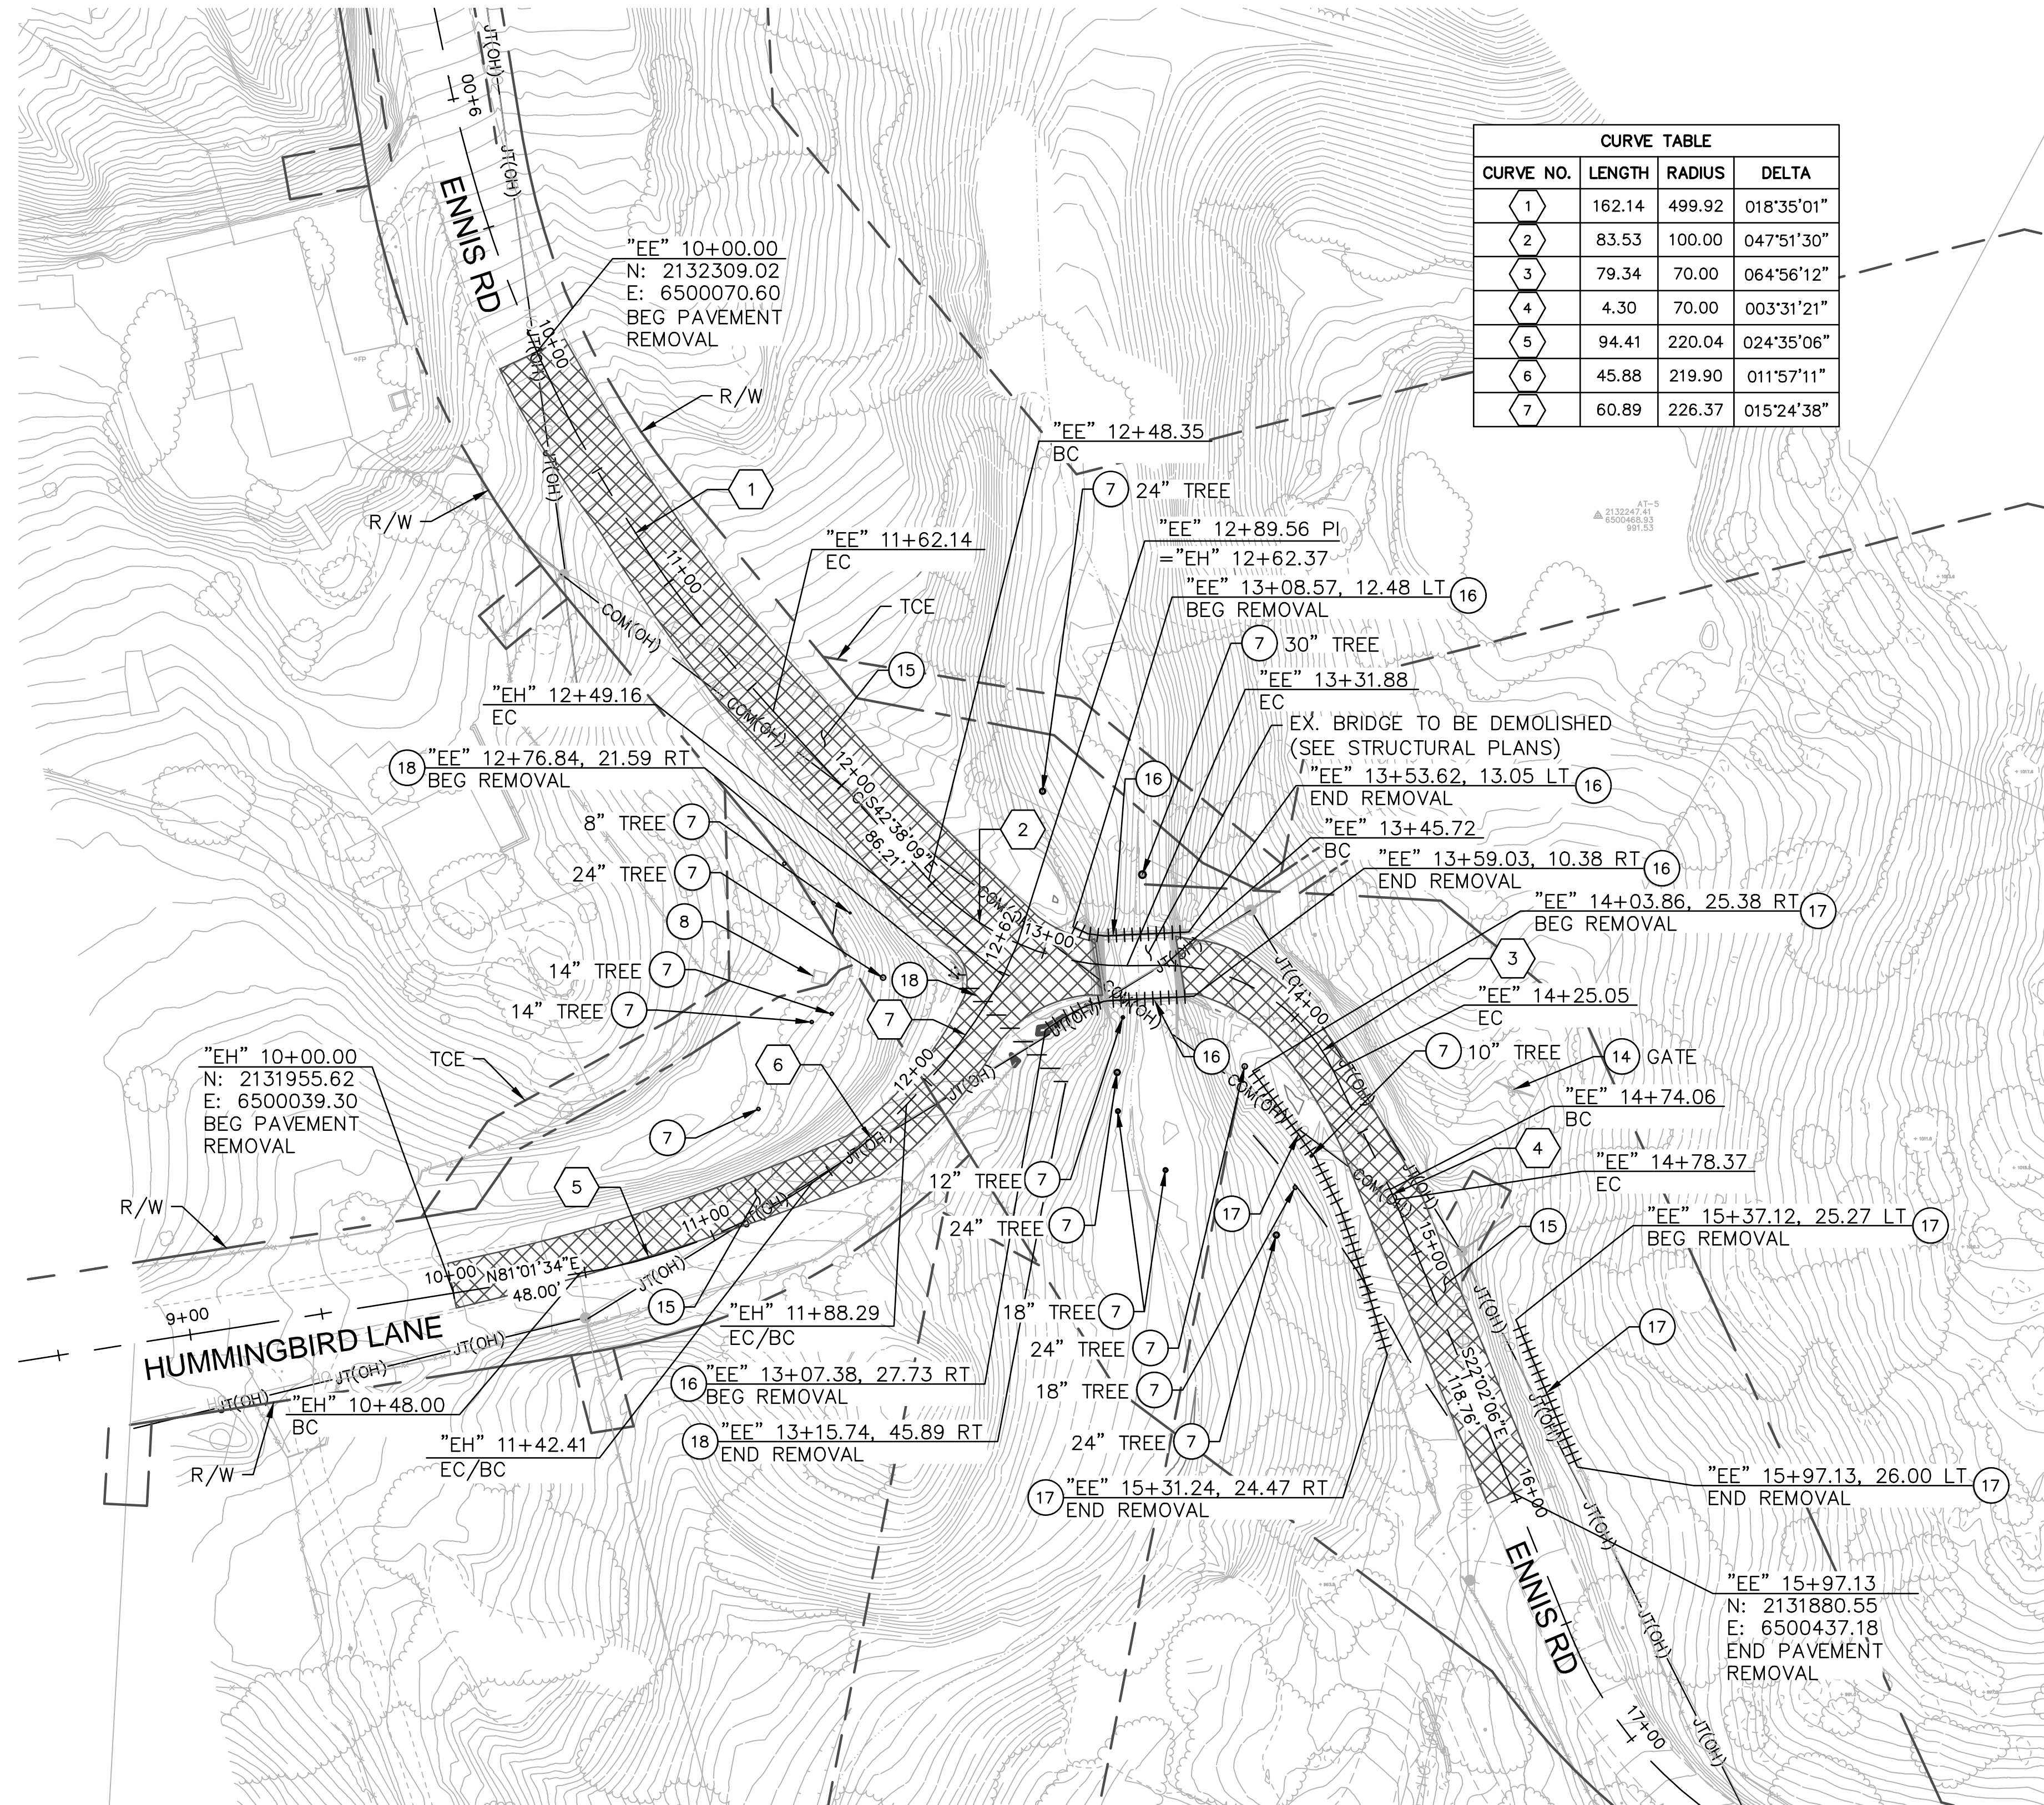


CURVE TABLE			
CURVE NO.	LENGTH	RADIUS	DELTA
1	162.14	499.92	018°35'01"
2	83.53	100.00	047°51'30"
3	79.34	70.00	064°56'12"
4	4.30	70.00	003°31'21"
5	94.41	220.04	024°35'06"
6	45.88	219.90	011°57'11"
7	60.89	226.37	015°24'38"

- CONSTRUCTION NOTES:**
- 7 REMOVE EXISTING TREE
 - 8 PROTECT IN PLACE SHED STRUCTURE
 - 14 PROTECT IN PLACE GATE
 - 15 REMOVE EXISTING ASPHALT CONCRETE PAVEMENT
 - 16 REMOVE EXISTING METAL BEAM GUARDRAIL
 - 17 REMOVE EXISTING WOOD POST AND WIRE FENCE
 - 18 REMOVE EXISTING 24" STORM DRAIN PIPE

- LEGEND**
- OH — EX. OVERHEAD ELECTRICAL
 - OT — EX. OVERHEAD TELECOMMUNICATIONS
 - - - - - ROW
 - - - - - TCE
 - (CIRCLE WITH TREE) EX. TREE
 - (CIRCLE WITH UTILITY POLE) EX. UTILITY POLE
 - (HATCHED) EX. ASPHALT CONCRETE PAVEMENT REMOVAL
 - (DASHED) EX. FENCE REMOVAL
 - (DIAGONAL) EX. STORM DRAIN REMOVAL


- NOTES:**
- FOR BRIDGE DEMOLITION, SEE STRUCTURAL PLANS.
 - SEE PP SHEETS FOR EXISTING UTILITY DISPOSITIONS.
 - SEE SHEET SS-1 FOR EXISTING SIGNING REMOVAL AND IMPROVEMENTS.

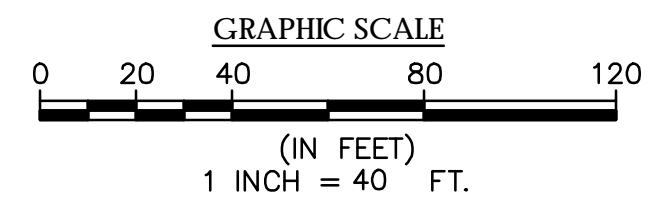


DM-1

DESIGNED: SA		DATE: 3/12/2021	RECORD DRAWING		SCALE	PROJECT			DEPARTMENT OF PUBLIC WORKS AND PLANNING	
DRAWN: LS		DATE: 3/12/2021	RESIDENT ENGINEER		AS SHOWN	SAND CREEK BRIDGE REPLACEMENT ON ENNIS ROAD			DEMOLITION PLAN	
CHECKED: SA		DATE: 3/12/2021	DATE			ROAD NO. 2824-2825 BRIDGE NO. 42C0697, BRLO-5942(238)			DRAWING NO. 11257 SHEET NO. 6 TOTAL 31	

THESE PLANS ARE FOR THE CONTRACTOR'S INFORMATION ONLY. THEY ARE NOT TO BE CONSIDERED TO BE PART OF THE CONTRACT DOCUMENTS AND SHALL HAVE NO BEARING WHATSOEVER ON THE INTERPRETATION OF THE STANDARD SPECIFICATIONS, THE STANDARD PLANS, THE SPECIAL PROVISIONS, NOR SHALL THEY HAVE ANY BEARING WHATSOEVER ON THE INTERPRETATION OF THE OTHER PUBLICATIONS REFERENCED THEREIN

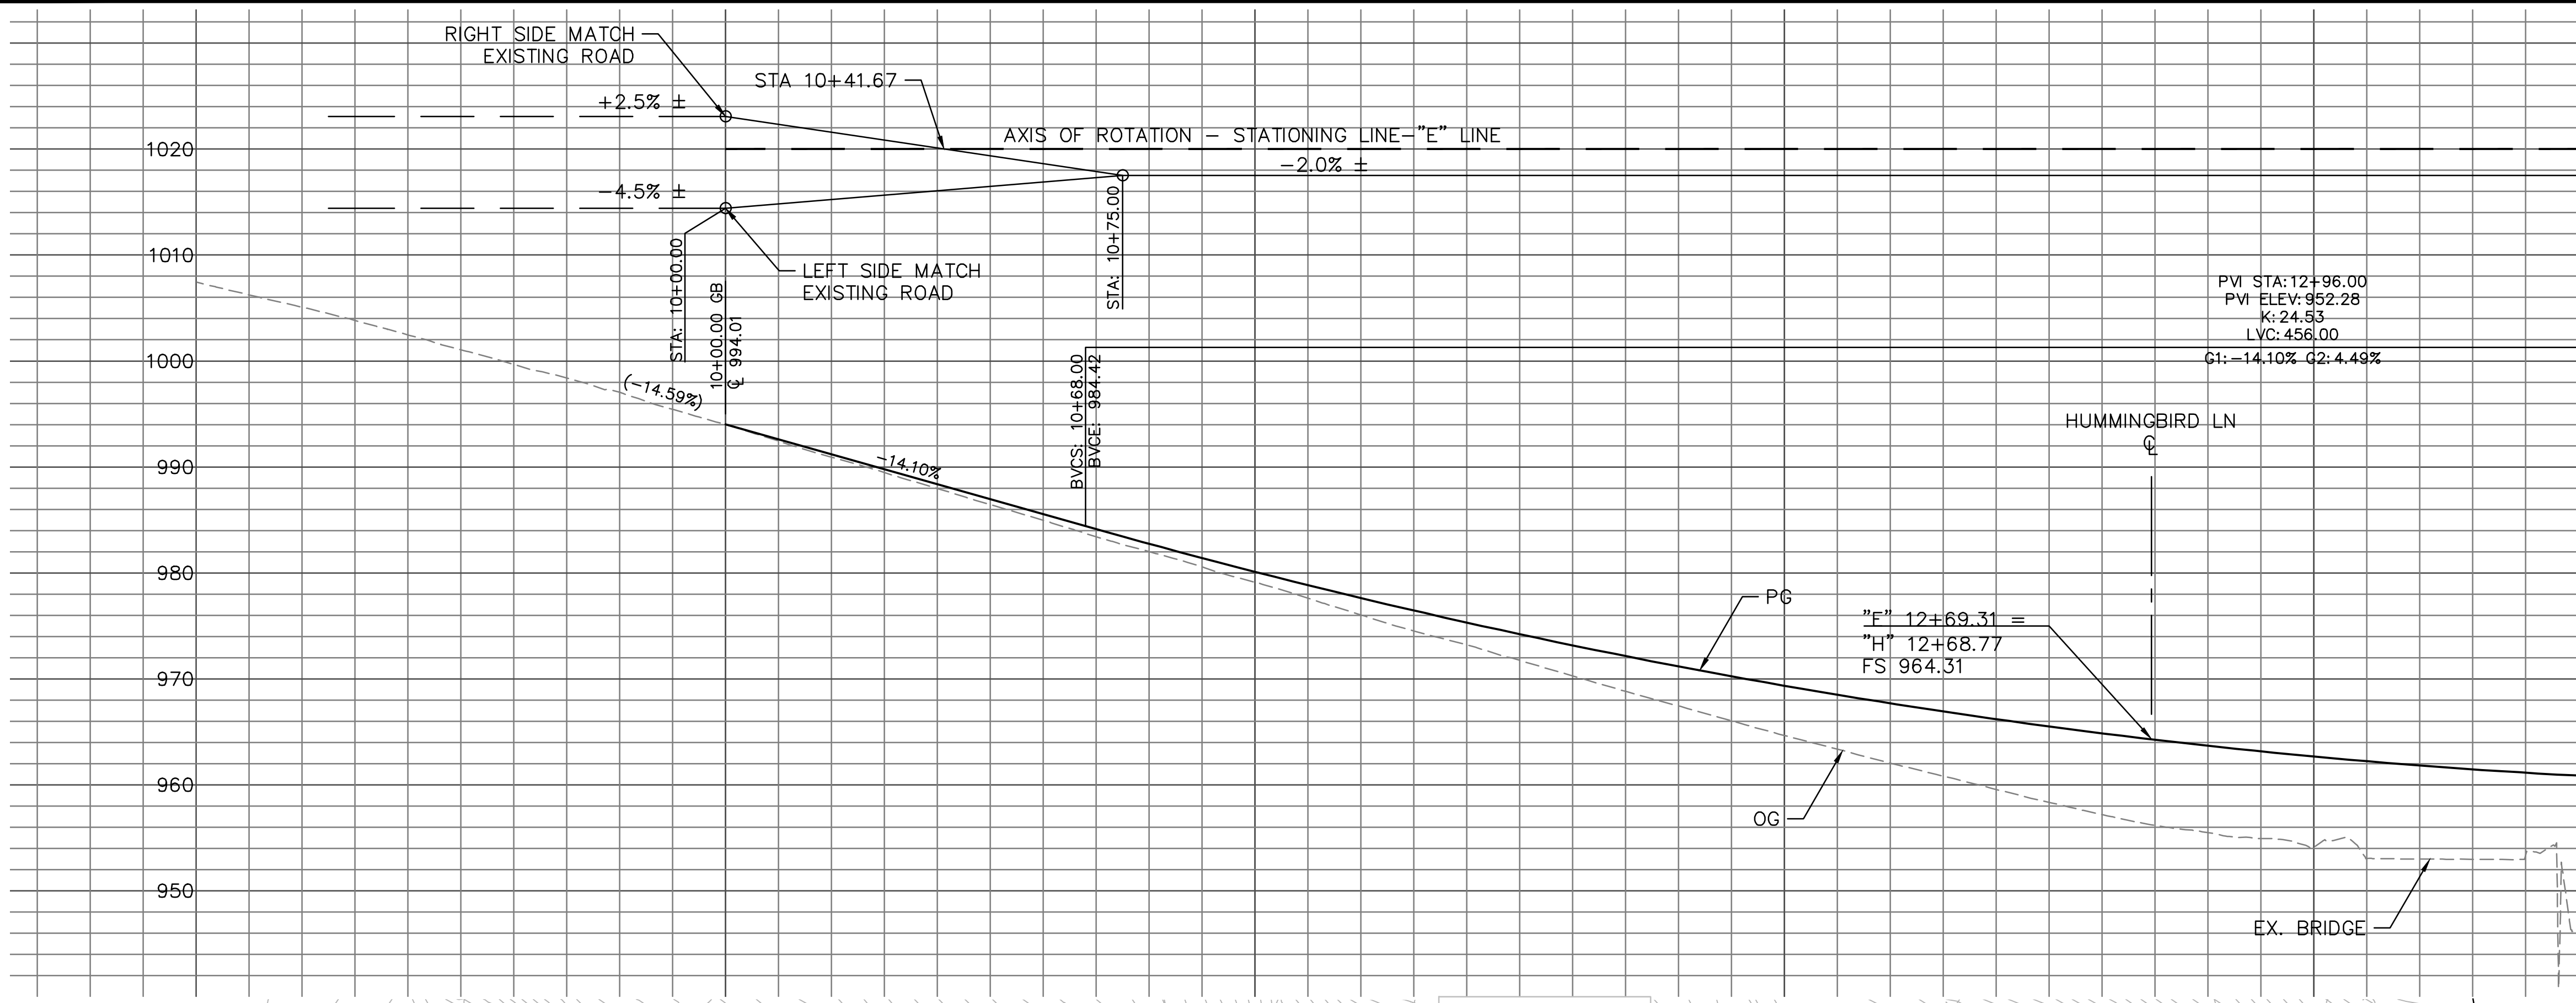

- CONSTRUCTION NOTES:**
- 1 PROTECT IN PLACE UTILITY POLE
 - 2 CONSTRUCT 3" HMA OVER 9" AB
 - 3 PROTECT IN PLACE OVERHEAD LINES
 - 4 CONSTRUCT GUARDRAIL SYSTEM STANDARD RAILING SECTION, PER CALTRANS RSP A77L1 WITH CALTRANS APPROVED 31" IN-LINE TERMINAL END TREATMENT, USING TYPE 12A LAYOUT PER CALTRANS RSP A77Q1
 - 5 CONSTRUCT GUARDRAIL SYSTEM STANDARD RAILING SECTION, PER CALTRANS RSP A77L1 WITH CALTRANS APPROVED 31" IN-LINE TERMINAL END TREATMENT, USING TYPE 12AA LAYOUT PER CALTRANS RSP A77Q4
 - 6 RELOCATE UTILITY POLE AND OVERHEAD LINE (BY OTHERS)
 - 9 INSTALL TRANSITIONAL RAILING TYPE WB-31 PER CALTRANS STD PLAN RSP A77U4
 - 13 INSTALL MUTCD STANDARD TYPE E WHITE RETROREFLECTOR (2-SIDED) GUARDRAIL DELINEATOR; SPACING TO BE EVERY 20 FT
 - 19 CONSTRUCT HOT MIX ASPHALT DIKE TYPE C PER CALTRANS STANDARD PLAN RSP A87B PER PLACEMENT AS INDICATED ON CALTRANS STANDARD PLAN A77N4
 - 21 CONCRETE BARRIER, SEE STRUCTURAL PLANS
 - 22 SAWCUT, MATCH EXISTING

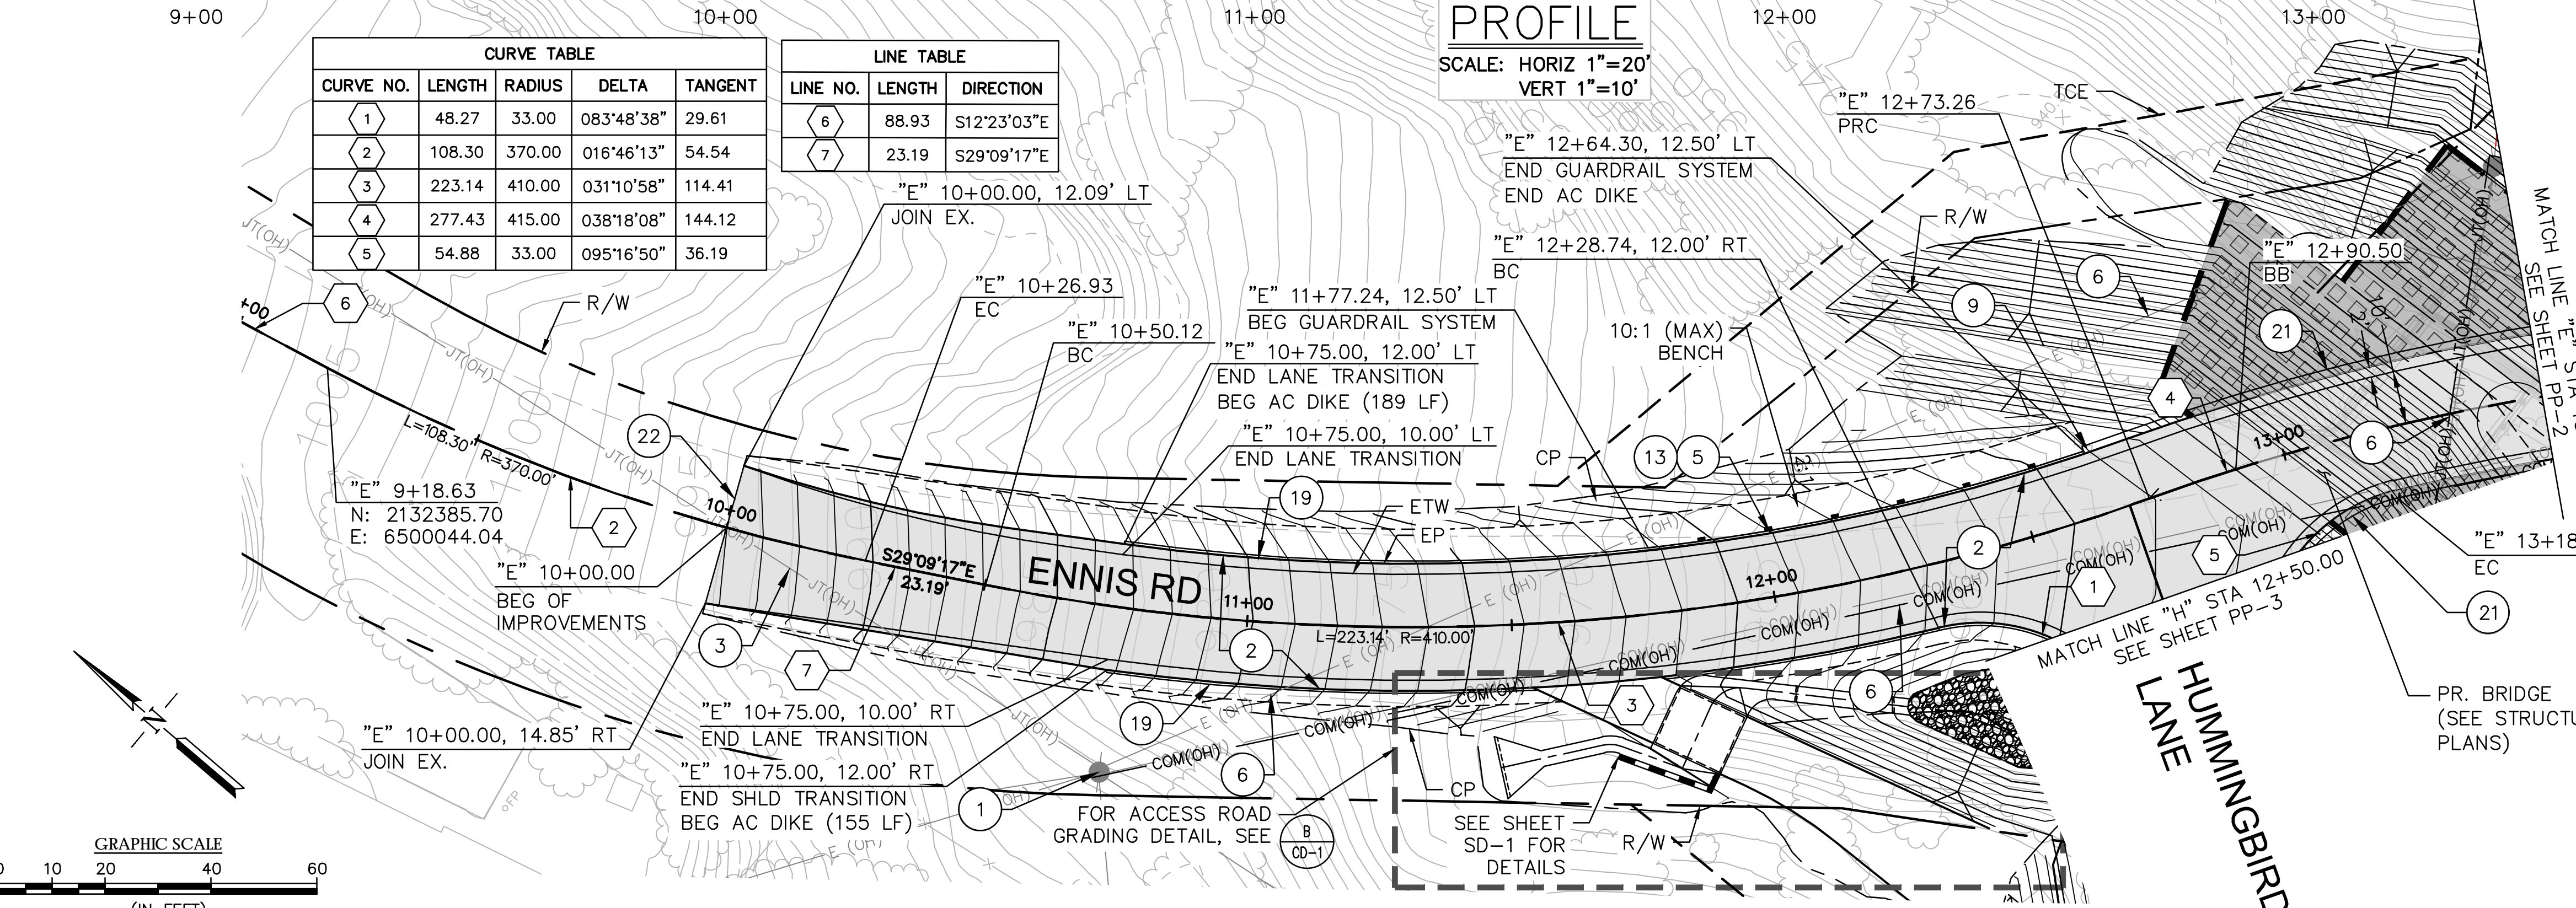


CURVE TABLE				
CURVE NO.	LENGTH	RADIUS	DELTA	TANGENT
1	48.27	33.00	083°48'38"	29.61
2	108.30	370.00	016°46'13"	54.54
3	223.14	410.00	031°10'58"	114.41
4	277.43	415.00	038°18'08"	144.12
5	54.88	33.00	095°16'50"	36.19

LINE TABLE		
LINE NO.	LENGTH	DIRECTION
6	88.93	S12°23'03"E
7	23.19	S29°09'17"E

PROFILE
SCALE: HORIZ 1"=20'
VERT 1"=10'


- LEGEND**
- EX. UTILITY POLE
 - E (OH) — EX. OVERHEAD ELECTRICAL
 - - - R/W
 - - - TCE
 - - - PR. DAYLIGHT
 - - - PR. BENCH
 - - - PR. MGS
 - ▒ PR. PAVEMENT
 - ▒ ACB SLOPE PROTECTION (SEE SHEET CD-02)

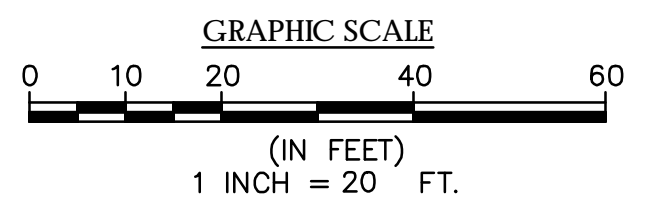

PP-1


DESIGNED: SA	DATE: 3/12/2021	RECORD DRAWING	SCALE	PROJECT		DEPARTMENT OF PUBLIC WORKS AND PLANNING
DRAWN: LS	DATE: 3/12/2021	RESIDENT ENGINEER	AS SHOWN	SAND CREEK BRIDGE REPLACEMENT ON ENNIS ROAD		PLAN AND PROFILE
CHECKED: SA	DATE: 3/12/2021			ROAD NO. 2824-2825 BRIDGE NO. 42C0697, BRLO-5942(238)		ENNIS ROAD STA 9+00.00-13+50.00
FOR RIGHT OF WAY DATA AND ACCURATE ACCESS DETERMINATION, SEE DOCUMENTS IN THE DEPARTMENT OF PUBLIC WORKS AND PLANNING.						DRAWING NO. 11257 SHEET NO. 7 TOTAL 31

THESE PLANS ARE FOR THE CONTRACTOR'S INFORMATION ONLY. THEY ARE NOT TO BE CONSIDERED TO BE PART OF THE CONTRACT DOCUMENTS AND SHALL HAVE NO BEARING WHATSOEVER ON THE INTERPRETATION OF THE STANDARD SPECIFICATIONS, THE STANDARD PLANS, THE SPECIAL PROVISIONS, NOR SHALL THEY HAVE ANY BEARING WHATSOEVER ON THE INTERPRETATION OF THE OTHER PUBLICATIONS REFERENCED THEREIN

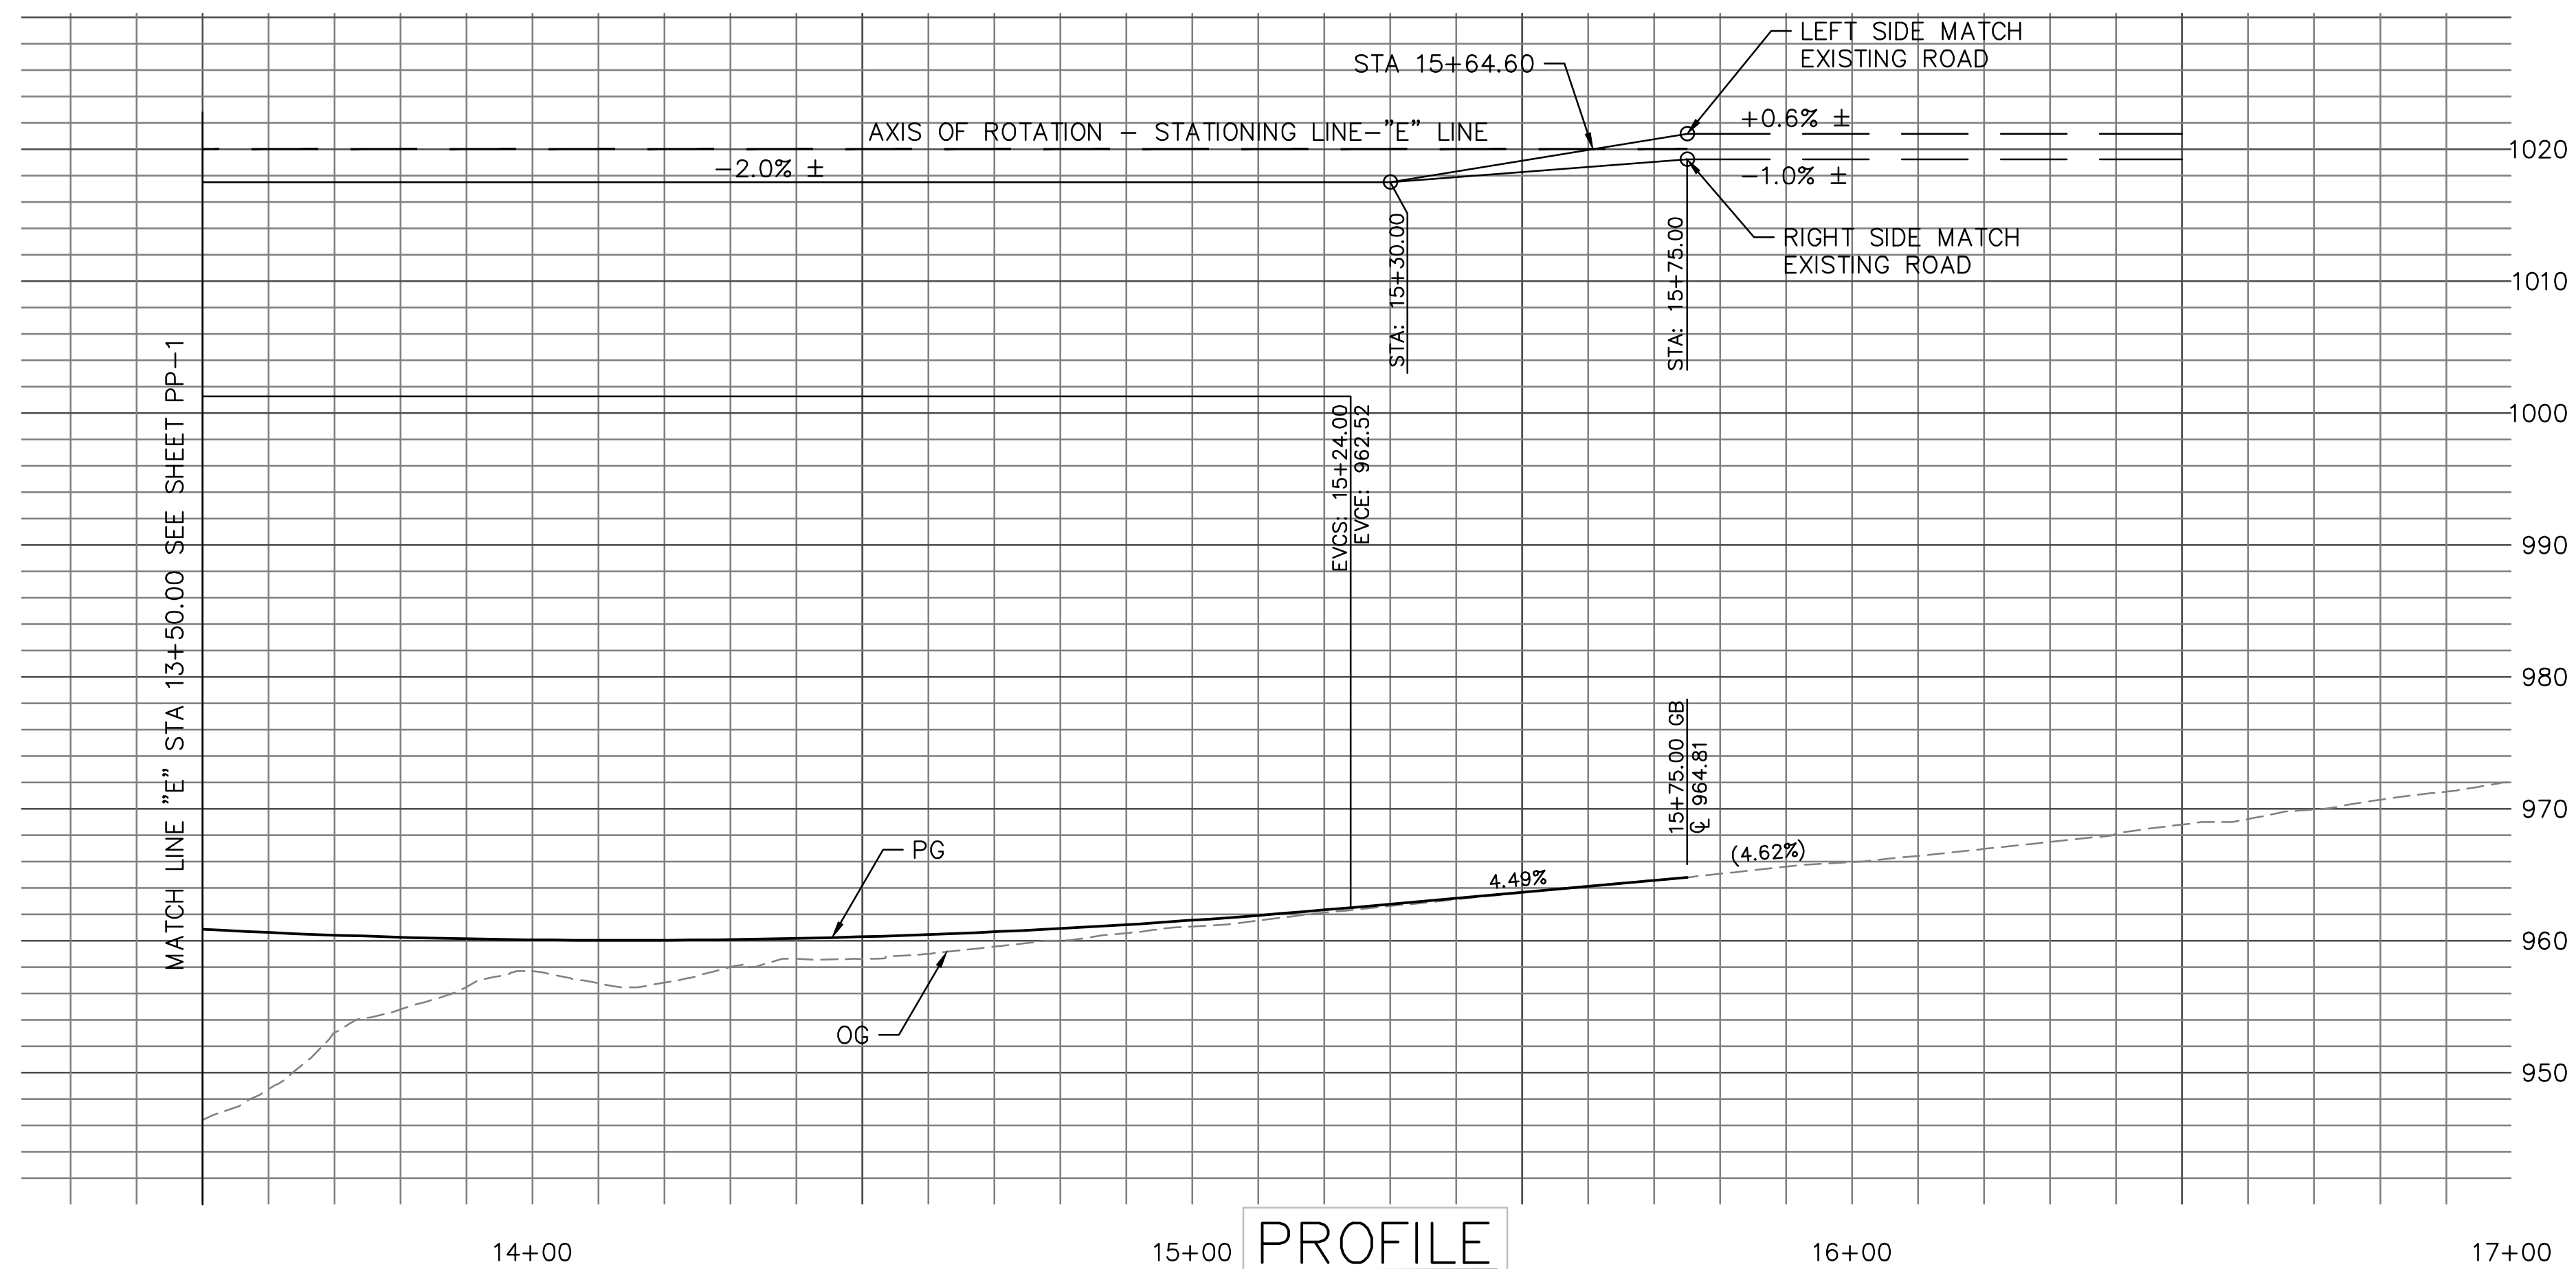

- CONSTRUCTION NOTES:**
- 1 PROTECT IN PLACE UTILITY POLE
 - 2 CONSTRUCT 3" HMA OVER 9" AB
 - 4 CONSTRUCT GUARDRAIL SYSTEM STANDARD RAILING SECTION, PER CALTRANS RSP A77L1 WITH CALTRANS APPROVED 31" IN-LINE TERMINAL END TREATMENT, USING TYPE 12A LAYOUT PER CALTRANS RSP A77Q1
 - 5 CONSTRUCT GUARDRAIL SYSTEM STANDARD RAILING SECTION, PER CALTRANS RSP A77L1 WITH CALTRANS APPROVED 31" IN-LINE TERMINAL END TREATMENT, USING TYPE 12AA LAYOUT PER CALTRANS RSP A77Q4
 - 6 RELOCATE UTILITY POLE AND OVERHEAD LINE (BY OTHERS)
 - 9 INSTALL TRANSITIONAL RAILING TYPE WB-31 PER CALTRANS STD PLAN RSP A77U4
 - 13 INSTALL MUTCD STANDARD TYPE E WHITE RETROREFLECTOR (2-SIDED) GUARDRAIL DELINEATOR; SPACING TO BE EVERY 20 FT
 - 19 CONSTRUCT HOT MIX ASPHALT DIKE TYPE C PER CALTRANS STANDARD PLAN RSP A87B PER PLACEMENT AS INDICATED ON CALTRANS STANDARD PLAN A77N4
 - 21 CONCRETE BARRIER, SEE STRUCTURAL PLANS
 - 22 SAWCUT, MATCH EXISTING
 - 23 INSTALL CLASS III RSP

PROFILE
SCALE: HORIZ 1"=20'
VERT 1"=10'

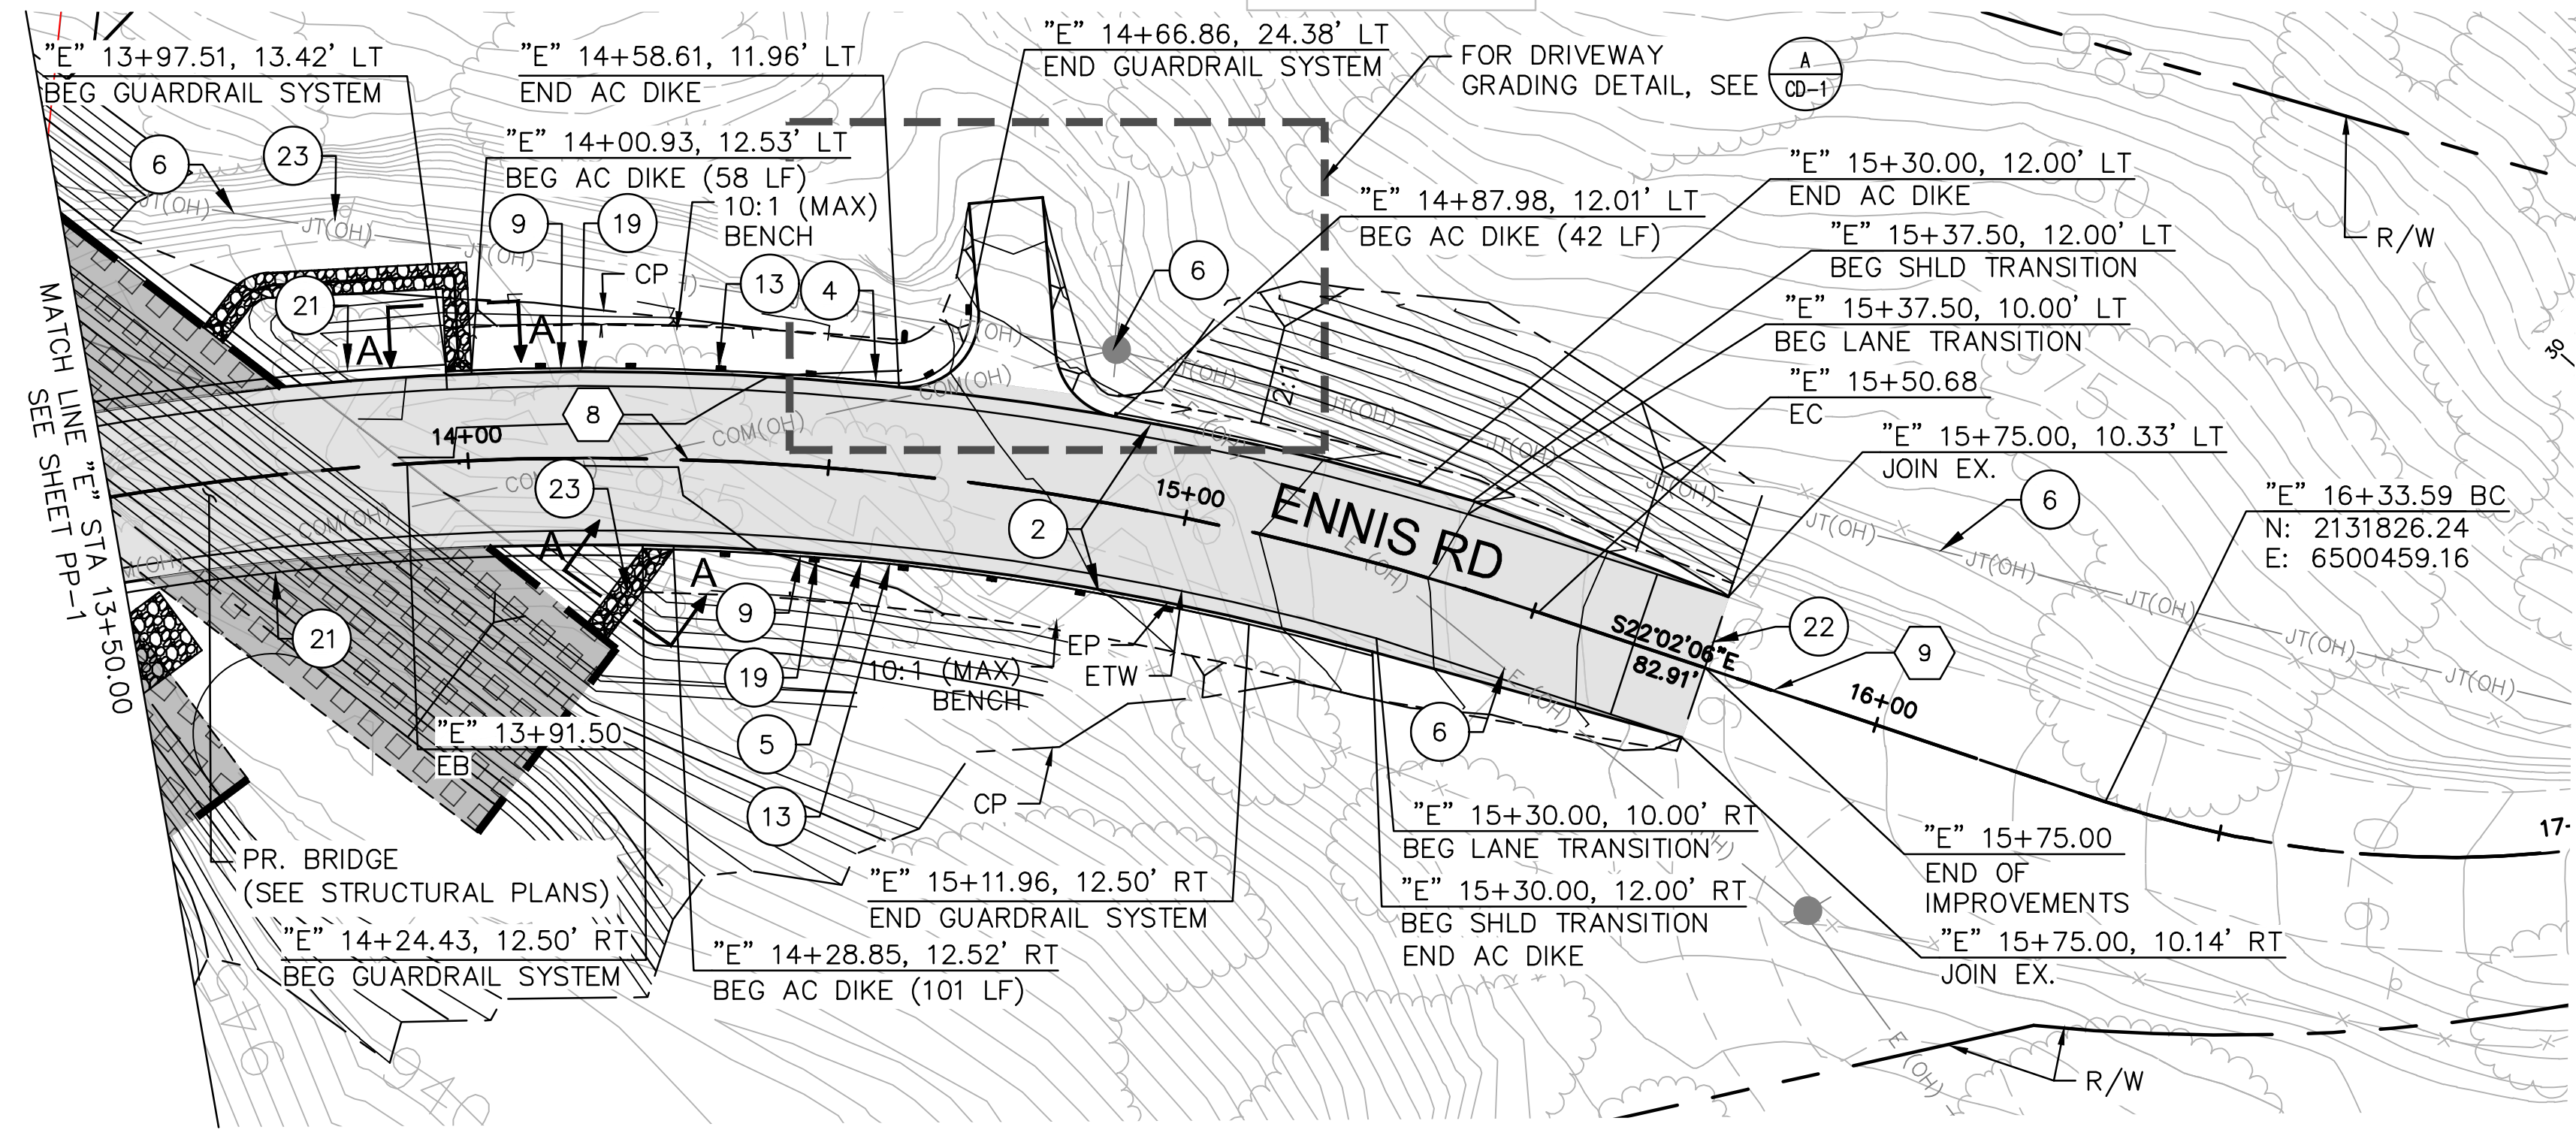



- LEGEND**
- EX. UTILITY POLE
 - E (OH) — EX. OVERHEAD ELECTRICAL
 - R/W
 - - - TCE
 - - - PR. DAYLIGHT
 - - - PR. BENCH
 - - - PR. MGS
 - ▭ PR. PAVEMENT
 - ▨ ACB PROTECTION (SEE SHEET CD-02)

CURVE TABLE

CURVE NO.	LENGTH	RADIUS	DELTA	TANGENT
7	277.43	415.00	038°18'08"	144.12

LINE TABLE


LINE NO.	LENGTH	DIRECTION
8	82.91	S22°02'06"E

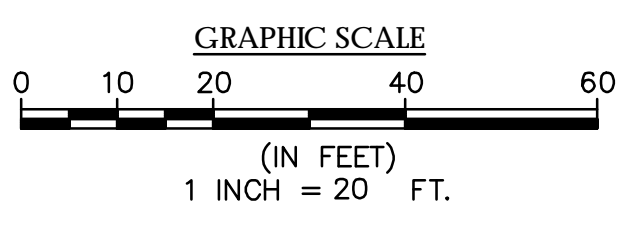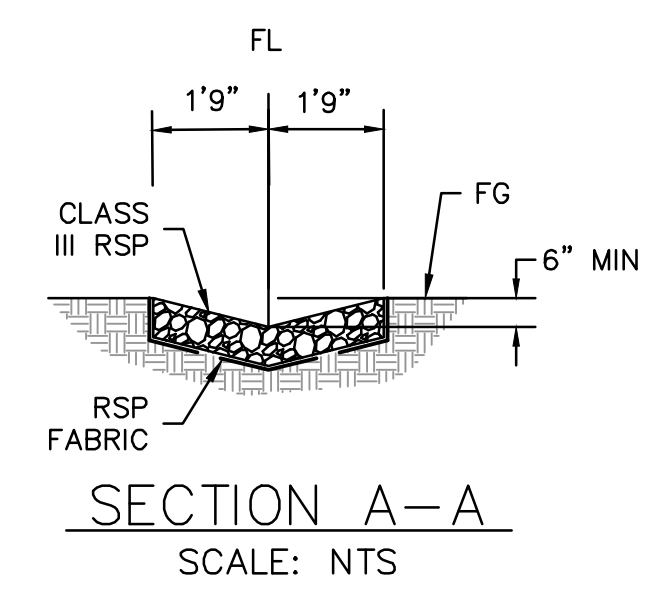

PP-2

DESIGNED: SA		DATE: 3/12/2021	RECORD DRAWING		SCALE	PROJECT			DEPARTMENT OF PUBLIC WORKS AND PLANNING		
DRAWN: LS		3/12/2021	RESIDENT ENGINEER	DATE	AS SHOWN	SAND CREEK BRIDGE REPLACEMENT ON ENNIS ROAD				PLAN AND PROFILE	
CHECKED: SA		3/12/2021				ROAD NO. 2824-2825 BRIDGE NO. 42C0697, BRLO-5942(238)		ENNIS ROAD STA 13+50.00-17+00.00			
FOR RIGHT OF WAY DATA AND ACCURATE ACCESS DETERMINATION, SEE DOCUMENTS IN THE DEPARTMENT OF PUBLIC WORKS AND PLANNING.											
DRAWING NO. 11257 SHEET NO. 8 TOTAL 31											

THESE PLANS ARE FOR THE CONTRACTOR'S INFORMATION ONLY. THEY ARE NOT TO BE CONSIDERED TO BE PART OF THE CONTRACT DOCUMENTS AND SHALL HAVE NO BEARING WHATSOEVER ON THE INTERPRETATION OF THE STANDARD SPECIFICATIONS, THE STANDARD PLANS, THE SPECIAL PROVISIONS, NOR SHALL THEY HAVE ANY BEARING WHATSOEVER ON THE INTERPRETATION OF THE OTHER PUBLICATIONS REFERENCED THEREIN

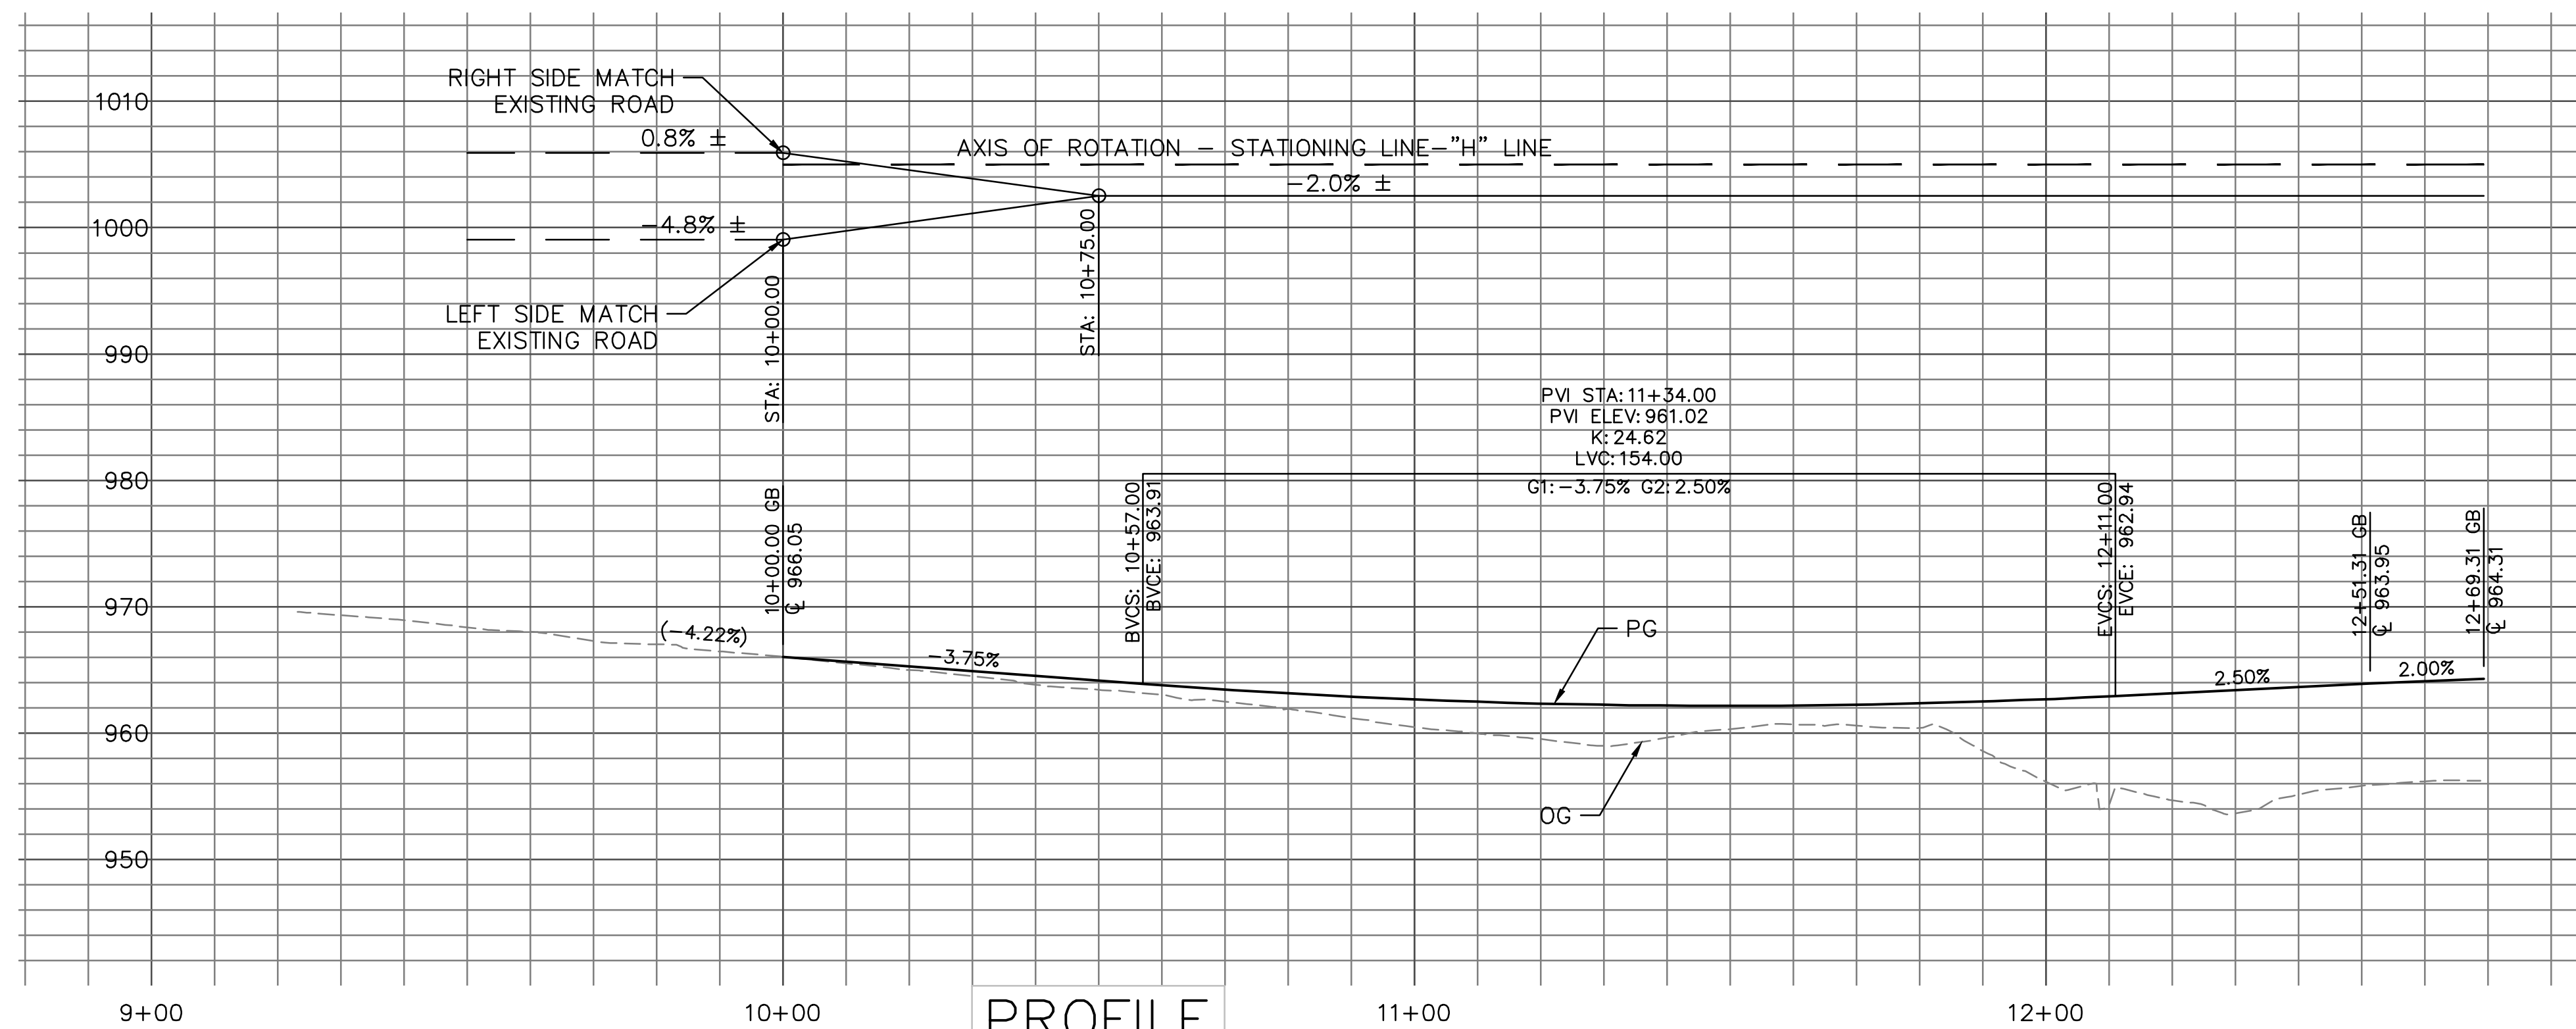


PROFILE
SCALE: HORIZ 1"=20'
VERT 1"=10'


- CONSTRUCTION NOTES:**
- 1 PROTECT IN PLACE UTILITY POLE
 - 2 CONSTRUCT 3" HMA OVER 9" AB
 - 3 PROTECT IN PLACE OVERHEAD LINES
 - 4 CONSTRUCT GUARDRAIL SYSTEM STANDARD RAILING SECTION, PER CALTRANS RSP A77L1 WITH CALTRANS APPROVED 31" IN-LINE TERMINAL END TREATMENT, USING TYPE 12A LAYOUT PER CALTRANS RSP A77Q1
 - 6 RELOCATE UTILITY POLE AND OVERHEAD LINE (BY OTHERS)
 - 8 PROTECT IN PLACE SHED STRUCTURE
 - 13 INSTALL MUTCD STANDARD TYPE E WHITE RETROREFLECTOR (2-SIDED) GUARDRAIL DELINEATOR; SPACING TO BE EVERY 20 FT
 - 19 CONSTRUCT HOT MIX ASPHALT DIKE TYPE C PER CALTRANS STANDARD PLAN RSP A87B PER PLACEMENT AS INDICATED ON CALTRANS STANDARD PLAN A77N4
 - 21 CONCRETE BARRIER, SEE STRUCTURAL PLANS
 - 22 SAWCUT, MATCH EXISTING

CURVE TABLE				
CURVE NO.	LENGTH	RADIUS	DELTA	TANGENT
10	188.68	220.00	049°08'18"	100.58

LINE TABLE		
LINE NO.	LENGTH	DIRECTION
11	112.58	N79°16'43"E
12	44.33	N30°08'25"E

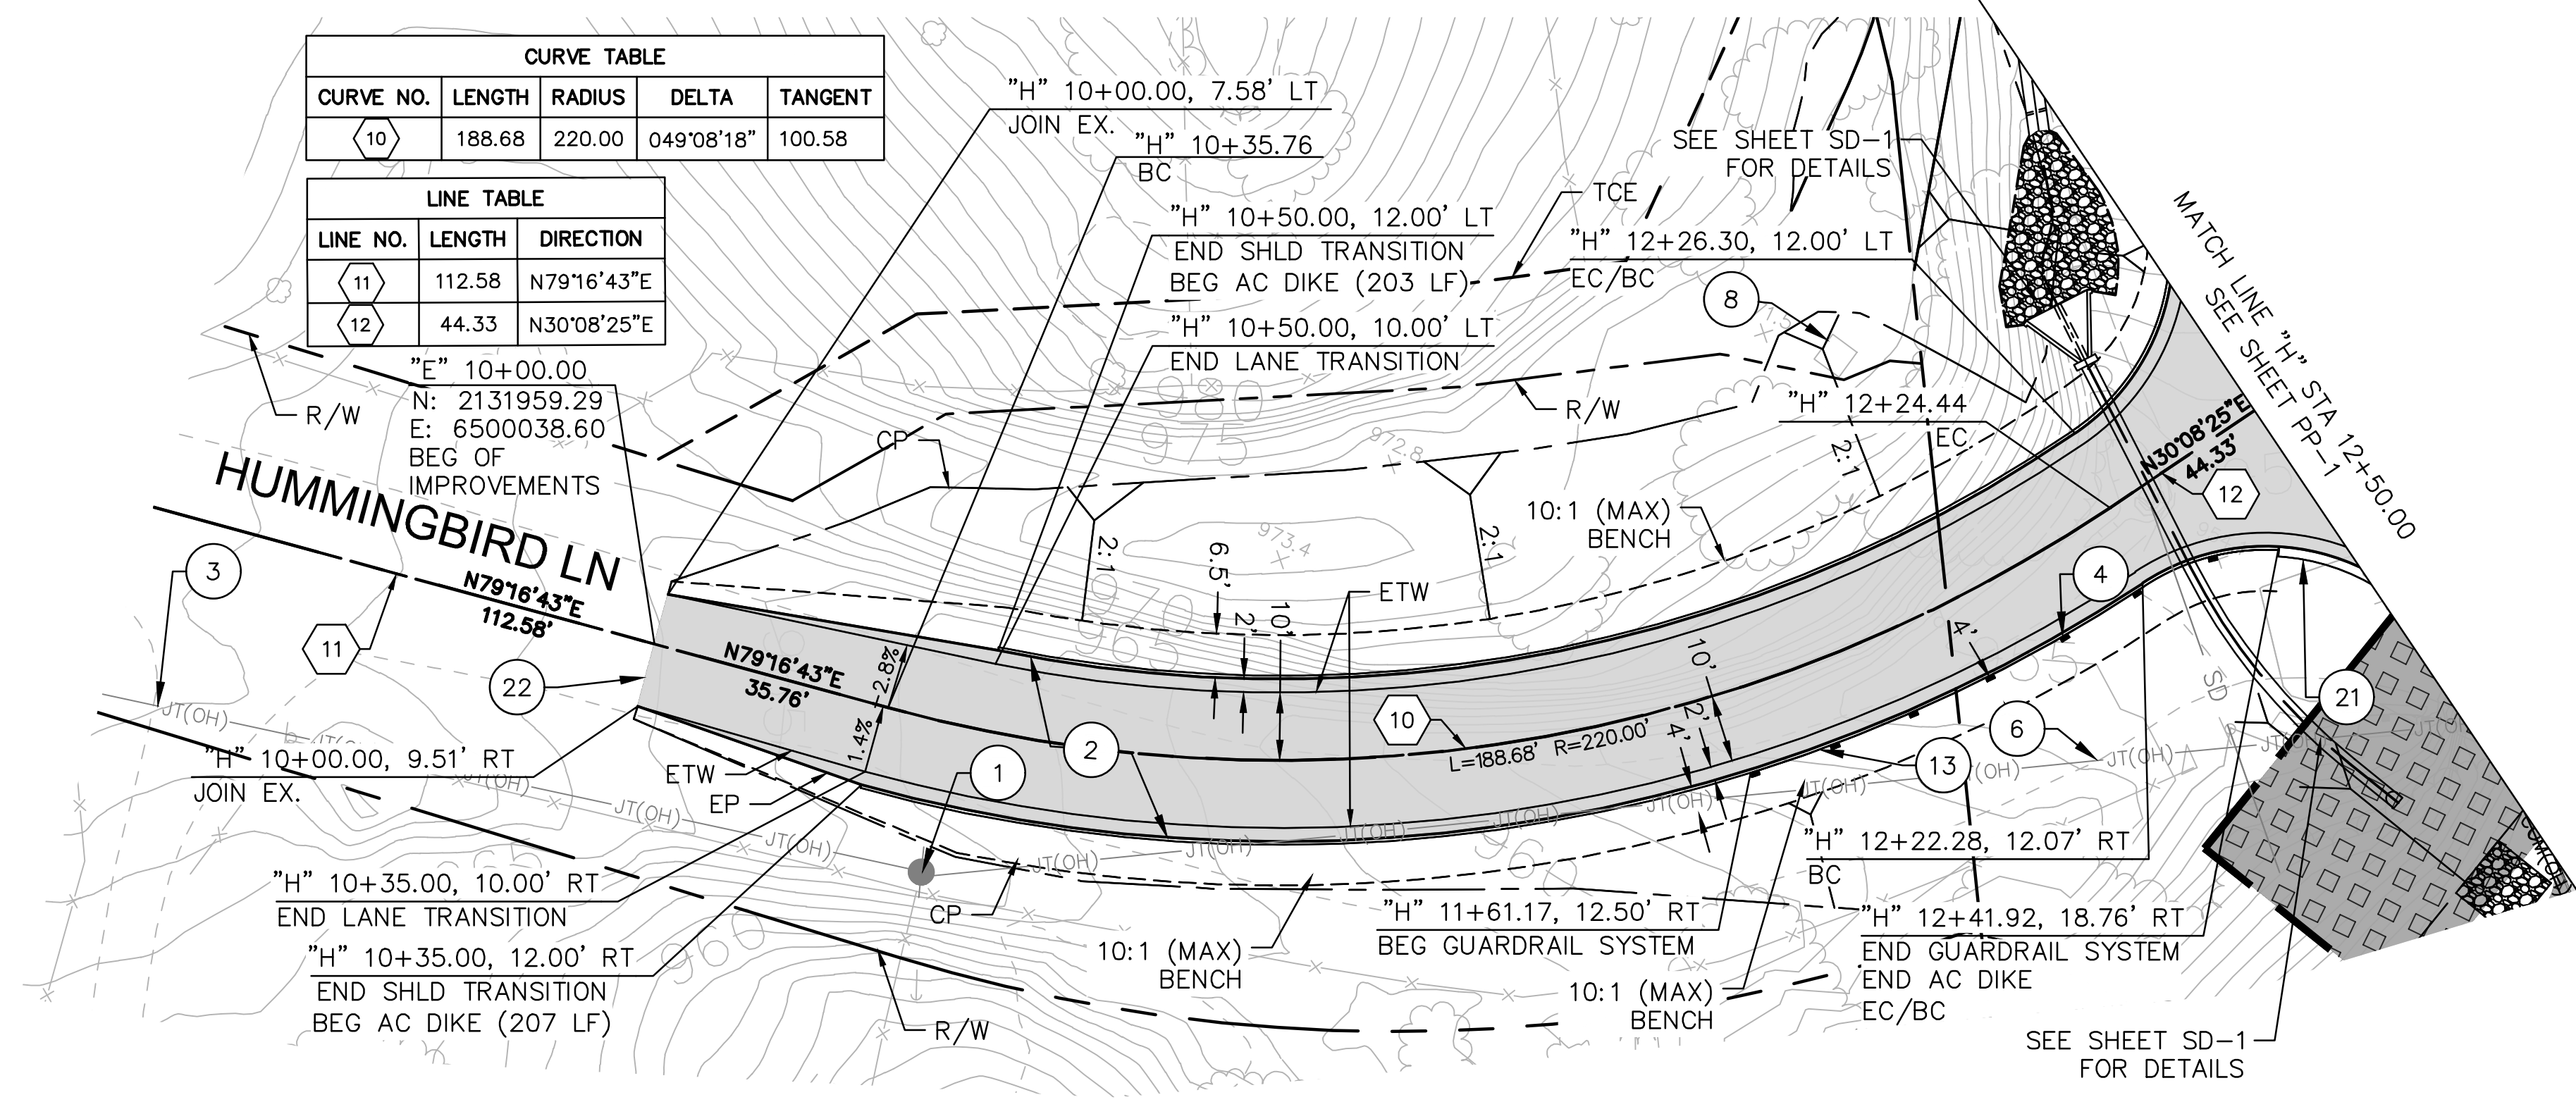

- LEGEND**
- EX. UTILITY POLE
 - E (OH) — EX. OVERHEAD ELECTRICAL
 - R/W — R/W
 - - - TCE
 - - - PR. DAYLIGHT
 - - - PR. BENCH
 - - - PR. MGS
 - ▨ PR. PAVEMENT
 - ▨ ACB SLOPE PROTECTION (SEE SHEET CD-02)

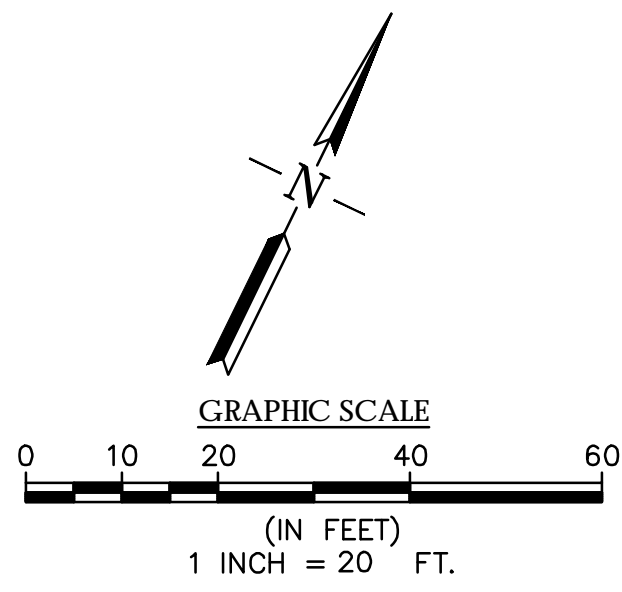

PP-3

DESIGNED: SA	DATE: 3/12/2021	RECORD DRAWING	SCALE	PROJECT		DEPARTMENT OF PUBLIC WORKS AND PLANNING
DRAWN: LS	DATE: 3/12/2021	RESIDENT ENGINEER	AS SHOWN	SAND CREEK BRIDGE REPLACEMENT ON ENNIS ROAD		PLAN AND PROFILE
CHECKED: SA	DATE: 3/12/2021			ROAD NO. 2824-2825 BRIDGE NO. 42C0697, BRLO-5942(238)		HUMMINGBIRD LANE STA 10+00.00-12+25.00
FOR RIGHT OF WAY DATA AND ACCURATE ACCESS DETERMINATION, SEE DOCUMENTS IN THE DEPARTMENT OF PUBLIC WORKS AND PLANNING.						DRAWING NO. 11257 SHEET NO. 9 TOTAL 31



THESE PLANS ARE FOR THE CONTRACTOR'S INFORMATION ONLY. THEY ARE NOT TO BE CONSIDERED TO BE PART OF THE CONTRACT DOCUMENTS AND SHALL HAVE NO BEARING WHATSOEVER ON THE INTERPRETATION OF THE STANDARD SPECIFICATIONS, THE STANDARD PLANS, THE SPECIAL PROVISIONS, NOR SHALL THEY HAVE ANY BEARING WHATSOEVER ON THE INTERPRETATION OF THE OTHER PUBLICATIONS REFERENCED THEREIN

CONSTRUCTION NOTES:

- 10 INSTALL PIPE CULVERT WARPED WING WALL (W=1') PER CALTRANS STD PLAN D86B
- 11 INSTALL 24" RSP CULVERT PER CALTRANS STD PLAN A62D
- 23 INSTALL CLASS III RSP
- 24 INSTALL 10'X10' CLASS V RSP CENTERED ON PIPE AT TOE OF SLOPE
- 25 CONSTRUCT CONCRETE LINED V-DITCH, SEE DETAIL 2 ON THIS SHEET FOR DIMENSIONS
- 26 CONSTRUCT DIP CROSSING
- 27 CONSTRUCT SPLASH WALL

LEGEND

- R/W
- TCE
- PR. DAYLIGHT
- PR. BENCH
- PR. MGS
- PR. PAVEMENT
- ACB SLOPE PROTECTION (SEE SHEET CD-02)
- ROCK SLOPE PROTECTION

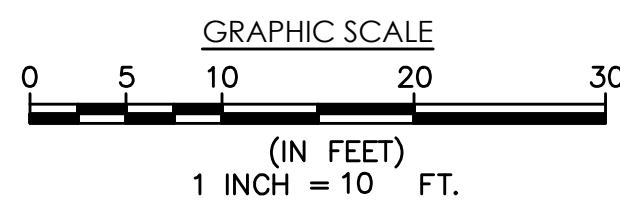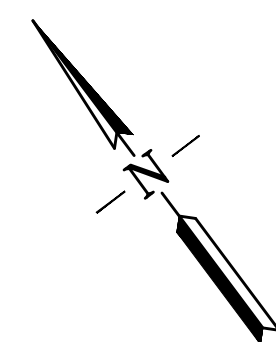


PROFILE

SCALE: HORIZ 1"=10'
VERT 1"=4'


LINE NO.	LENGTH	DIRECTION
1	19.67	N52°59'06"W
2	12.25	N20°26'02"W
3	12.95	S74°18'59"W
4	31.23	N33°55'21"W
5	33.42	S52°59'06"E
6	9.14	S77°01'51"E

CURVE NO.	LENGTH	RADIUS	DELTA
7	37.77	90.00	024°02'45"
8	7.51	6.00	071°45'40"
9	3.69	6.50	032°33'04"

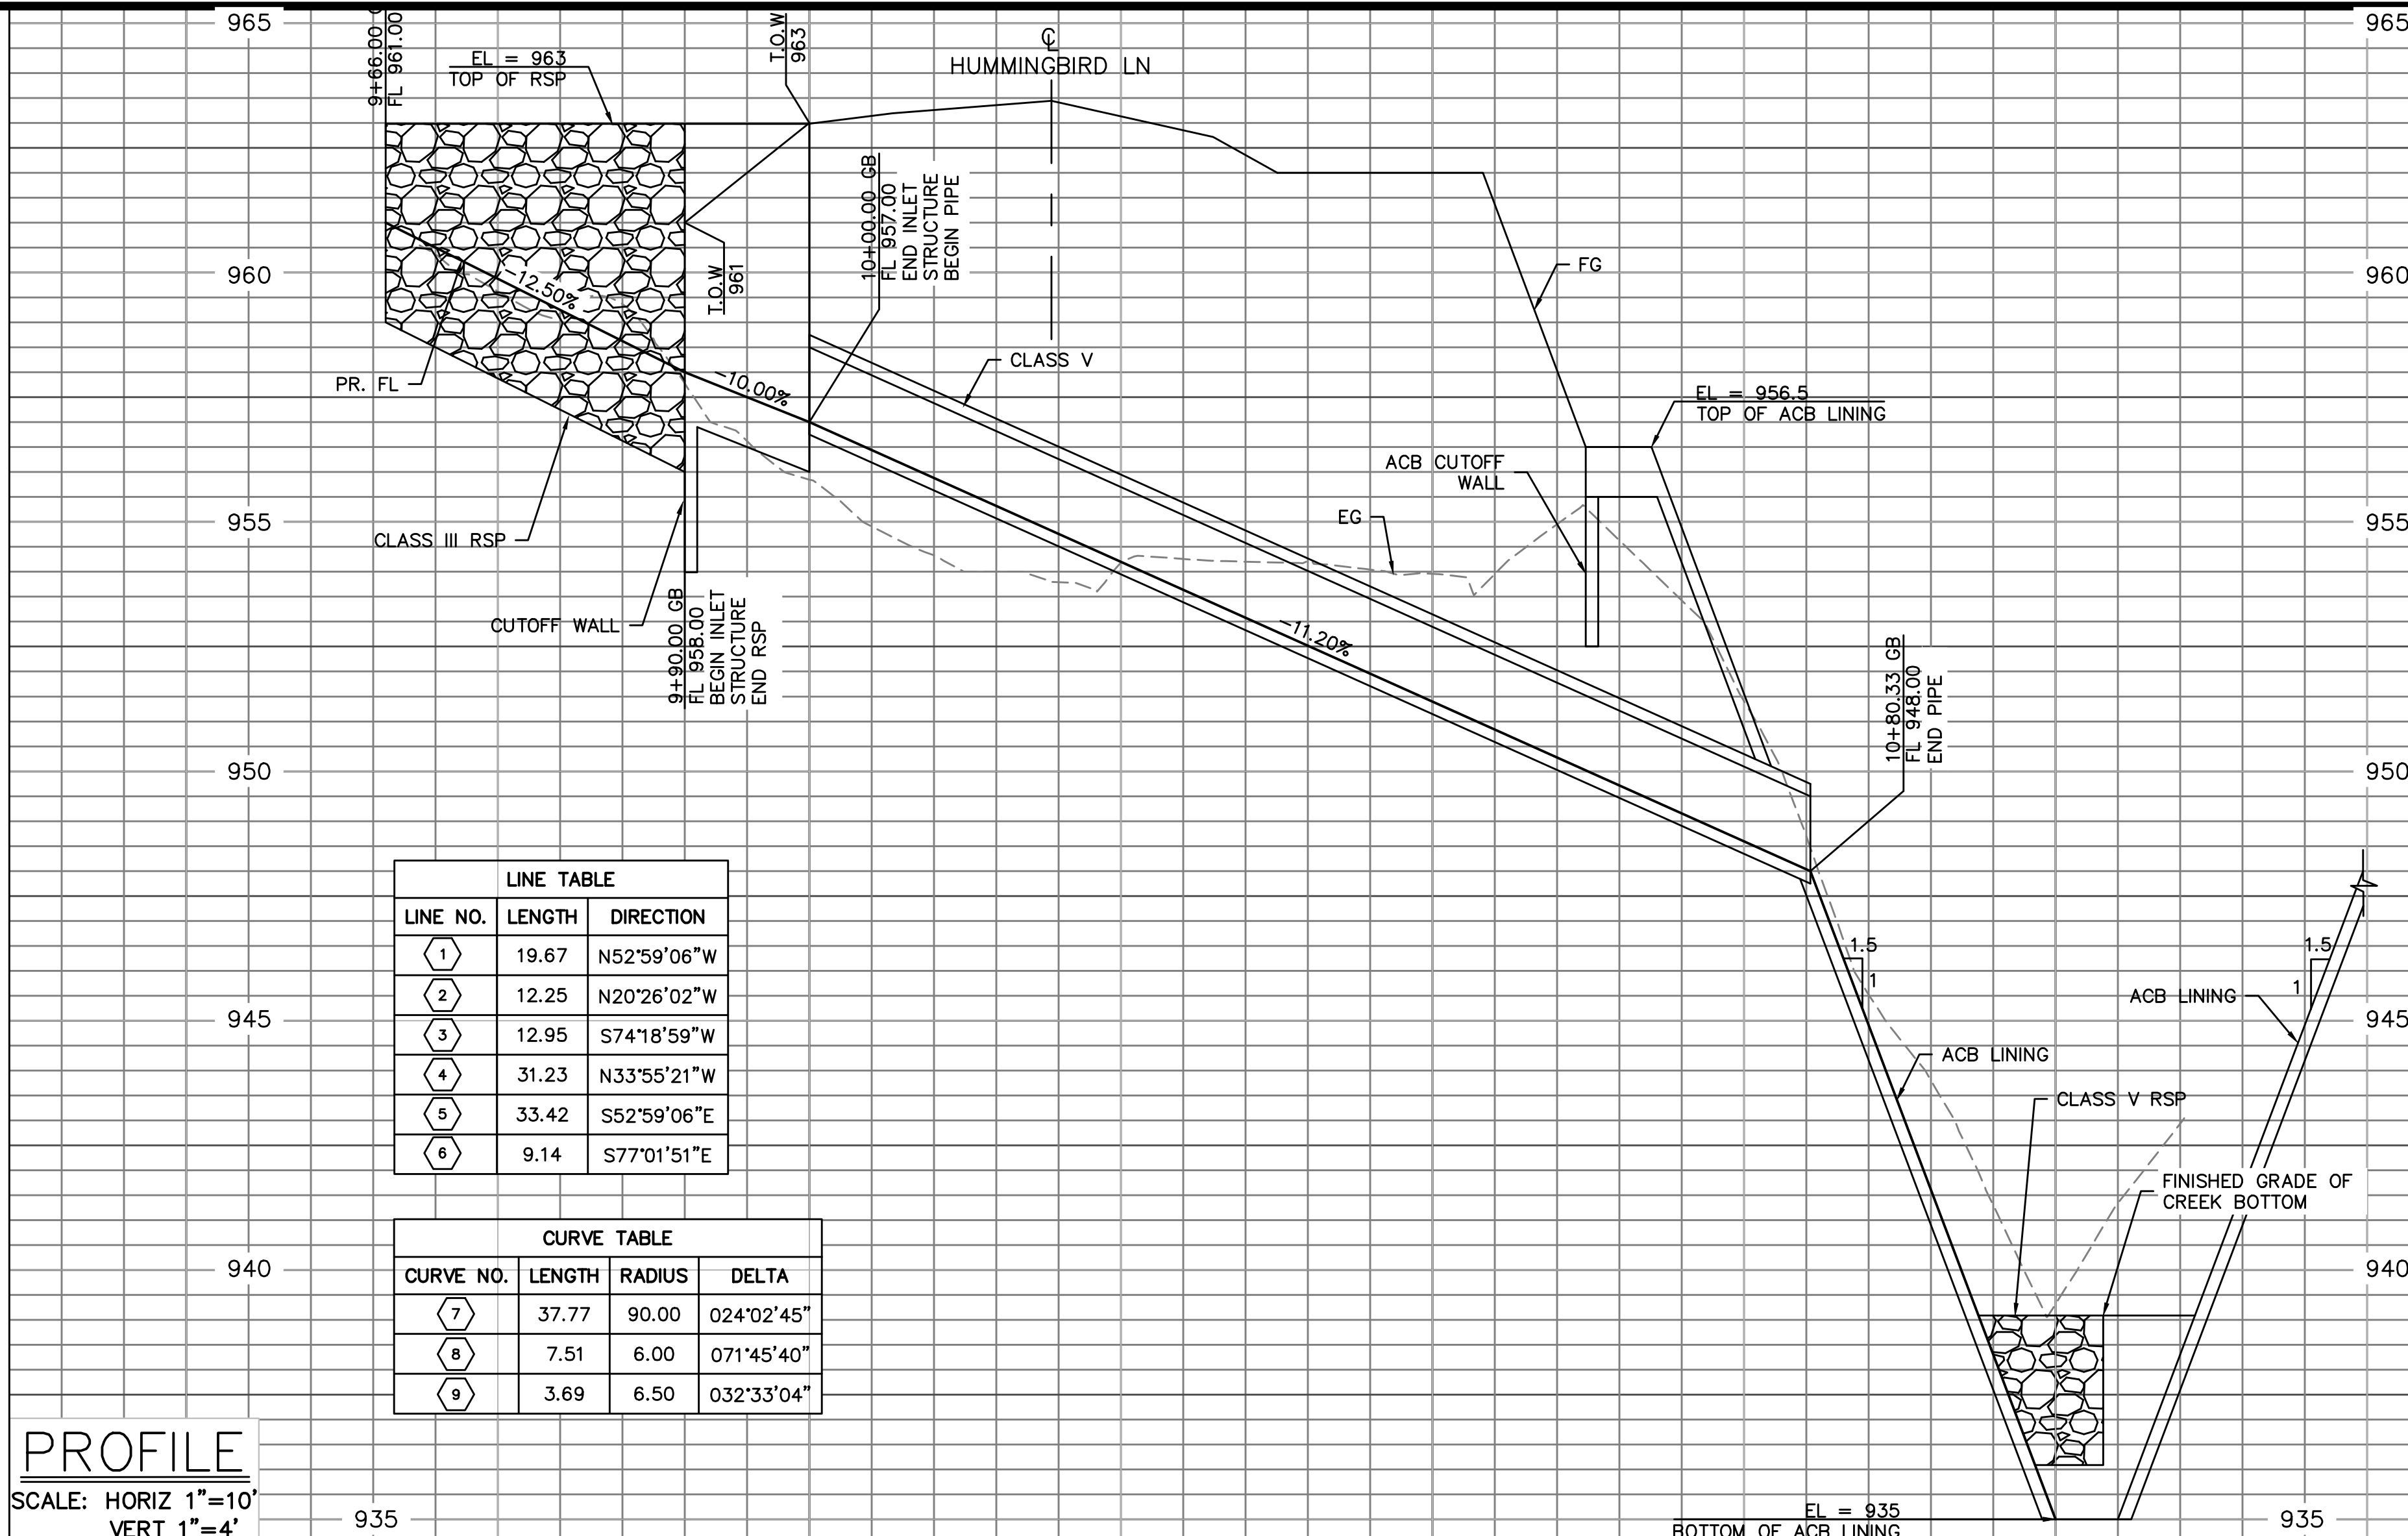

1 PIPE INTERCEPT DETAIL



SCALE: N.T.S.

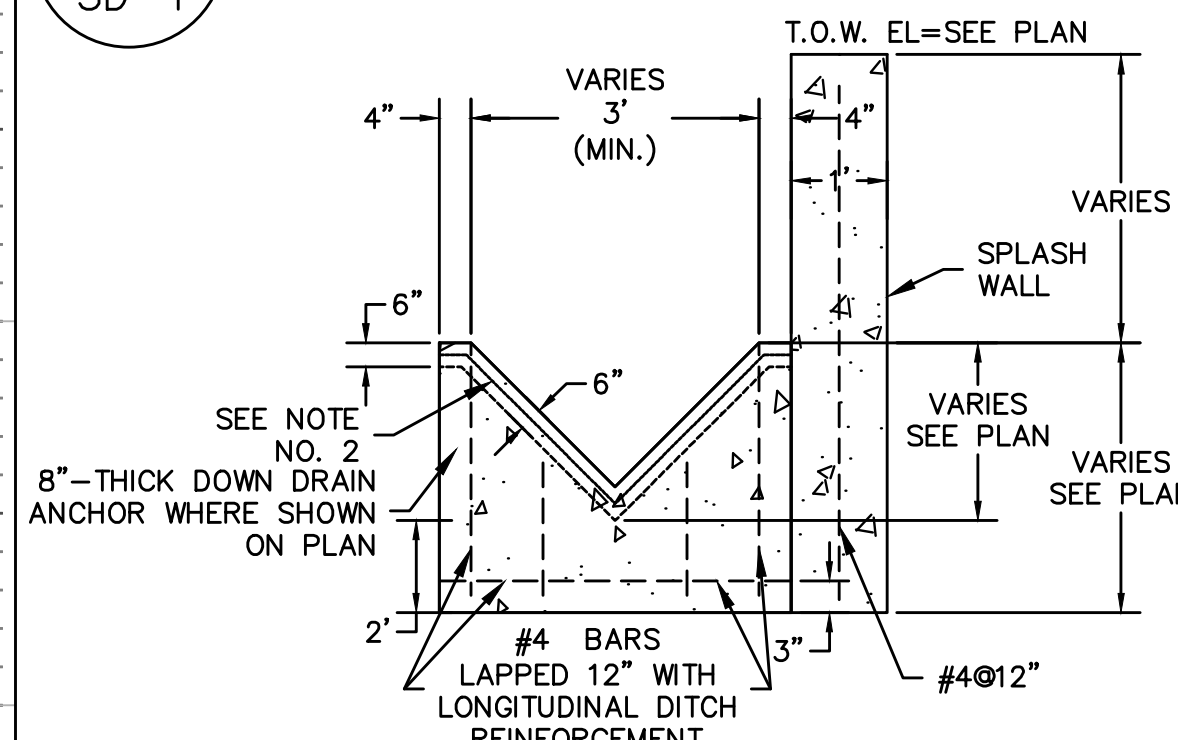

- NOTES:**
- CONCRETE SHALL HAVE A MINIMUM ULTIMATE COMPRESSIVE STRENGTH AT 28 DAYS OF 2500 PSI. CONCRETE MAY BE PNEUMATICALLY PLACED AND SHALL CONFORM TO SECTION 1924 OF THE UNIFORM BUILDING CODE.
 - REINFORCING SHALL BE 6"x6" - W1.4 X W1.4 WELDED WIRE MESH (W.W.M.) OR APPROVED EQUAL.
 - GROUNDING SHALL BE PRE-WETTED TO THE SATISFACTION OF THE ENGINEER PRIOR TO PLACEMENT OF CONCRETE. MOISTURE LOSS RETARDANT SHALL BE USED WHEN REQUIRED BY THE ENGINEER.

2 V-DITCH DETAIL


SCALE: N.T.S.

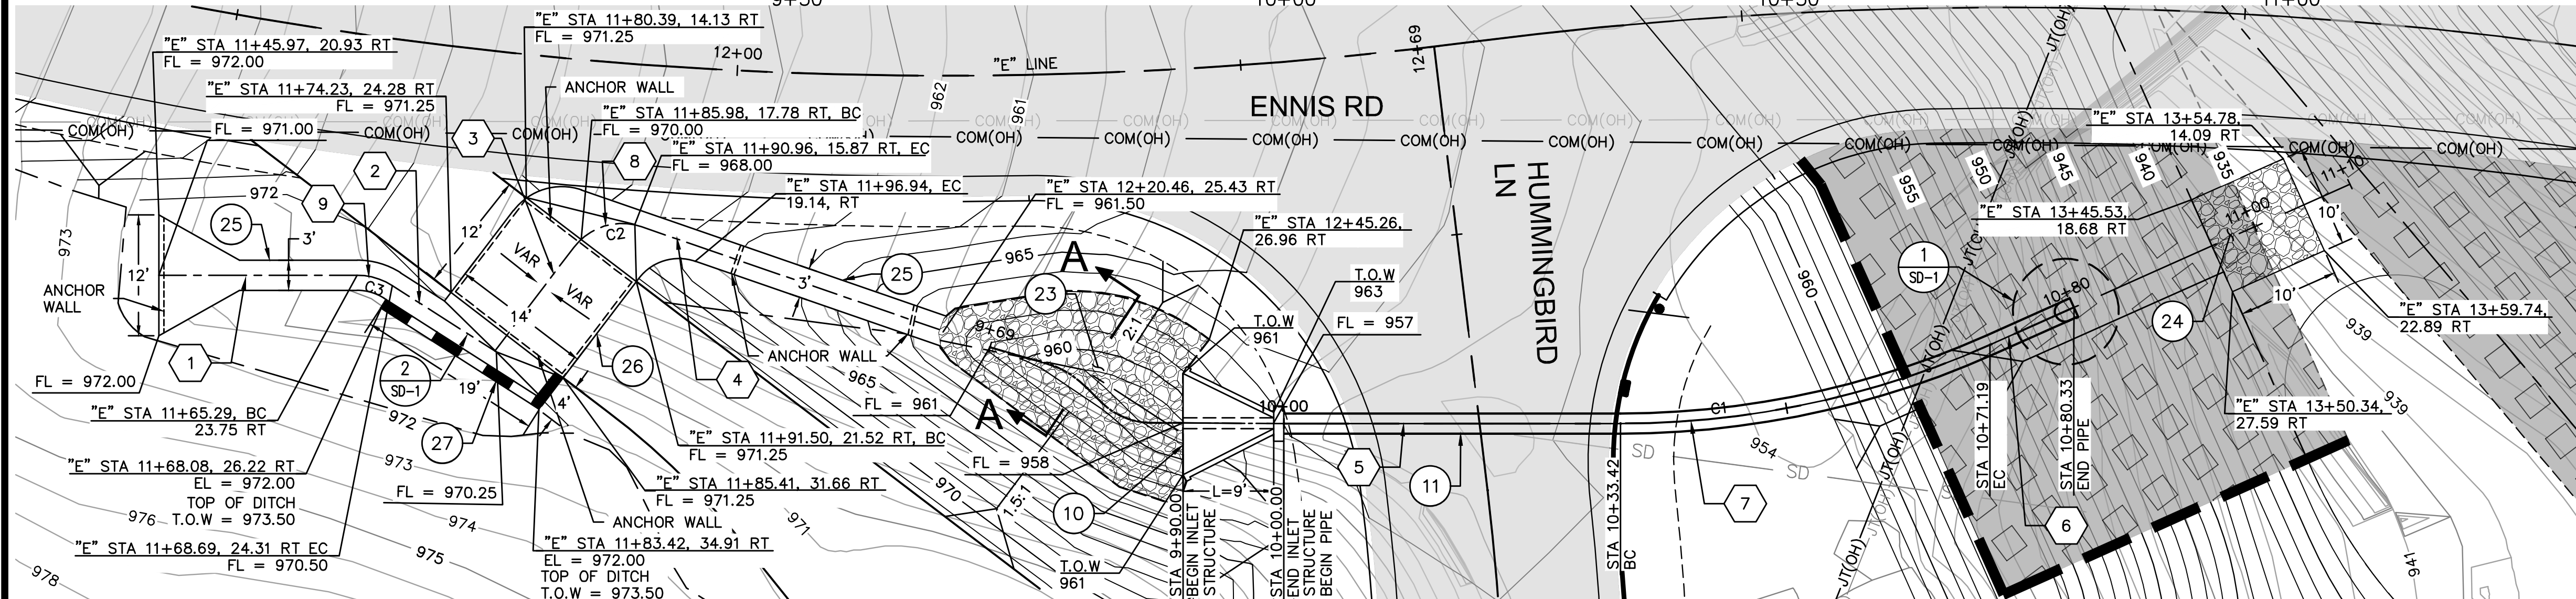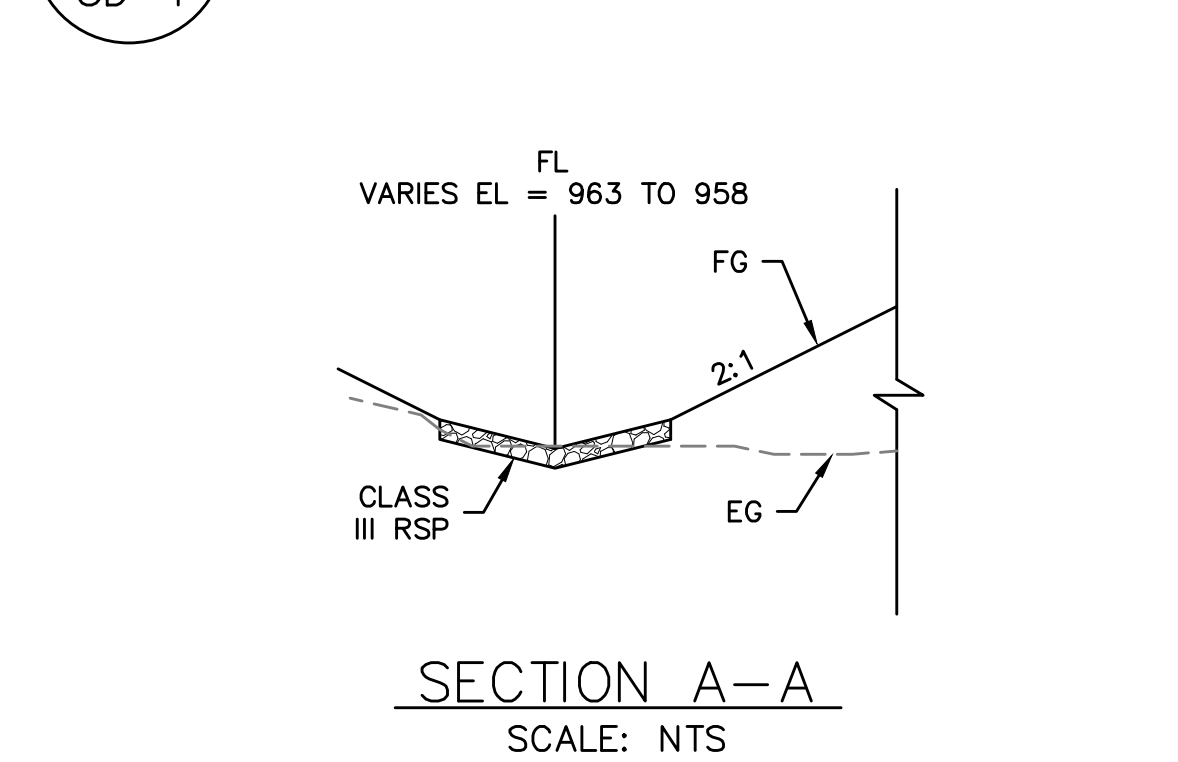


DATE	RECORD DRAWING	SCALE
DESIGNED: SA DV 3/12/2021	RESIDENT ENGINEER	DATE
DRAWN: LS 3/12/2021		
CHECKED: DV 3/12/2021		

PROJECT
SAND CREEK BRIDGE REPLACEMENT ON ENNIS ROAD
ROAD NO. 2824-2825 BRIDGE NO. 42C0697, BRLO-5942(238)


DEPARTMENT OF PUBLIC WORKS AND PLANNING
STORM DRAIN PLAN AND PROFILE
DRAWING NO. 11257 SHEET NO. 10 TOTAL 31

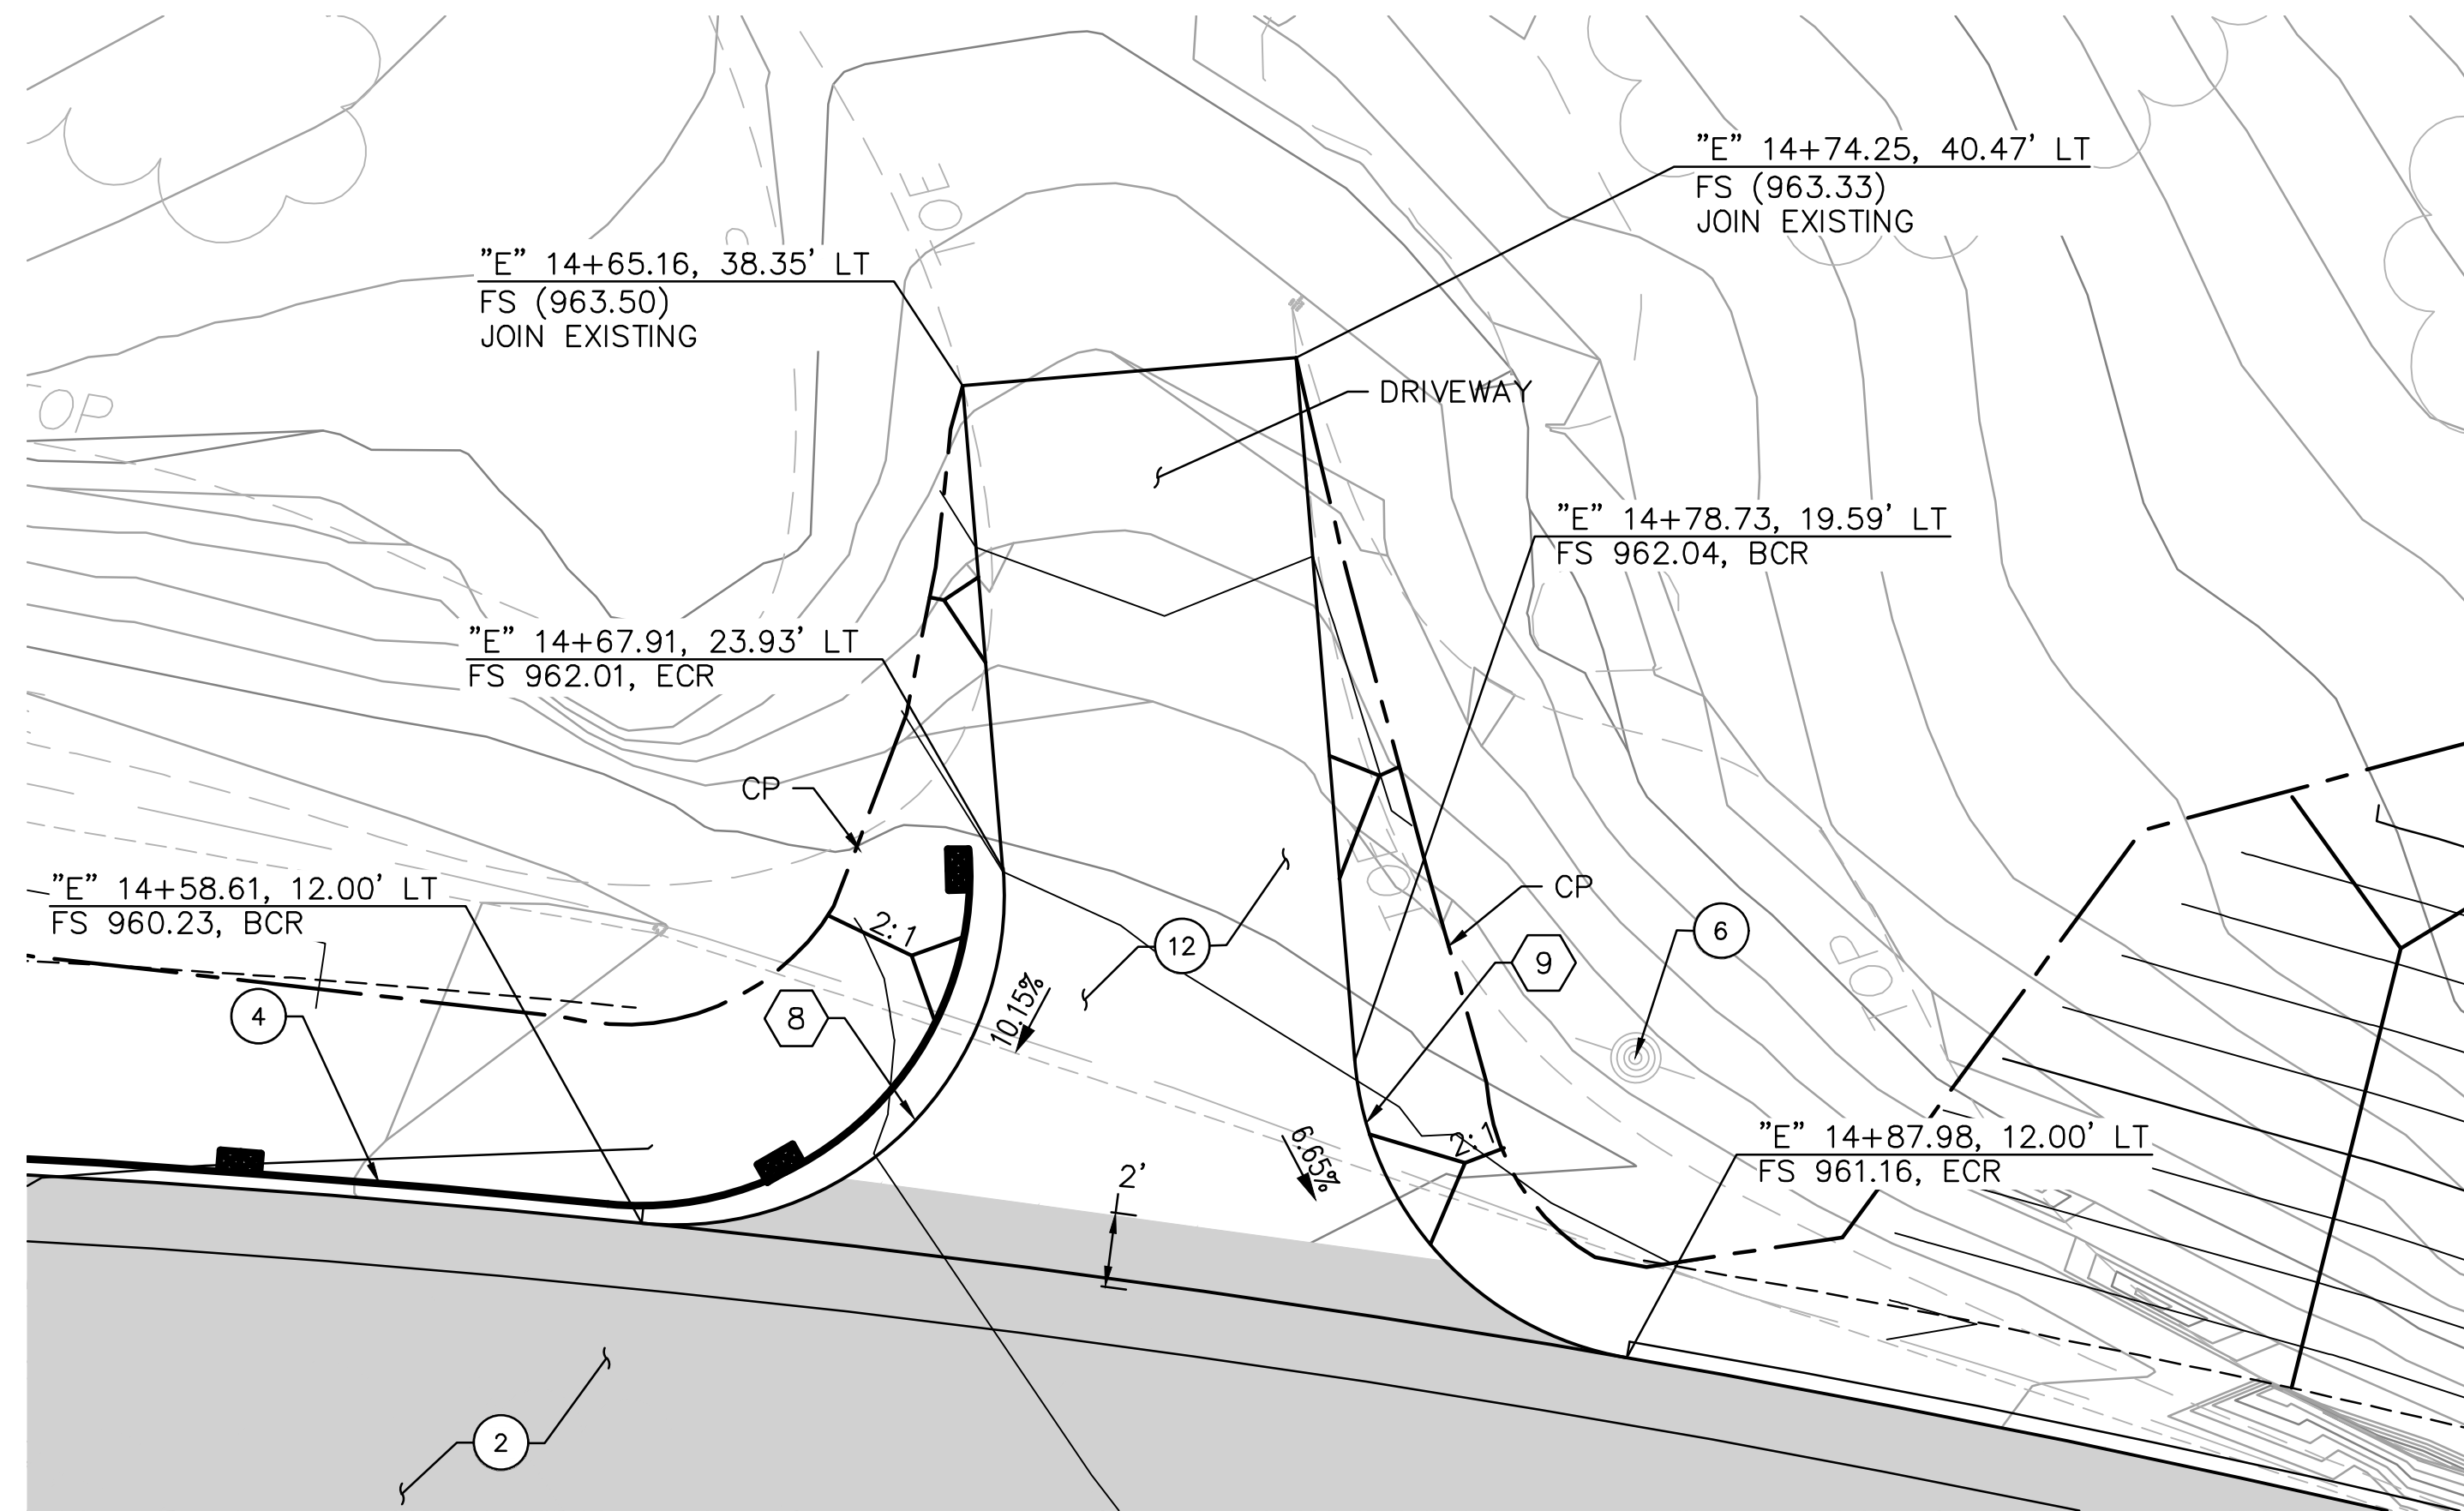

A DRIVEWAY GRADING DETAIL
CD-1
SCALE: 1"=5'

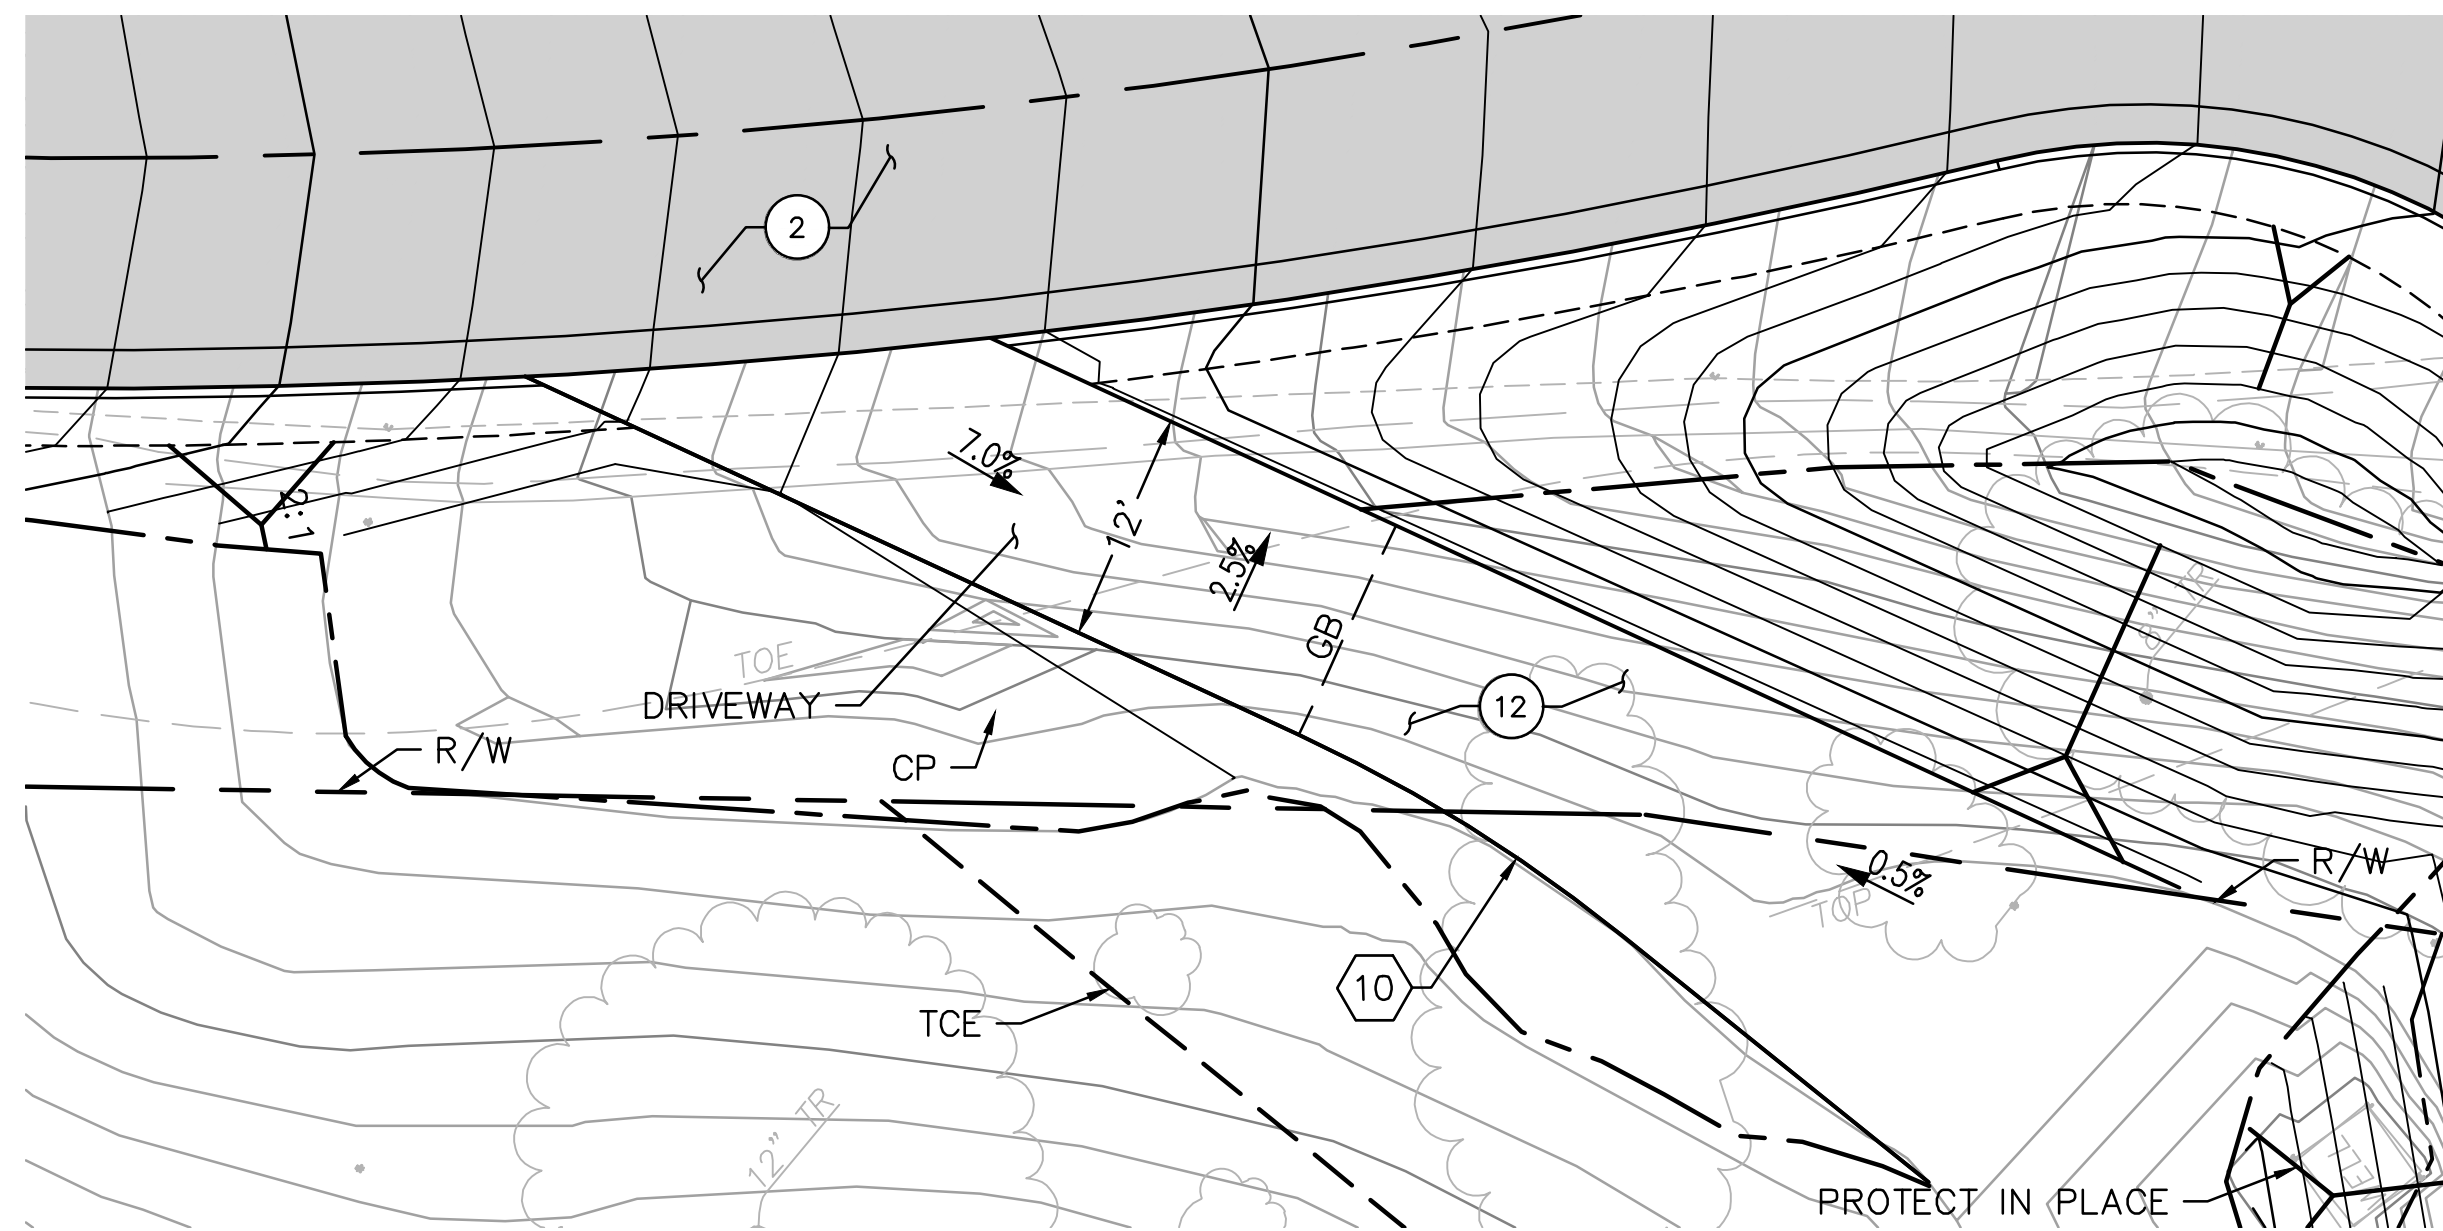

B ACCESS ROAD GRADING DETAIL
CD-1
SCALE: 1"=10'

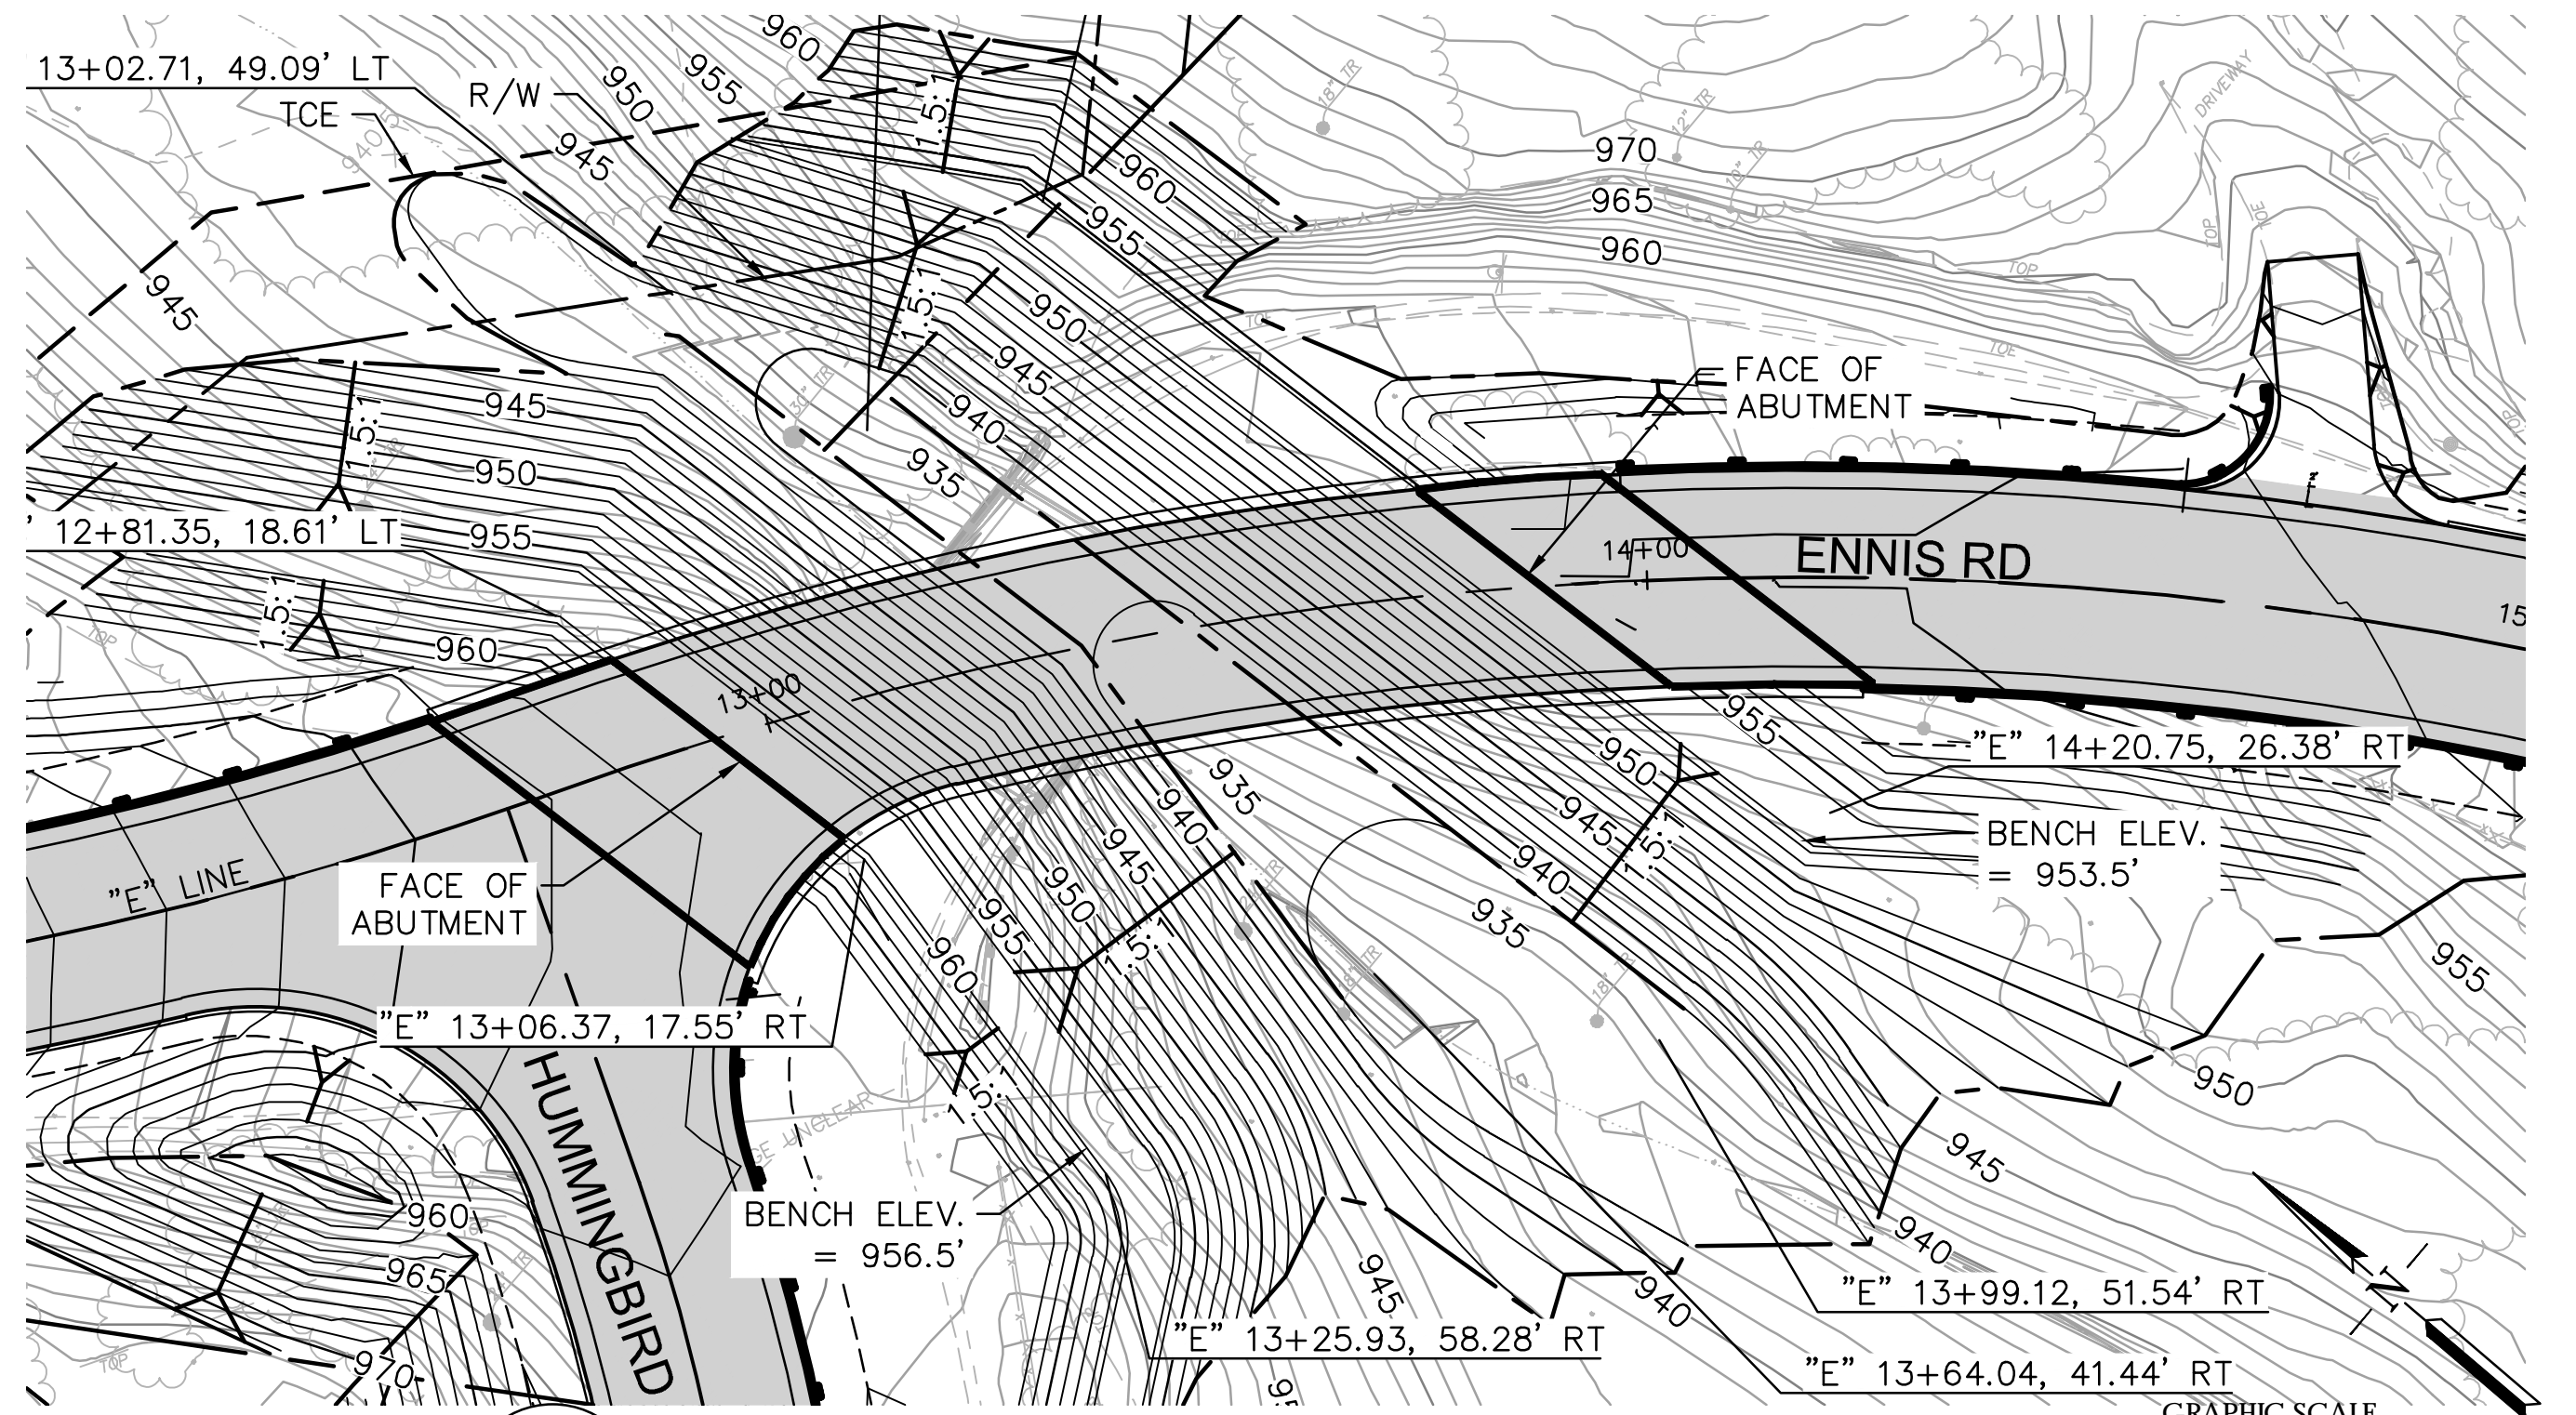

C SLOPE AND CREEK GRADING DETAIL
CD-1
SCALE: 1"=20'

*NOTE: GRADING DEPICTS SURFACE OF ACB WHERE APPLIED




CURVE TABLE			
CURVE NO.	LENGTH	RADIUS	DELTA
8	17.54	10.00	100°30'28"
9	13.17	10.00	075°26'17"
10	19.98	80.00	014°18'30"

CONSTRUCTION NOTES:

- ② CONSTRUCT 3" HMA OVER 9" AB
- ④ CONSTRUCT GUARDRAIL SYSTEM STANDARD RAILING SECTION, PER CALTRANS RSP A77L1 WITH CALTRANS APPROVED 31" IN-LINE TERMINAL END TREATMENT, USING TYPE 12A LAYOUT PER CALTRANS RSP A77Q1
- ⑥ RELOCATE UTILITY POLE AND OVERHEAD LINE (BY OTHERS)
- ⑫ CONSTRUCT 10" CLASS II AGGREGATE BASE






LEGEND

- R/W
- - - - PR. TCE
- PR. DAYLIGHT
- PR. BENCH
- - - - PR. CUT OFF WALL
- PR. MGS
- PR. PAVEMENT

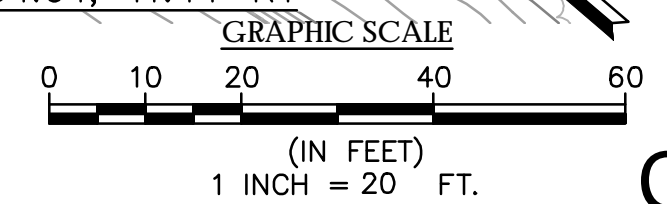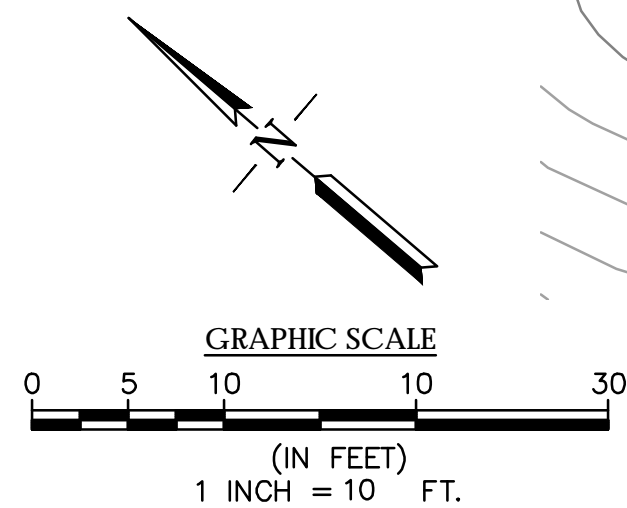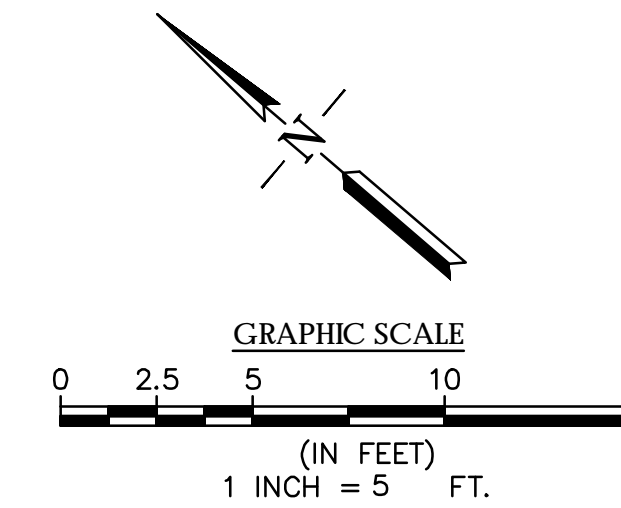


CD-1

DESIGNED: SA		DATE	RECORD DRAWING		SCALE	PROJECT			DEPARTMENT OF PUBLIC WORKS AND PLANNING	
DRAWN: LS		3/12/2021	RESIDENT ENGINEER	DATE	AS SHOWN	SAND CREEK BRIDGE REPLACEMENT ON ENNIS ROAD			CONSTRUCTION DETAILS	
CHECKED: SA		3/12/2021				ROAD NO. 2824-2825	BRIDGE NO. 42C0697, BRLO-5942(238)		DRAWING NO. 11257	SHEET NO. 11

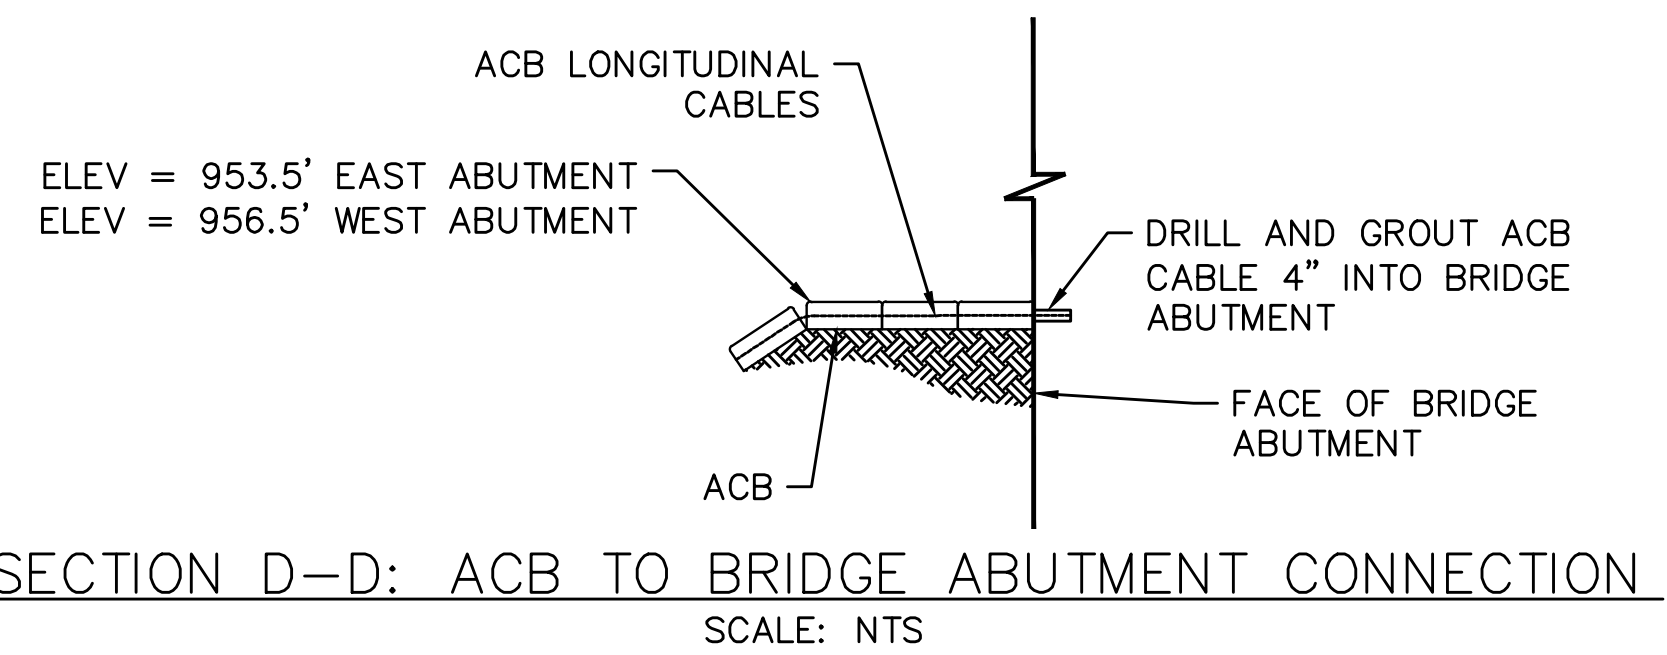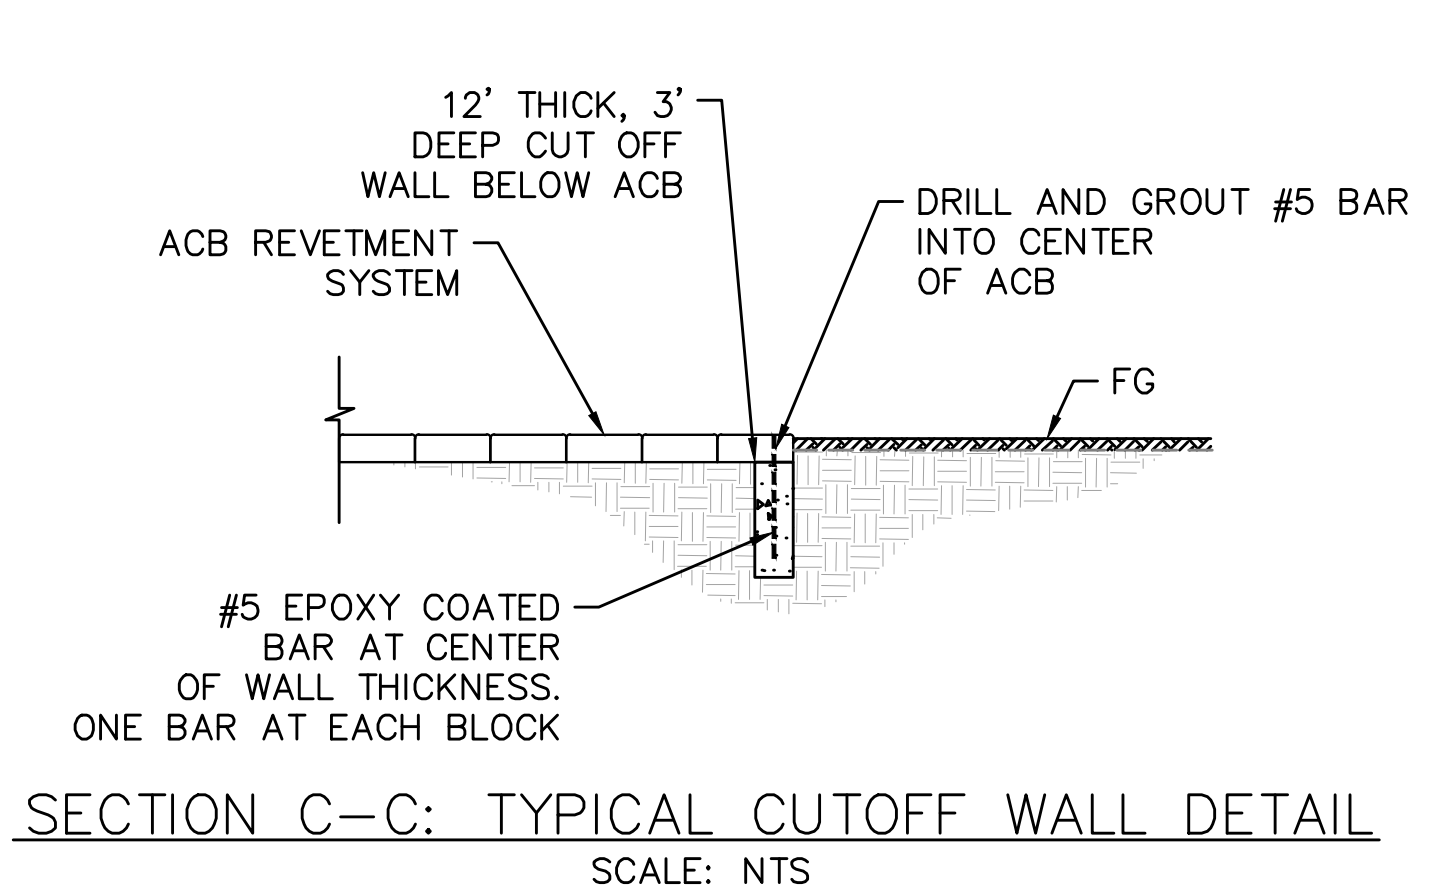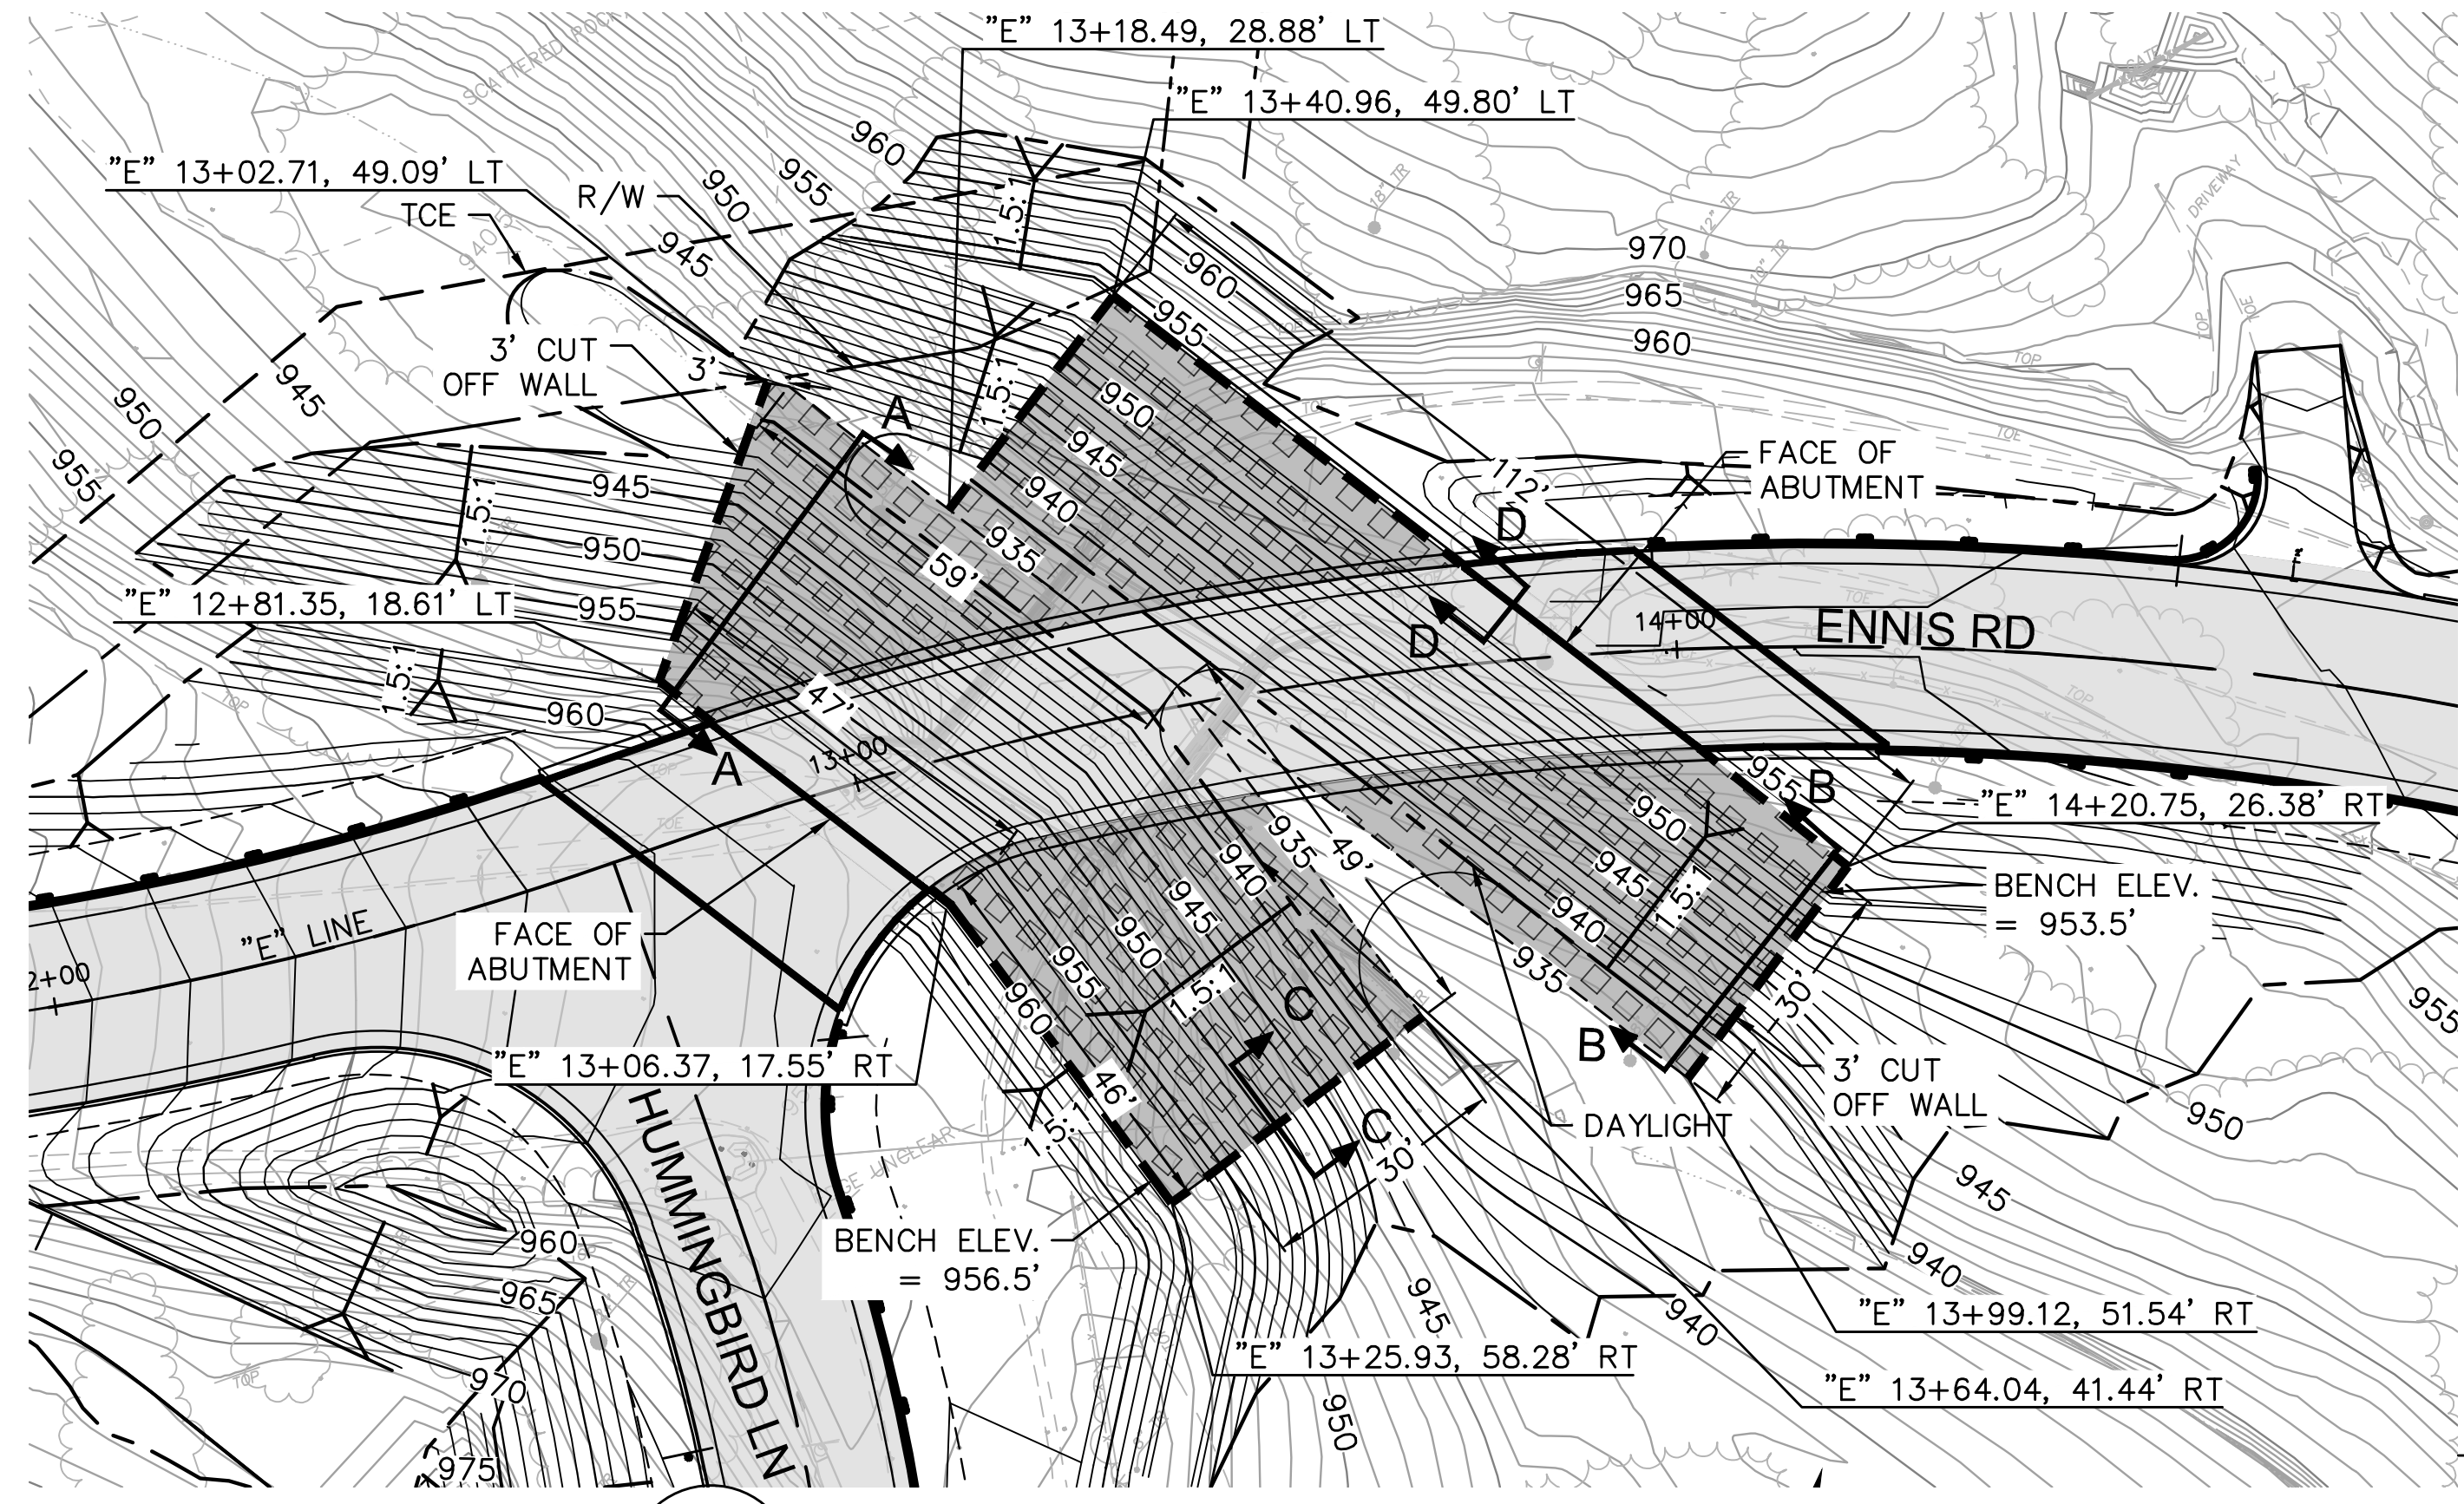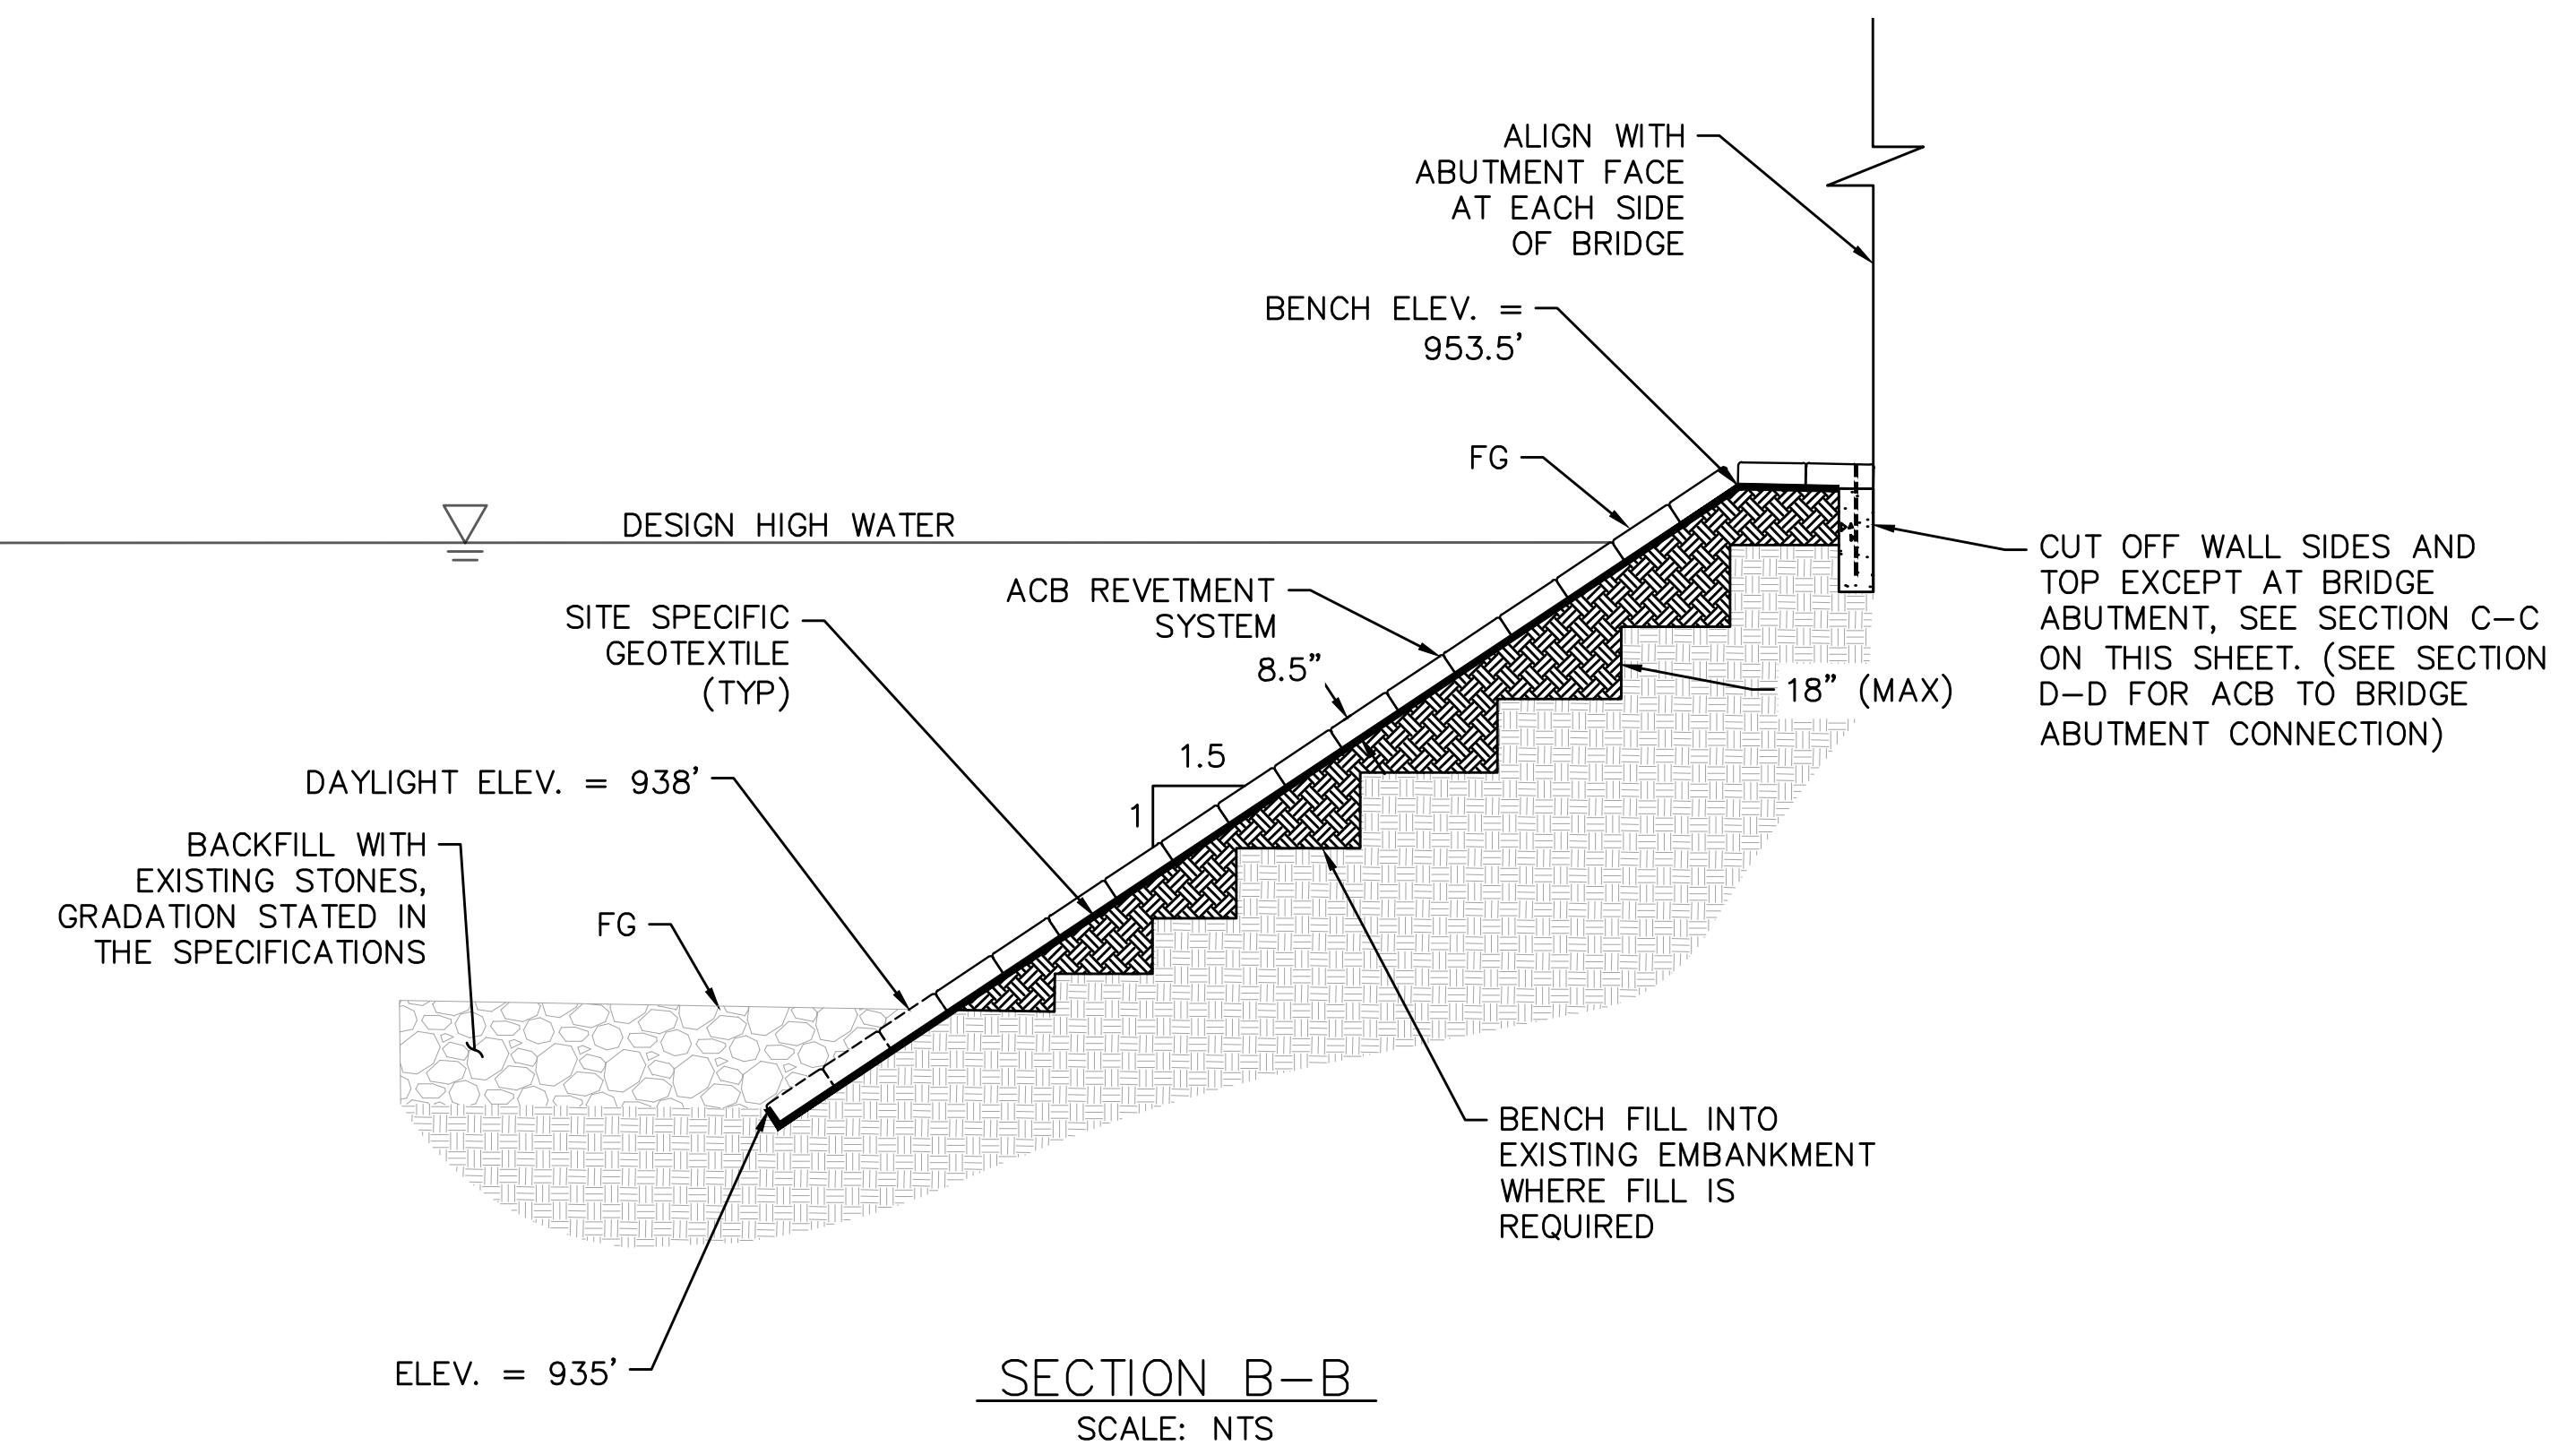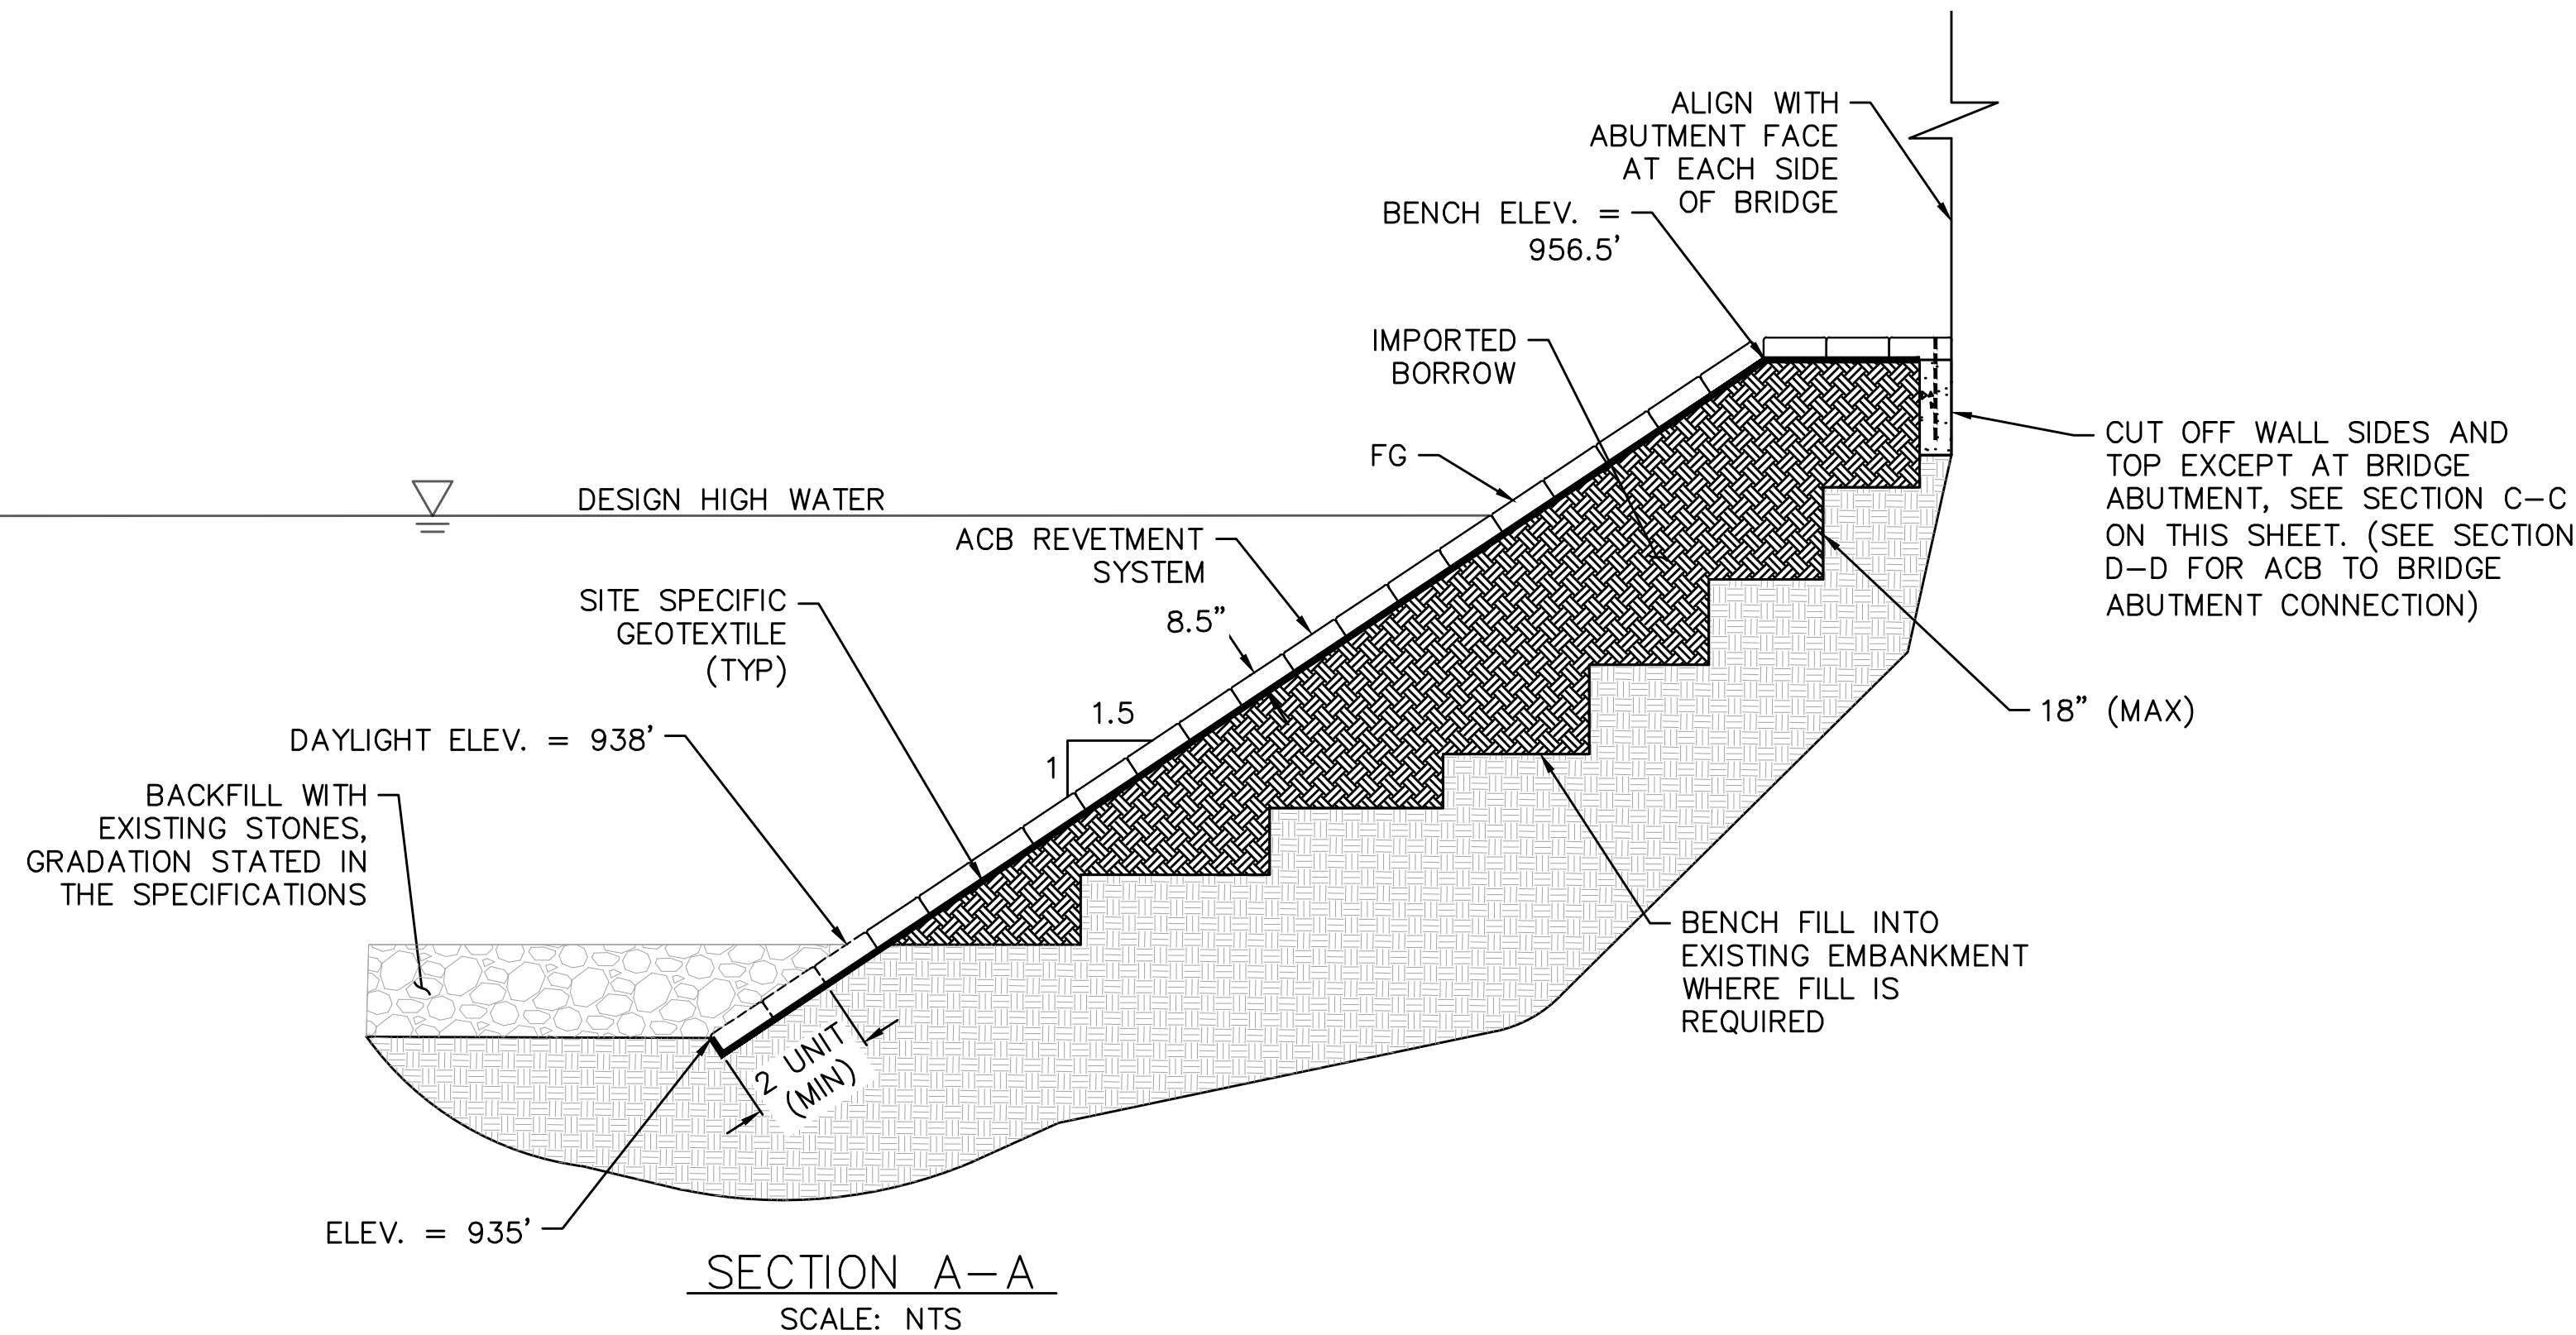

- NOTES:**
- DESIGN OF ARTICULATED CONCRETE BLOCK (ACB) SLOPE PROTECTION IS BASED ON THE REPORT TITLED "PRELIMINARY DESIGN HYDRAULIC STUDY ENNIS ROAD BRIDGE OVER SAND CREEK (BRIDGE 42C0697), FRESNO COUNTY, CALIFORNIA," PREPARED BY AVILA AND ASSOCIATES, DATED NOVEMBER 6, 2019.
 - FOR BRIDGE GENERAL PLAN, SEE STRUCTURAL SHEET S-1.


- LEGEND**
- R/W
 - - - PR. TCE
 - - - PR. DAYLIGHT
 - - - PR. BENCH
 - - - PR. CUT OFF WALL
 - - - PR. MGS
 - ▭ PR. PAVEMENT
 - ▨ ACB SLOPE PROTECTION

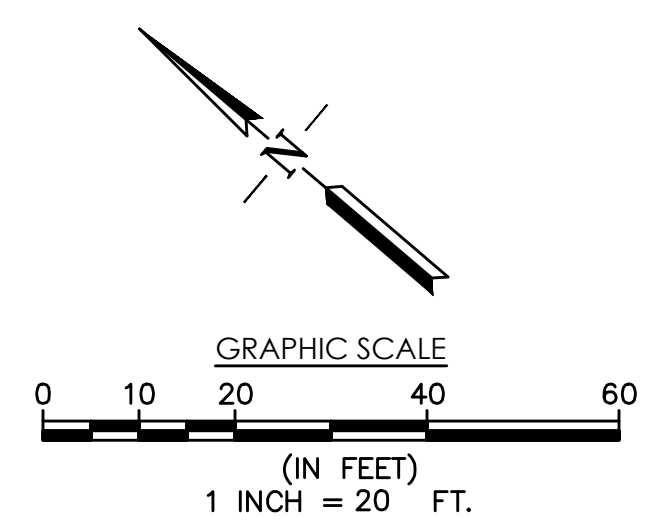

CD-2



DESIGNED: DV		DATE: 3/12/2021	RECORD DRAWING		SCALE: AS SHOWN	PROJECT: SAND CREEK BRIDGE REPLACEMENT ON ENNIS ROAD			DEPARTMENT OF PUBLIC WORKS AND PLANNING	
DRAWN: LS		DATE: 3/12/2021	RESIDENT ENGINEER			ROAD NO. 2824-2825 BRIDGE NO. 42C0697, BRLO-5942(238)			CONSTRUCTION DETAILS	
CHECKED: DV		DATE: 3/12/2021	DATE			DRAWING NO. 11257 SHEET NO. 12 TOTAL 31				

THESE PLANS ARE FOR THE CONTRACTOR'S INFORMATION ONLY. THEY ARE NOT TO BE CONSIDERED TO BE PART OF THE CONTRACT DOCUMENTS AND SHALL HAVE NO BEARING WHATSOEVER ON THE INTERPRETATION OF THE STANDARD SPECIFICATIONS, THE STANDARD PLANS, THE SPECIAL PROVISIONS, NOR SHALL THEY HAVE ANY BEARING WHATSOEVER ON THE INTERPRETATION OF THE OTHER PUBLICATIONS REFERENCED THEREIN

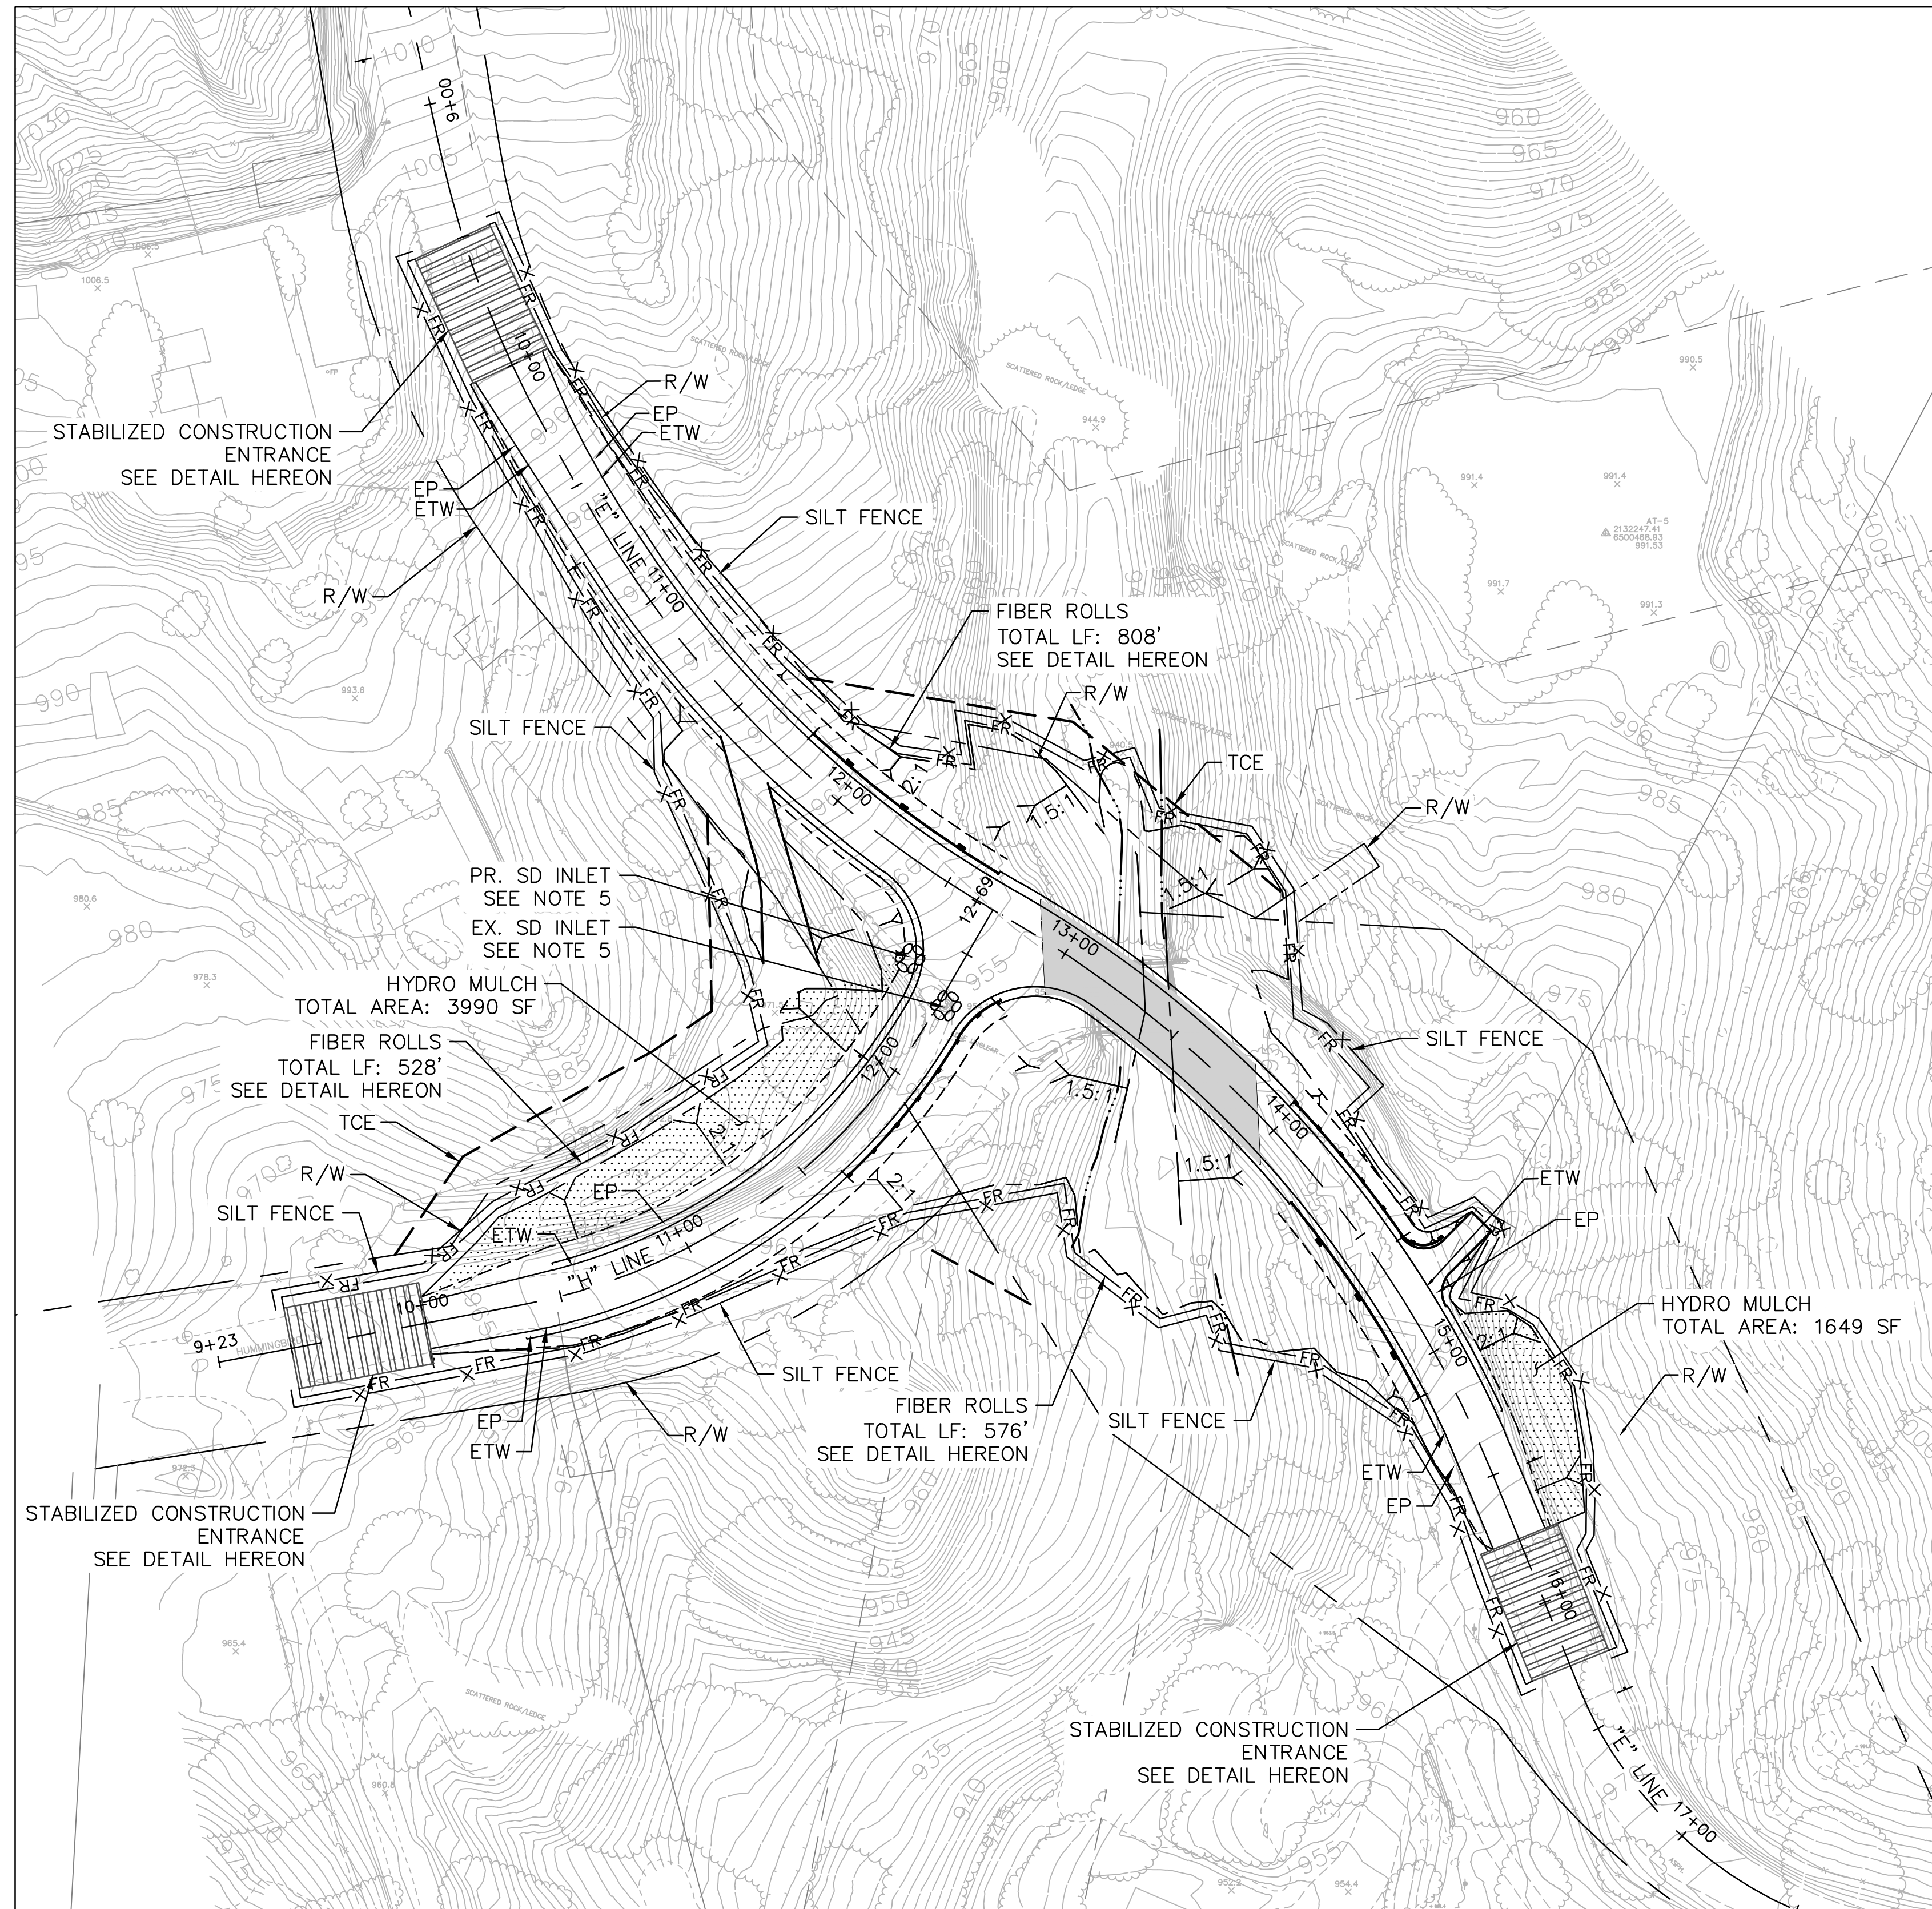


EROSION CONTROL NOTES:

1. EROSION AND SEDIMENT CONTROL MEASURES SHALL BE EFFECTIVE FOR CONSTRUCTION IN DISTURBED AREAS THAT WILL NOT BE WORKED FOR 14 DAYS.
2. ALL PAVED AREAS SHALL BE KEPT CLEAR OF EARTH MATERIALS AND DEBRIS, THE SITE SHALL BE MAINTAINED SO AS TO MINIMIZE SEDIMENT-LADEN RUNOFF FROM ENTERING SAND CREEK.
3. ALL FIBER ROLLS TO REMAIN IN PLACE AFTER COMPLETION OF CONSTRUCTION.
4. CONTRACTOR SHALL REVISE EROSION CONTROL PLAN TO ACCOMMODATE CONSTRUCTION SCHEDULE AND PHASING.
5. FOR TEMPORARY DRAINAGE INLET PROTECTION, SEE CALTRANS STANDARD PLAN T62. INLET PROTECTION LOCATION WILL CHANGE DEPENDING ON CONSTRUCTION STAGE.

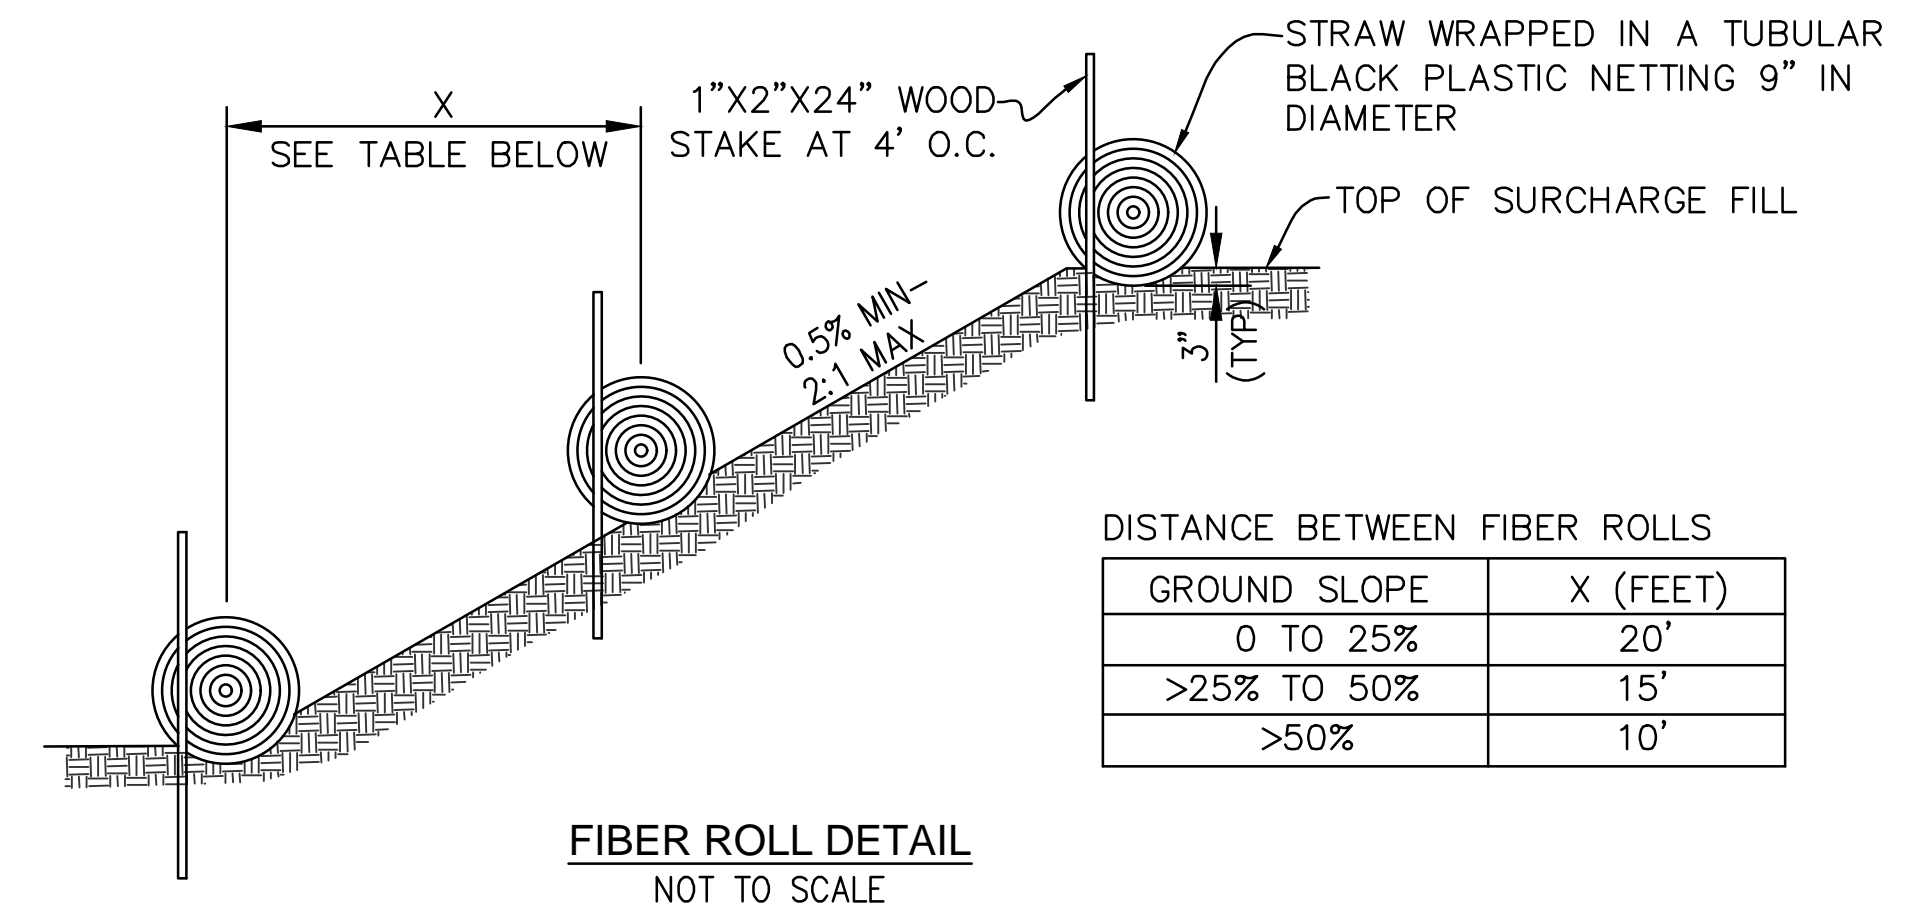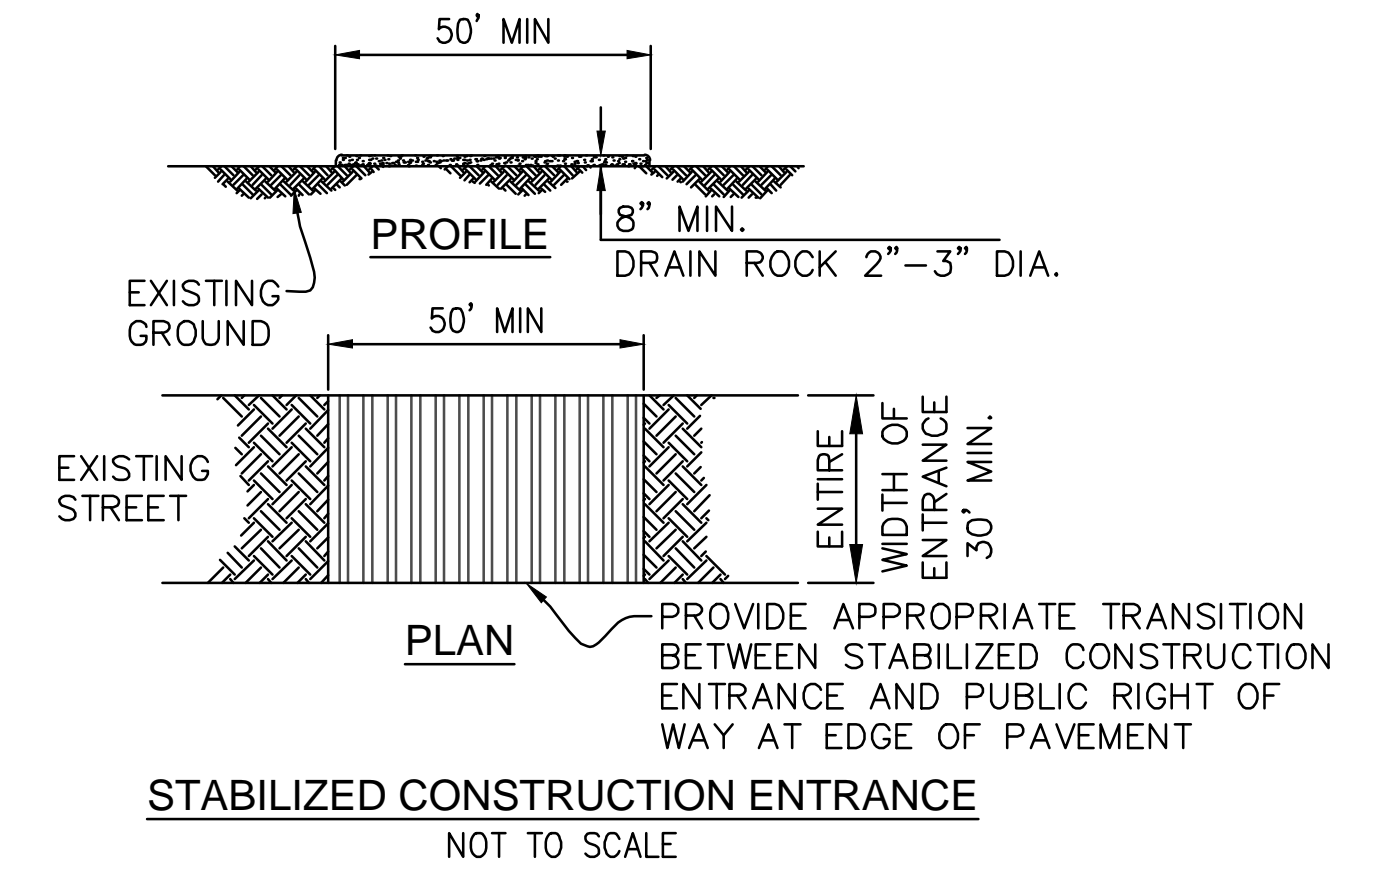

DISTANCE BETWEEN FIBER ROLLS

GROUND SLOPE	X (FEET)
0 TO 25%	20'
>25% TO 50%	15'
>50%	10'

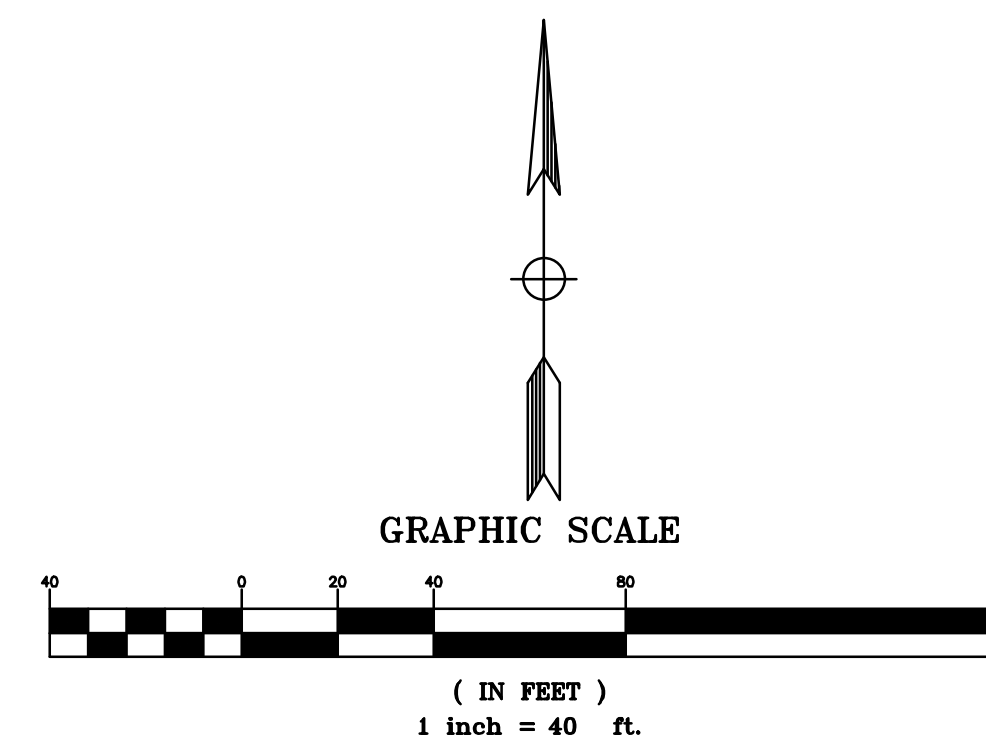


EC-1

DESIGNED: SA	DATE: 3/12/2021	RECORD DRAWING	SCALE	PROJECT		DEPARTMENT OF PUBLIC WORKS AND PLANNING
DRAWN: LS	DATE: 3/12/2021	RESIDENT ENGINEER	AS SHOWN	SAND CREEK BRIDGE REPLACEMENT ON ENNIS ROAD		EROSION CONTROL
CHECKED: SA	DATE: 3/12/2021			ROAD NO. 2824-2825		DRAWING NO. 11257
FOR RIGHT OF WAY DATA AND ACCURATE ACCESS DETERMINATION, SEE DOCUMENTS IN THE DEPARTMENT OF PUBLIC WORKS AND PLANNING.				BRIDGE NO. 42C0697, BRLO-5942(238)		SHEET NO. 13
						TOTAL 31



- SIGNING NOTES:**
- E PROTECT IN PLACE EXISTING SIGN UNLESS OTHERWISE NOTED
 - 1 REMOVE EXISTING SIGN
 - 2 INSTALL SIGN AND POST AS INDICATED. EXISTING SHALL BE REMOVED AND DISPOSED

- LEGEND**
- EX. UTILITY POLE
 - EX. OVERHEAD ELECTRICAL
 - R/W
 - PR. TCE
 - PR. DAYLIGHT
 - PR. BENCH
 - PR. MGS
 - EX. SIGN
 - PR. SIGN

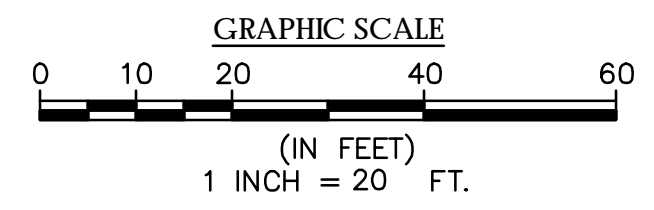

SS-1

	DATE	RECORD DRAWING		SCALE		PROJECT		<i>DEPARTMENT OF PUBLIC WORKS AND PLANNING</i>			
DESIGNED: SA	3/12/2021	RESIDENT ENGINEER	DATE	AS SHOWN	SAND CREEK BRIDGE REPLACEMENT ON ENNIS ROAD	SIGNING PLAN					
DRAWN: LS	3/12/2021					ROAD NO. 2824-2825		BRIDGE NO. 42C0697, BRLO-5942(238)	DRAWING NO. 11257	SHEET NO. 14	TOTAL 31
CHECKED: SA	3/12/2021					FOR RIGHT OF WAY DATA AND ACCURATE ACCESS DETERMINATION, SEE DOCUMENTS IN THE DEPARTMENT OF PUBLIC WORKS AND PLANNING.					


THESE PLANS ARE FOR THE CONTRACTOR'S INFORMATION ONLY. THEY ARE NOT TO BE CONSIDERED TO BE PART OF THE CONTRACT DOCUMENTS AND SHALL HAVE NO BEARING WHATSOEVER ON THE INTERPRETATION OF THE STANDARD SPECIFICATIONS, THE STANDARD PLANS, THE SPECIAL PROVISIONS, NOR SHALL THEY HAVE ANY BEARING WHATSOEVER ON THE INTERPRETATION OF THE OTHER PUBLICATIONS REFERENCED THEREIN



- NOTE:**
1. CONTRACTOR SHALL PREPARE AND SUBMIT TRAFFIC CONTROL PLANS FOR COUNTY APPROVAL.
 2. CONTRACTOR SHALL PROVIDE ACCESS TO DRIVEWAYS AT ALL TIMES.

- LEGEND**
- SURFACE MOUNTED CHANNELIZER
 - ▨ CONSTRUCTION AREA
 - ▤ GRADE EMBANKMENT PER PLAN
 - TEMPORARY OR PERMANENT ASPHALT CONCRETE AS NOTED IN STAGE CONSTRUCTION CALL-OUTS.
 - K-RAIL (10-FOOT OR 20-FOOT SEGMENTS)
 - ▧ ABSORB 350
 - ++ TYPE II BARRICADE
 - +++ TYPE III BARRICADE
 - ▬ GEOTEXTILE FABRIC
 - ↔ TRAFFIC DIRECTION
 - MIDWEST GUARDRAIL SYSTEM
 - ▣ 24"x24" CATCH BASIN
 - ⊥ TEMPORARY ROADSIDE SIGN

- STAGE 1 CONSTRUCTION**
- 1-A DEMOLISH EXISTING BRIDGE
 - 1-B INSTALL TEMPORARY K-RAIL, BARRICADES, SURFACE MOUNTED CHANNELIZERS AND TEMPORARY SIGNS.
 - 1-C CONSTRUCT PIPE CULVERT WARPED WINGWALL, RSP AND STORM DRAIN. CONSTRUCT 24"x24" CATCH BASIN AND CONNECT TO EXISTING 24" STORM DRAIN FOR TEMPORARY DRAINAGE.
 - 1-D CONSTRUCT NEW ROADWAY SECTION ALONG ENNIS ROAD. CONSTRUCT NEW BRIDGE ALONG ENNIS ROAD. GRADE SLOPE EMBANKMENTS ALONG ENNIS ROAD EAST OF HUMMINGBIRD LANE, AS SHOWN PER PLANS. INSTALL ACB SLOPE PROTECTION
 - 1-E INSTALL GEOTEXTILE FABRIC OR OTHER MEANS AND METHOD (APPROXIMATELY H=10 FEET) TO RETAIN EXPOSED SOIL. INSTALL GUARDRAIL SYSTEM ALONG ENNIS ROAD.
 - 1-F REGRADE EXISTING DRIVEWAYS TO MEET NEW FINISHED GRADE OR SURFACE PER PLAN. DRIVEWAY SHALL REMAIN ACCESSIBLE DURING CONSTRUCTION.
 - 1-G CONSTRUCT TEMPORARY AC PAVEMENT WHERE NEEDED TO MEET A 16 FT WIDE ROAD BED ALONG ENNIS ROAD AND HUMMINGBIRD LANE.
 - 1-H CONSTRUCT SOUTH BOUND SIDE OF ROADWAY SECTION OF ENNIS ROAD. CONSTRUCT WEST BOUND SIDE OF ROADWAY SECTION OF HUMMINGBIRD LANE. CONSTRUCT ACCESS ROAD. GRADE SLOPE EMBANKMENTS AS SHOWN ON PLANS. INSTALL CRASH CUSHION AND GUARDRAIL SYSTEM.

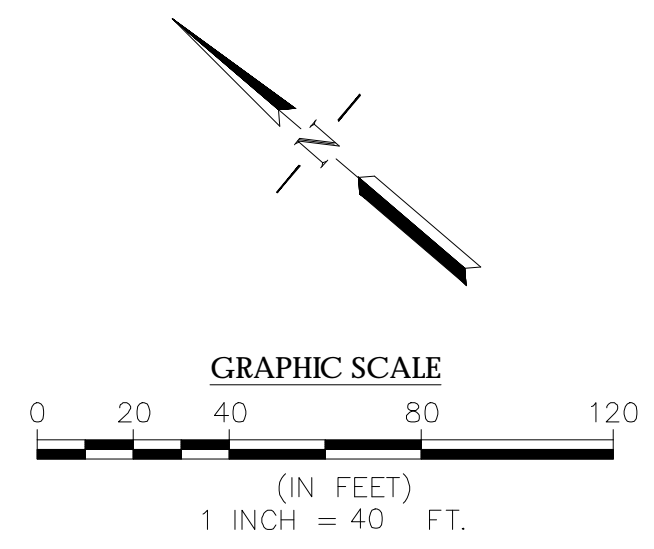

SC-1

DESIGNED: SA		DATE	RECORD DRAWING		SCALE		PROJECT			DEPARTMENT OF PUBLIC WORKS AND PLANNING	
DRAWN: LS		3/12/2021	RESIDENT ENGINEER		AS SHOWN		SAND CREEK BRIDGE REPLACEMENT ON ENNIS ROAD			STAGE CONSTRUCTION - STAGE 1	
CHECKED: SA		3/12/2021					ROAD NO. 2824-2825 BRIDGE NO. 42C0697, BRLO-5942(238)			DRAWING NO. 11257 SHEET NO. 15 TOTAL 31	
FOR RIGHT OF WAY DATA AND ACCURATE ACCESS DETERMINATION, SEE DOCUMENTS IN THE DEPARTMENT OF PUBLIC WORKS AND PLANNING.											

THESE PLANS ARE FOR THE CONTRACTOR'S INFORMATION ONLY. THEY ARE NOT TO BE CONSIDERED TO BE PART OF THE CONTRACT DOCUMENTS AND SHALL HAVE NO BEARING WHATSOEVER ON THE INTERPRETATION OF THE STANDARD SPECIFICATIONS, THE STANDARD PLANS, THE SPECIAL PROVISIONS, NOR SHALL THEY HAVE ANY BEARING WHATSOEVER ON THE INTERPRETATION OF THE OTHER PUBLICATIONS REFERENCED THEREIN

NOTE:



1. CONTRACTOR SHALL PREPARE AND SUBMIT TRAFFIC CONTROL PLANS FOR COUNTY APPROVAL.
2. CONTRACTOR SHALL PROVIDE ACCESS TO DRIVEWAYS AT ALL TIMES.

LEGEND

- SURFACE MOUNTED CHANNELIZER
- ▨ CONSTRUCTION AREA
- ▨ GRADE EMBANKMENT PER PLAN
- ▨ TEMPORARY OR PERMANENT ASPHALT CONCRETE AS NOTED IN STAGE CONSTRUCTION CALL-OUTS.
- ▬ K-RAIL 910-FOOT OR 20-FOOT SEGMENTS)
- ▬ ABSORB 350
- ⊕ TYPE II BARRICADE
- ⊕⊕ TYPE III BARRICADE
- ▬ GEOTEXTILE FABRIC
- ↔ TRAFFIC DIRECTION
- ▬ MIDWEST GUARDRAIL SYSTEM
- ▬ TEMPORARY ROADSIDE SIGN

STAGE 2 CONSTRUCTION

- 2-A SWITCH EXISTING TRAFFIC TO WEST SIDE OF ENNIS ROAD, PERMANENT ASPHALT CONCRETE CONSTRUCTED DURING STAGE 1.
- 2-B DEMOLISH TEMPORARY CATCH BASIN CONNECTION CONSTRUCTED IN STAGE 1. DEMOLISH EXISTING STORM DRAIN SYSTEM. CONSTRUCT STORM DRAIN, RSP, AND OUTLET PROTECTION.
- 2-C DEMOLISH TEMPORARY ASPHALT CONCRETE PAVEMENT. CONSTRUCT NORTH BOUND SIDE OF ENNIS ROAD. CONSTRUCT EAST BOUND SIDE OF HUMMINGBIRD LANE. GRADE SLOPE EMBANKMENTS ALONG ENNIS ROAD AS SHOWN ON PLANS. INSTALL ACB SLOPE PROTECTION.
- 2-D INSTALL GUARDRAIL SYSTEM ALONG ENNIS ROAD AND HUMMINGBIRD LANE.

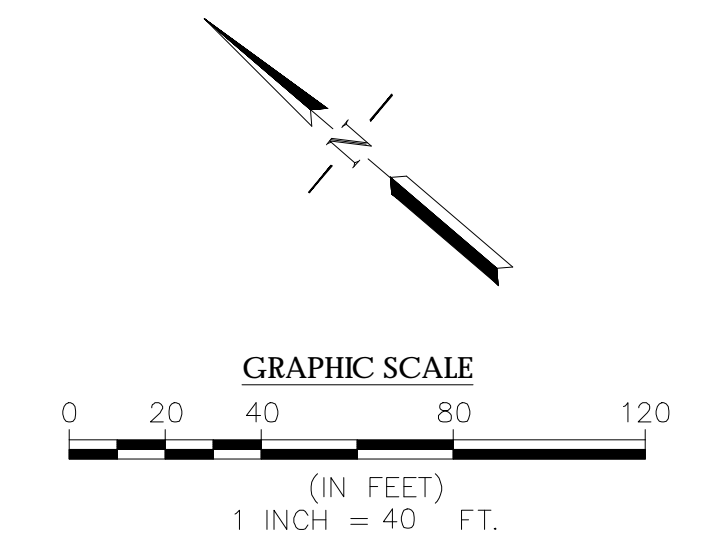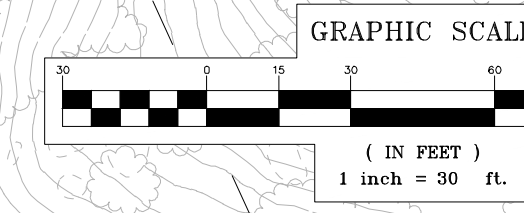


SC-2

DESIGNED: SA		DATE	RECORD DRAWING		SCALE		PROJECT			DEPARTMENT OF PUBLIC WORKS AND PLANNING	
DRAWN: LS		3/12/2021	RESIDENT ENGINEER		AS SHOWN		SAND CREEK BRIDGE REPLACEMENT ON ENNIS ROAD			STAGE CONSTRUCTION - STAGE 2	
CHECKED: SA		3/12/2021	DATE				ROAD NO. 2824-2825 BRIDGE NO. 42C0697, BRLO-5942(238)			DRAWING NO. 11257 SHEET NO. 16 TOTAL 31	
FOR RIGHT OF WAY DATA AND ACCURATE ACCESS DETERMINATION, SEE DOCUMENTS IN THE DEPARTMENT OF PUBLIC WORKS AND PLANNING.											

THESE PLANS ARE FOR THE CONTRACTOR'S INFORMATION ONLY. THEY ARE NOT TO BE CONSIDERED TO BE PART OF THE CONTRACT DOCUMENTS AND SHALL HAVE NO BEARING WHATSOEVER ON THE INTERPRETATION OF THE STANDARD SPECIFICATIONS, THE STANDARD PLANS, THE SPECIAL PROVISIONS, NOR SHALL THEY HAVE ANY BEARING WHATSOEVER ON THE INTERPRETATION OF THE OTHER PUBLICATIONS REFERENCED THEREIN

\\BKF-OAK\VOL4\ENGIN\20141070_FRESNO-SAND_CREEK_BRIDGE_ON_ENNIS_ROAD\ENGIN\SHEETS\DETOUR.DWG

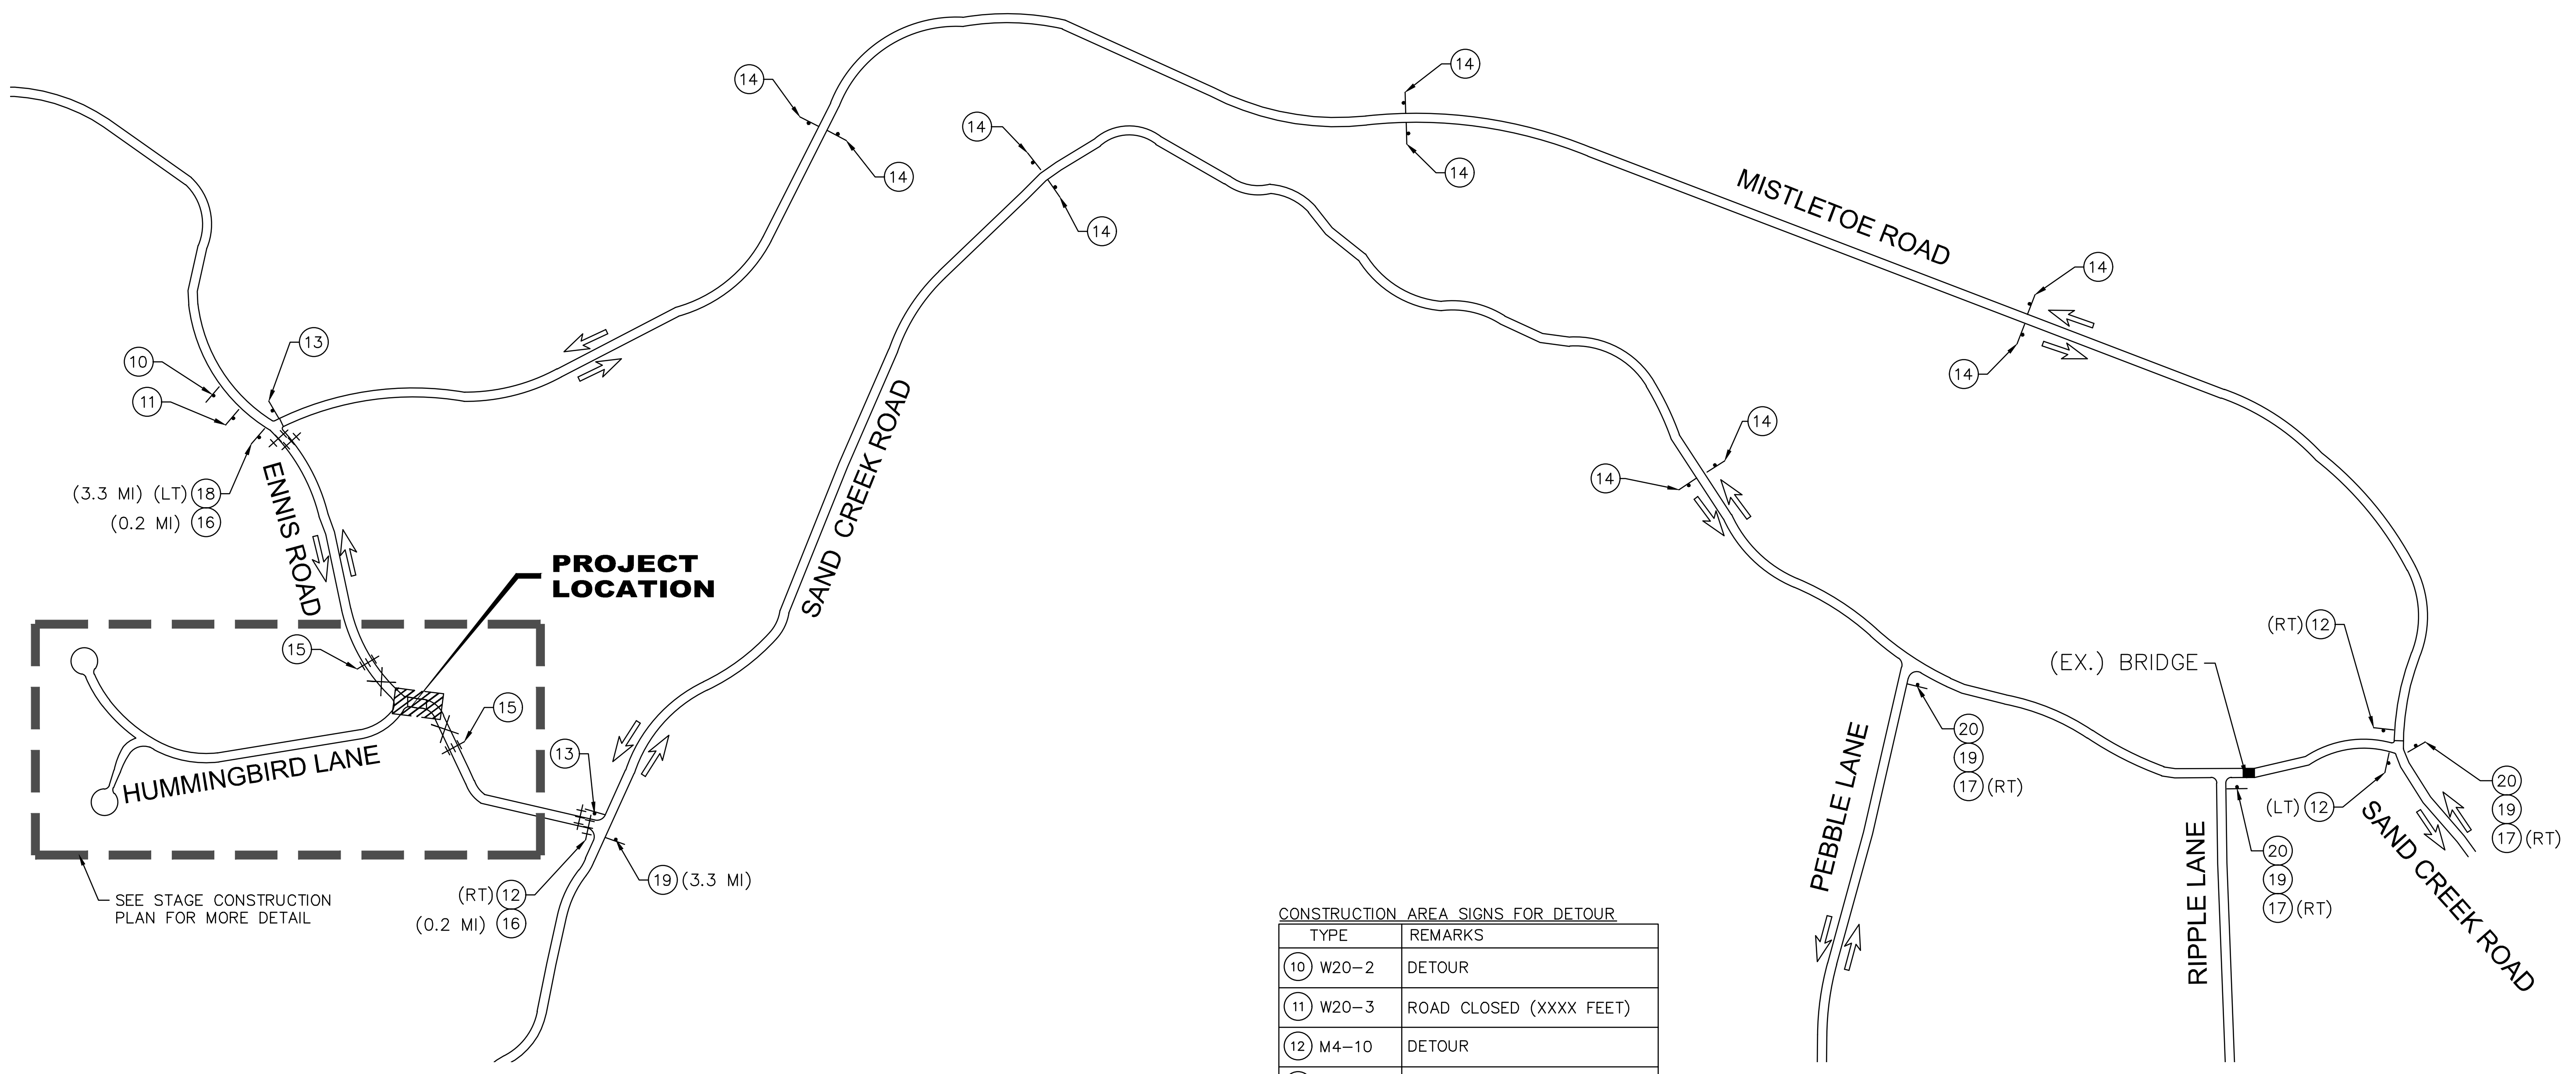

CONSTRUCTION AREA SIGNS FOR DETOUR


TYPE	REMARKS
10 W20-2	DETOUR
11 W20-3	ROAD CLOSED (XXXX FEET)
12 M4-10	DETOUR
13 M4-8A	END DETOUR
14 M4-8	DETOUR
15 R11-2	ROAD CLOSED
16 R11-3a	ROAD CLOSED XX MILES AHEAD LOCAL TRAFFIC ONLY
17 W1-6	"ARROW"
18 M4-9	DETOUR
19 SC3 (CA)	DETOUR
20 MOD	ROAD CLOSED AHEAD ON ENNIS ROAD LOCAL TRAFFIC ONLY USE MISTLETOE ROAD

NOTES:

1. LOCATION OF CONSTRUCTION AREA SIGNS SHOWN ARE APPROXIMATE. EXACT LOCATION WILL BE DETERMINED BY THE ENGINEER.
2. ALL SIGNS ARE STATIONARY MOUNTED.
3. SIGNAGE SHALL COMPLY WITH 2014 CA MUTCD.

LEGEND:

- PROPOSED ROADSIDE SIGN
- ✕ ROADWAY CLOSURE
- ➡ DIRECTION OF TRAFFIC
- +++ TYPE III BARRICADE

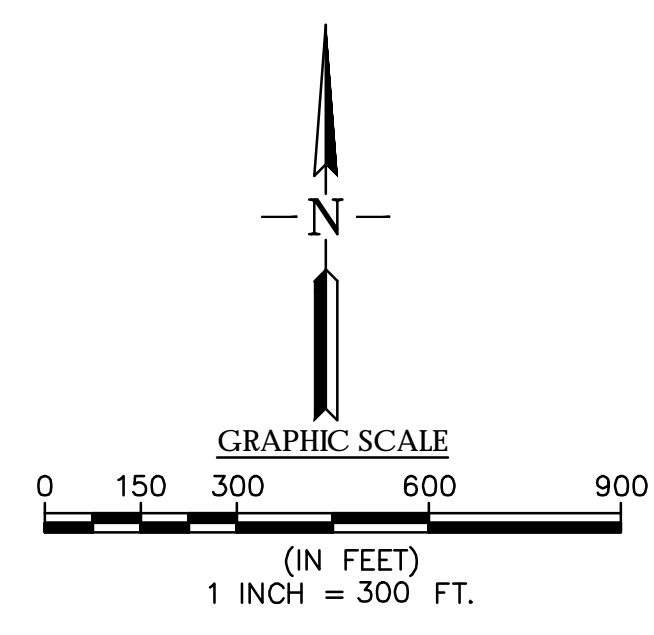

DE-1


DESIGNED: SA		DATE: 3/12/2021	RECORD DRAWING		SCALE		PROJECT			DEPARTMENT OF PUBLIC WORKS AND PLANNING	
DRAWN: LS		DATE: 3/12/2021	RESIDENT ENGINEER		AS SHOWN		SAND CREEK BRIDGE REPLACEMENT ON ENNIS ROAD			DETOUR PLAN	
CHECKED: SA		DATE: 3/12/2021	DATE				ROAD NO. 2824-2825 BRIDGE NO. 42C0697, BRLO-5942(238)			DRAWING NO. 11257 SHEET NO. 17 TOTAL 31	
FOR RIGHT OF WAY DATA AND ACCURATE ACCESS DETERMINATION, SEE DOCUMENTS IN THE DEPARTMENT OF PUBLIC WORKS AND PLANNING.											

FOR ACCURATE RIGHT OF WAY AND ACCESS DATA, SEE 'ROADWAY PLANS'



PROFILE GRADE


NO SCALE

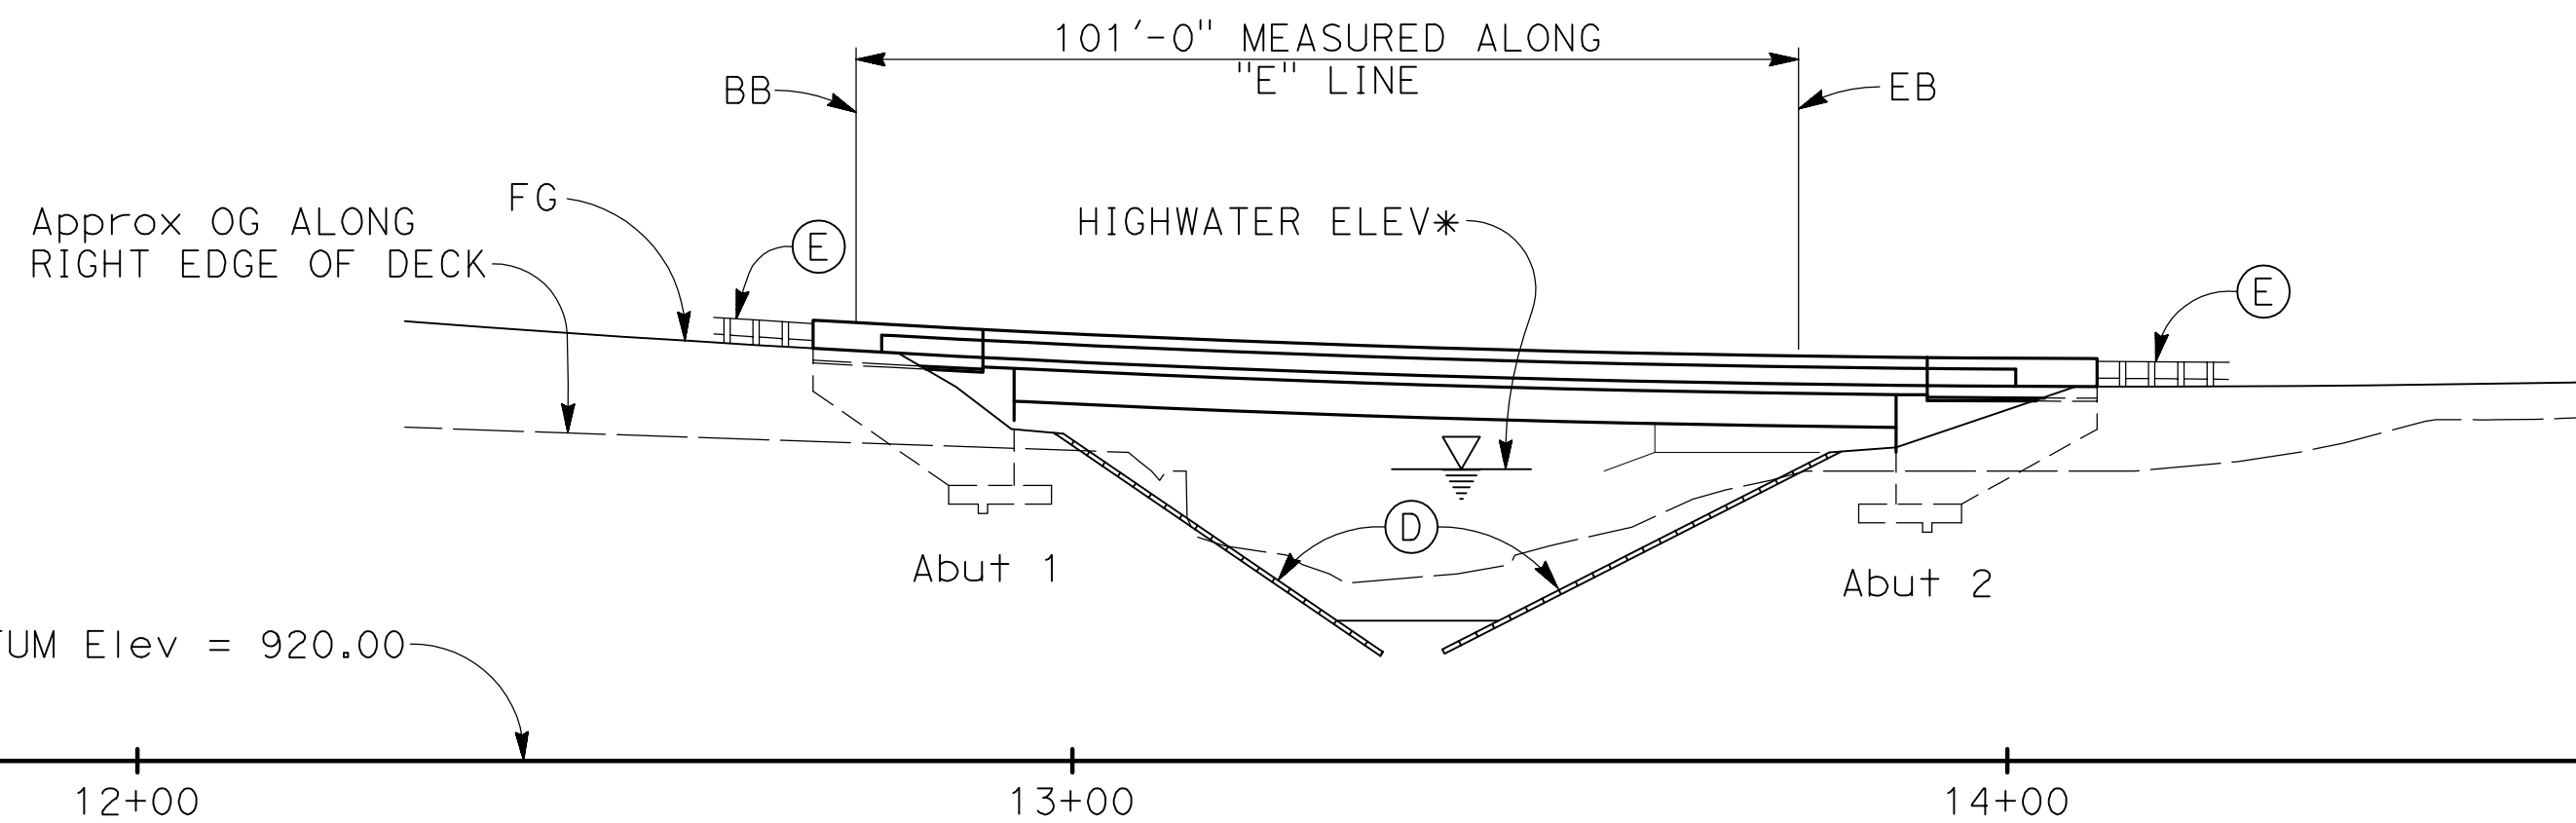

DEVELOPED ELEVATION


1" = 20'

* SEE "HYDROLOGIC SUMMARY" ON "FOUNDATION PLAN" SHEET

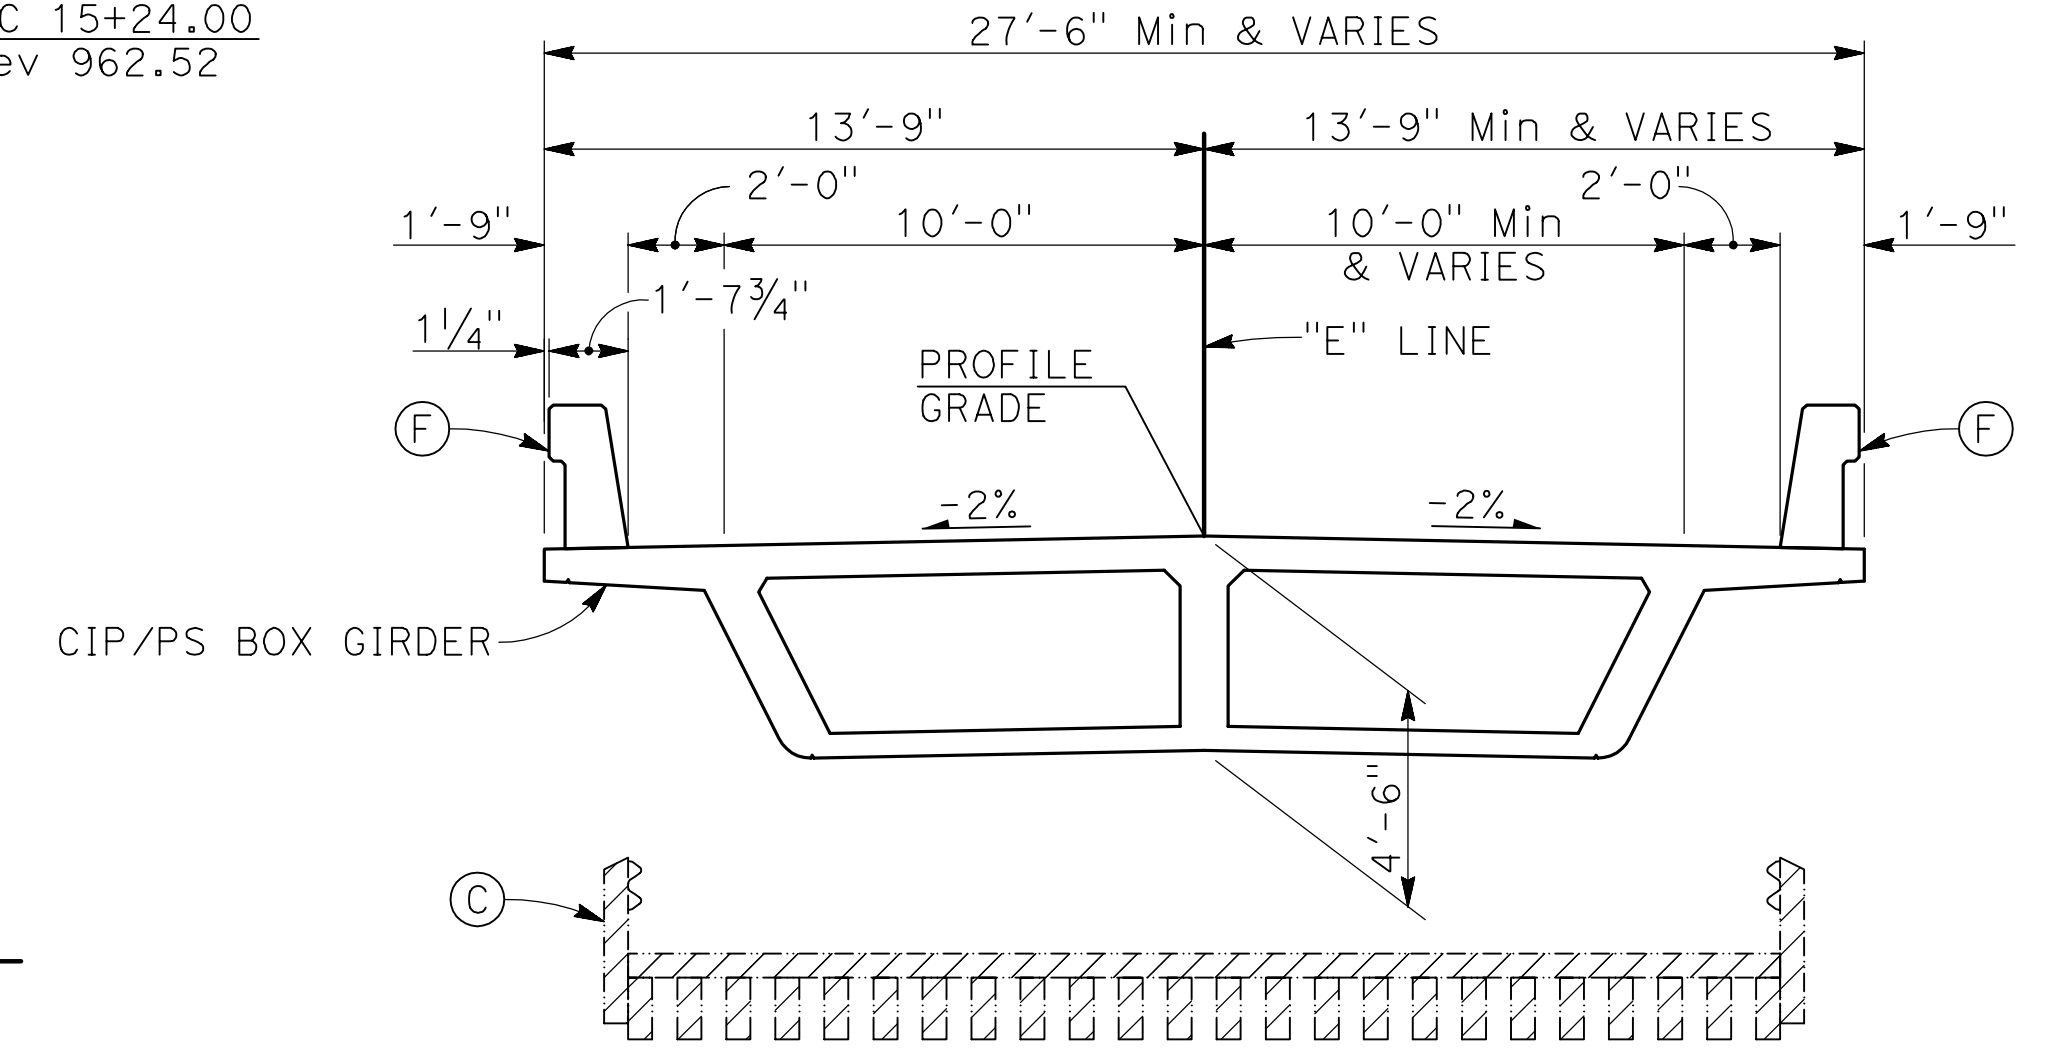


TYPICAL SECTION

1/4" = 1'-0"

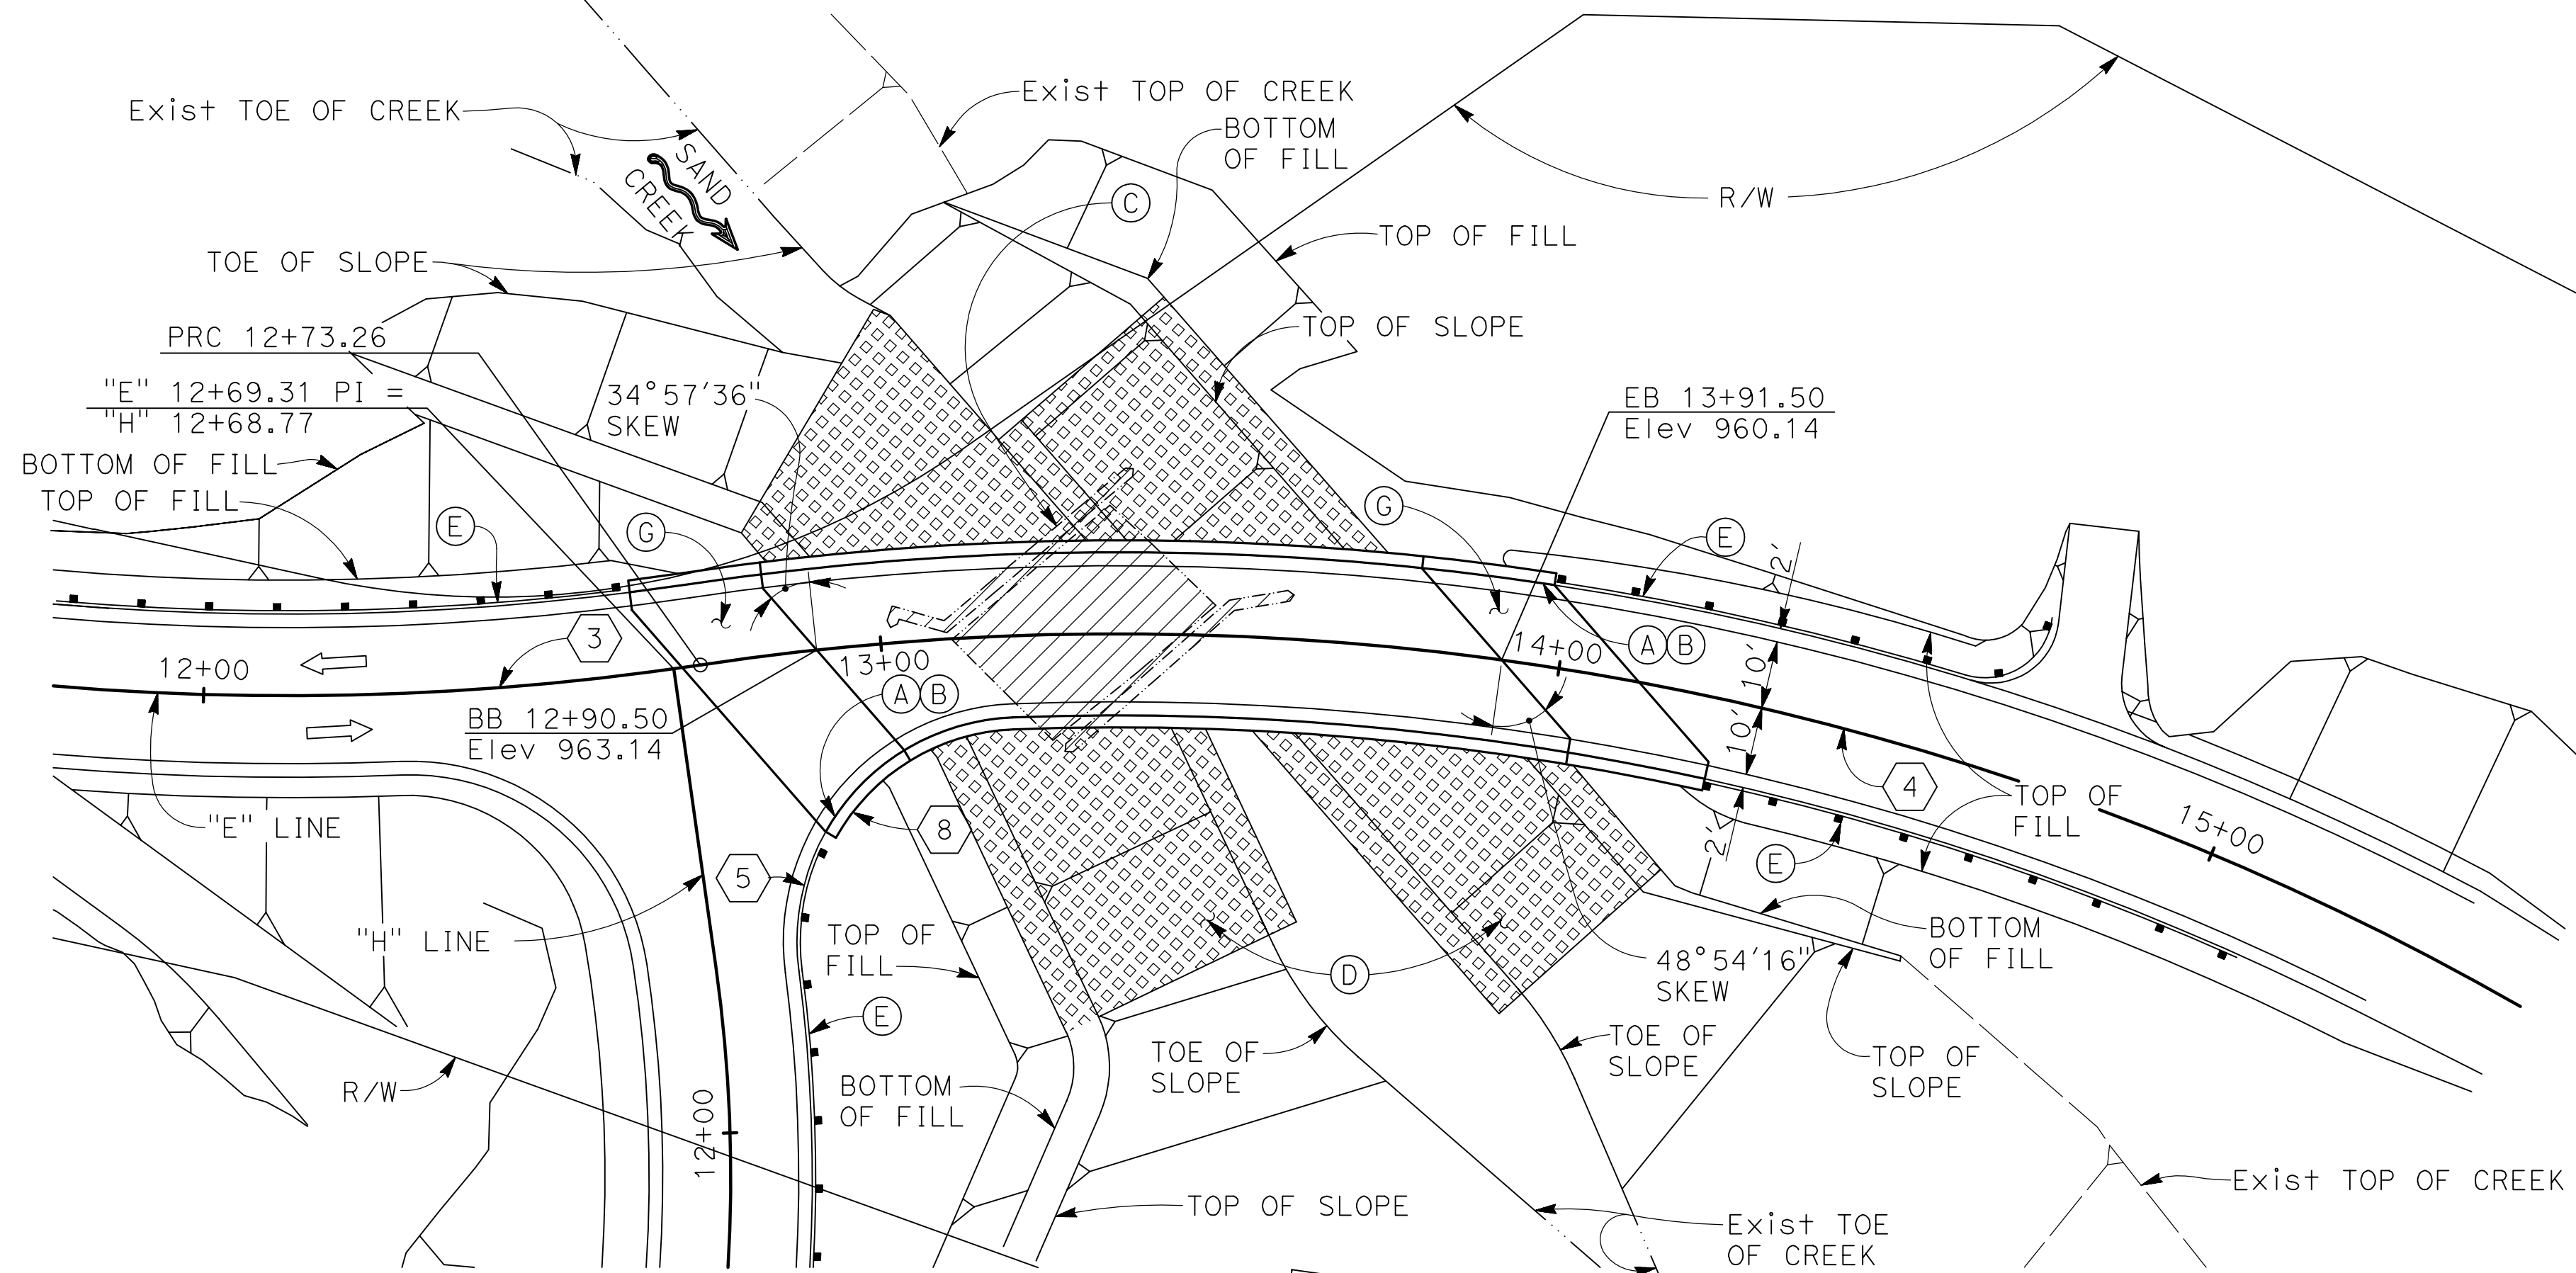

PLAN

1" = 20'

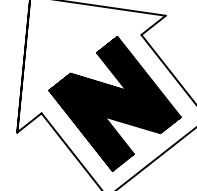

3
Curve Data
Layout Line
R = 410'
Δ = 31°10'58"
T = 114.41'
L = 223.14'

4
Curve Data
Layout Line
R = 415'
Δ = 38°18'08"
T = 144.12'
L = 277.43'

5
Curve Data
Layout Line
R = 33'
Δ = 95°16'50"
T = 36.19'
L = 54.88'

8
Curve Data
Layout Line
R = 31.25'
Δ = 58°29'47"
T = 17.50'
L = 31.90'

NOTES:


- (A) Paint "BRIDGE No. 42C0697"
 - (B) Paint "SAND CREEK BRIDGE"
 - (C) Remove existing Sand Creek Bridge
 - (D) ACB Revetment System, see "ROADWAY PLANS"
 - (E) MGS, See "ROADWAY PLANS"
 - (F) Concrete Barrier Type 836
 - (G) Structure Approach Slab
1. For "GENERAL NOTES", see "DECK CONTOURS" sheet
 2. For "SPREAD FOOTING DATA TABLE", see "FOUNDATION PLAN" sheet

LEGEND:

- Bridge Removal
- Indicates Existing Structure
- Indicates Traffic Direction


NOTE:
THE CONTRACTOR MUST VERIFY ALL CONTROLLING FIELD DIMENSIONS BEFORE ORDERING OR FABRICATING ANY MATERIAL

DESIGNED: SGS		DATE: 1/25/21	RECORD DRAWING		SCALE: AS SHOWN	PROJECT: SAND CREEK BRIDGE REPLACEMENT ON ENNIS ROAD			DEPARTMENT OF PUBLIC WORKS AND PLANNING	
DRAWN: AR		DATE: 1/25/21	RESIDENT ENGINEER			ROAD NO. 2824-2825 BRIDGE NO. 42C0697, BRLO-5942(238)			GENERAL PLAN	
CHECKED: ML		DATE: 1/25/21	DATE			DRAWING NO. 11257 SHEET NO. 18 TOTAL 31				

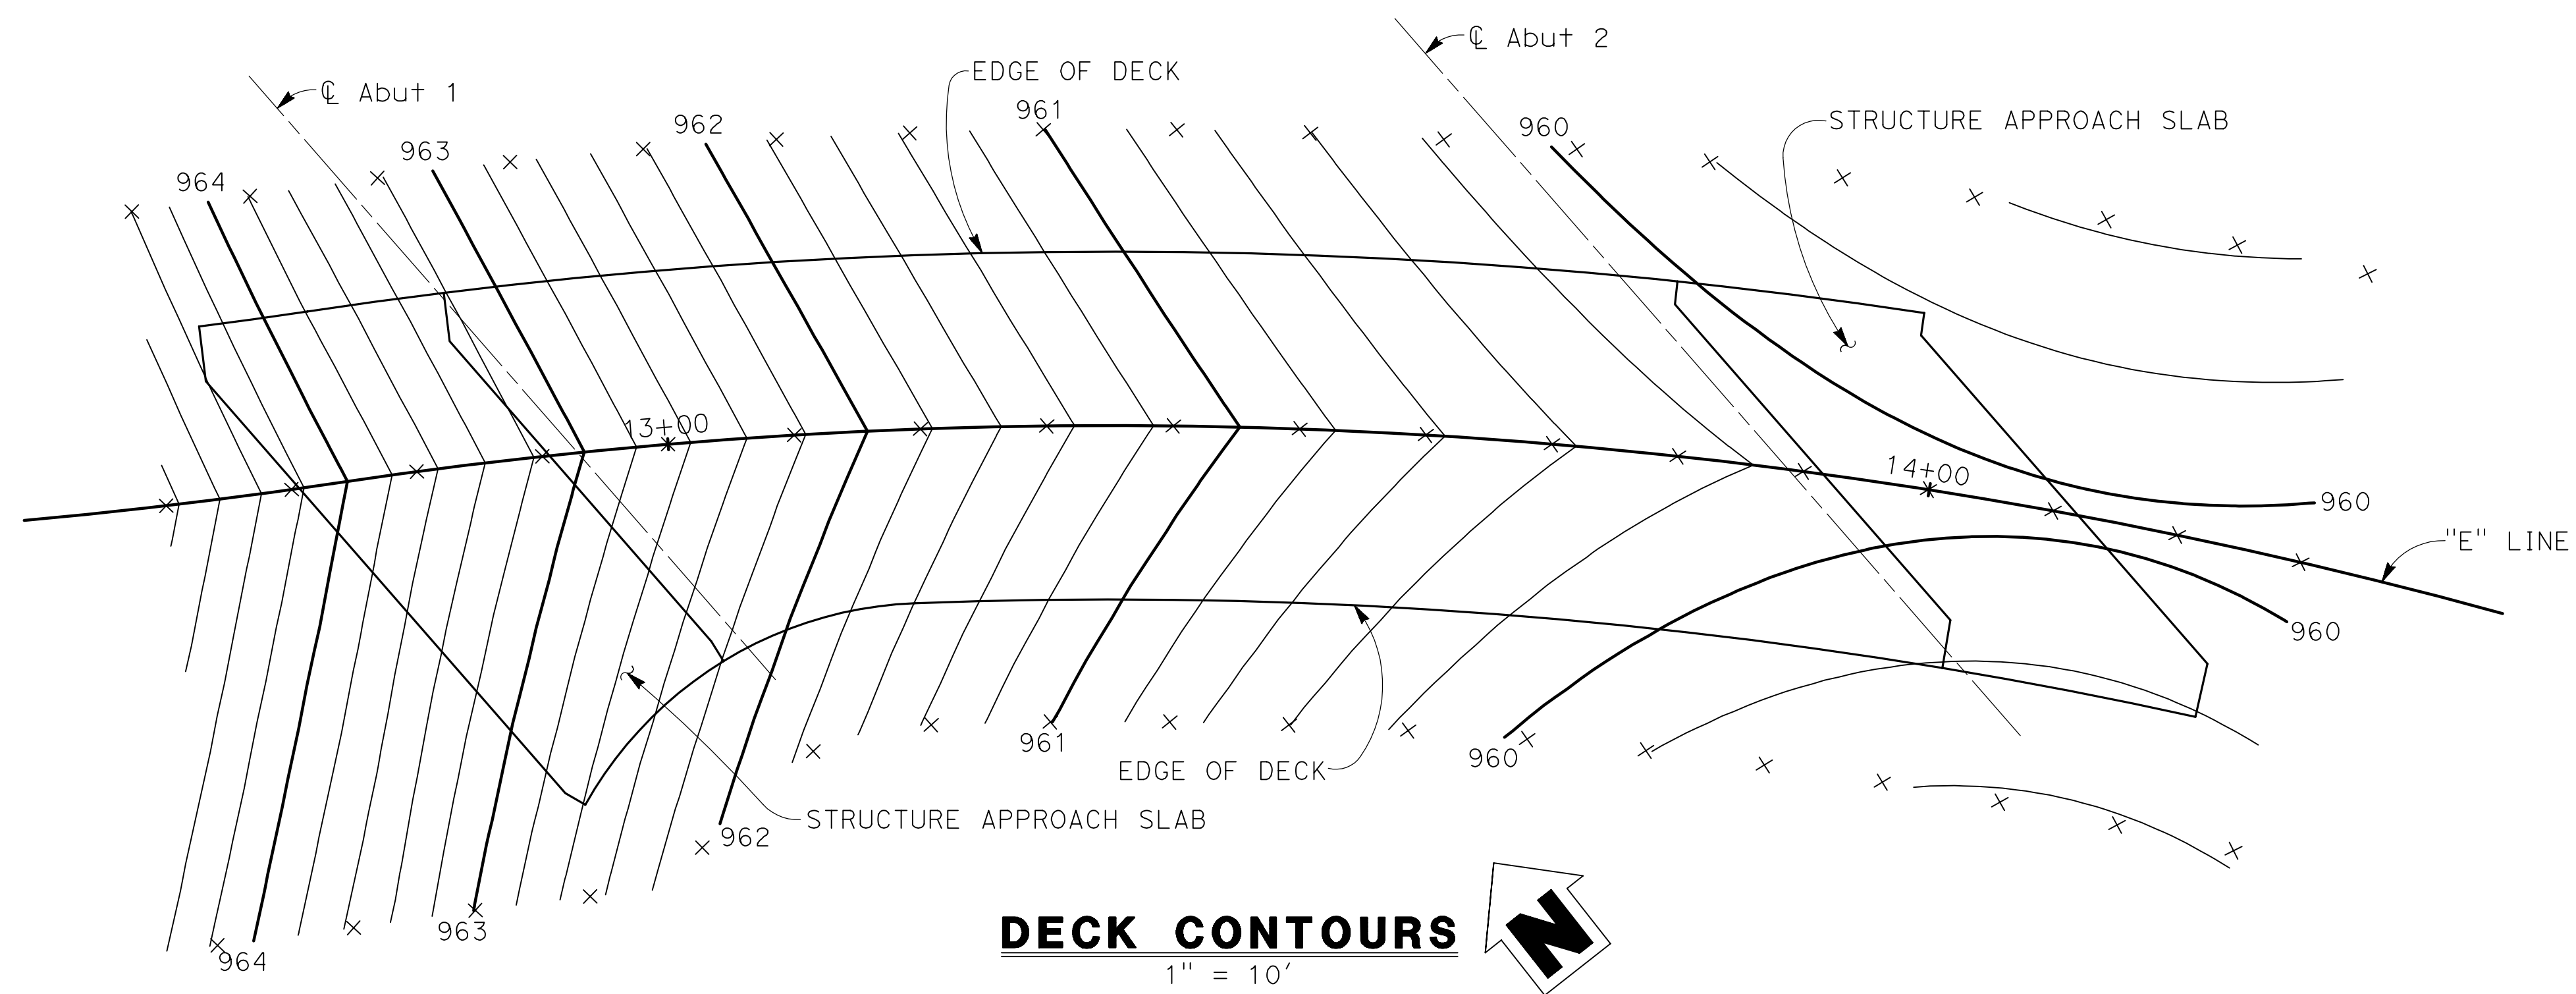


DECK CONTOURS
1" = 10'

- NOTES:
1. Contours indicate top of deck elevation.
 2. x Indicates 10 foot intervals measured along "E" Line.
 3. Contour interval = 0.2'
 4. Contours do not include camber or falsework settlement.

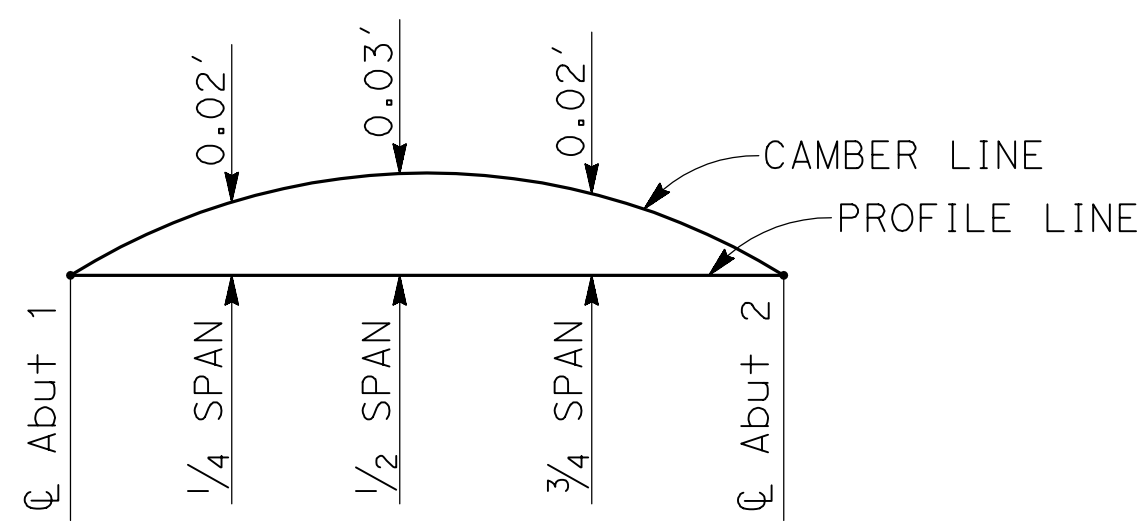

NOTE:
Camber does not include allowance for falsework settlement

CAMBER DIAGRAM
NO SCALE

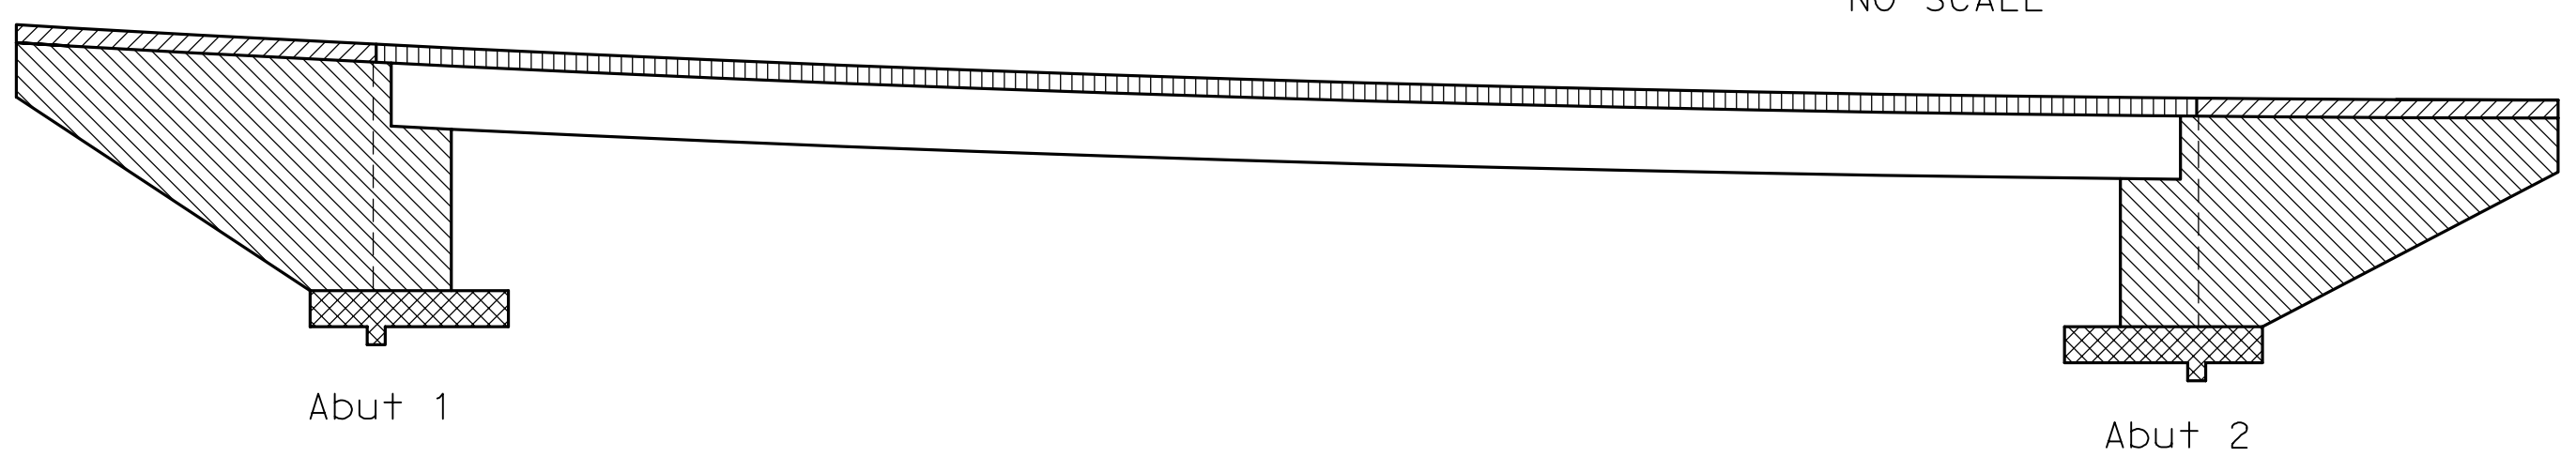

- LEGEND:
- STRUCTURAL CONCRETE, BRIDGE (f'c = 4.0 ksi AT 28 DAYS)
 - STRUCTURAL CONCRETE, BRIDGE
 - STRUCTURAL CONCRETE, BRIDGE FOOTING
 - STRUCTURAL CONCRETE, BRIDGE (POLYMER FIBER) (f'c = 4.0 ksi AT 28 DAYS)
 - STRUCTURAL CONCRETE, APPROACH SLAB

CONCRETE STRENGTH AND TYPE LIMITS
NO SCALE

NOTE:
THE CONTRACTOR MUST VERIFY ALL CONTROLLING FIELD DIMENSIONS BEFORE ORDERING OR FABRICATING ANY MATERIAL

- LEGEND:
- Indicates Standard Plan sheet No.
 - Indicates Detail No.
 - Indicates Section No.
 - Indicates sheet No. shown on
 - Indicates Detail No.
 - Indicates sheet No. shown on

GENERAL NOTES
LOAD & RESISTANCE FACTOR DESIGN


DESIGN: AASHTO LRFD Bridge Design Specifications, 6th Edition and California Amendments, preface dated January 2014

SEISMIC DESIGN: Caltrans Seismic Design Criteria (SDC) Version 1.7

DEAD LOAD: Includes 35 psf for future wearing surface.

LIVE LOAD: HL93 and permit design load

SEISMIC LOAD: Soil profile: C, Vs30 = 500 m IS
Moment magnitude: M6.2
Peak ground acceleration: 0.22g

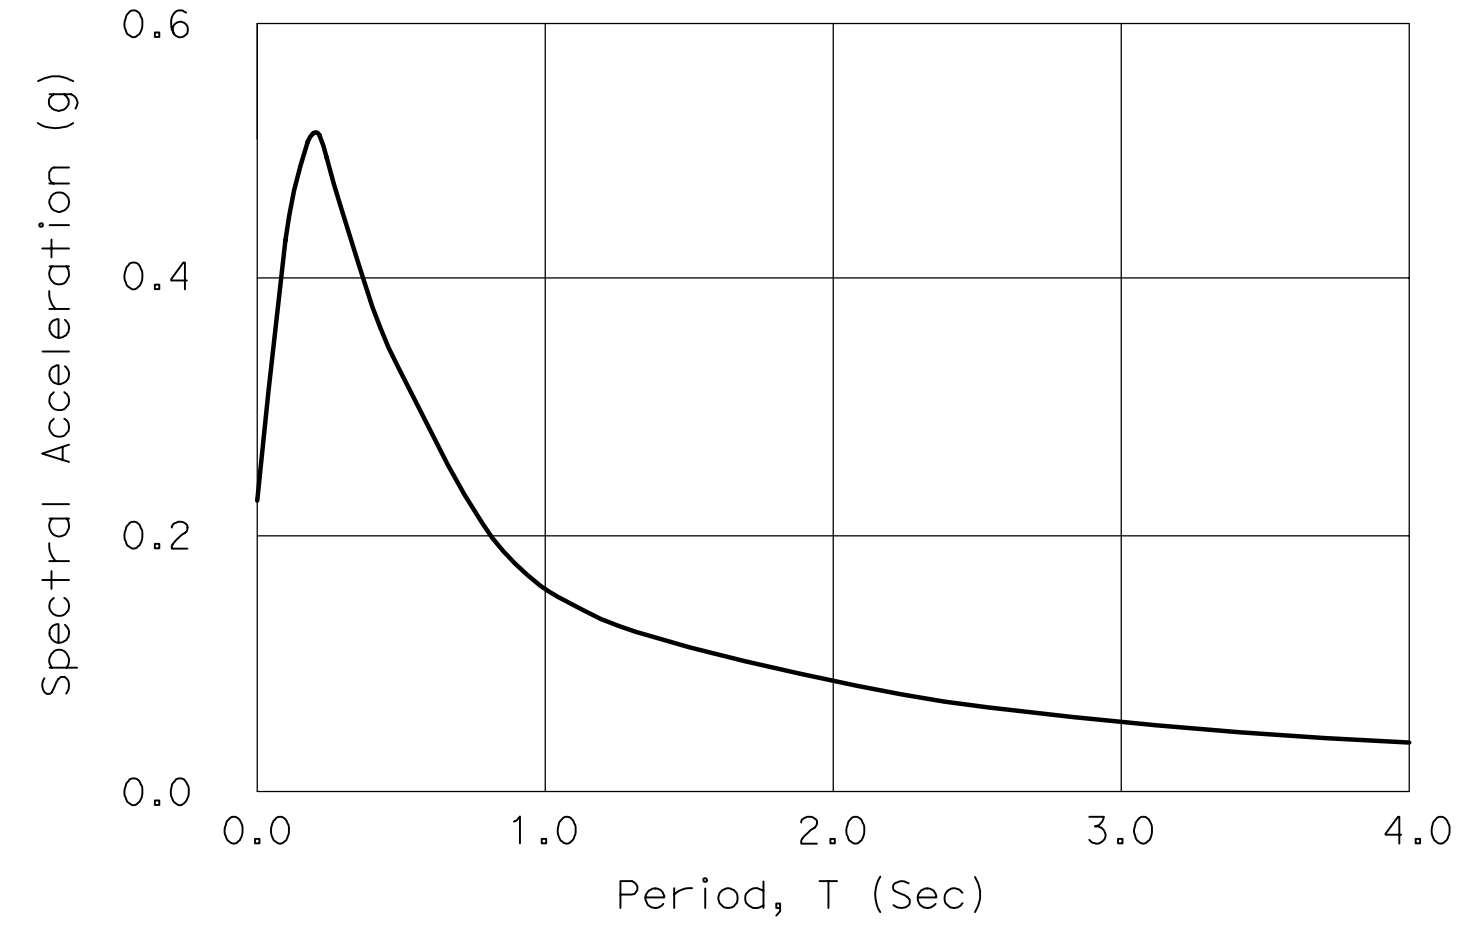

ARS DESIGN CURVE
NO SCALE

CONCRETE: f_y = 60 ksi
f'c = 3.6 ksi (except as shown on "CONCRETE STRENGTH & TYPE LIMITS" diagram)
n = 8

CALTRANS 2015 STANDARD PLANS


- A3A ABBREVIATIONS (SHEET 1 OF 3)
- A3B ABBREVIATIONS (SHEET 2 OF 3)
- A3C ABBREVIATIONS (SHEET 3 OF 3)
- A10A LEGEND-LINES AND SYMBOLS (SHEET 1 OF 5)
- RSP A10B LEGEND-LINES AND SYMBOLS (SHEET 2 OF 5)
- A10C LEGEND-LINES AND SYMBOLS (SHEET 3 OF 5)
- A10D LEGEND-LINES AND SYMBOLS (SHEET 4 OF 5)
- A10E LEGEND-LINES AND SYMBOLS (SHEET 5 OF 5)
- BO-1 BRIDGE DETAILS
- BO-5 BRIDGE DETAILS
- BO-13 BRIDGE DETAILS
- B6-21 JOINT SEALS (MAXIMUM MOVEMENT RATING = 2")
- B7-1 BOX GIRDER DETAILS
- RSP B8-5 CAST-IN-PLACE POST-TENSIONED GIRDER DETAILS
- B14-5 WATER SUPPLY LINE (DETAILS) (PIPE SIZES LESS THAN 4")

CALTRANS 2018 STANDARD PLANS

- RSP B11-79 CONCRETE BARRIER TYPE 836 DETAILS No. 1
- RSP B11-80 CONCRETE BARRIER TYPE 836 DETAILS No. 2


DESIGNED: SGS	DATE: 1/25/21	RECORD DRAWING: RESIDENT ENGINEER	SCALE: AS SHOWN	PROJECT: SAND CREEK BRIDGE REPLACEMENT ON ENNIS ROAD		DEPARTMENT OF PUBLIC WORKS AND PLANNING
DRAWN: SMH	DATE: 1/25/21			ROAD NO. 2824-2825 BRIDGE NO. 42C0697, BRLO-5942(238)		DECK CONTOURS
CHECKED: ML	DATE: 1/25/21					DRAWING NO. 11257 SHEET NO. 19 TOTAL 31

FOR ACCURATE RIGHT OF WAY AND ACCESS DATA, SEE 'ROADWAY PLANS'

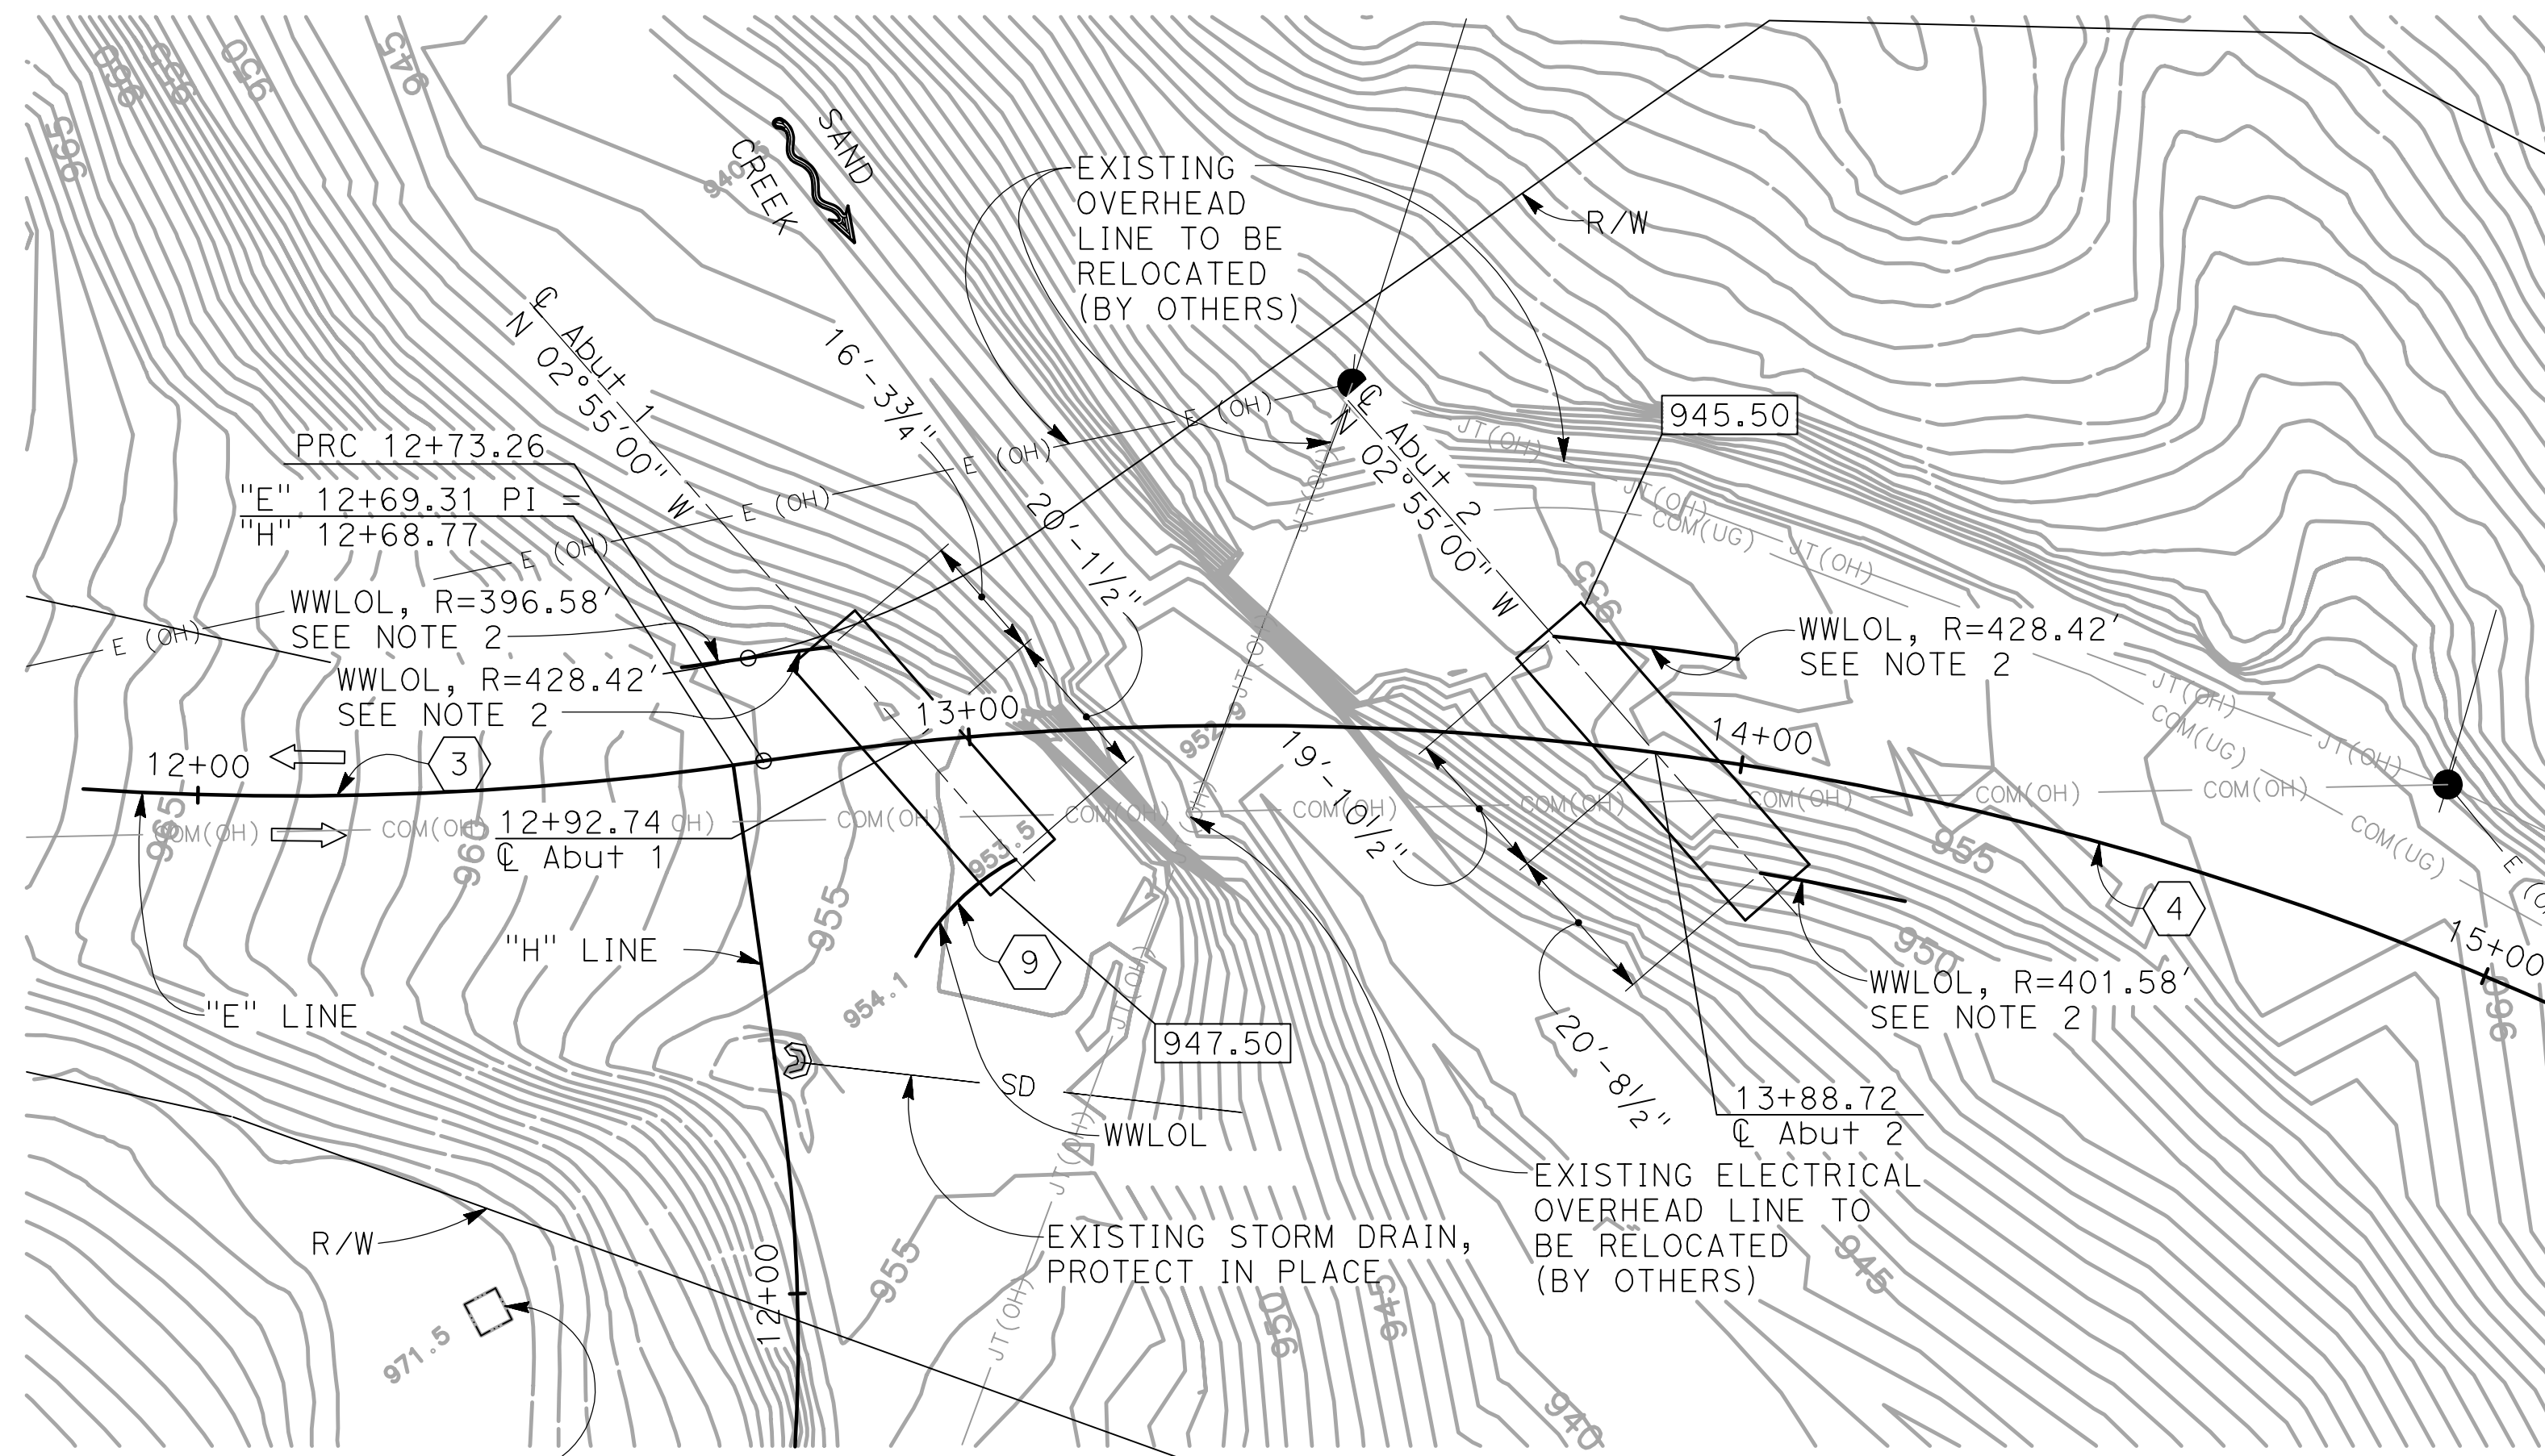

FOUNDATION PLAN

1" = 20'

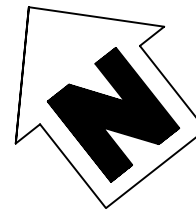

SPREAD FOOTING DATA TABLE

LOCATION	SERVICE ² PERMISSIBLE NET CONTACT STRESS (SETTLEMENT) (ksf)	STRENGTH / CONSTRUCTION ³ FACTORED GROSS NOMINAL BEARING RESISTANCE $\phi_b = 0.45$ (ksf), SEE NOTE 4	EXTREME EVENT ³ FACTORED GROSS NOMINAL BEARING RESISTANCE $\phi_h = 1.00$ (ksf)
ABUTMENT 1	9.0	28.0	N/A
ABUTMENT 2	9.0	28.0	N/A

NOTES:


- Controlling load combination is the one resulting in the highest ratio of q_{gu}/q_R for foundations on soil, or $q_{g \max}/q_R$ for foundation on rock.
- Controlling load combination for Service Limit State is the one resulting in the highest ratio of q_{nu}/q_{pn} for foundations on soil, or $q_{g \max}/q_R$ for foundations on rock.
- Controlling load combination for Strength, Construction, and Extreme Event is the one resulting in the highest ratio of q_{gu}/q_R for foundations on soil, or $q_{g \max}/q_R$ for foundations on rock.
- The value below is the Gross Nominal Bearing Capacity. The Resistance Factor of 0.45 has not been applied.

NOTE:
THE CONTRACTOR MUST VERIFY ALL CONTROLLING FIELD DIMENSIONS BEFORE ORDERING OR FABRICATING ANY MATERIAL

Curve Data Layout Line	Curve Data Layout Line	Curve Data Layout Line	Curve Data Layout Line
R = 410'	R = 415'	R = 33'	R = 31.58'
$\Delta = 31^\circ 10' 58''$	$\Delta = 38^\circ 18' 08''$	$\Delta = 95^\circ 16' 50''$	$\Delta = 33^\circ 02' 06''$
T = 114.41'	T = 144.12'	T = 36.19'	T = 9.37'
L = 223.14'	L = 277.43'	L = 54.88'	L = 18.21'


NOTES:
1. Verify utility locations with "ROADWAY PLANS".
2. WWLOL is concentric with "E" line.

LEGEND:
945.50 Indicates bottom of footing elevation
29.6 Indicates spot elevation

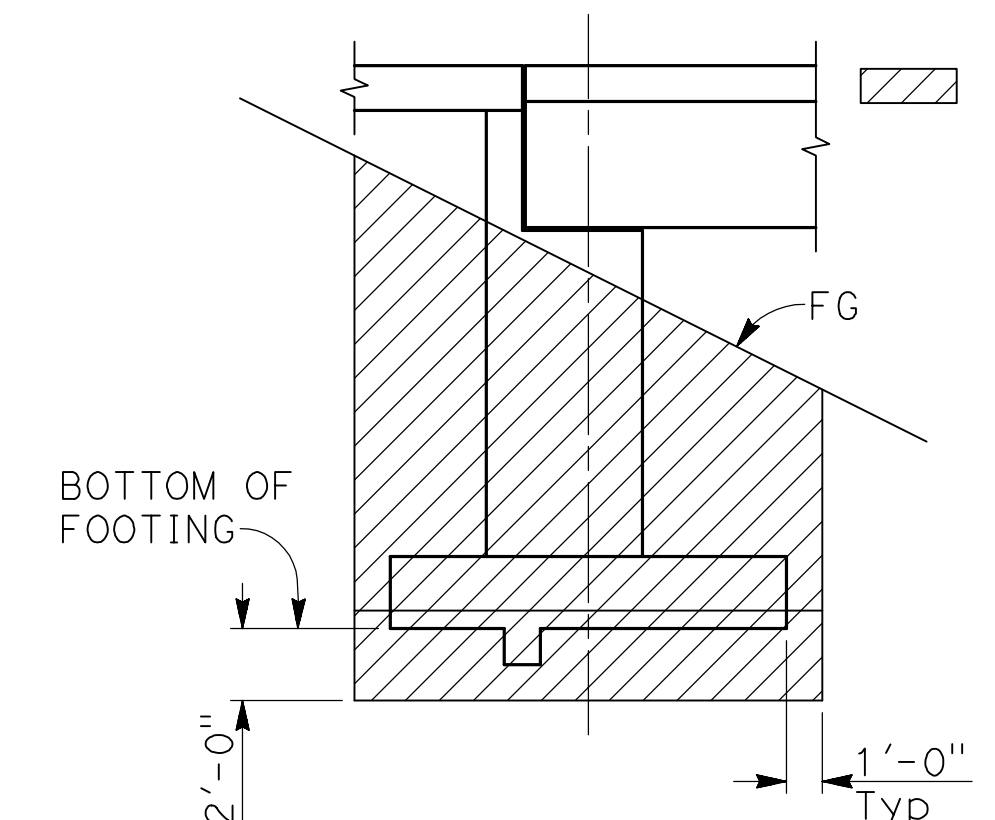

LIMITS OF PAYMENT FOR EXCAVATION

NO SCALE

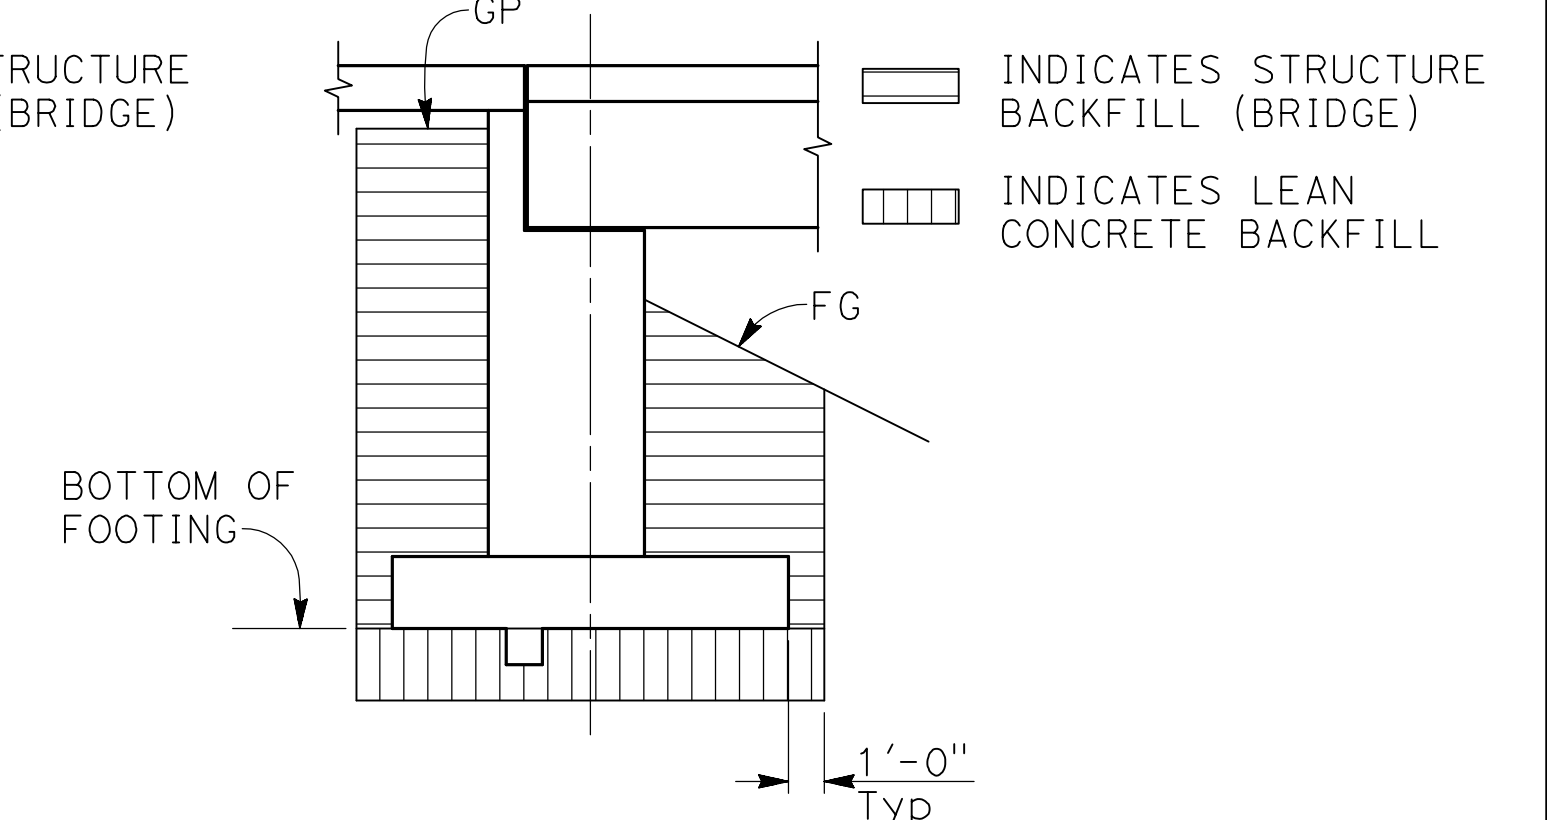

LIMITS OF PAYMENT FOR BACKFILL

NO SCALE

HYDROLOGIC SUMMARY

(PROVIDED BY AVILA & ASSOCIATES - 11/6/2019)

DRAINAGE AREA: 18.2 SQUARE MILES	DESIGN FLOOD FREQUENCY (YEARS)	DESIGN FLOOD DISCHARGE (CUBIC FEET PER SECOND)	DESIGN FLOOD WATER SURFACE (ELEVATION AT BRIDGE)
	50	2770	950.2
	100	3345	951.2

FLOOD PLAIN DATA ARE BASED UPON INFORMATION AVAILABLE WHEN THE PLANS WERE PREPARED AND ARE SHOWN TO MEET FEDERAL REQUIREMENTS. THE ACCURACY OF SAID INFORMATION IS NOT WARRANTED BY BIGGS CARDOSA ASSOCIATES AND INTERESTED OR AFFECTED PARTIES SHOULD MAKE THEIR OWN INVESTIGATION.

BENCH MARK AND DATUM

MONUMENT	COORDINATES		ELEVATION	DESCRIPTION/LOCATION
	NORTHING	EASTING		
HN1G	2002915.567	6372176.001	252.141	COORDINATE VALUES WERE GPS DERIVED IN CALIFORNIA STATE PLAN COORDINATES, ZONE 4, EPOCH 2011 (NAD83) USING CSDS CONTINUALLY MONITORING STATION "HN1G", LOCATED IN HANFORD, CA VERTICAL DATUM = NAVD 88


SCOUR DATA TABLE

SUPPORT No.	LONG TERM (DEGRADATION AND CONTRACTION) SCOUR ELEVATION (ft)	SHORT TERM (LOCAL) SCOUR DEPTH (ft)
ABUTMENT 1	N/A	N/A
ABUTMENT 2	N/A	N/A


* FOUNDATION IS EMBEDDED INTO ROCK. NO SCOUR ANALYSIS REQUIRED.

DESIGNED: SGS	DATE: 1/25/21	RECORD DRAWING: RESIDENT ENGINEER	SCALE: AS SHOWN
DRAWN: AR	1/25/21		
CHECKED: ML	1/25/21		


PROJECT: SAND CREEK BRIDGE REPLACEMENT ON ENNIS ROAD
ROAD NO. 2824-2825 BRIDGE NO. 42C0697, BRLO-5942(238)

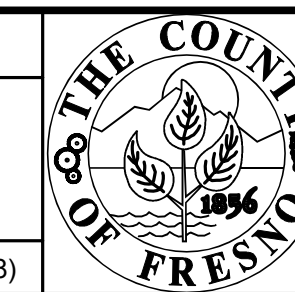


DEPARTMENT OF PUBLIC WORKS AND PLANNING
FOUNDATION PLAN
DRAWING NO. 11257 SHEET NO. 20 TOTAL 31

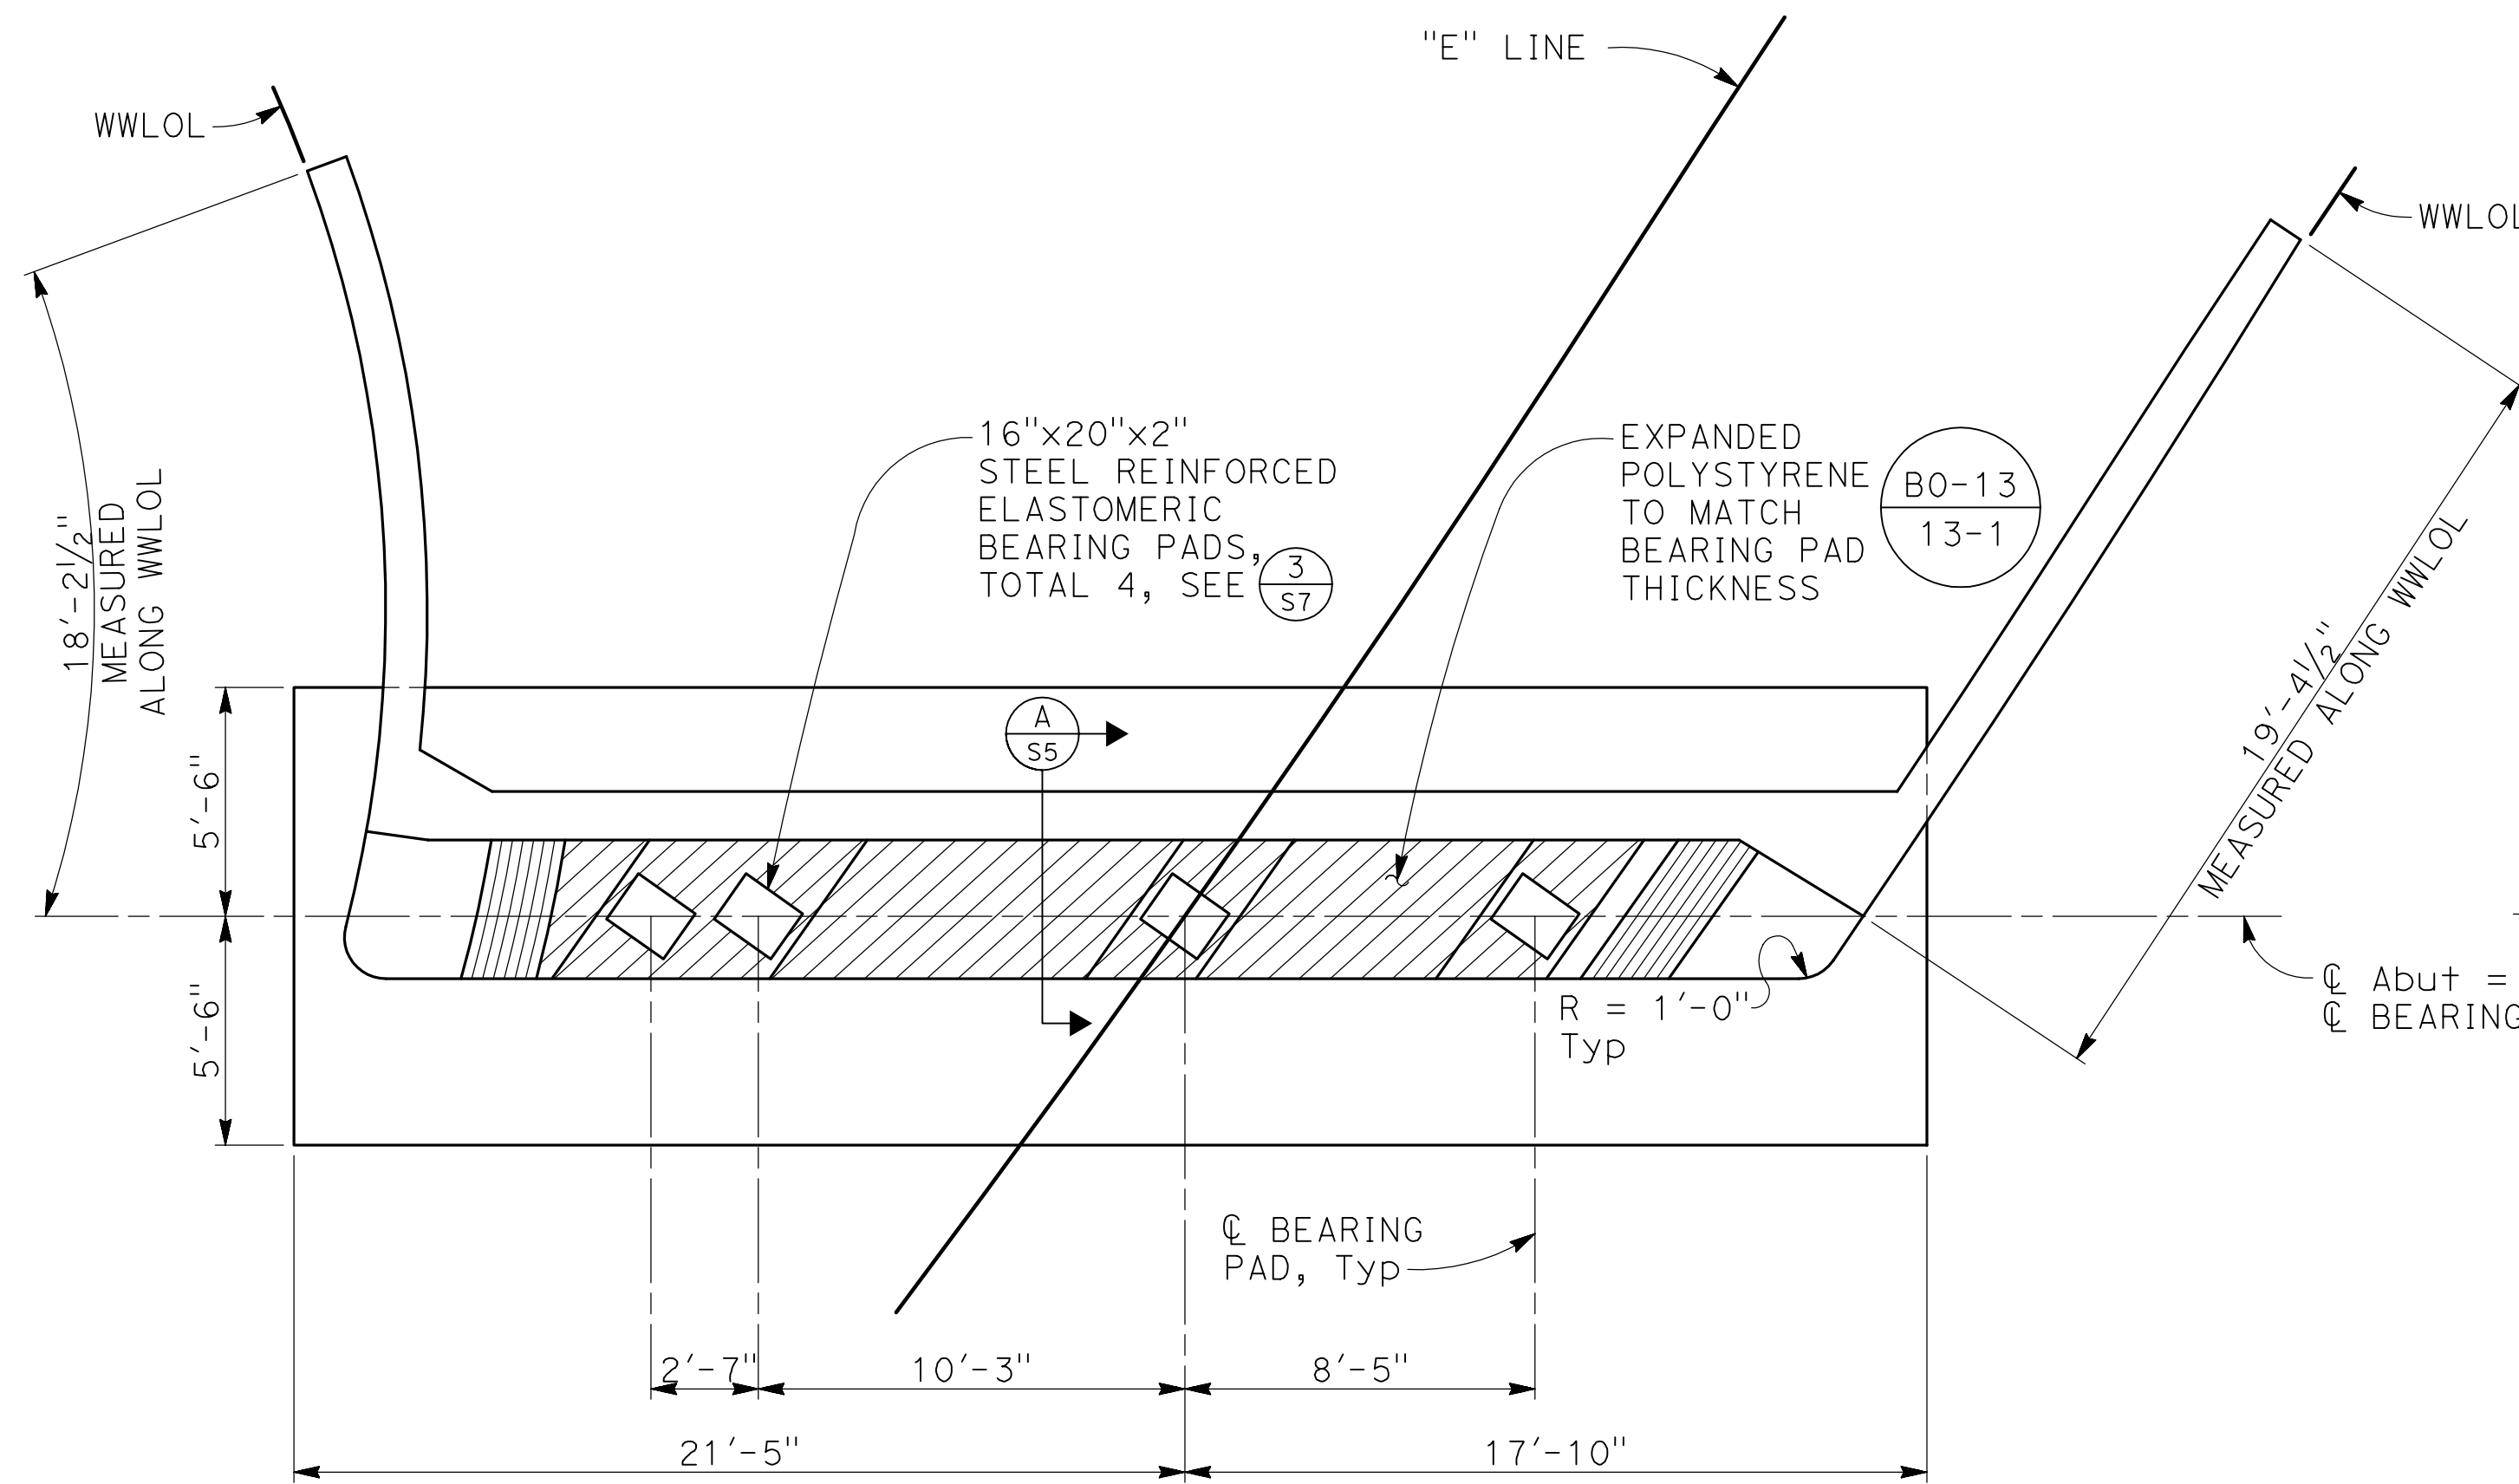


ABUTMENT 1 PLAN
1/4" = 1'-0"

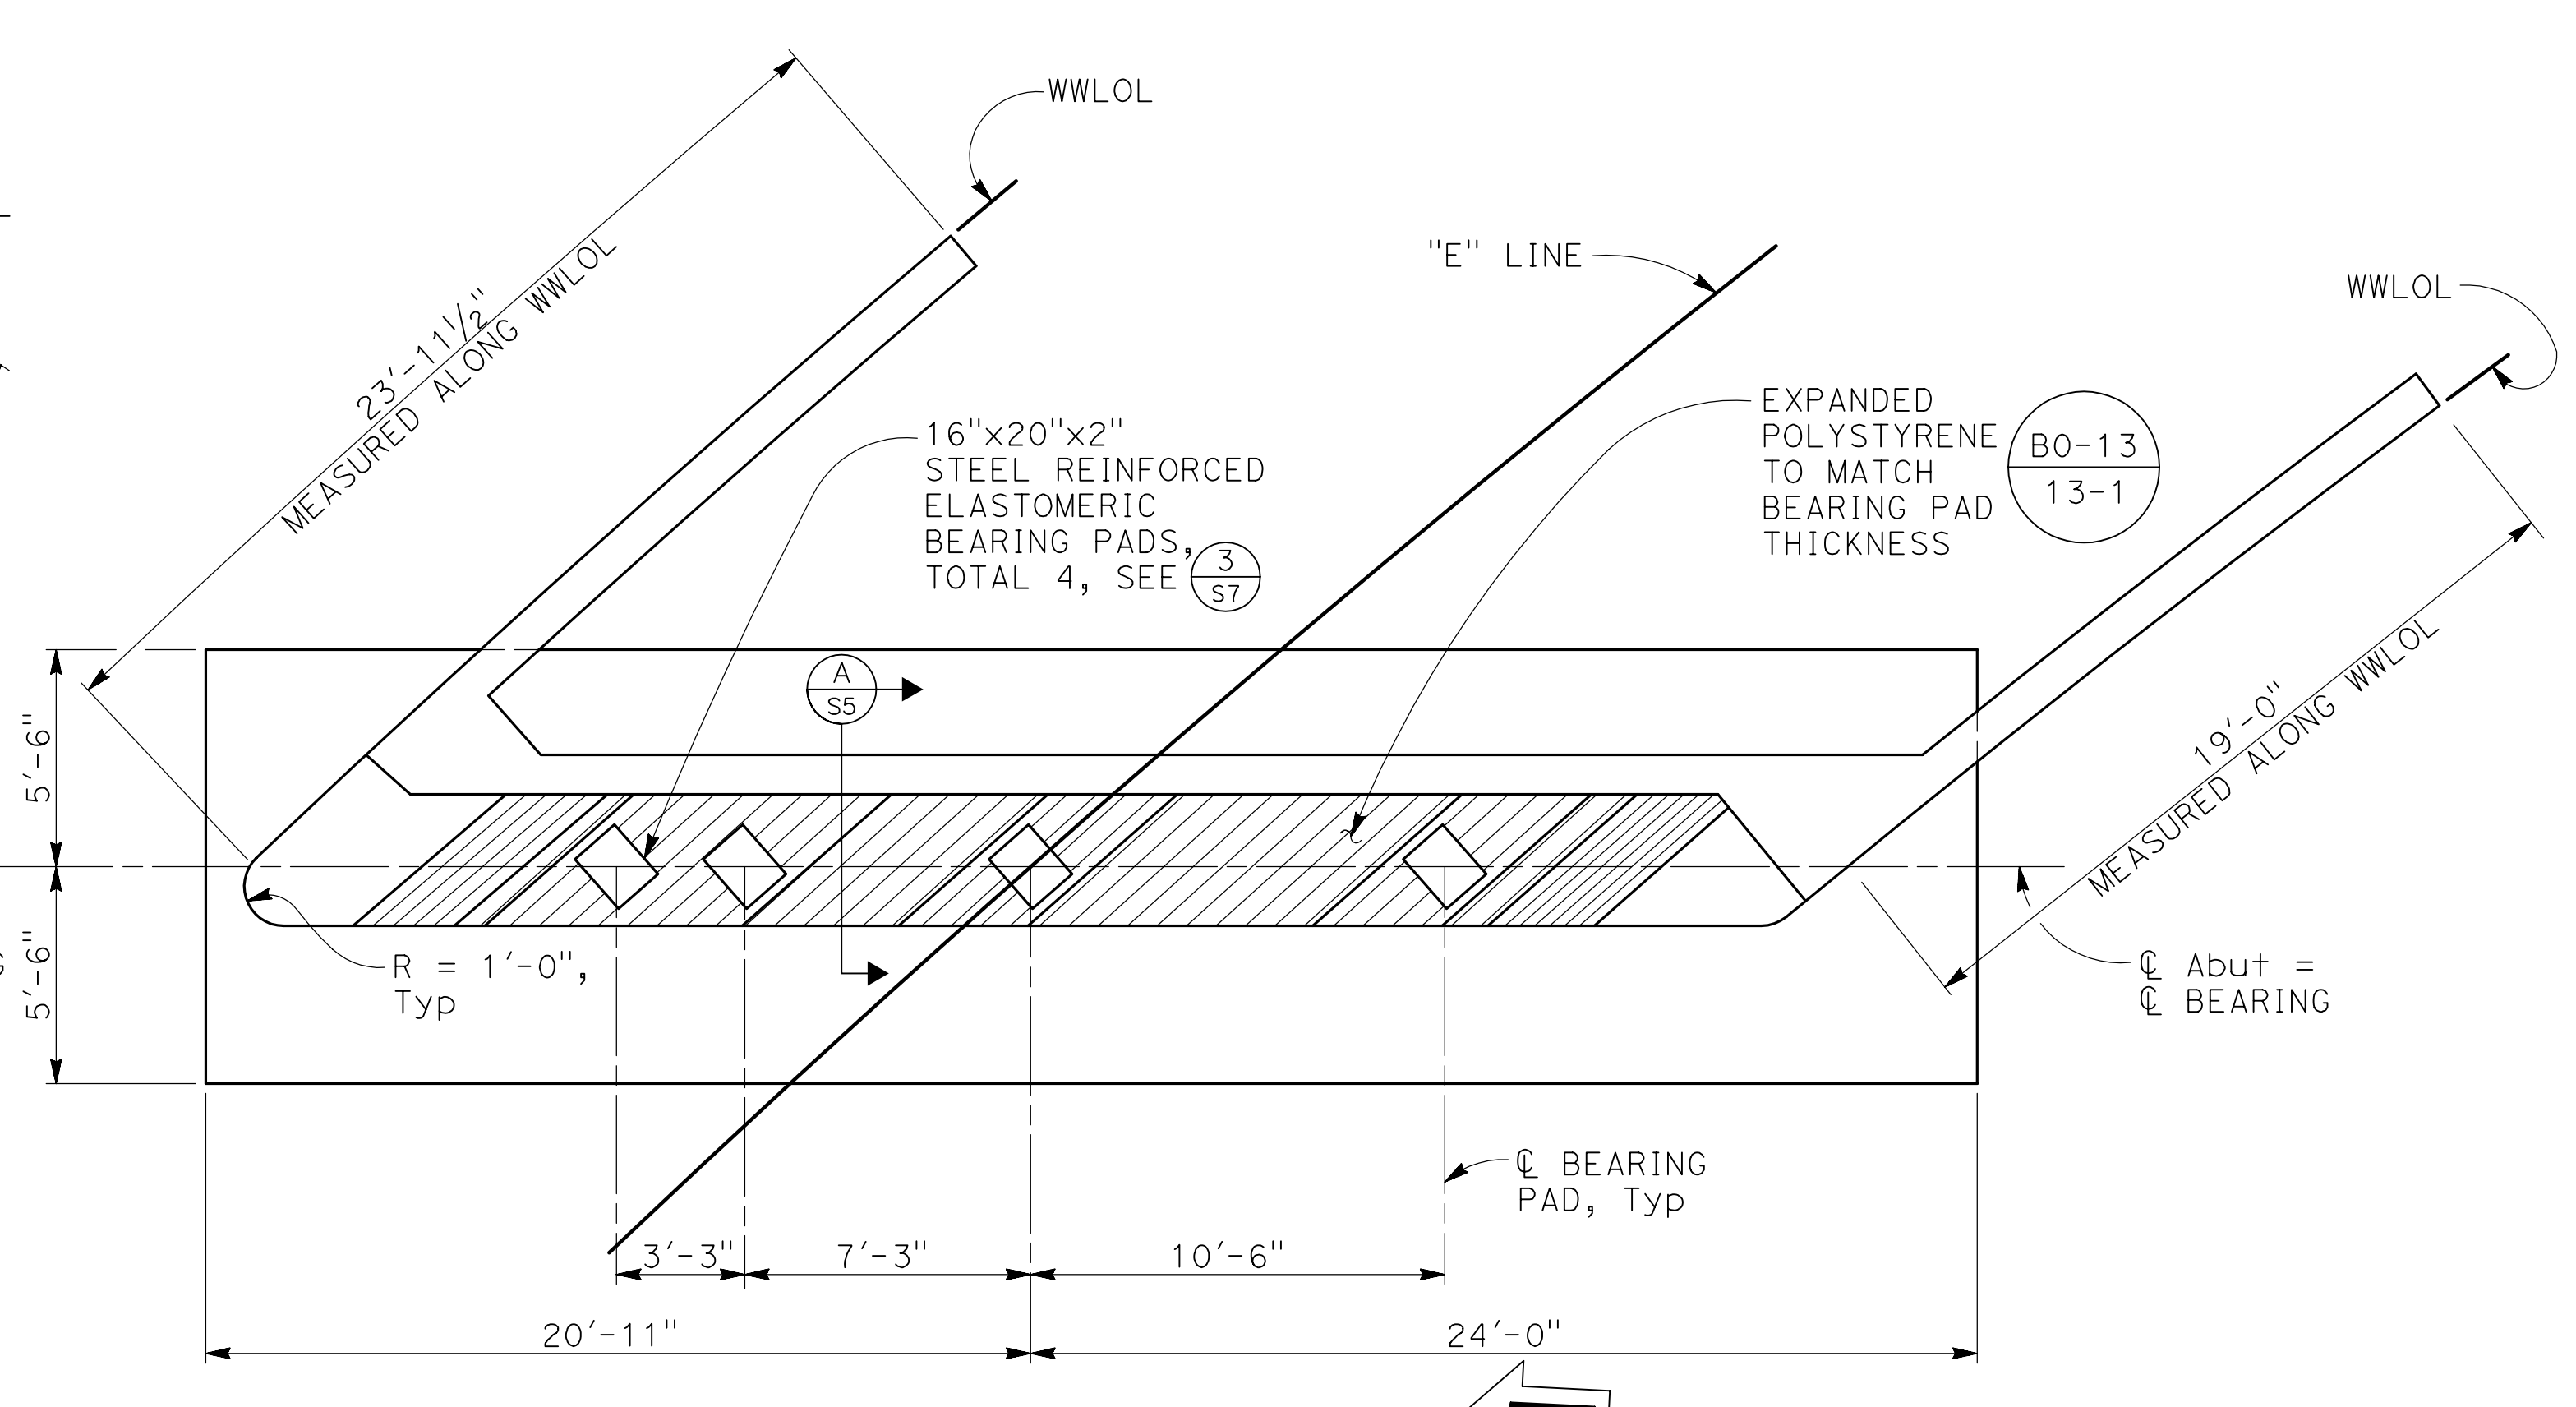

ABUTMENT 2 PLAN
1/4" = 1'-0"

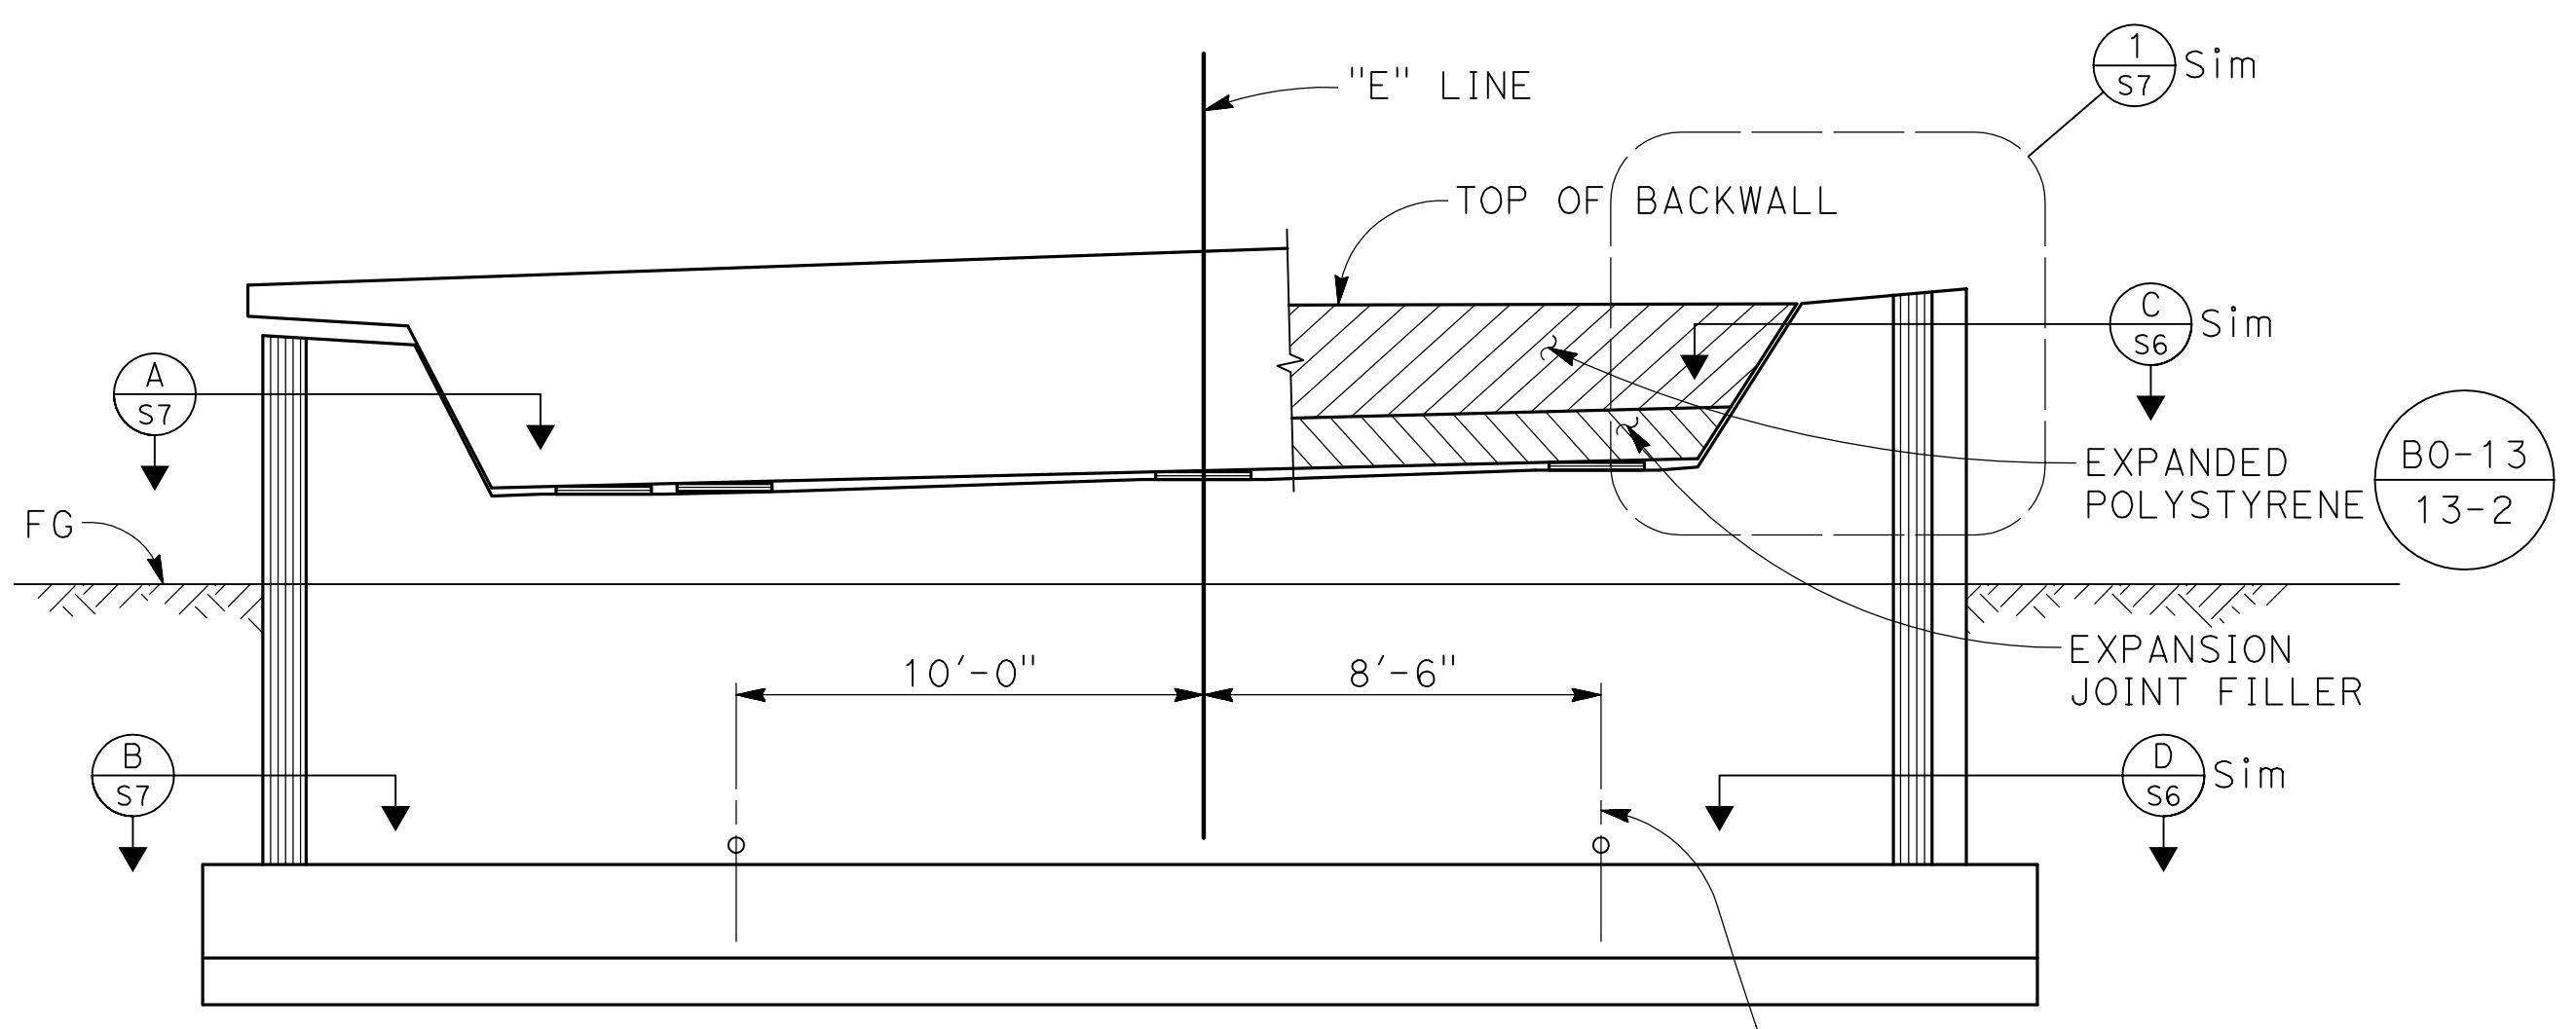

ABUTMENT 1 ELEVATION
1/4" = 1'-0"

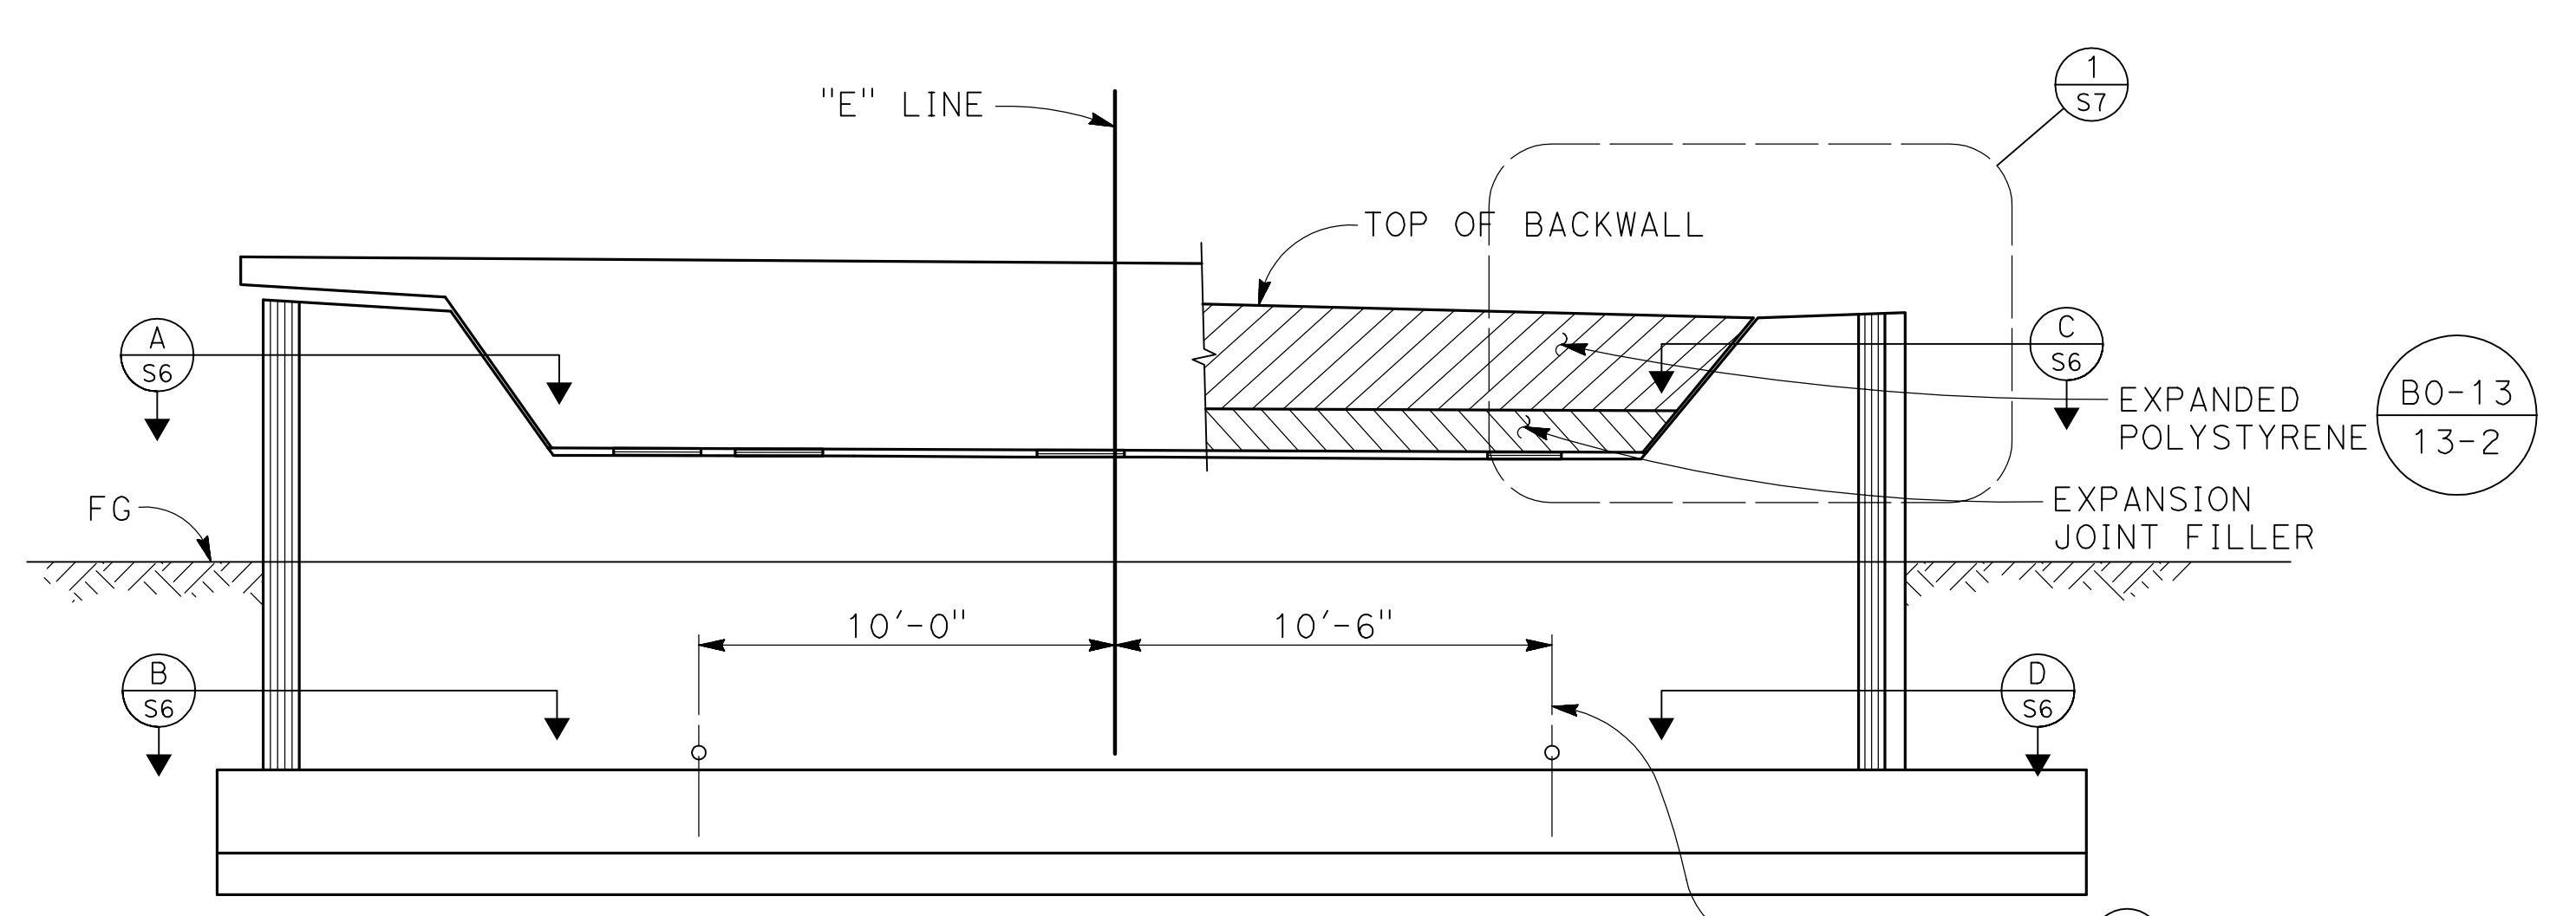


ABUTMENT 2 ELEVATION
1/4" = 1'-0"


NOTE:
THE CONTRACTOR MUST VERIFY ALL CONTROLLING FIELD DIMENSIONS BEFORE ORDERING OR FABRICATING ANY MATERIAL

DESIGNED: SGS		DATE: 1/25/21	RECORD DRAWING: RESIDENT ENGINEER		SCALE: AS SHOWN	PROJECT: SAND CREEK BRIDGE REPLACEMENT ON ENNIS ROAD			DEPARTMENT OF PUBLIC WORKS AND PLANNING	
DRAWN: AR		DATE: 1/25/21				ROAD NO. 2824-2825 BRIDGE NO. 42C0697, BRLO-5942(238)			ABUTMENT LAYOUT	
CHECKED: ML		DATE: 1/25/21				DRAWING NO. 11257 SHEET NO. 21 TOTAL 31				

THESE PLANS ARE FOR THE CONTRACTOR'S INFORMATION ONLY. THEY ARE NOT TO BE CONSIDERED TO BE PART OF THE CONTRACT DOCUMENTS AND SHALL HAVE NO BEARING WHATSOEVER ON THE INTERPRETATION OF THE STANDARD SPECIFICATIONS, THE STANDARD PLANS, THE SPECIAL PROVISIONS, NOR SHALL THEY HAVE ANY BEARING WHATSOEVER ON THE INTERPRETATION OF THE OTHER PUBLICATIONS REFERENCED THEREIN

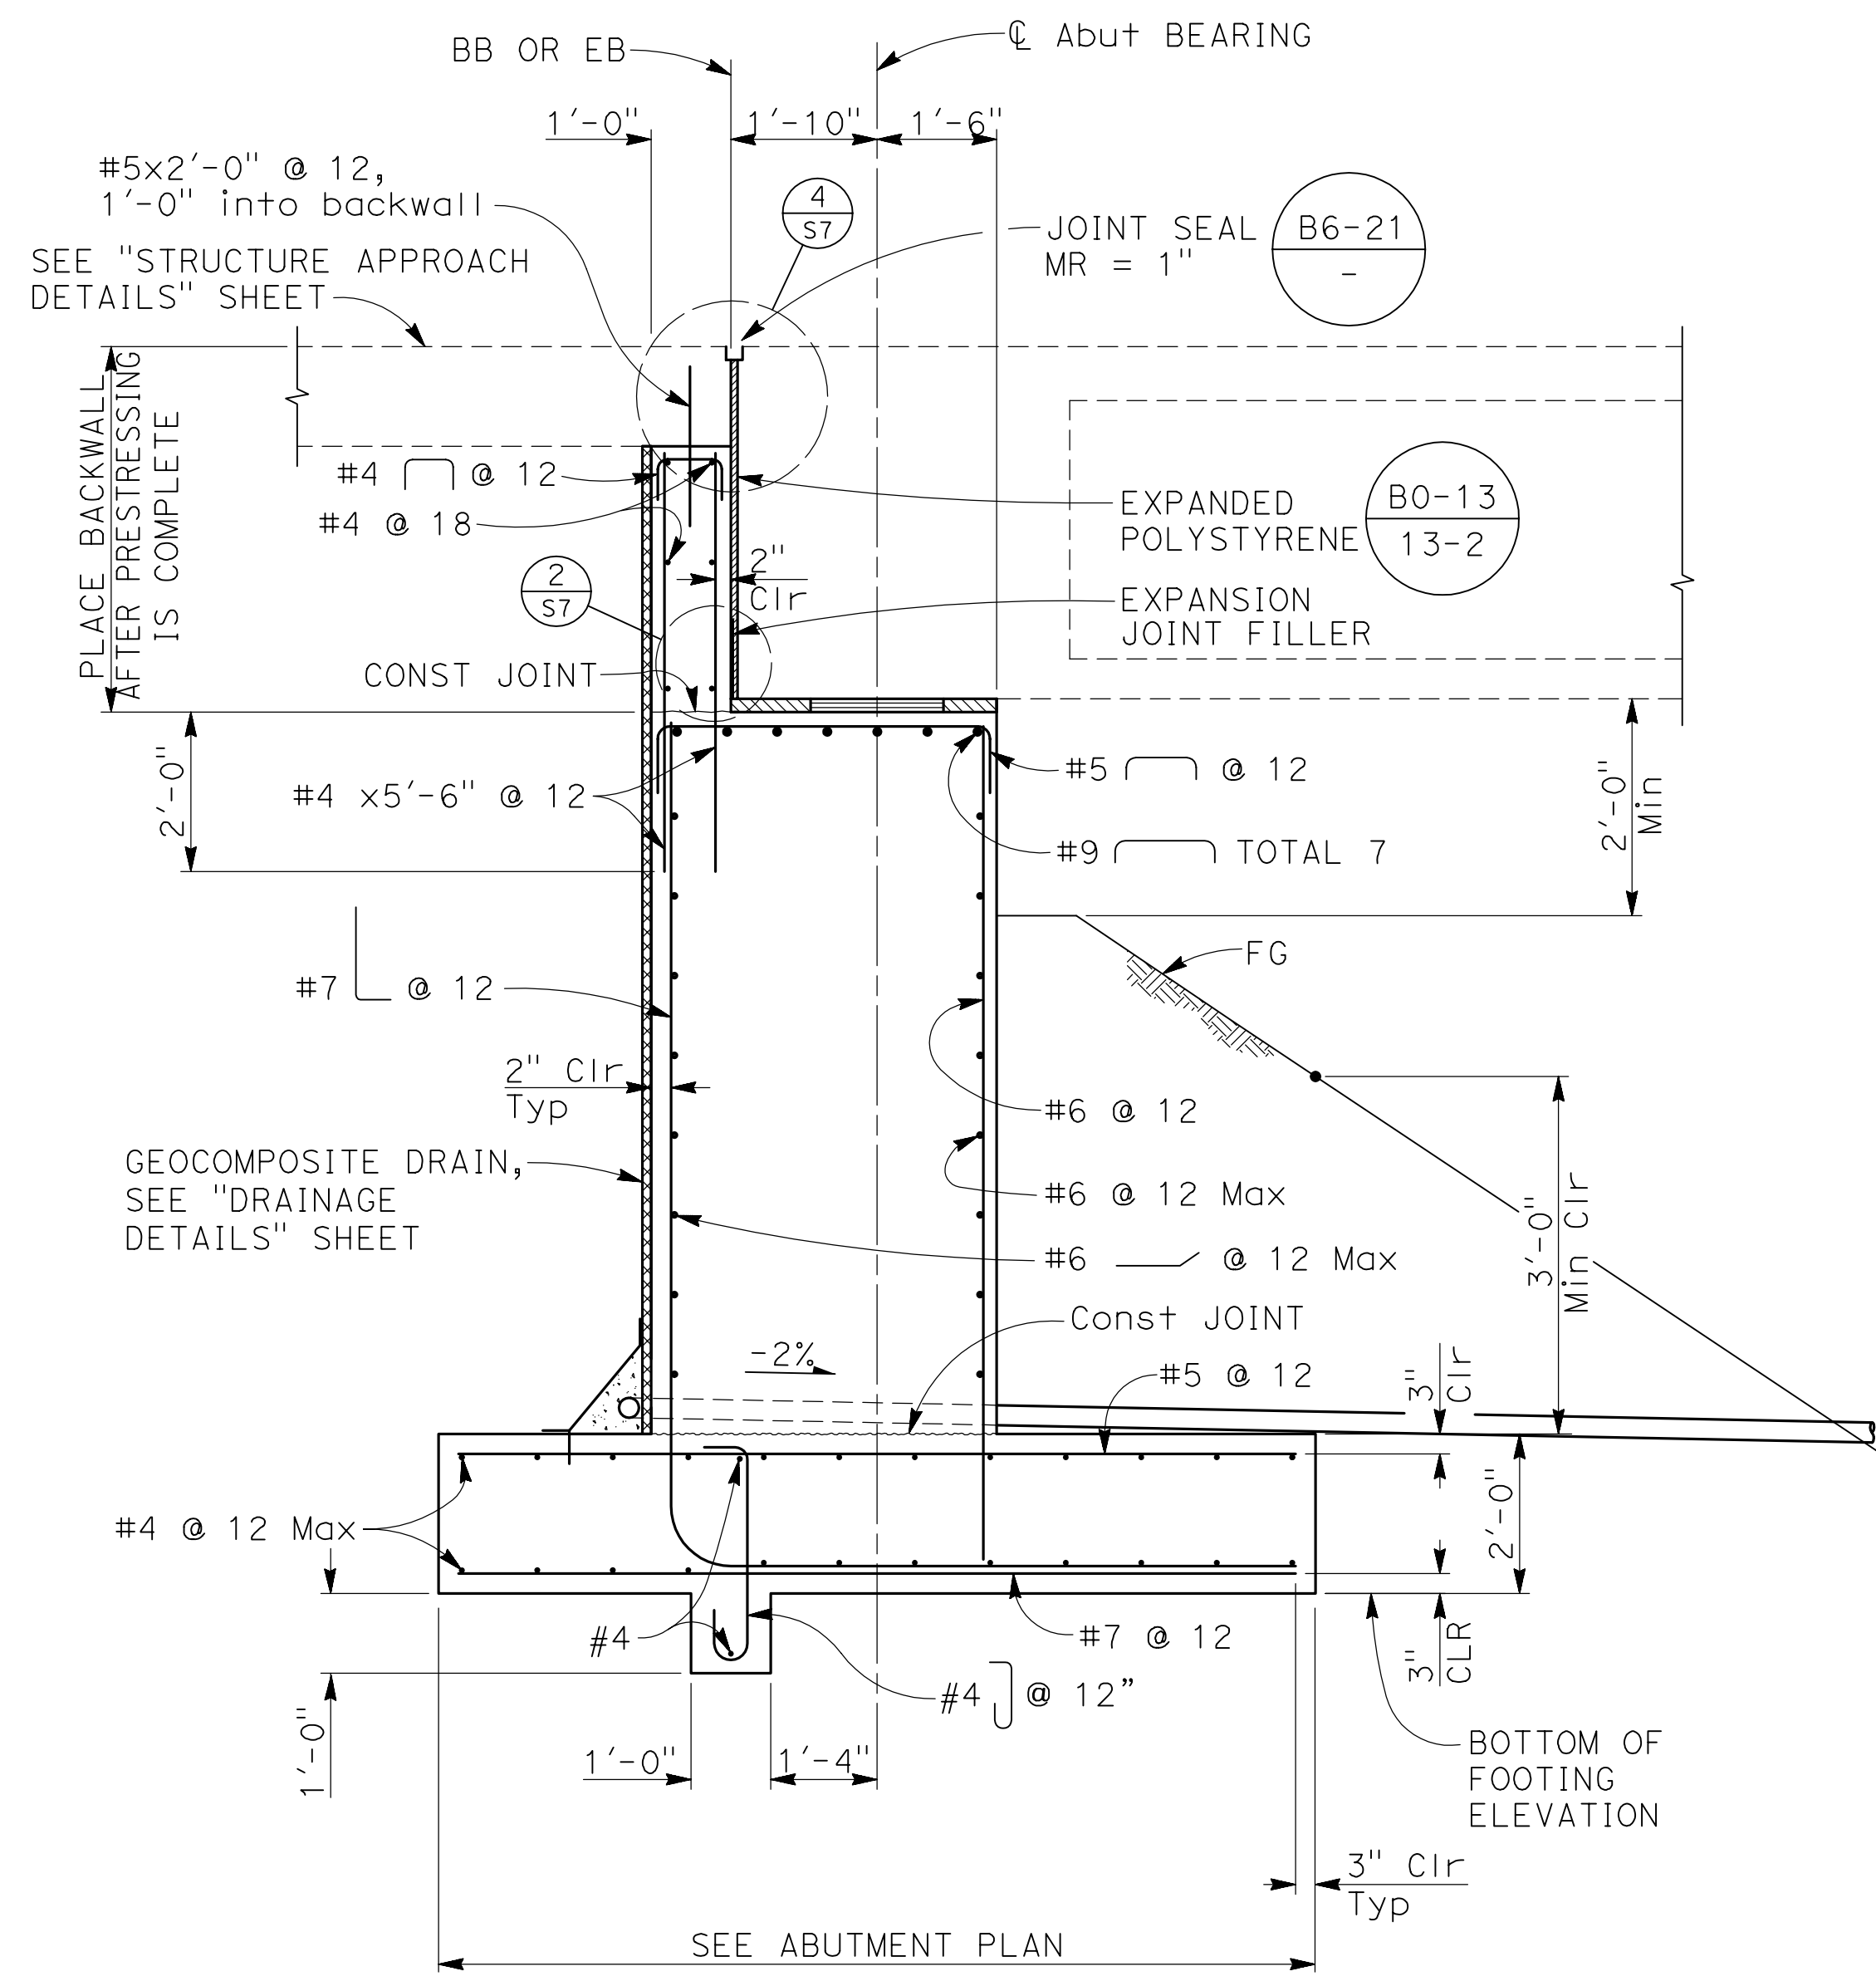

SECTION A
1/2" = 1'-0" (S5)

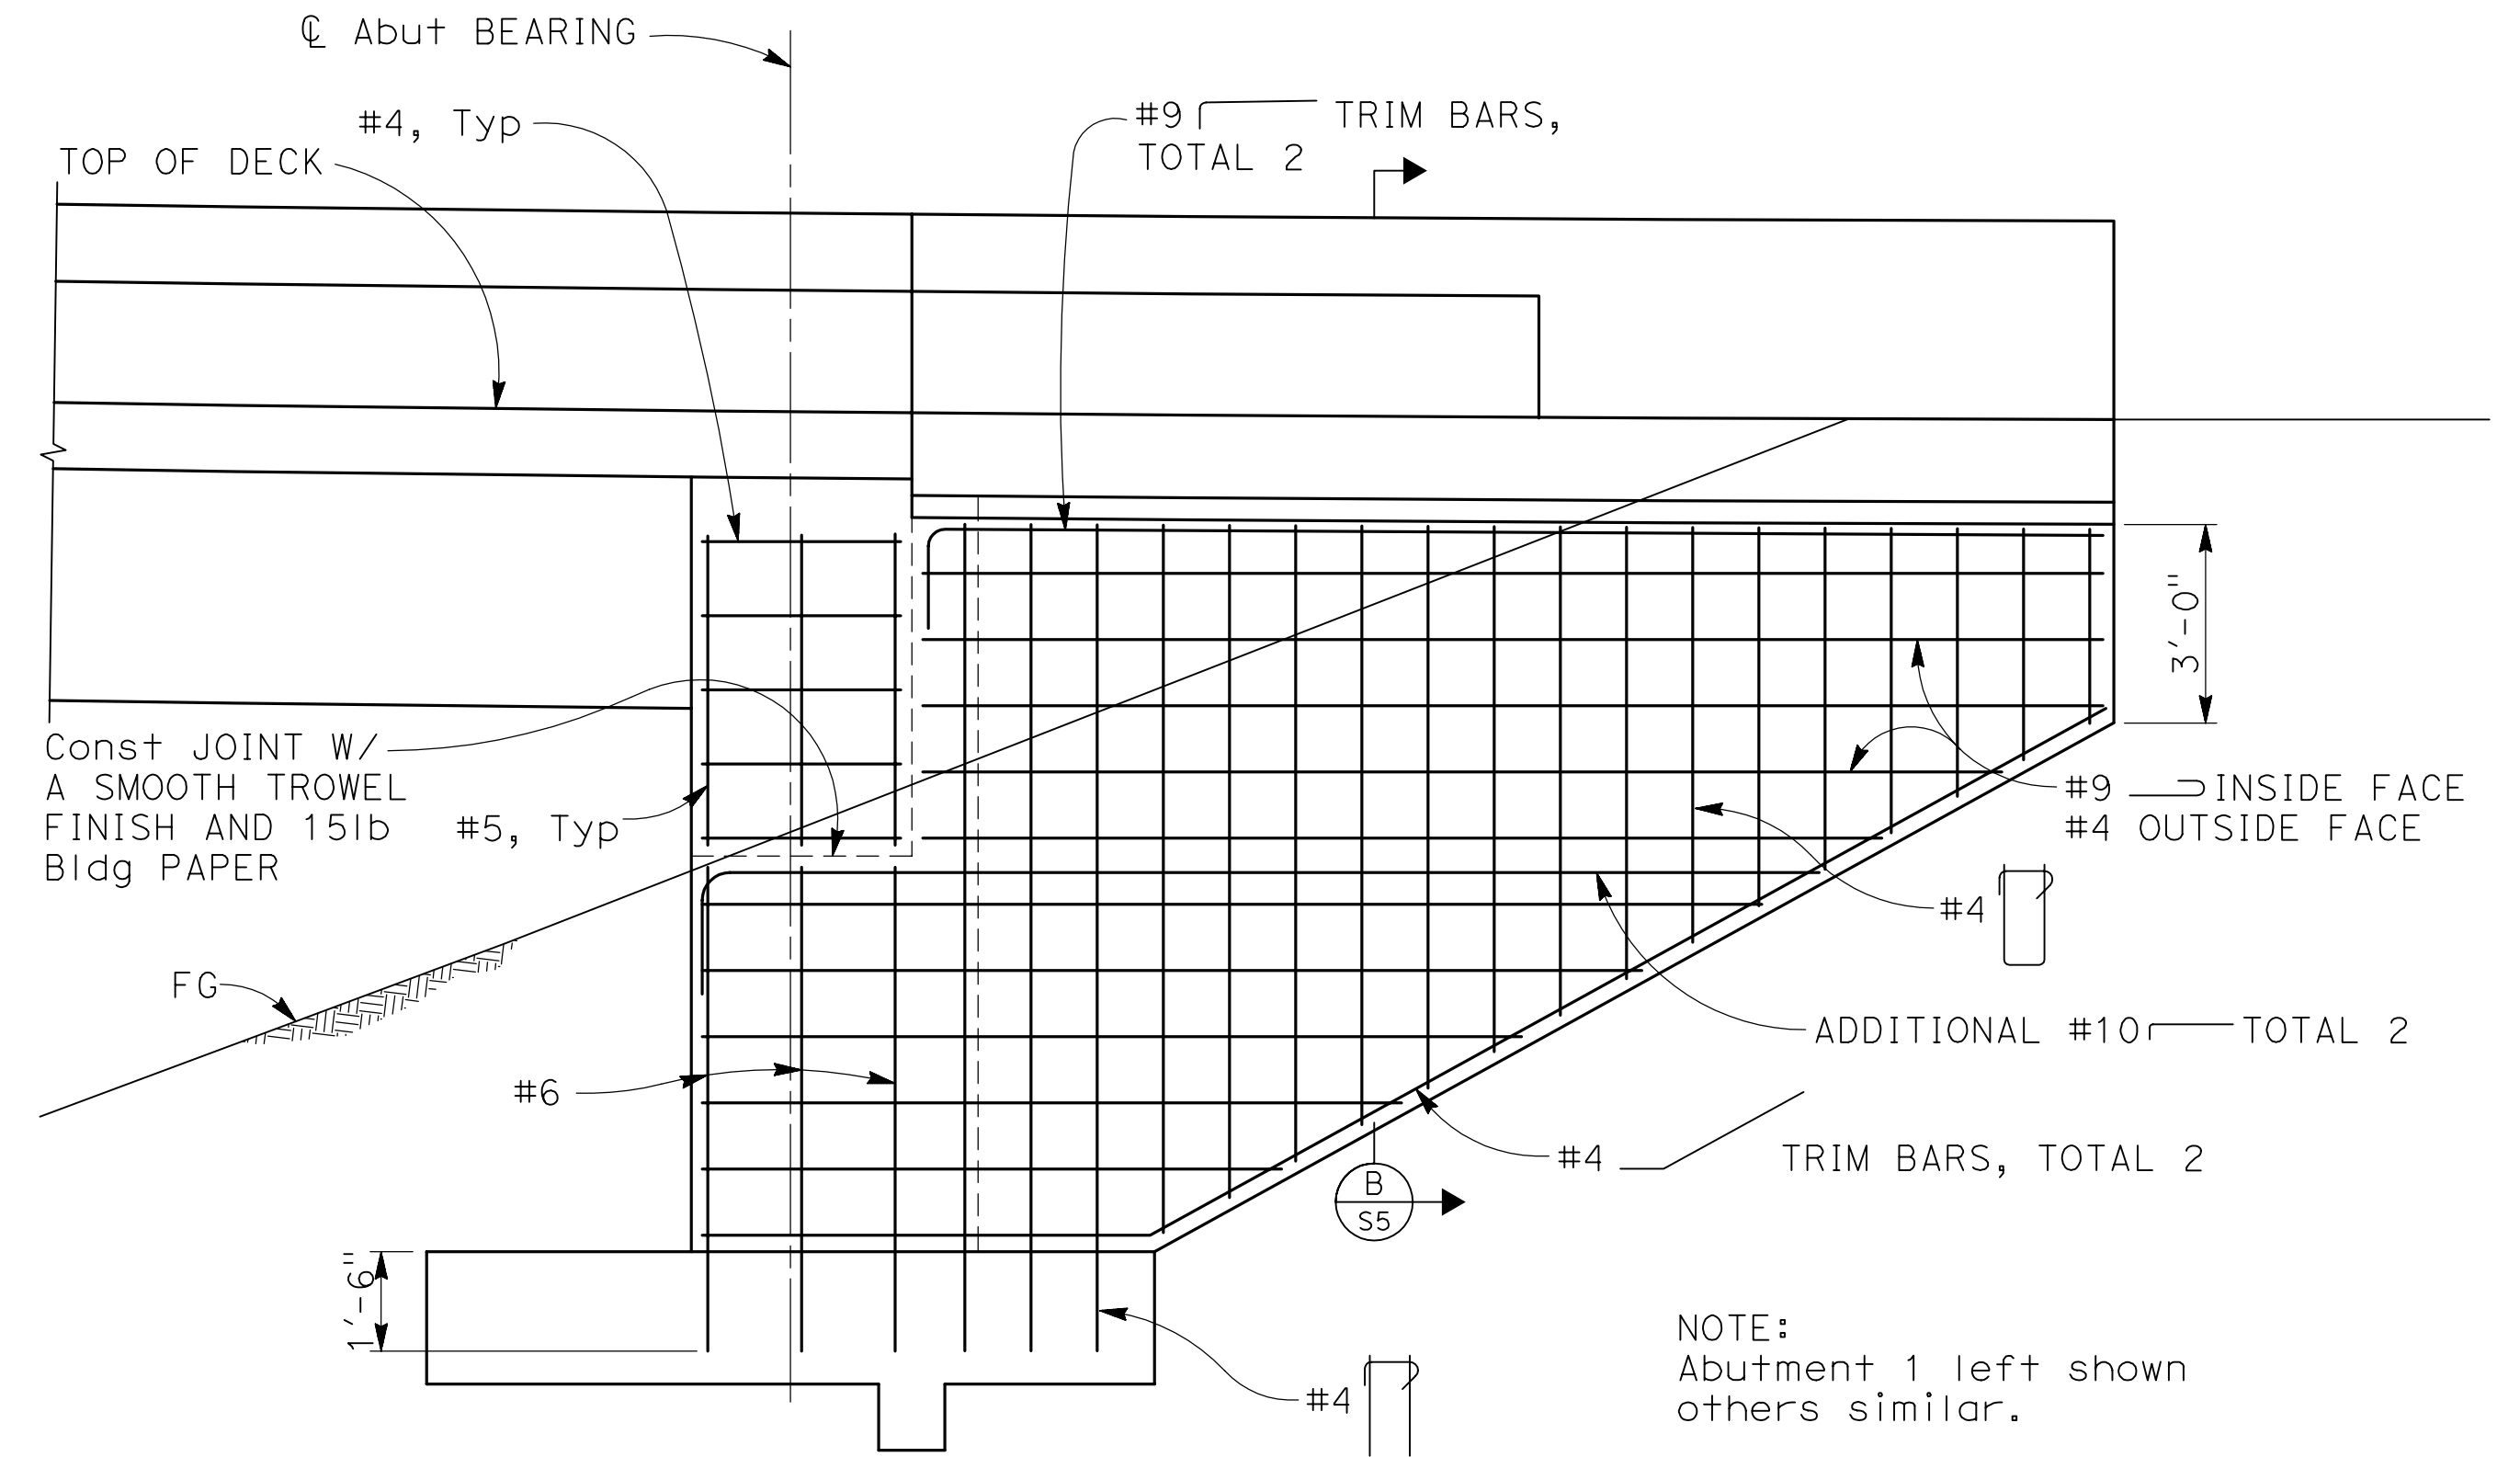


ABUTMENT WINGWALL ELEVATION

3/8" = 1'-0"

STRUCTURE APPROACH SLAB, SEE "STRUCTURE APPROACH DETAILS" SHEET





GEOCOMPOSITE DRAIN, SEE "DRAINAGE DETAILS" SHEET

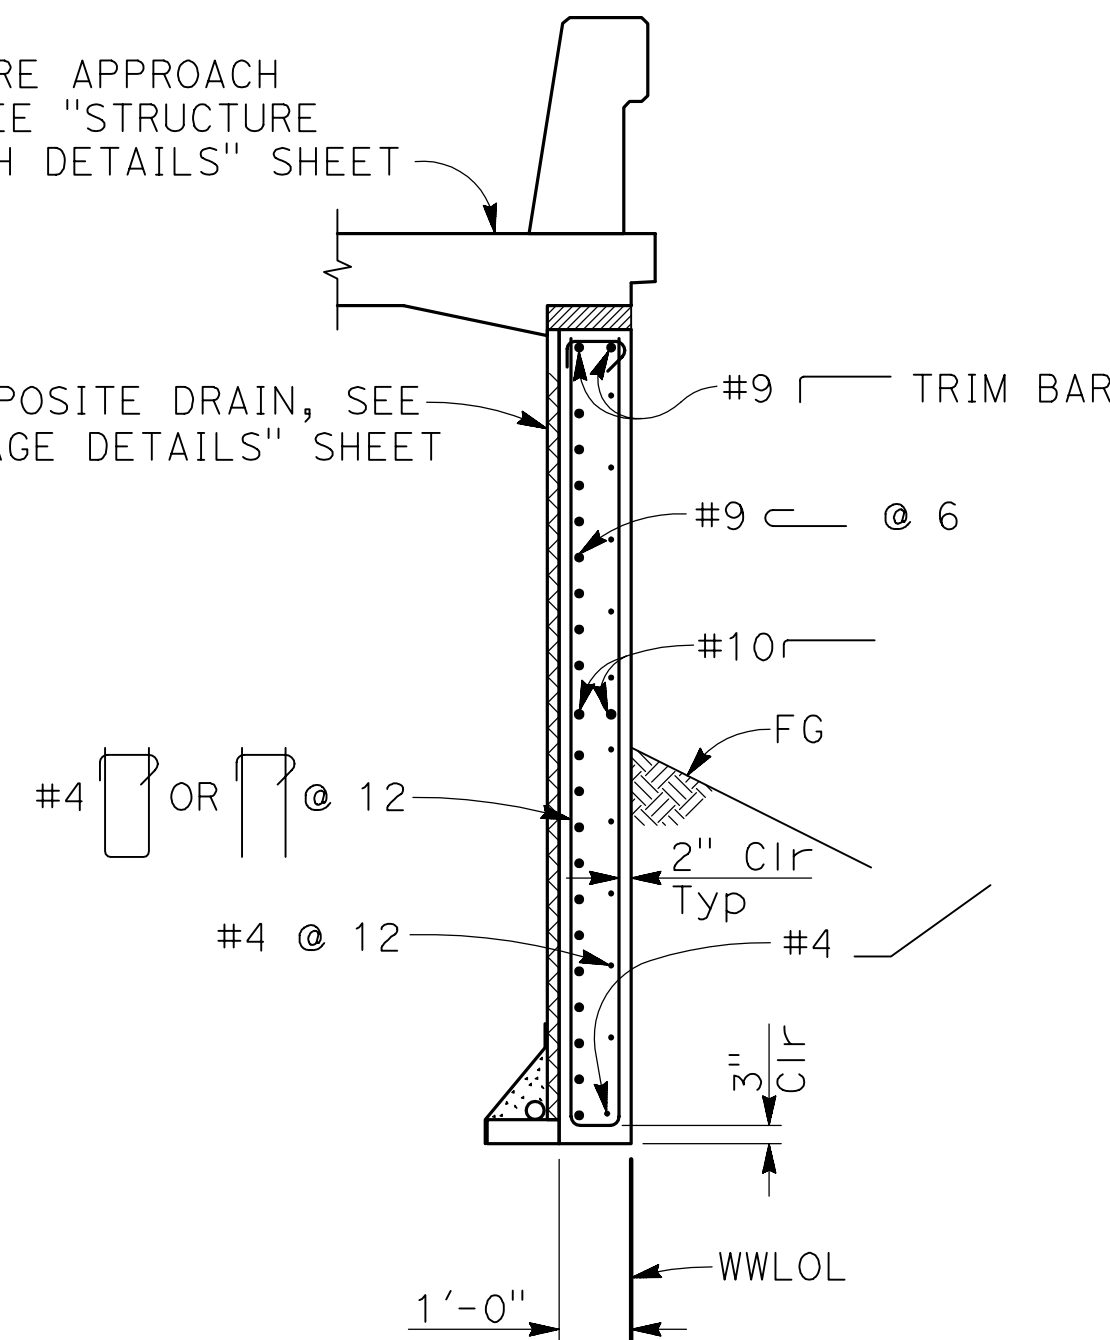

SECTION B
3/8" = 1'-0" (S5)

NOTE:
THE CONTRACTOR MUST VERIFY ALL CONTROLLING FIELD DIMENSIONS BEFORE ORDERING OR FABRICATING ANY MATERIAL


DATE		RECORD DRAWING		SCALE	PROJECT	DEPARTMENT OF PUBLIC WORKS AND PLANNING			
DESIGNED: SGS	1/25/21	RESIDENT ENGINEER	DATE	AS SHOWN	SAND CREEK BRIDGE REPLACEMENT ON ENNIS ROAD				
DRAWN: AR	1/25/21								
CHECKED: ML	1/25/21								
FOR RIGHT OF WAY DATA AND ACCURATE ACCESS DETERMINATION, SEE DOCUMENTS IN THE DEPARTMENT OF PUBLIC WORKS AND PLANNING.					ROAD NO. 2824-2825	BRIDGE NO. 42C0697, BRLO-5942(238)	DRAWING NO. 11257	SHEET NO. 22	TOTAL 31

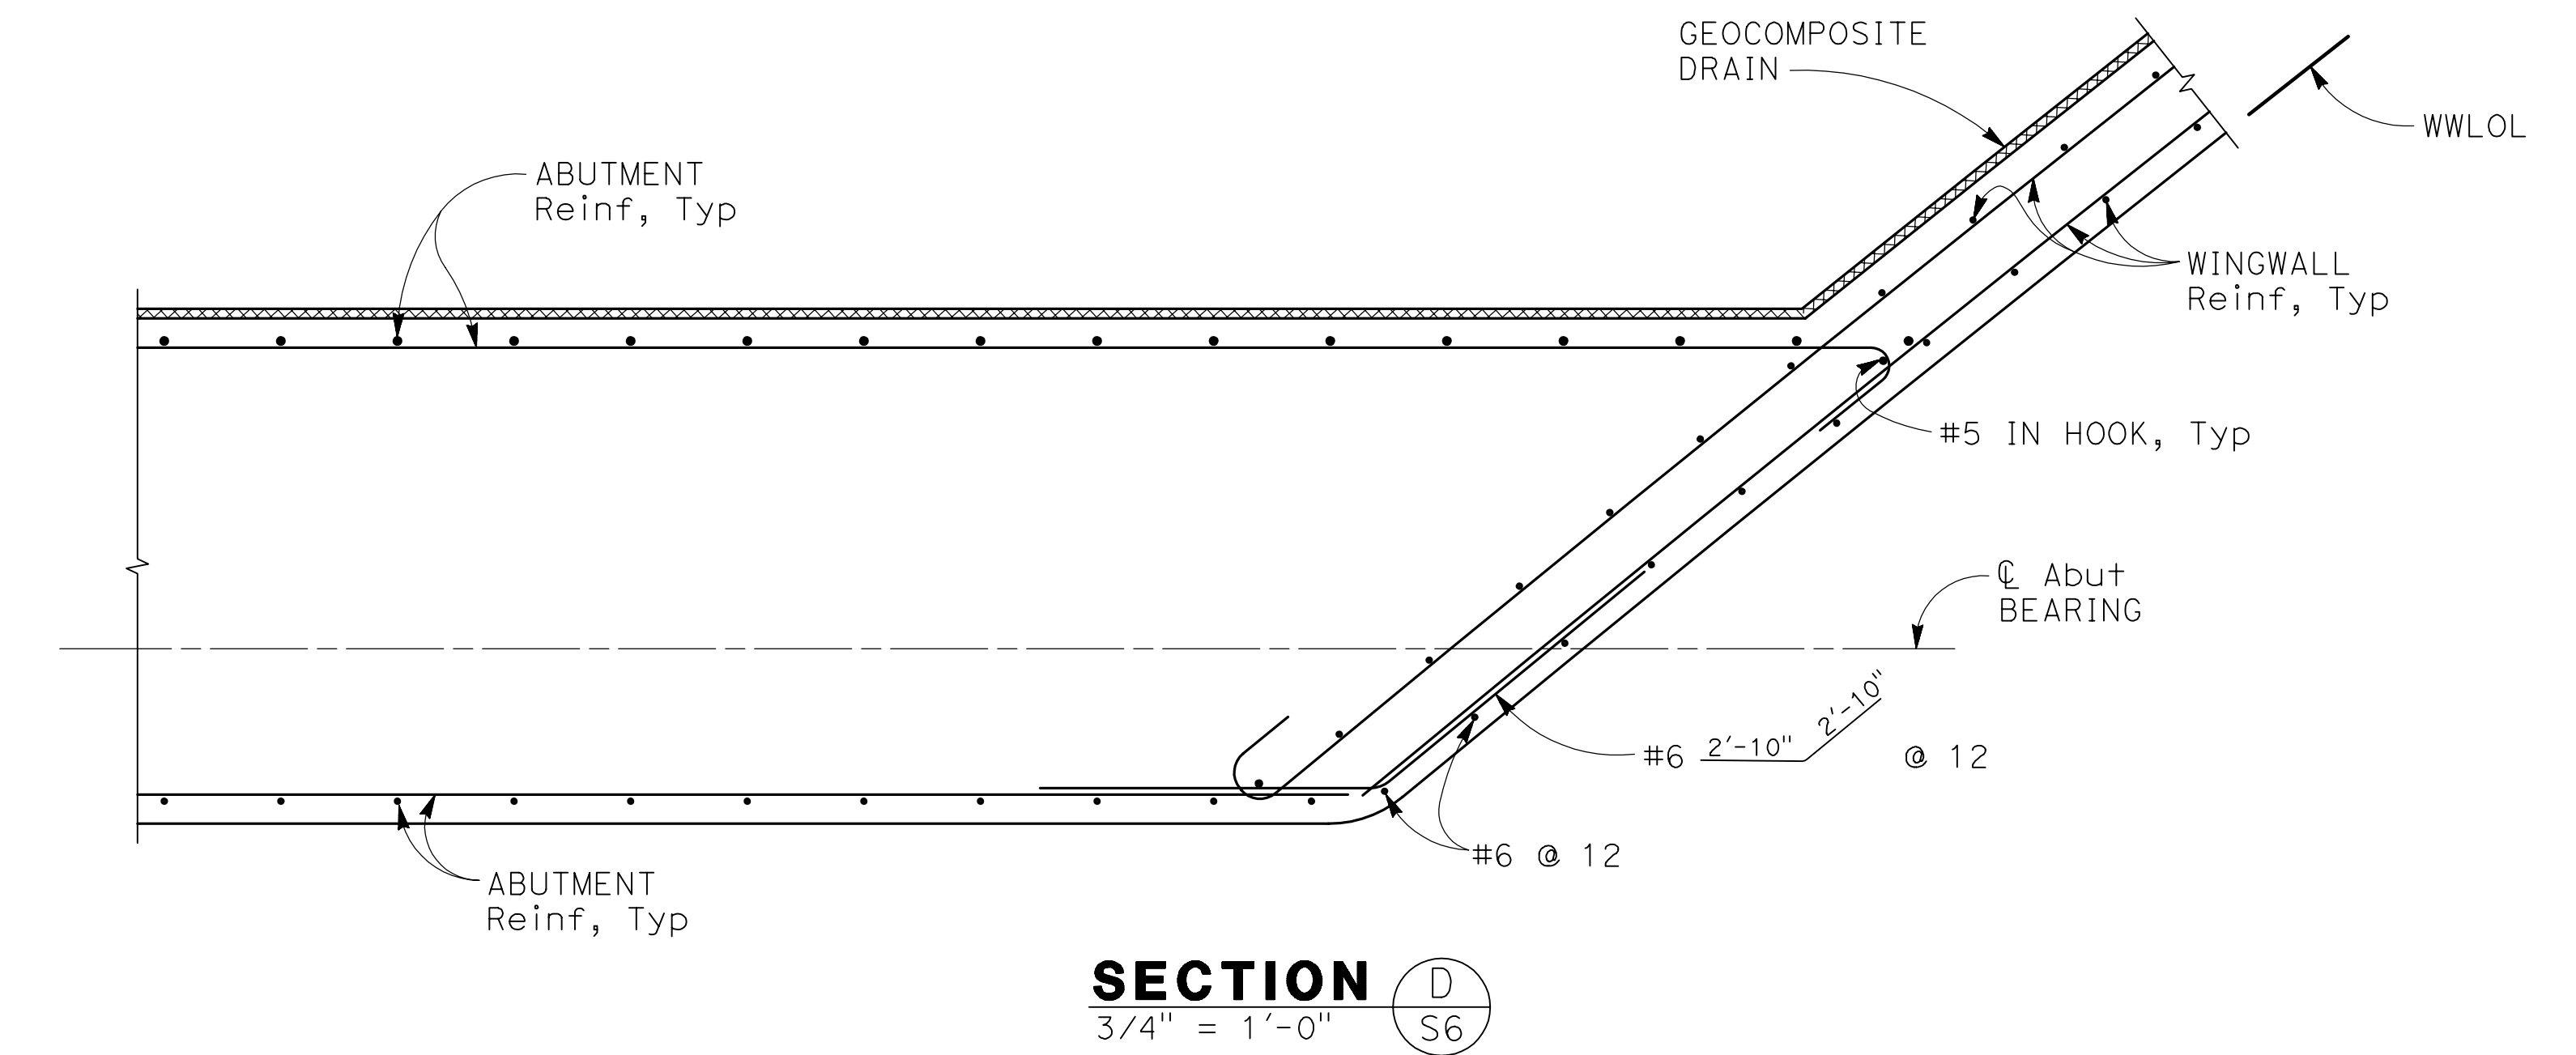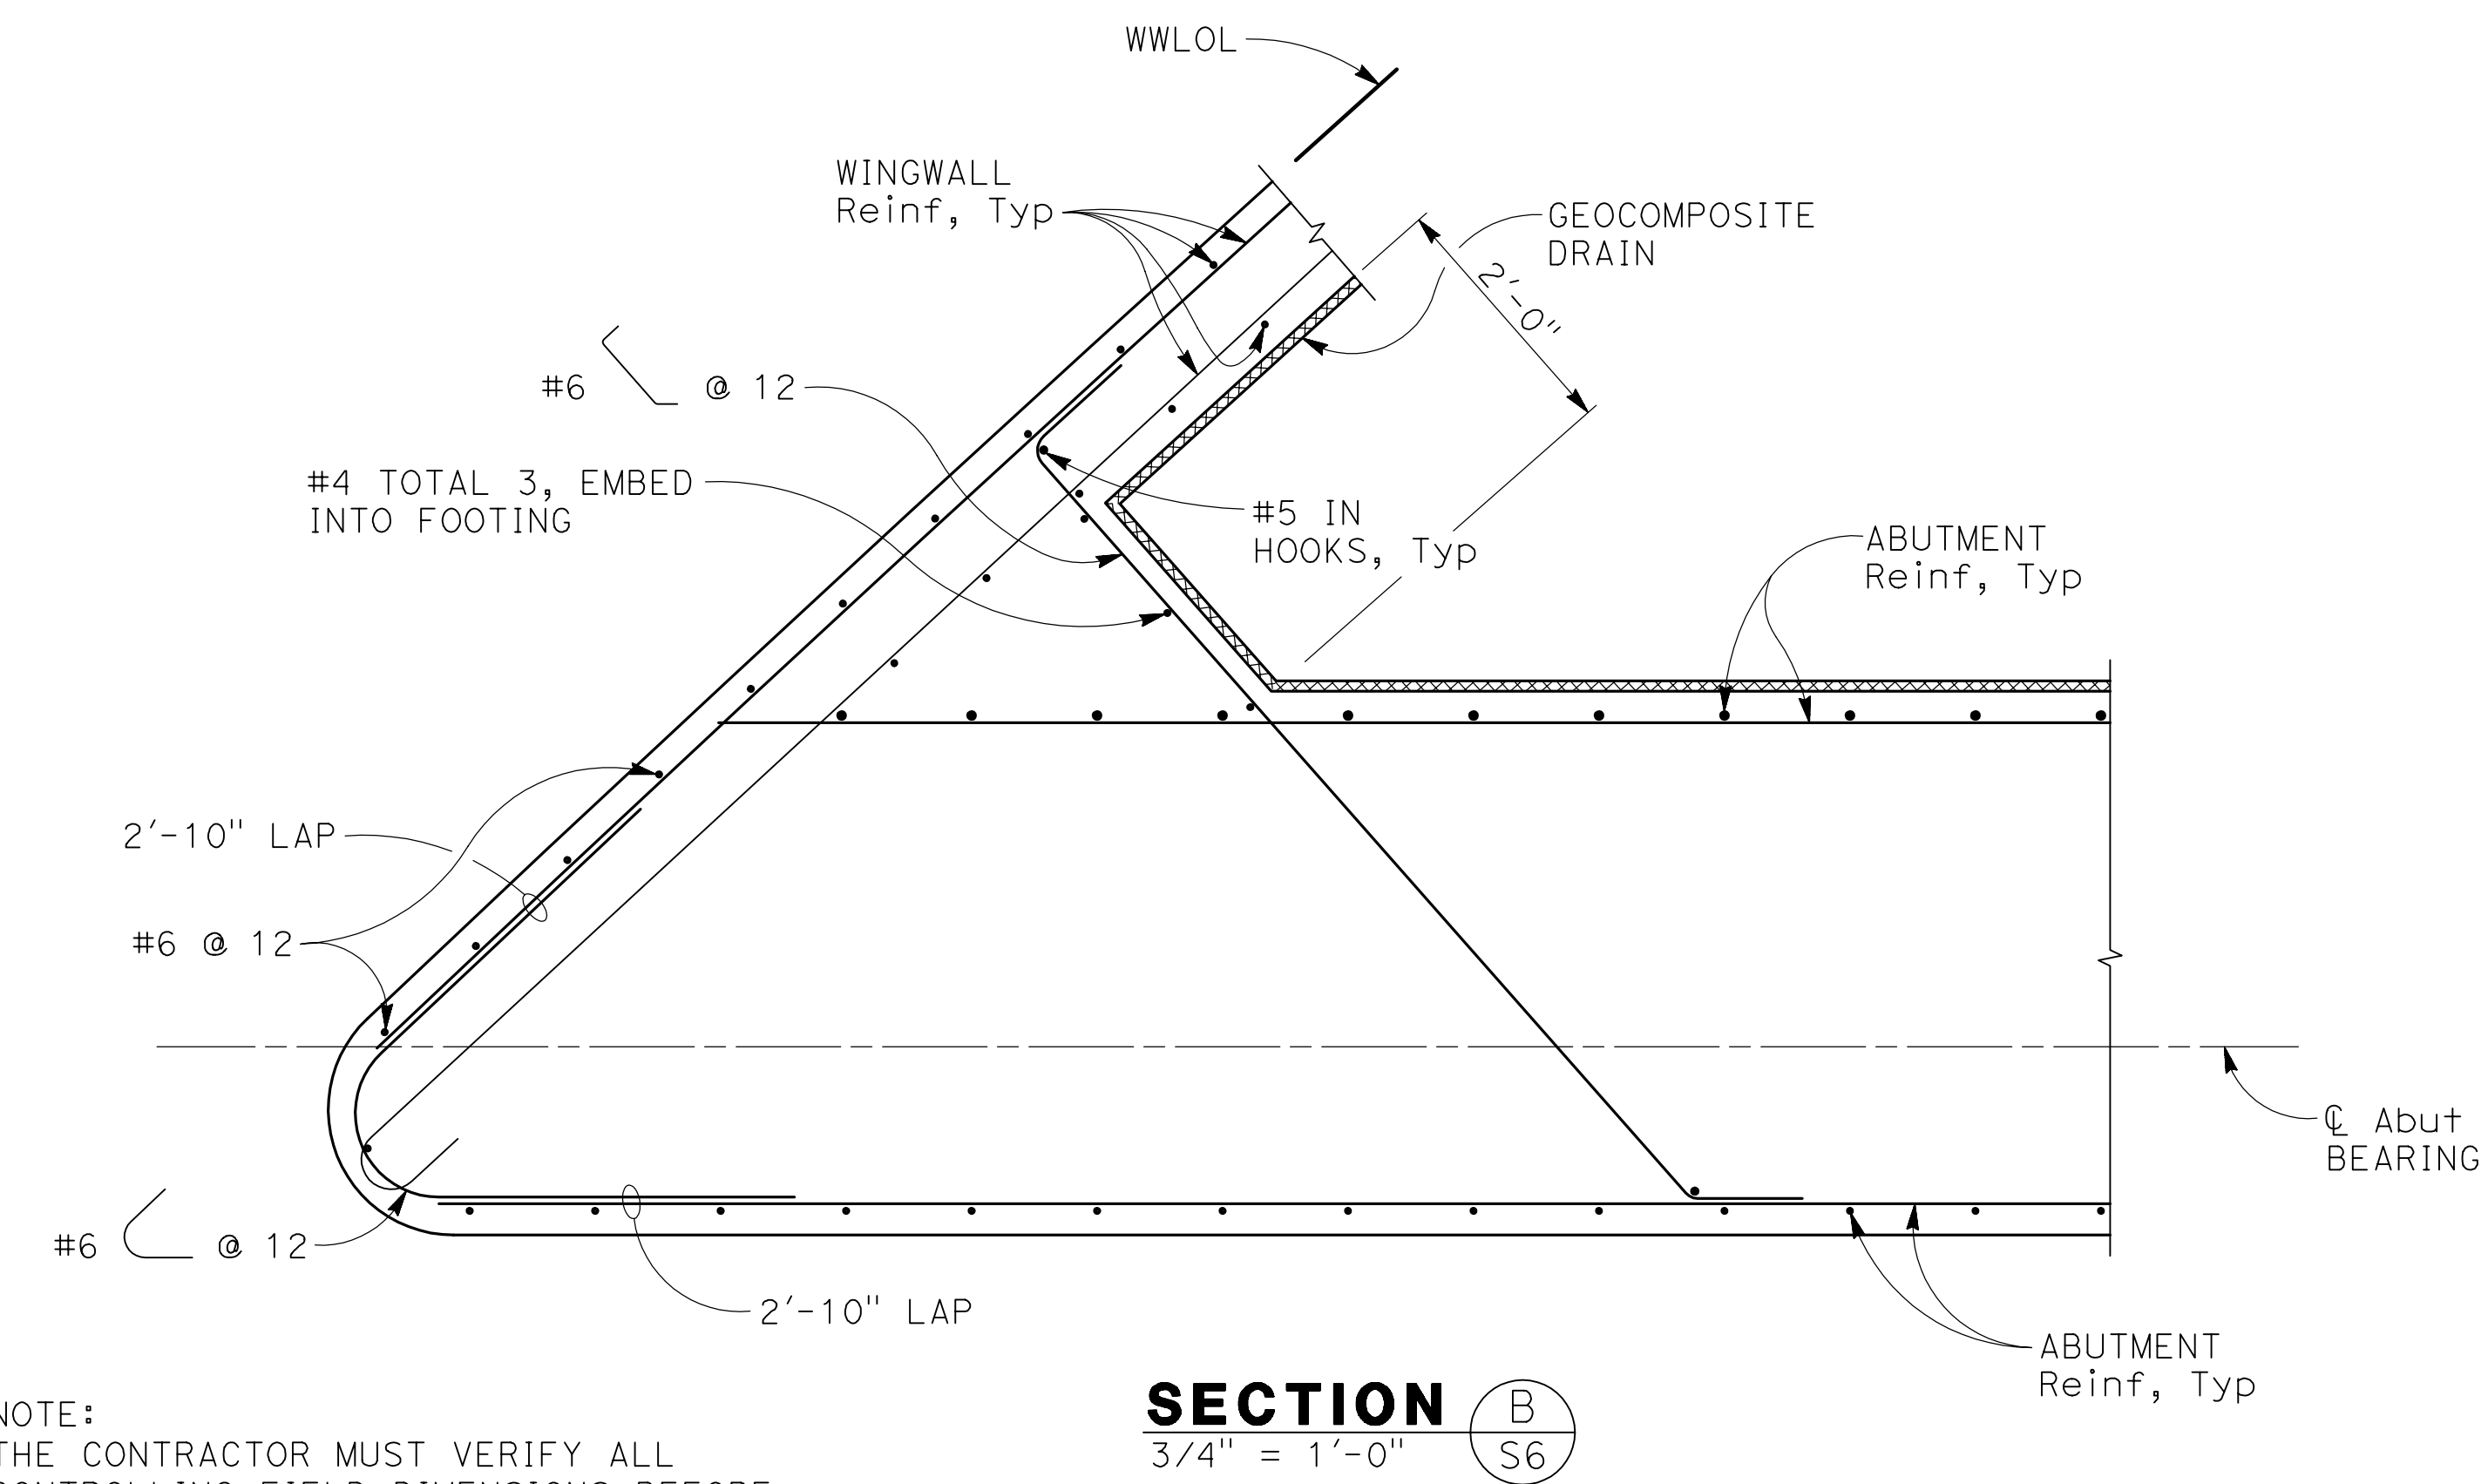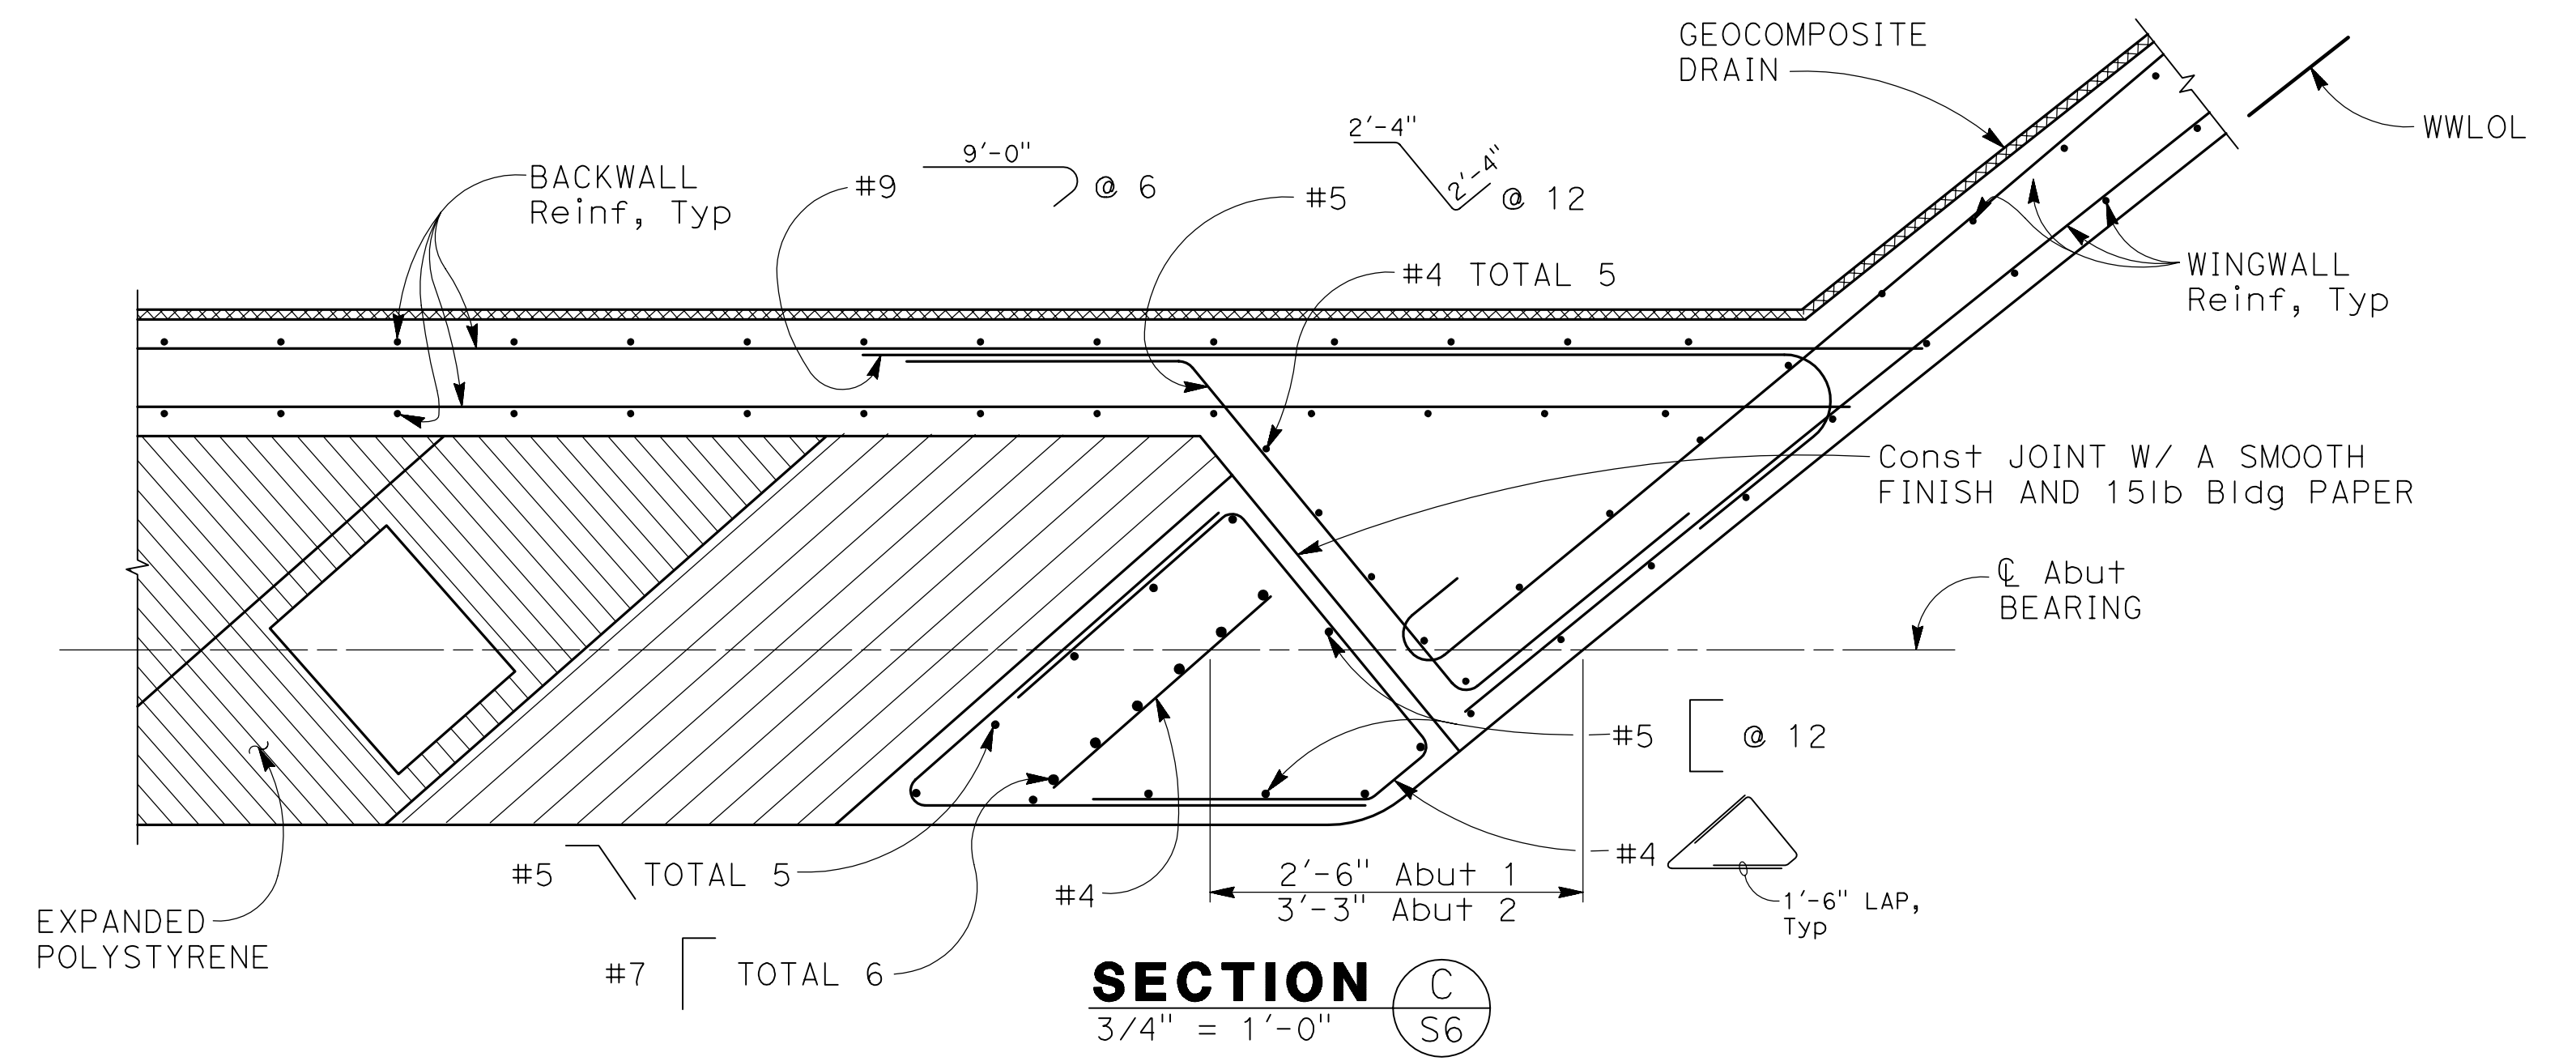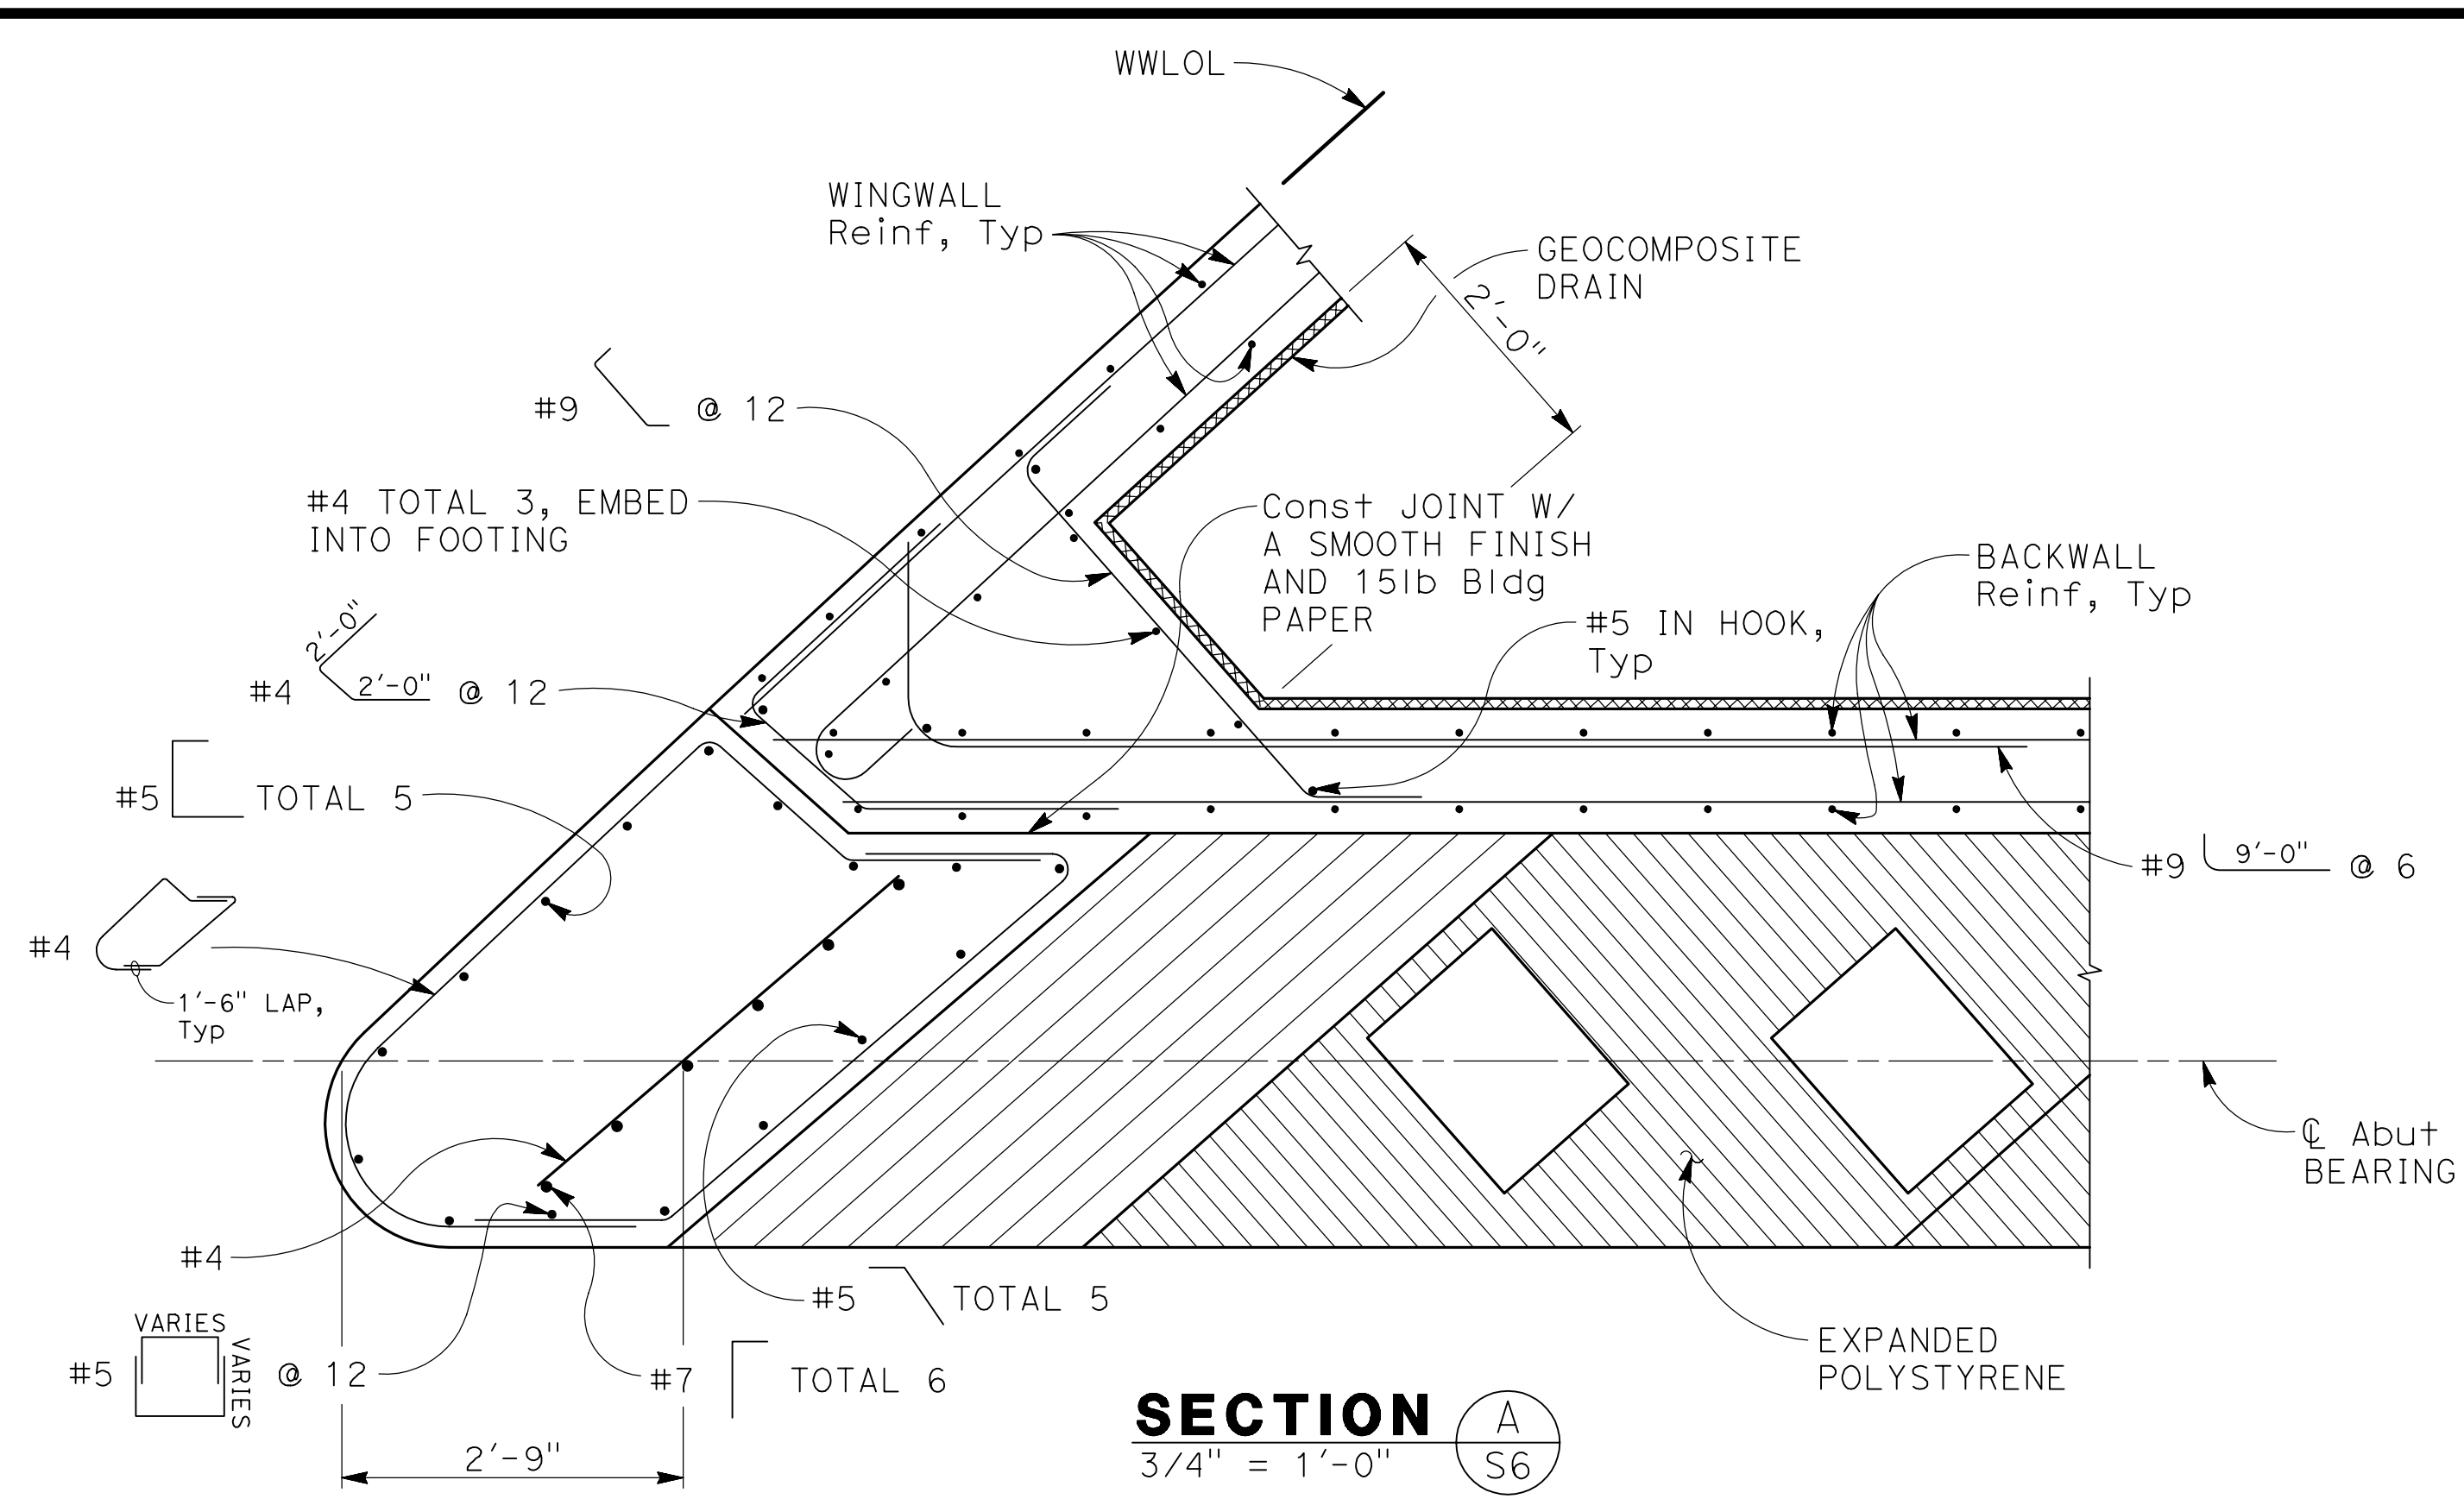




NOTE:
THE CONTRACTOR MUST VERIFY ALL
CONTROLLING FIELD DIMENSIONS BEFORE
ORDERING OR FABRICATING ANY MATERIAL

S-6

DESIGNED: SGS		DATE: 1/25/21	RECORD DRAWING		SCALE: AS SHOWN	PROJECT: SAND CREEK BRIDGE REPLACEMENT ON ENNIS ROAD		DEPARTMENT OF PUBLIC WORKS AND PLANNING	
DRAWN: AR		DATE: 1/25/21	RESIDENT ENGINEER			ROAD NO. 2824-2825		ABUTMENT DETAILS No. 2	
CHECKED: ML		DATE: 1/25/21	DATE			BRIDGE NO. 42C0697, BRLO-5942(238)		DRAWING NO. 11257	
FOR RIGHT OF WAY DATA AND ACCURATE ACCESS DETERMINATION, SEE DOCUMENTS IN THE DEPARTMENT OF PUBLIC WORKS AND PLANNING.						SHEET NO. 23		TOTAL 31	

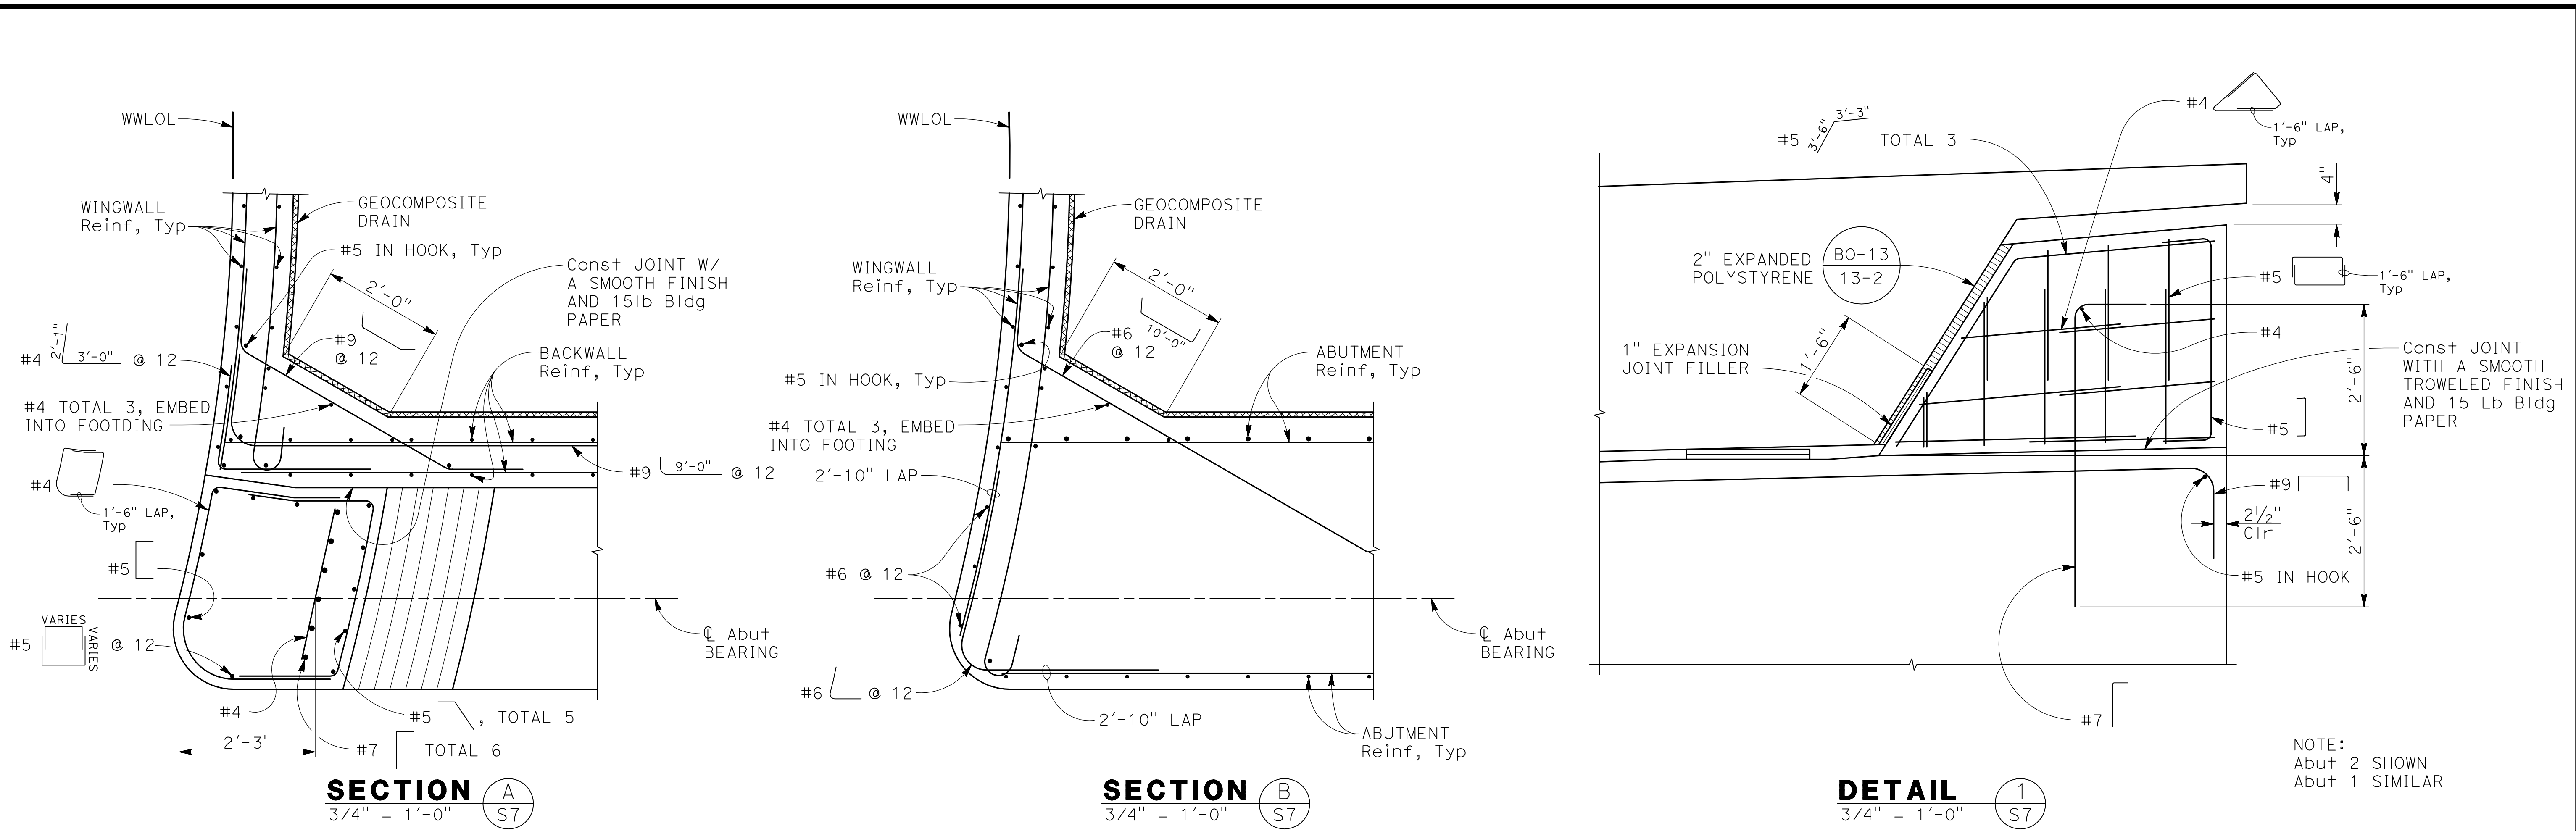

NOTE:
Abut 2 SHOWN
Abut 1 SIMILAR

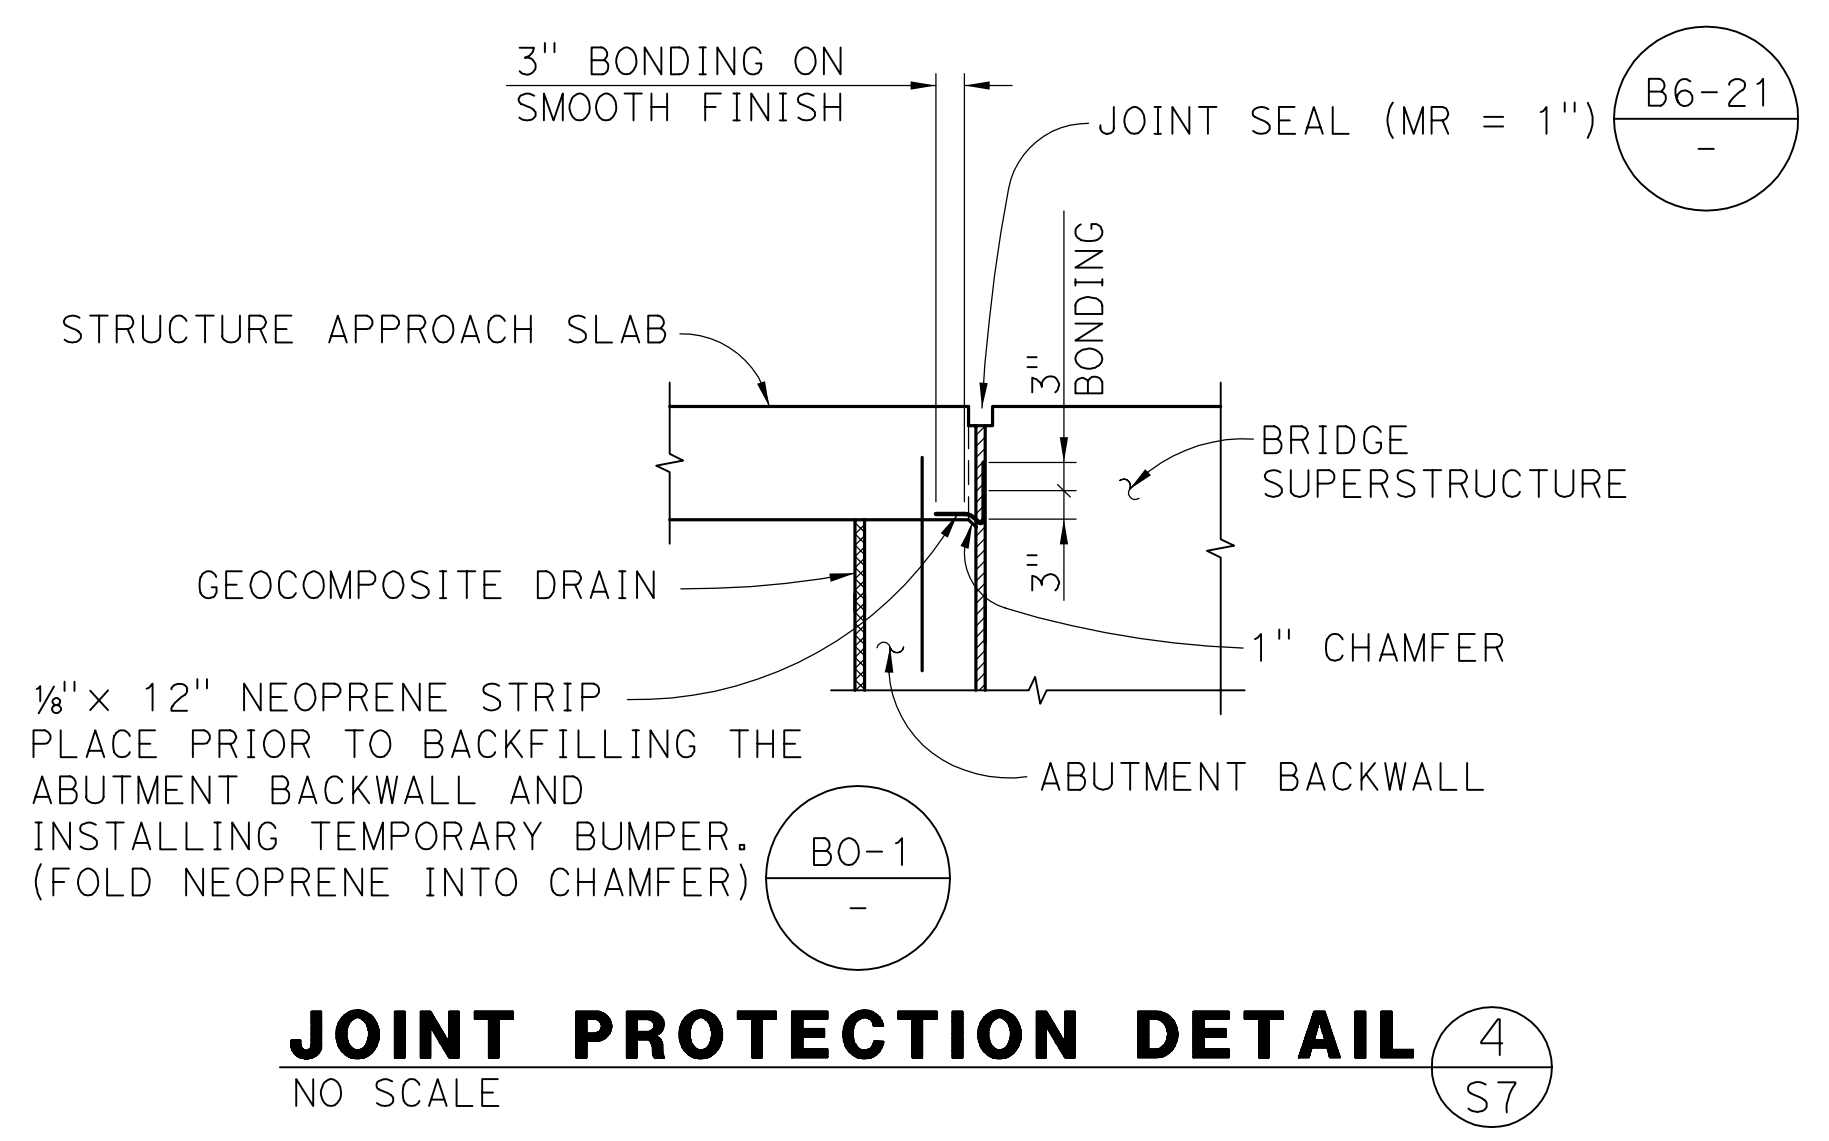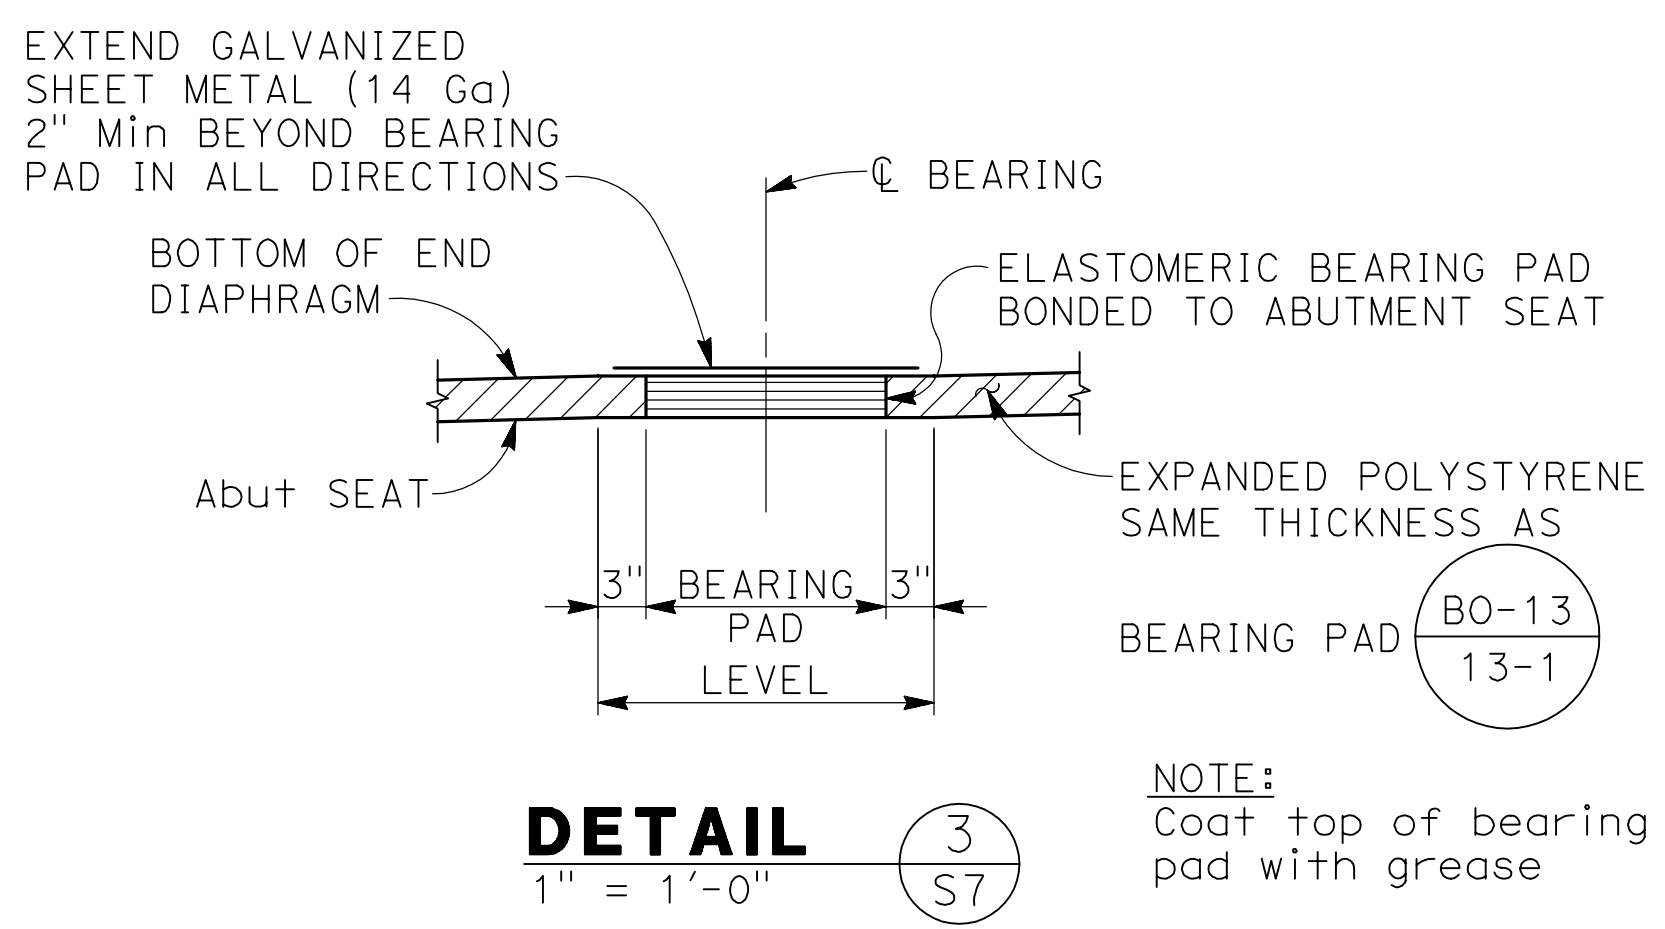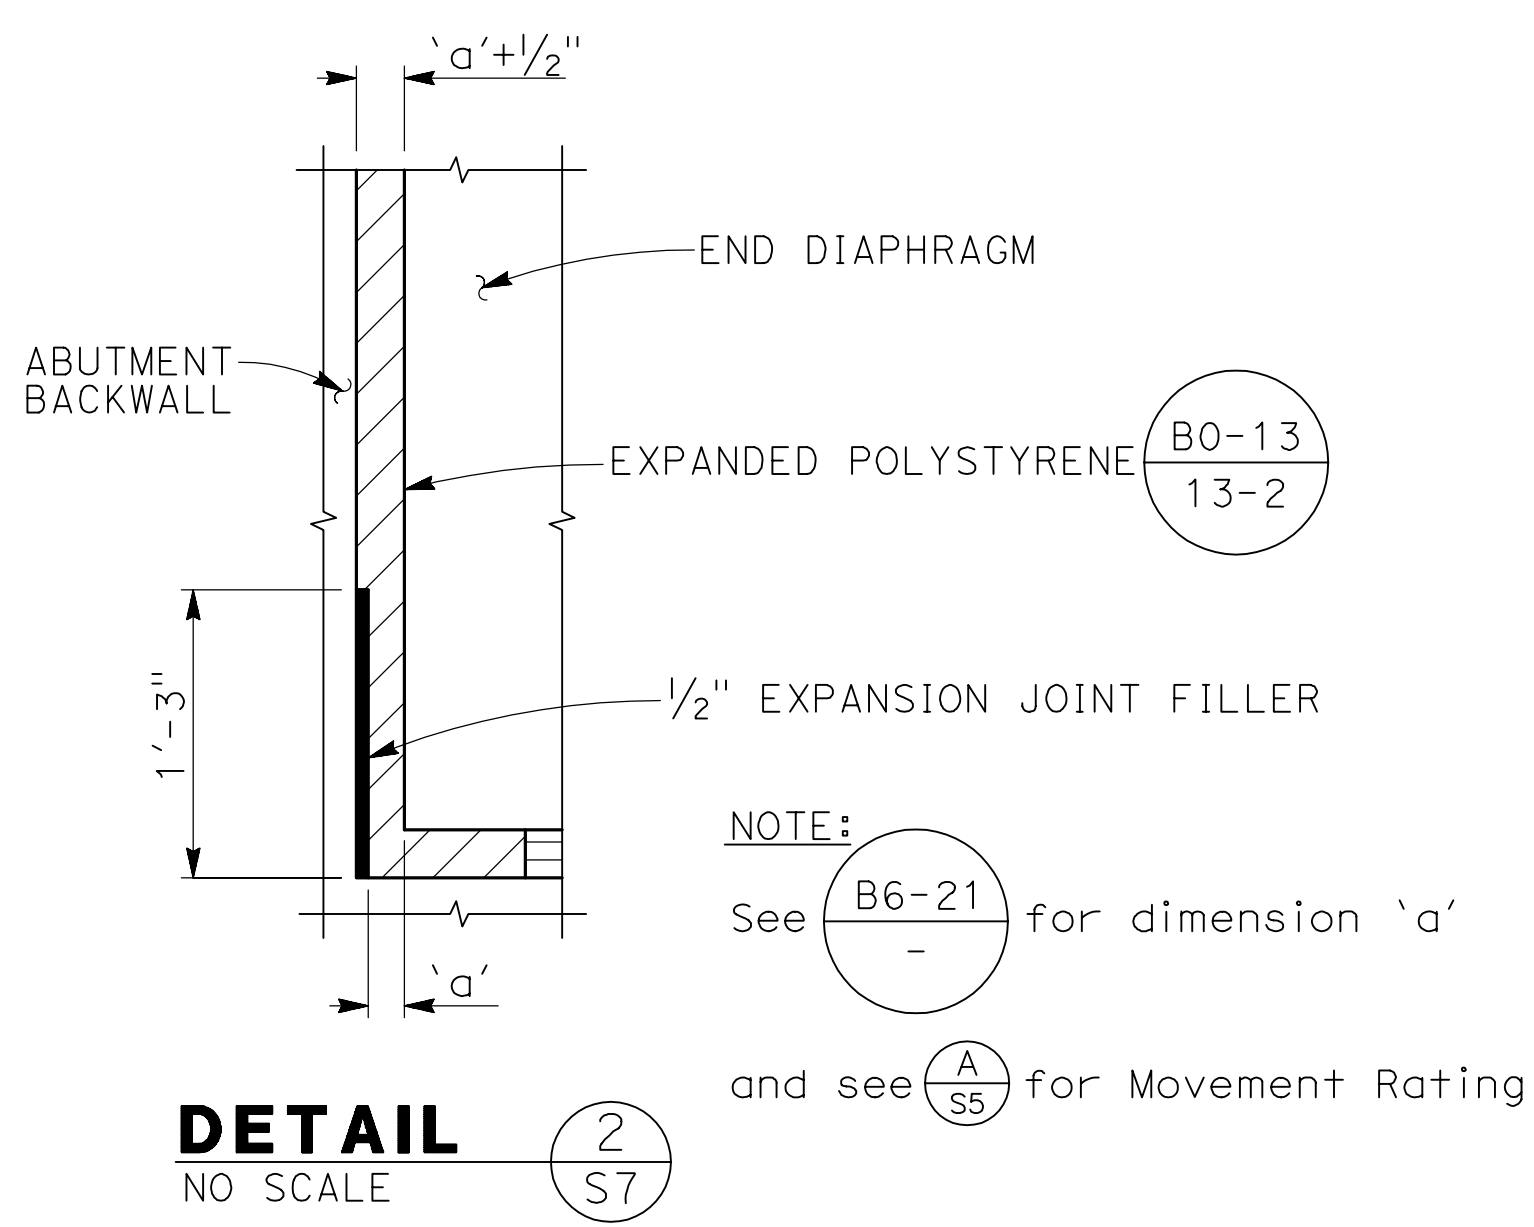


NOTE:
THE CONTRACTOR MUST VERIFY ALL CONTROLLING FIELD DIMENSIONS BEFORE ORDERING OR FABRICATING ANY MATERIAL



S-7

DESIGNED: SGS		DATE: 1/25/21	RECORD DRAWING		SCALE	PROJECT		DEPARTMENT OF PUBLIC WORKS AND PLANNING	
DRAWN: AR		DATE: 1/25/21	RESIDENT ENGINEER		AS SHOWN	SAND CREEK BRIDGE REPLACEMENT ON ENNIS ROAD		ABUTMENT DETAILS No. 3	
CHECKED: ML		DATE: 1/25/21	DATE			ROAD NO. 2824-2825	BRIDGE NO. 42C0697, BRLO-5942(238)	DRAWING NO. 11257 SHEET NO. 24 TOTAL 31	
FOR RIGHT OF WAY DATA AND ACCURATE ACCESS DETERMINATION, SEE DOCUMENTS IN THE DEPARTMENT OF PUBLIC WORKS AND PLANNING.									

201513457

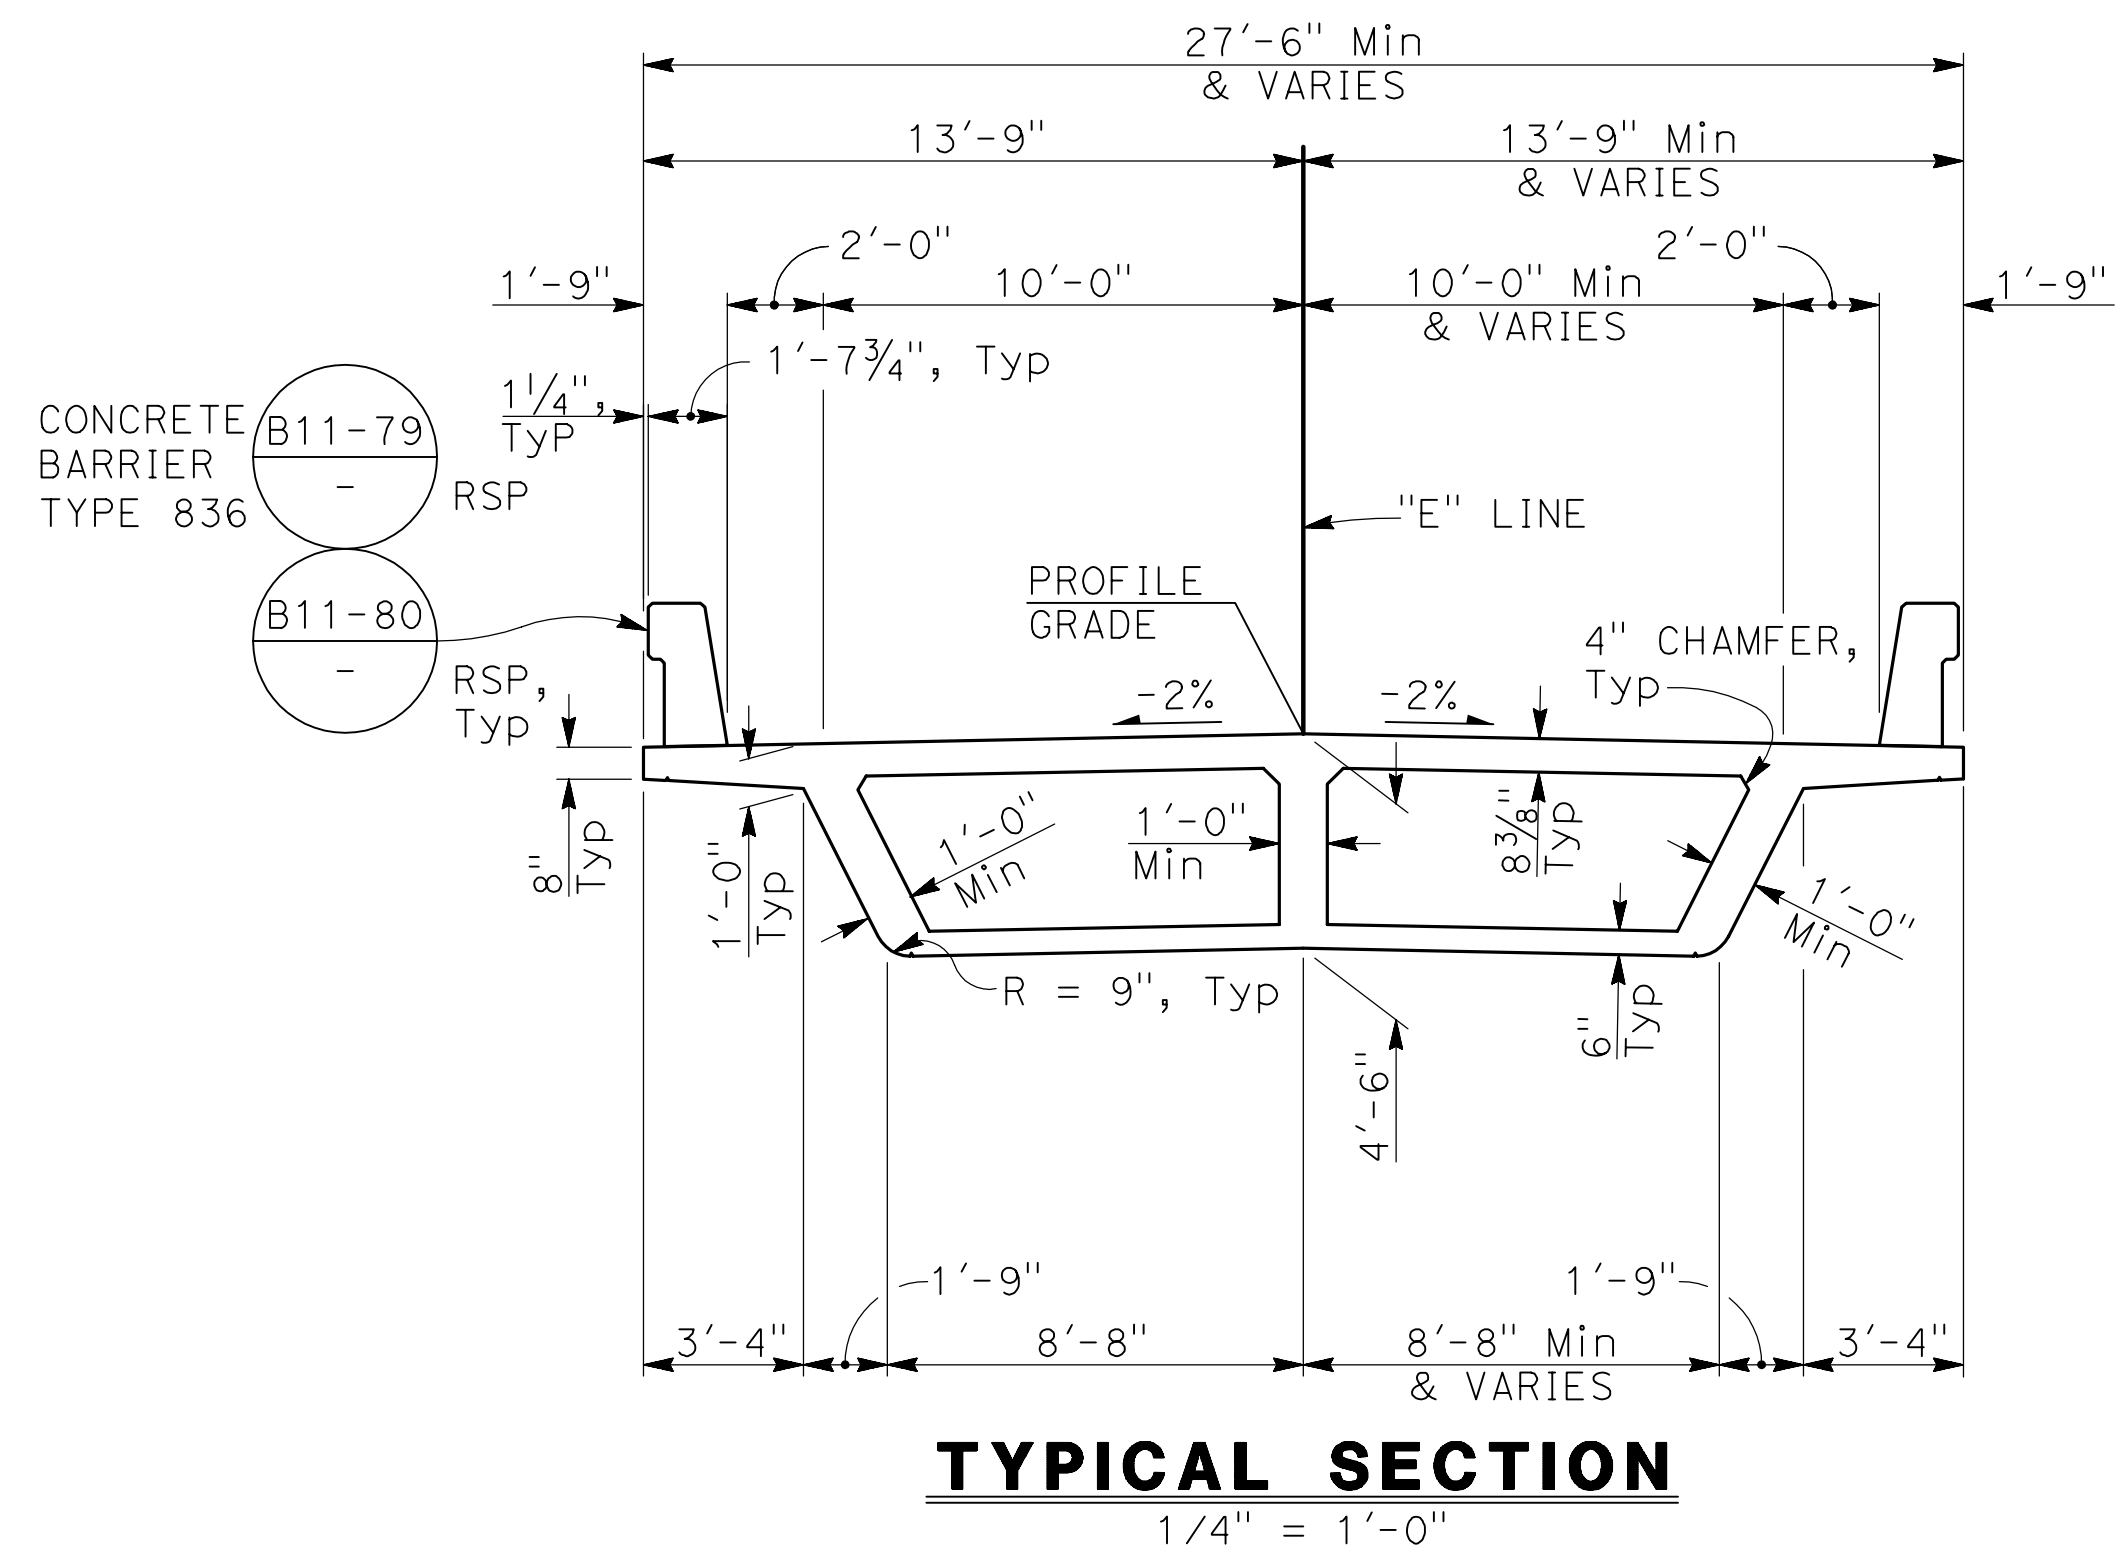


- NOTES:
1. All dimensions are measured perpendicular to the "E" Line.
 2. Transverse deck and soffit reinforcement shall be placed normal to the "E" Line and shall be spaced along "E" Line.
 3. Horizontal tendon radius must be greater than 400 feet.

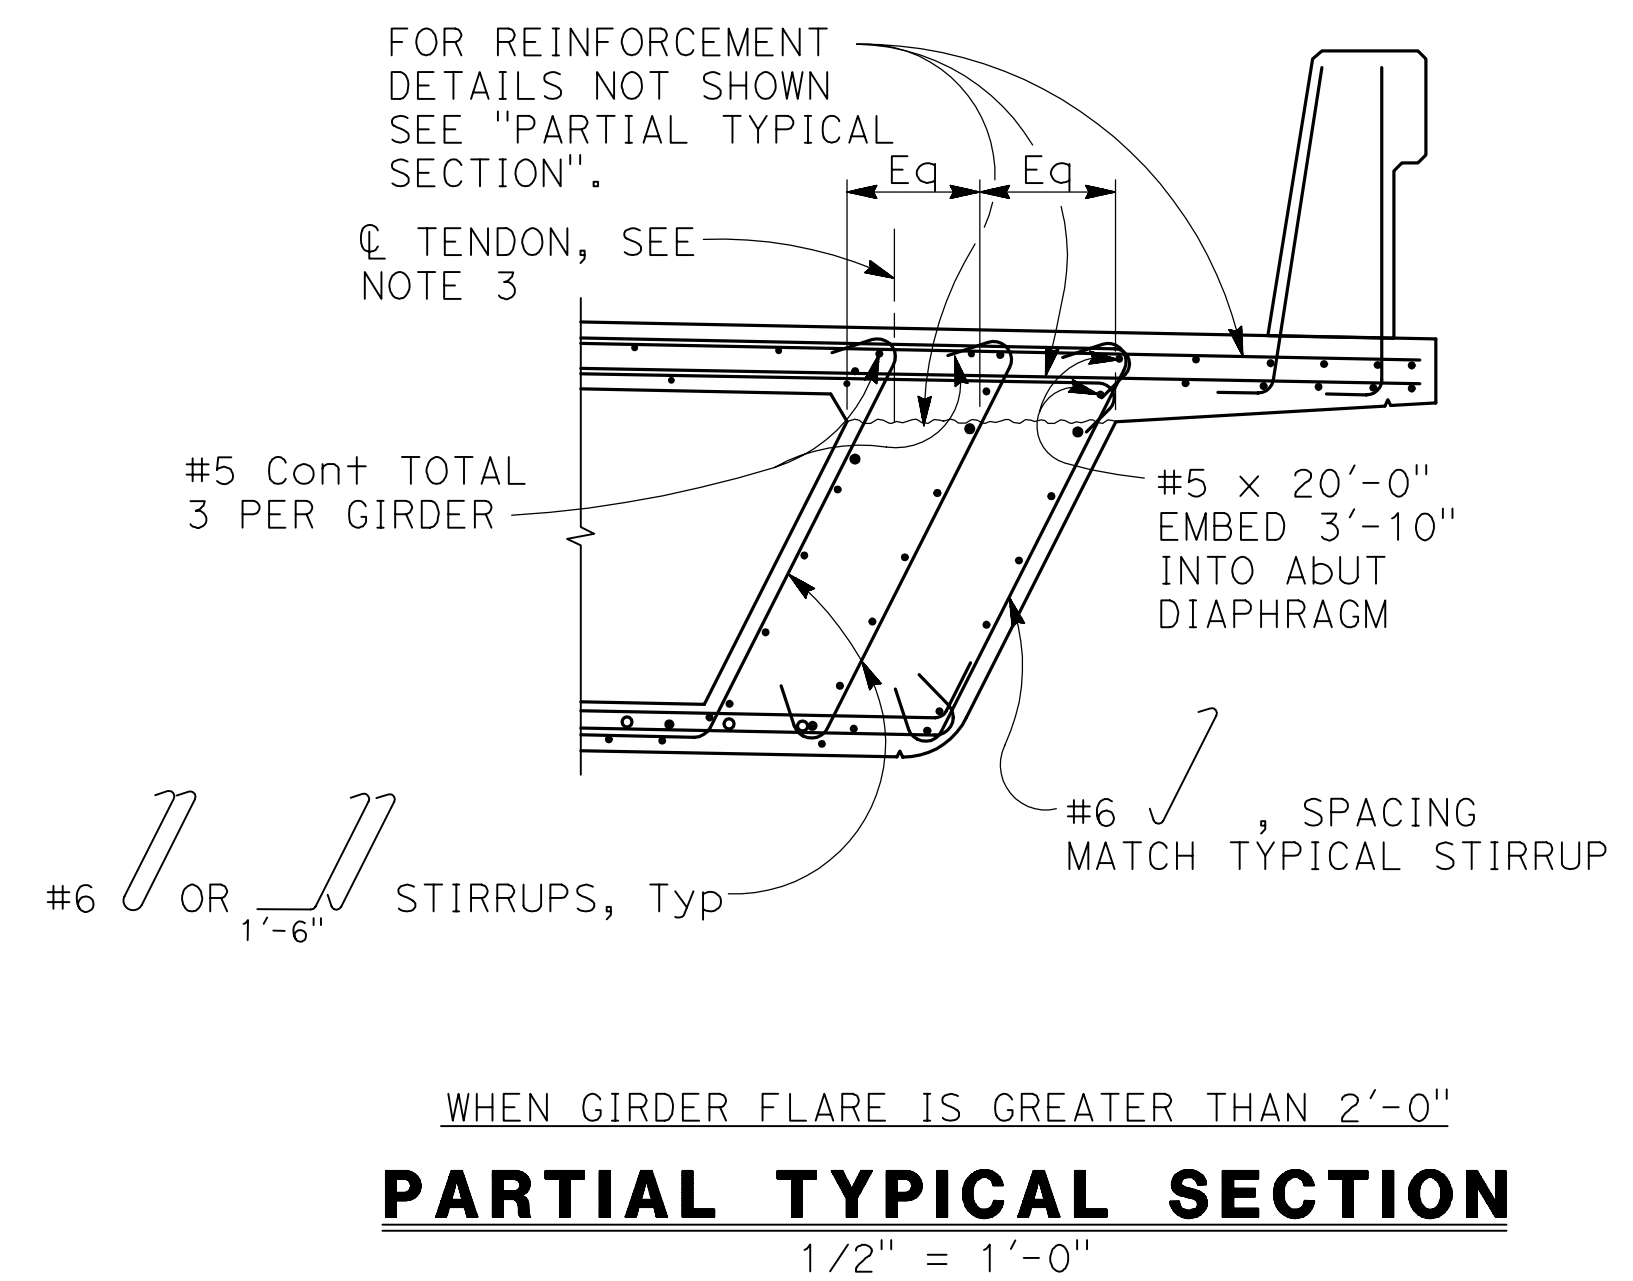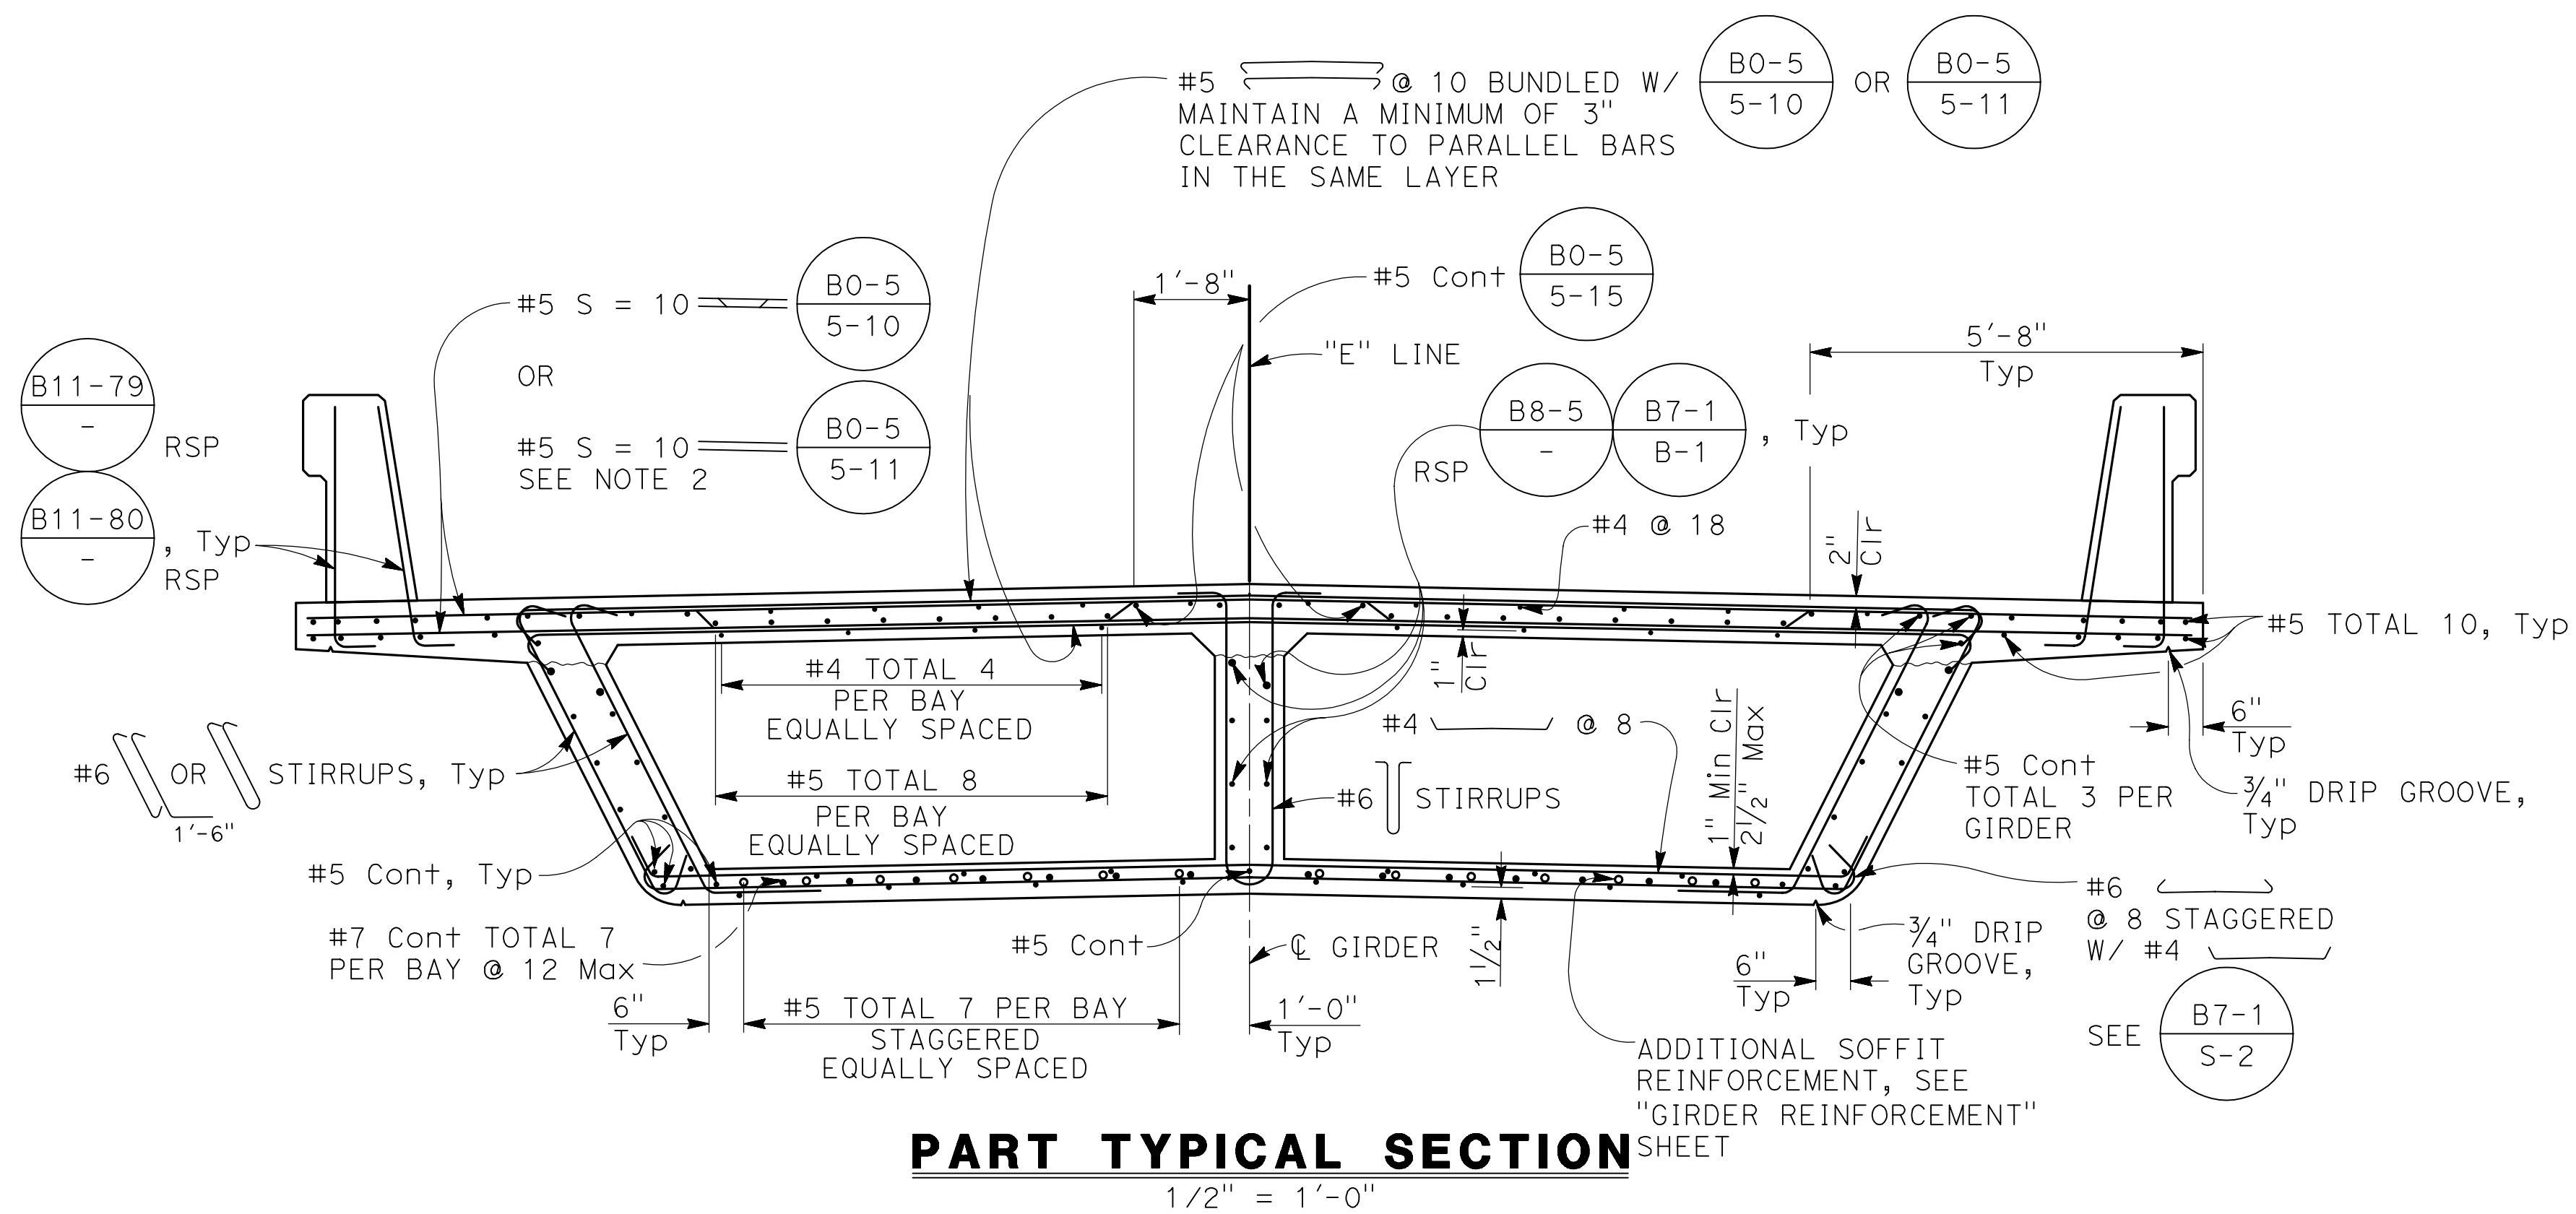

NOTE:
THE CONTRACTOR MUST VERIFY ALL CONTROLLING FIELD DIMENSIONS BEFORE ORDERING OR FABRICATING ANY MATERIAL

DESIGNED: SGS	DATE: 1/25/21	RECORD DRAWING: RESIDENT ENGINEER	SCALE: AS SHOWN	PROJECT: SAND CREEK BRIDGE REPLACEMENT ON ENNIS ROAD		DEPARTMENT OF PUBLIC WORKS AND PLANNING
DRAWN: AR	DATE: 1/25/21	CHECKED: ML	ROAD NO. 2824-2825	BRIDGE NO. 42C0697, BRLO-5942(238)		TYPICAL SECTION
FOR RIGHT OF WAY DATA AND ACCURATE ACCESS DETERMINATION, SEE DOCUMENTS IN THE DEPARTMENT OF PUBLIC WORKS AND PLANNING.				ROAD NO. 2824-2825	BRIDGE NO. 42C0697, BRLO-5942(238)	DRAWING NO. 11257
THESE PLANS ARE FOR THE CONTRACTOR'S INFORMATION ONLY. THEY ARE NOT TO BE CONSIDERED TO BE PART OF THE CONTRACT DOCUMENTS AND SHALL HAVE NO BEARING WHATSOEVER ON THE INTERPRETATION OF THE STANDARD SPECIFICATIONS, THE STANDARD PLANS, THE SPECIAL PROVISIONS, NOR SHALL THEY HAVE ANY BEARING WHATSOEVER ON THE INTERPRETATION OF THE OTHER PUBLICATIONS REFERENCED THEREIN						SHEET NO. 25
						TOTAL 31

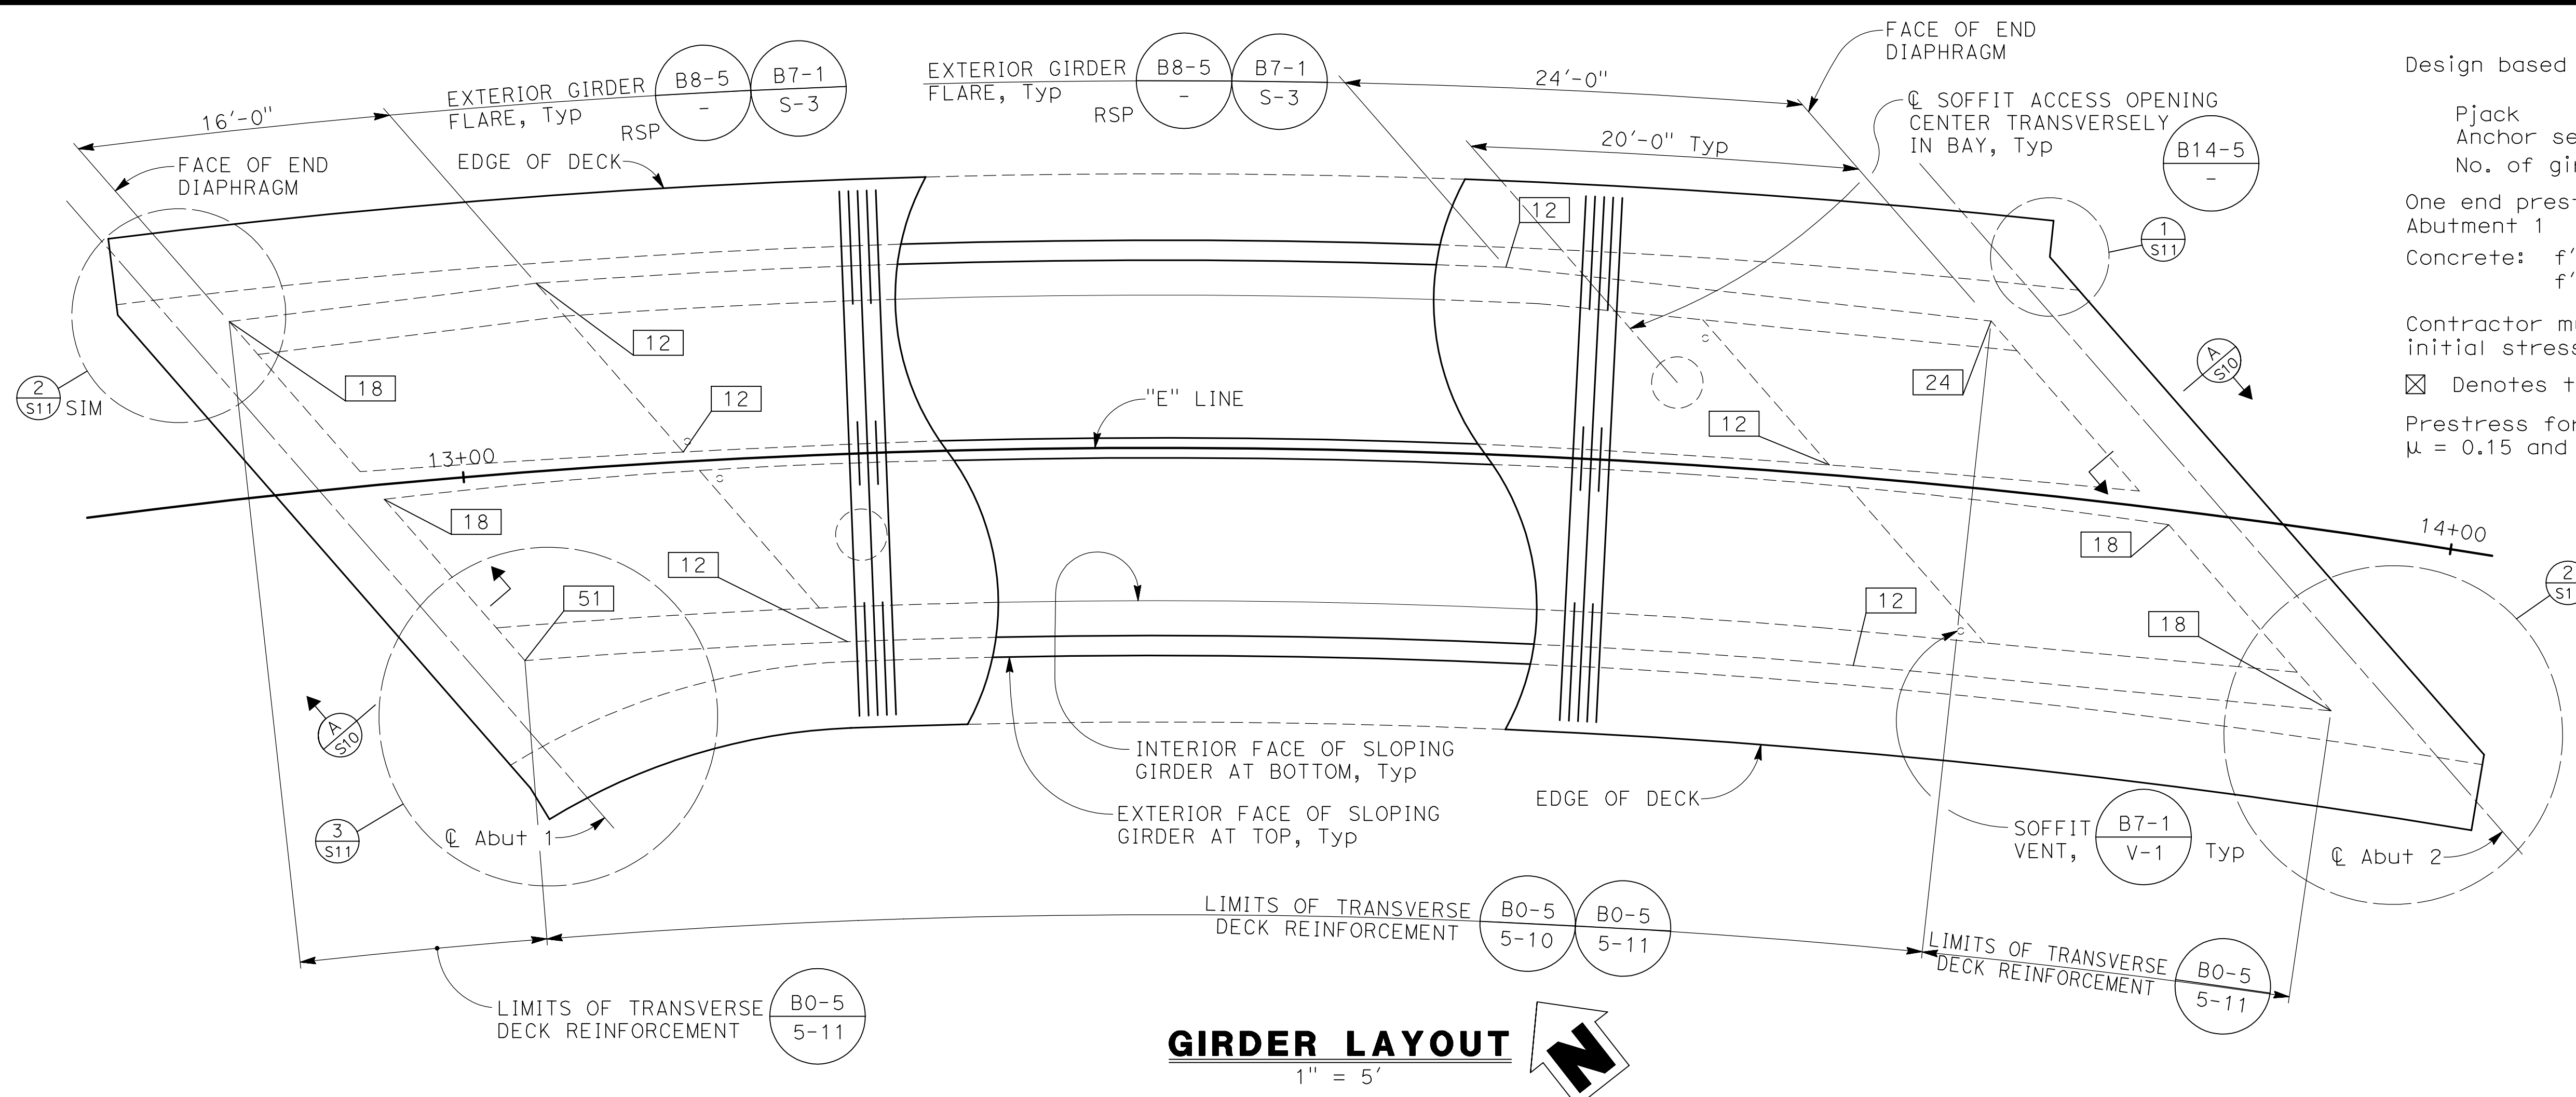

GIRDER LAYOUT
1" = 5'

PRESTRESSING NOTES

Design based on 270 ksi Low Relaxation Strand:

Pjack = 5900 kips
 Anchor set = 3/8 in
 No. of girders = 3


One end prestressing shall be performed from Abutment 1

Concrete: $f'c = 4000$ psi @ 28 days
 $f'ci = 3500$ psi @ time of stressing

Contractor must submit elongation calculations based on initial stress at $\square = 0.939$ times jacking stress

\square Denotes theoretical point of no movement

Prestress force design is based on friction coefficient $\mu = 0.15$ and friction wobble coefficient $k=0.0002/ft.$

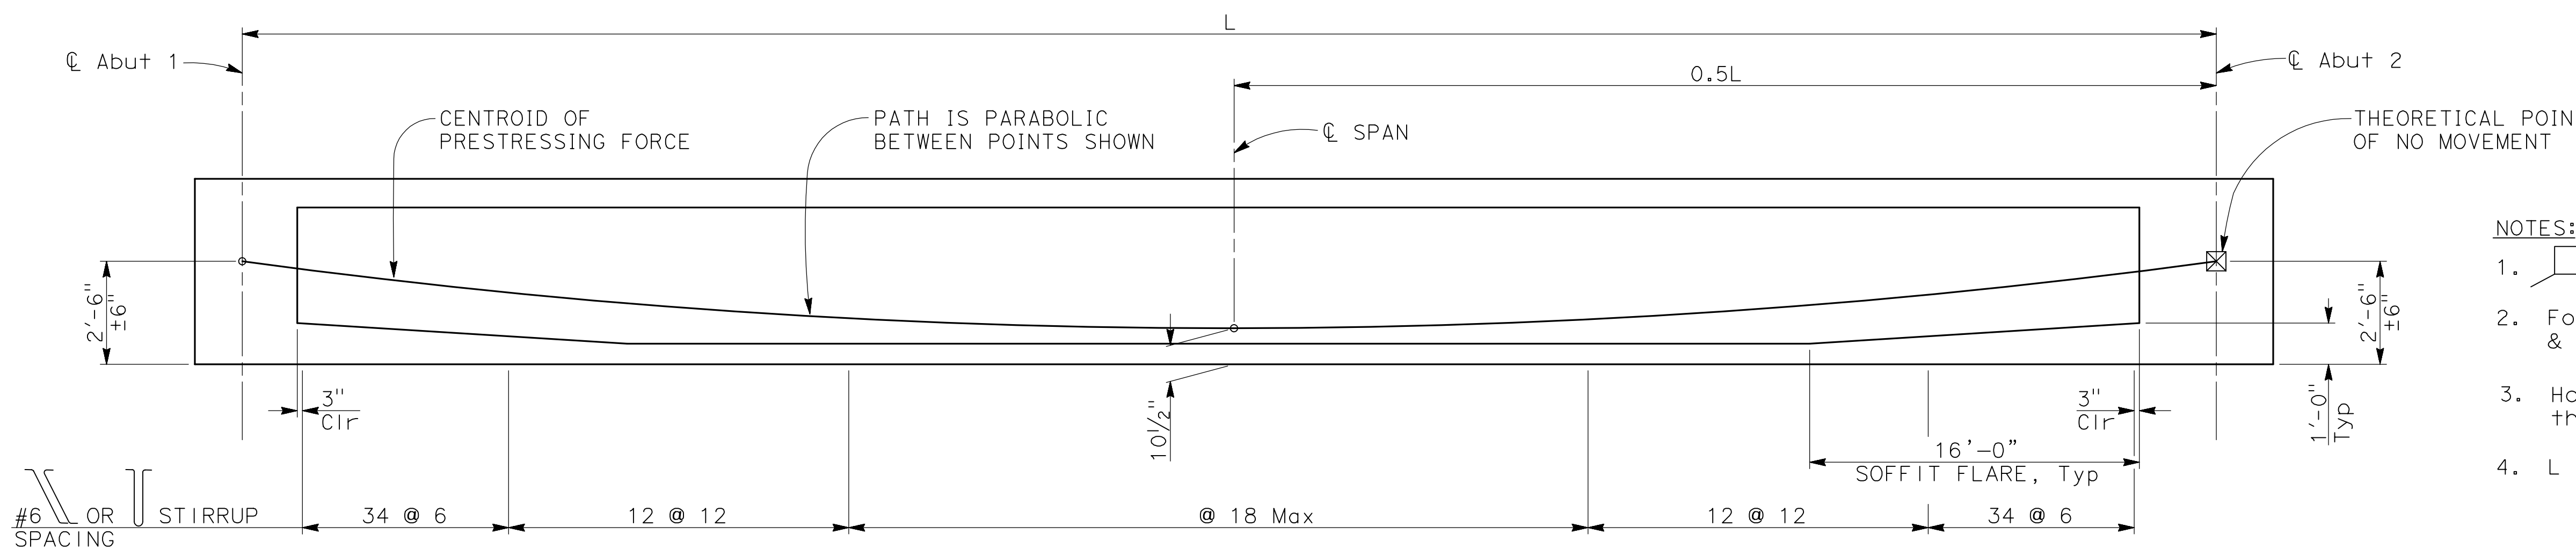


LONGITUDINAL SECTION
NO SCALE

- NOTES:**
- Indicates girder stem width in inches
 - For "CAMBER DIAGRAM" and "CONCRETE STRENGTH & TYPE LIMITS", see "DECK CONTOURS" sheet.
 - Horizontal tendon radius must be greater than 400 feet.
 - L is measured along the \O of each girder.


NOTE:
 THE CONTRACTOR MUST VERIFY ALL CONTROLLING FIELD DIMENSIONS BEFORE ORDERING OR FABRICATING ANY MATERIAL

DESIGNED: SGS		DATE: 1/25/21	RECORD DRAWING		SCALE	PROJECT			DEPARTMENT OF PUBLIC WORKS AND PLANNING	
DRAWN: AR		DATE: 1/25/21	RESIDENT ENGINEER		AS SHOWN	SAND CREEK BRIDGE REPLACEMENT ON ENNIS ROAD			GIRDER LAYOUT	
CHECKED: ML		DATE: 1/25/21	DATE			ROAD NO. 2824-2825 BRIDGE NO. 42C0697, BRLO-5942(238)			DRAWING NO. 11257 SHEET NO. 26 TOTAL 31	

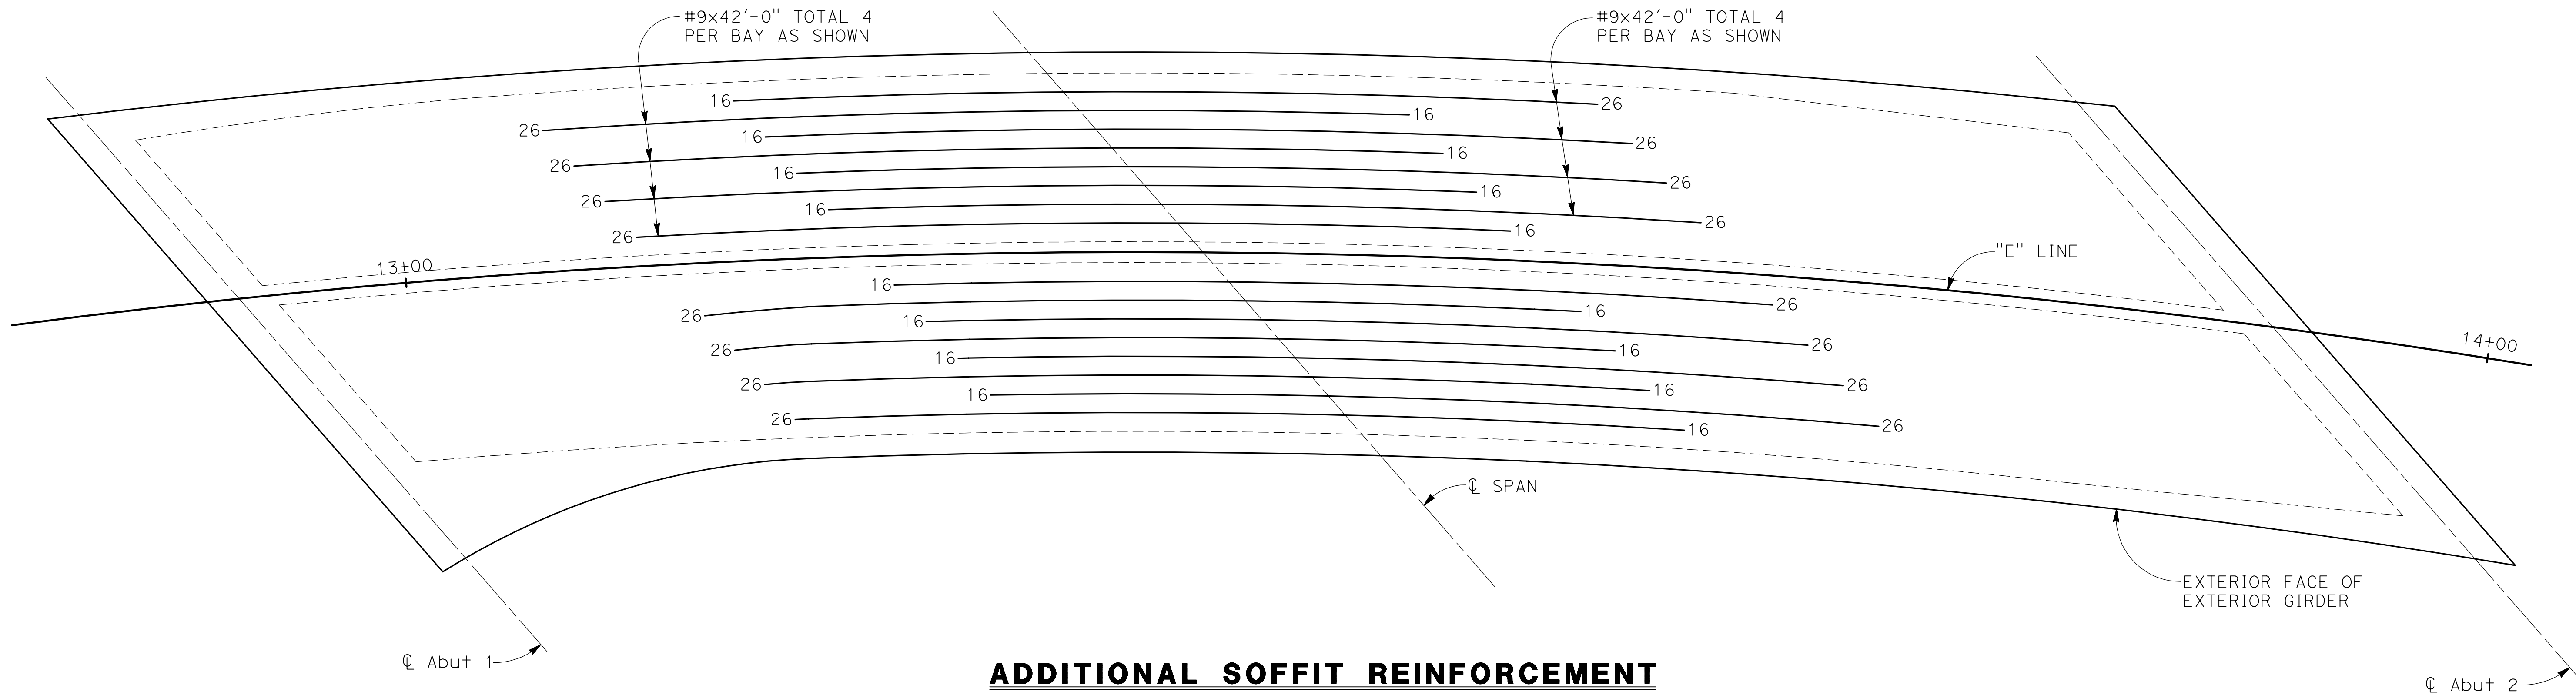

ADDITIONAL SOFFIT REINFORCEMENT

NO SCALE

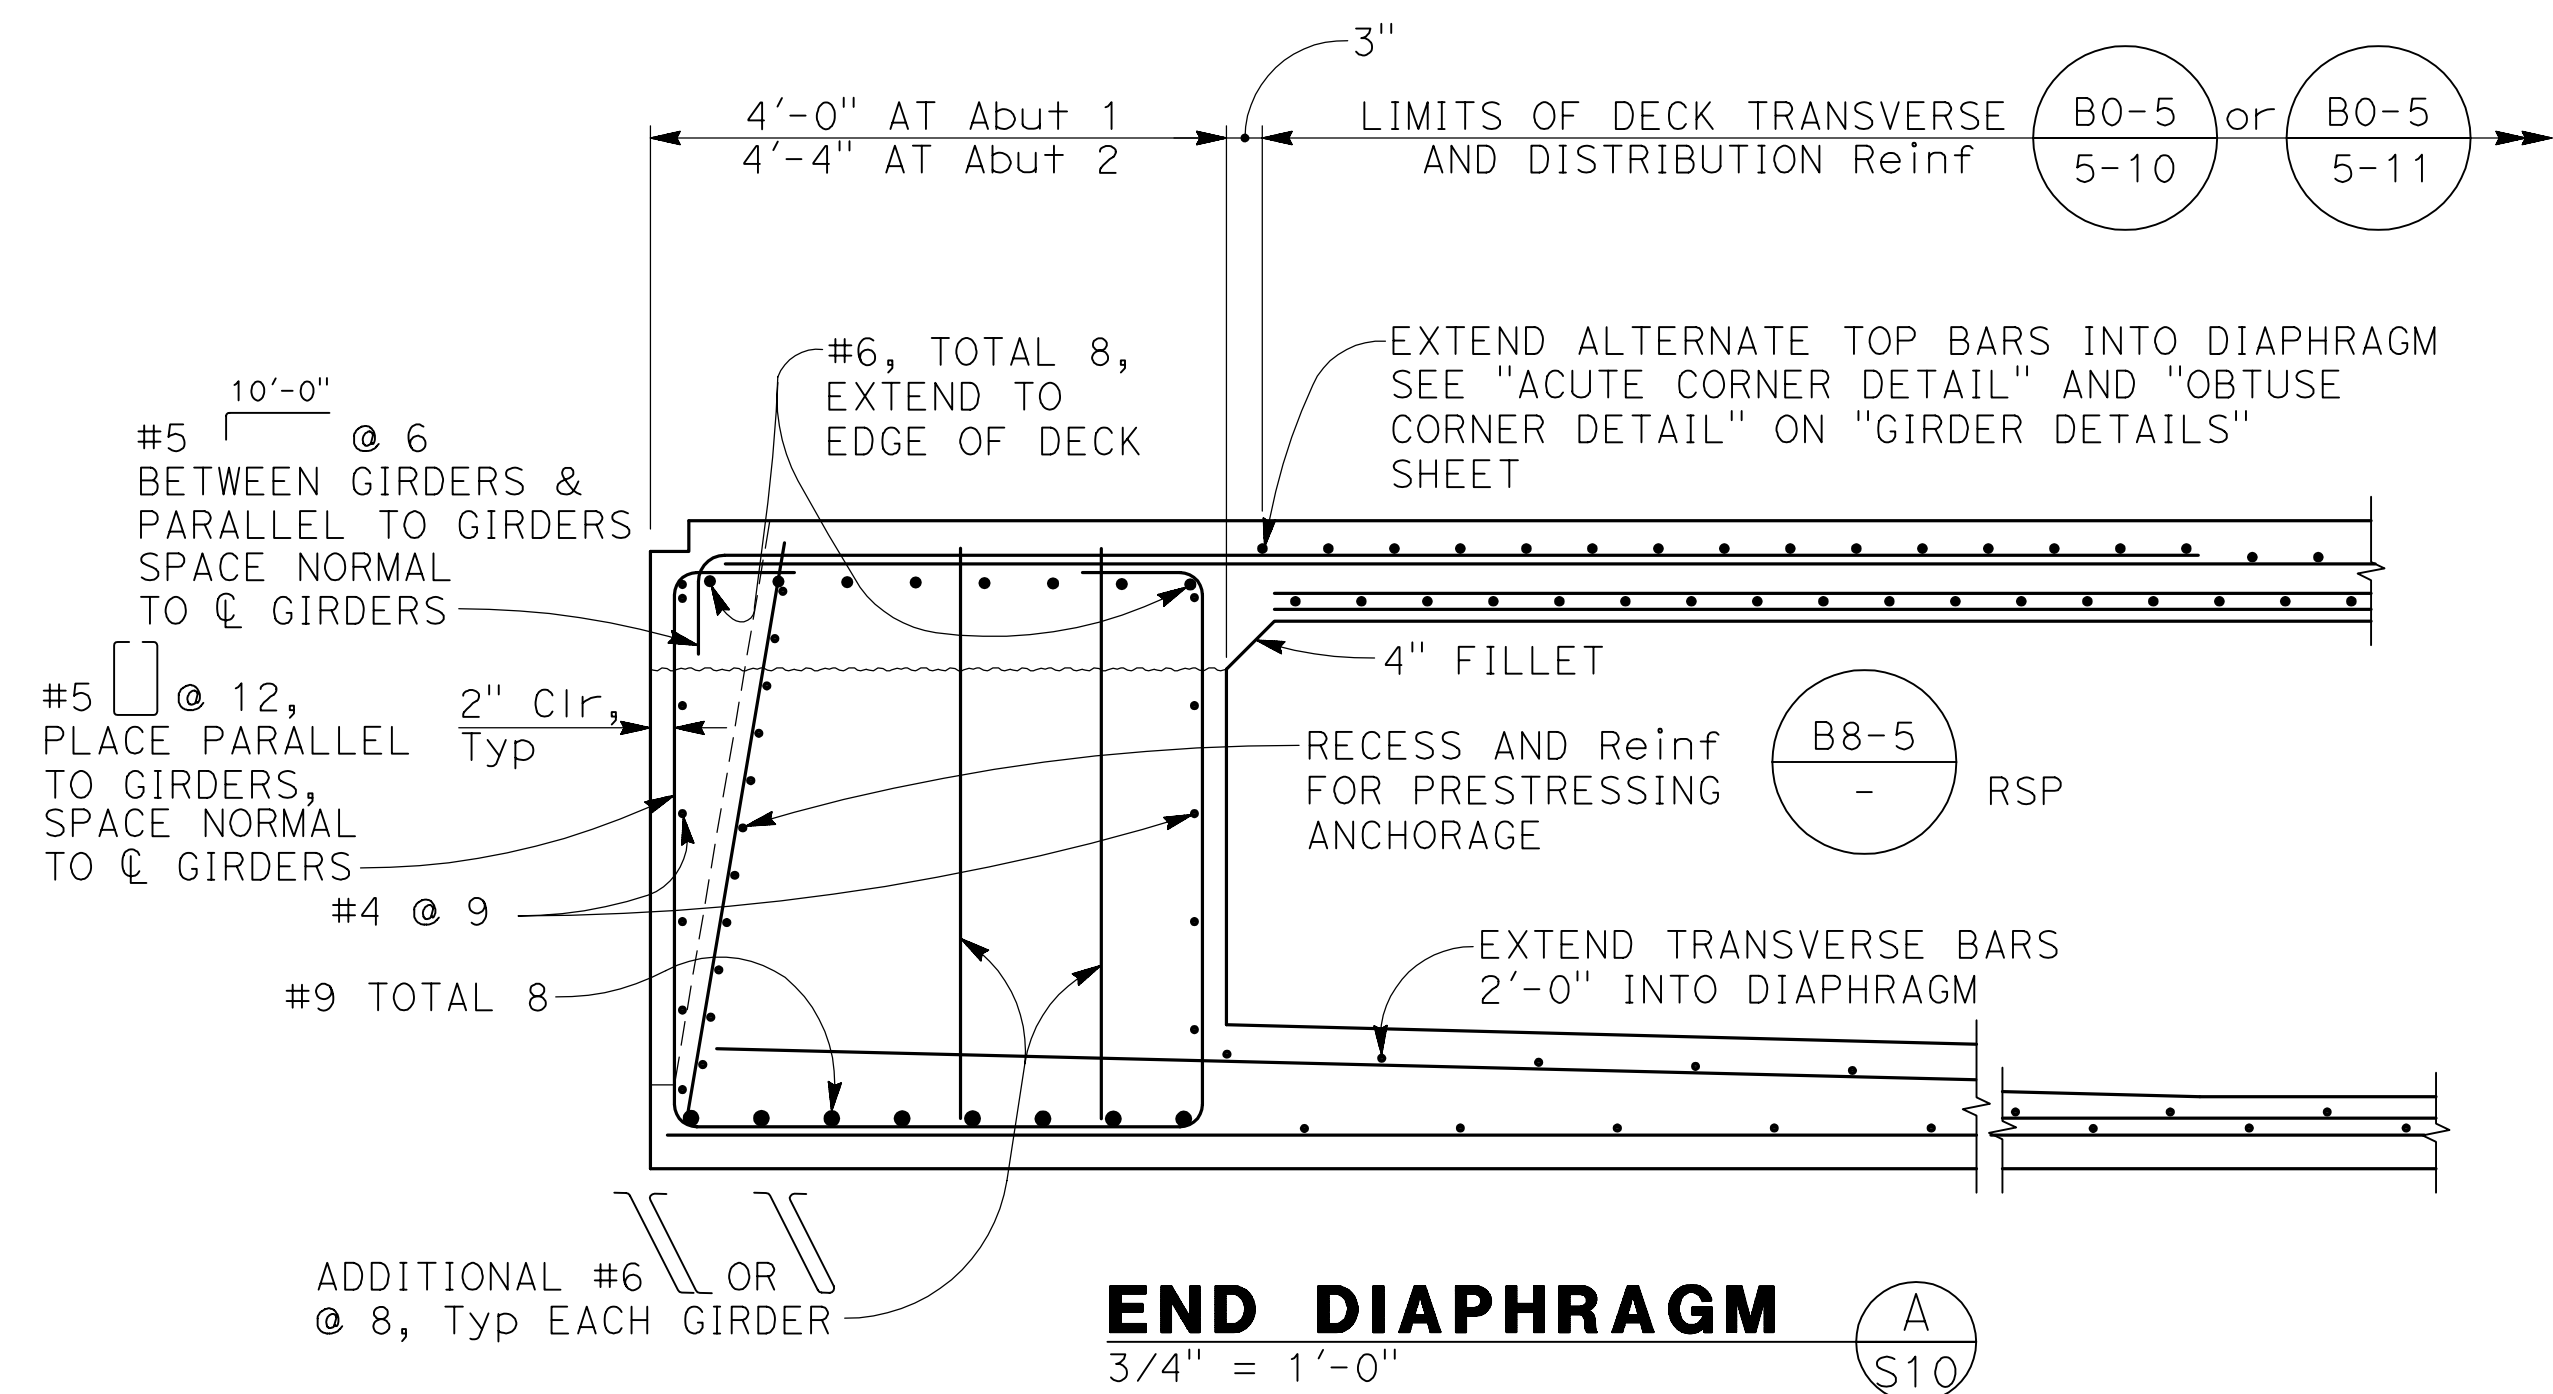


NOTES:

1. Reinforcement shown is in addition to reinforcement on "TYPICAL SECTION" sheet.
2. All bars shall be evenly spaced within each bay.
3. Reinforcement shall be placed parallel to "E" Line.
4. Additional deck reinforcement not required. See "TYPICAL SECTION" sheet for all deck reinforcement.
5. No splices allowed in #9x42'-0" additional reinforcement.
6. Number at end of bar indicates distance in feet from CL Span.


NOTE:
THE CONTRACTOR MUST VERIFY ALL CONTROLLING FIELD DIMENSIONS BEFORE ORDERING OR FABRICATING ANY MATERIAL

S-10


DESIGNED: SGS		DATE: 1/25/21	RECORD DRAWING		SCALE: AS SHOWN	PROJECT: SAND CREEK BRIDGE REPLACEMENT ON ENNIS ROAD			DEPARTMENT OF PUBLIC WORKS AND PLANNING	
DRAWN: AR		DATE: 1/25/21	RESIDENT ENGINEER			ROAD NO. 2824-2825 BRIDGE NO. 42C0697, BRLO-5942(238)			GIRDER REINFORCEMENT	
CHECKED: ML		DATE: 1/25/21	DATE			DRAWING NO. 11257 SHEET NO. 27 TOTAL 31				

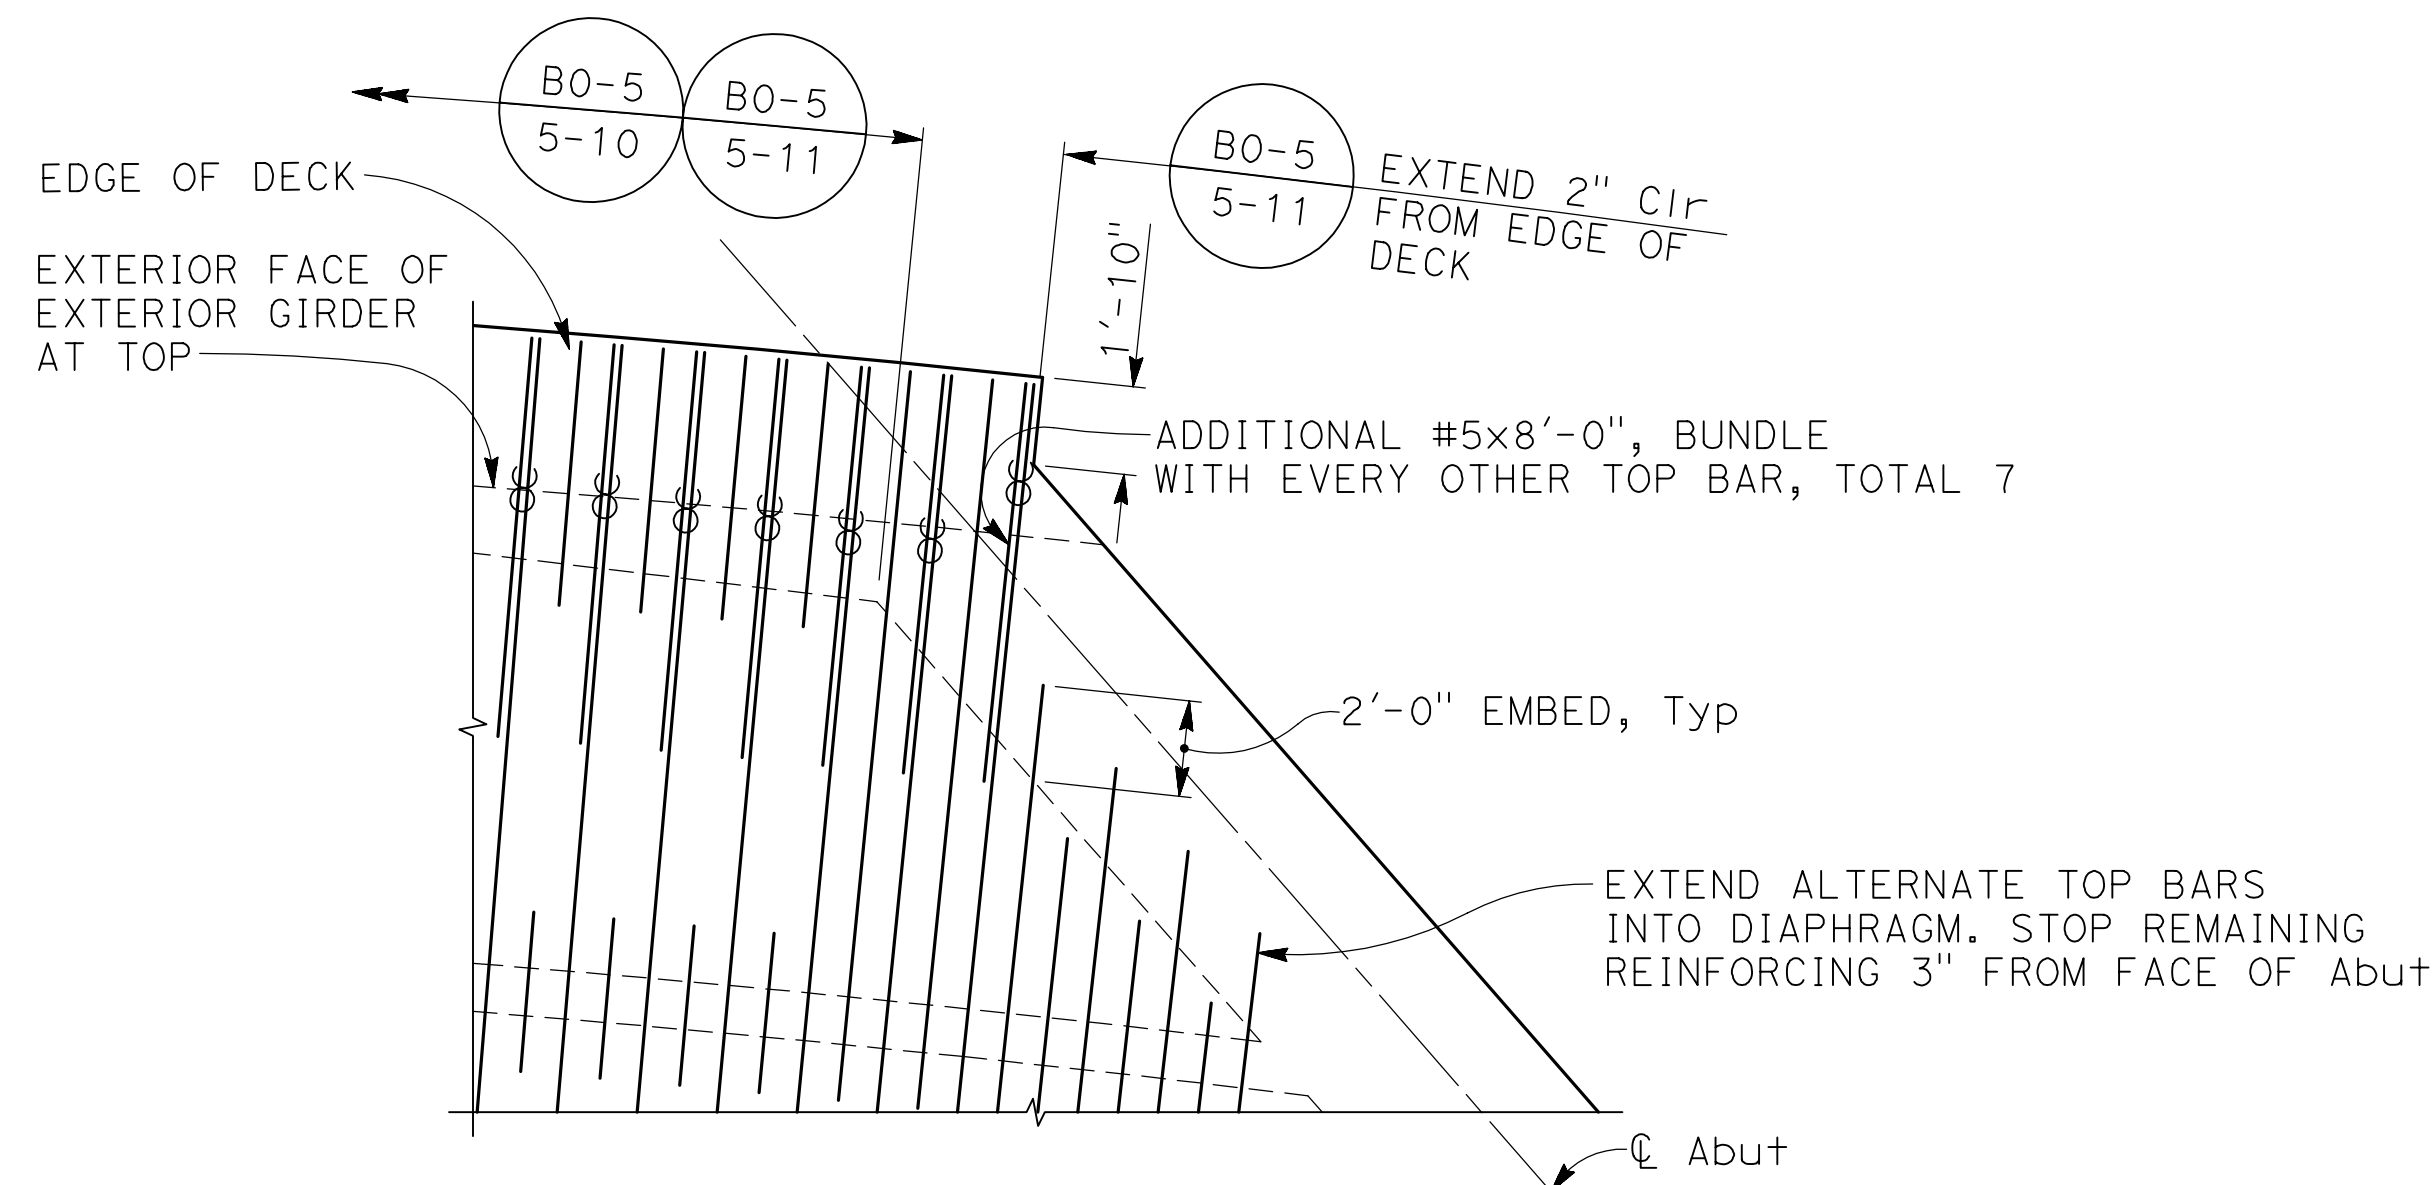


OBTUSE CORNER DETAIL (1)
NO SCALE S11

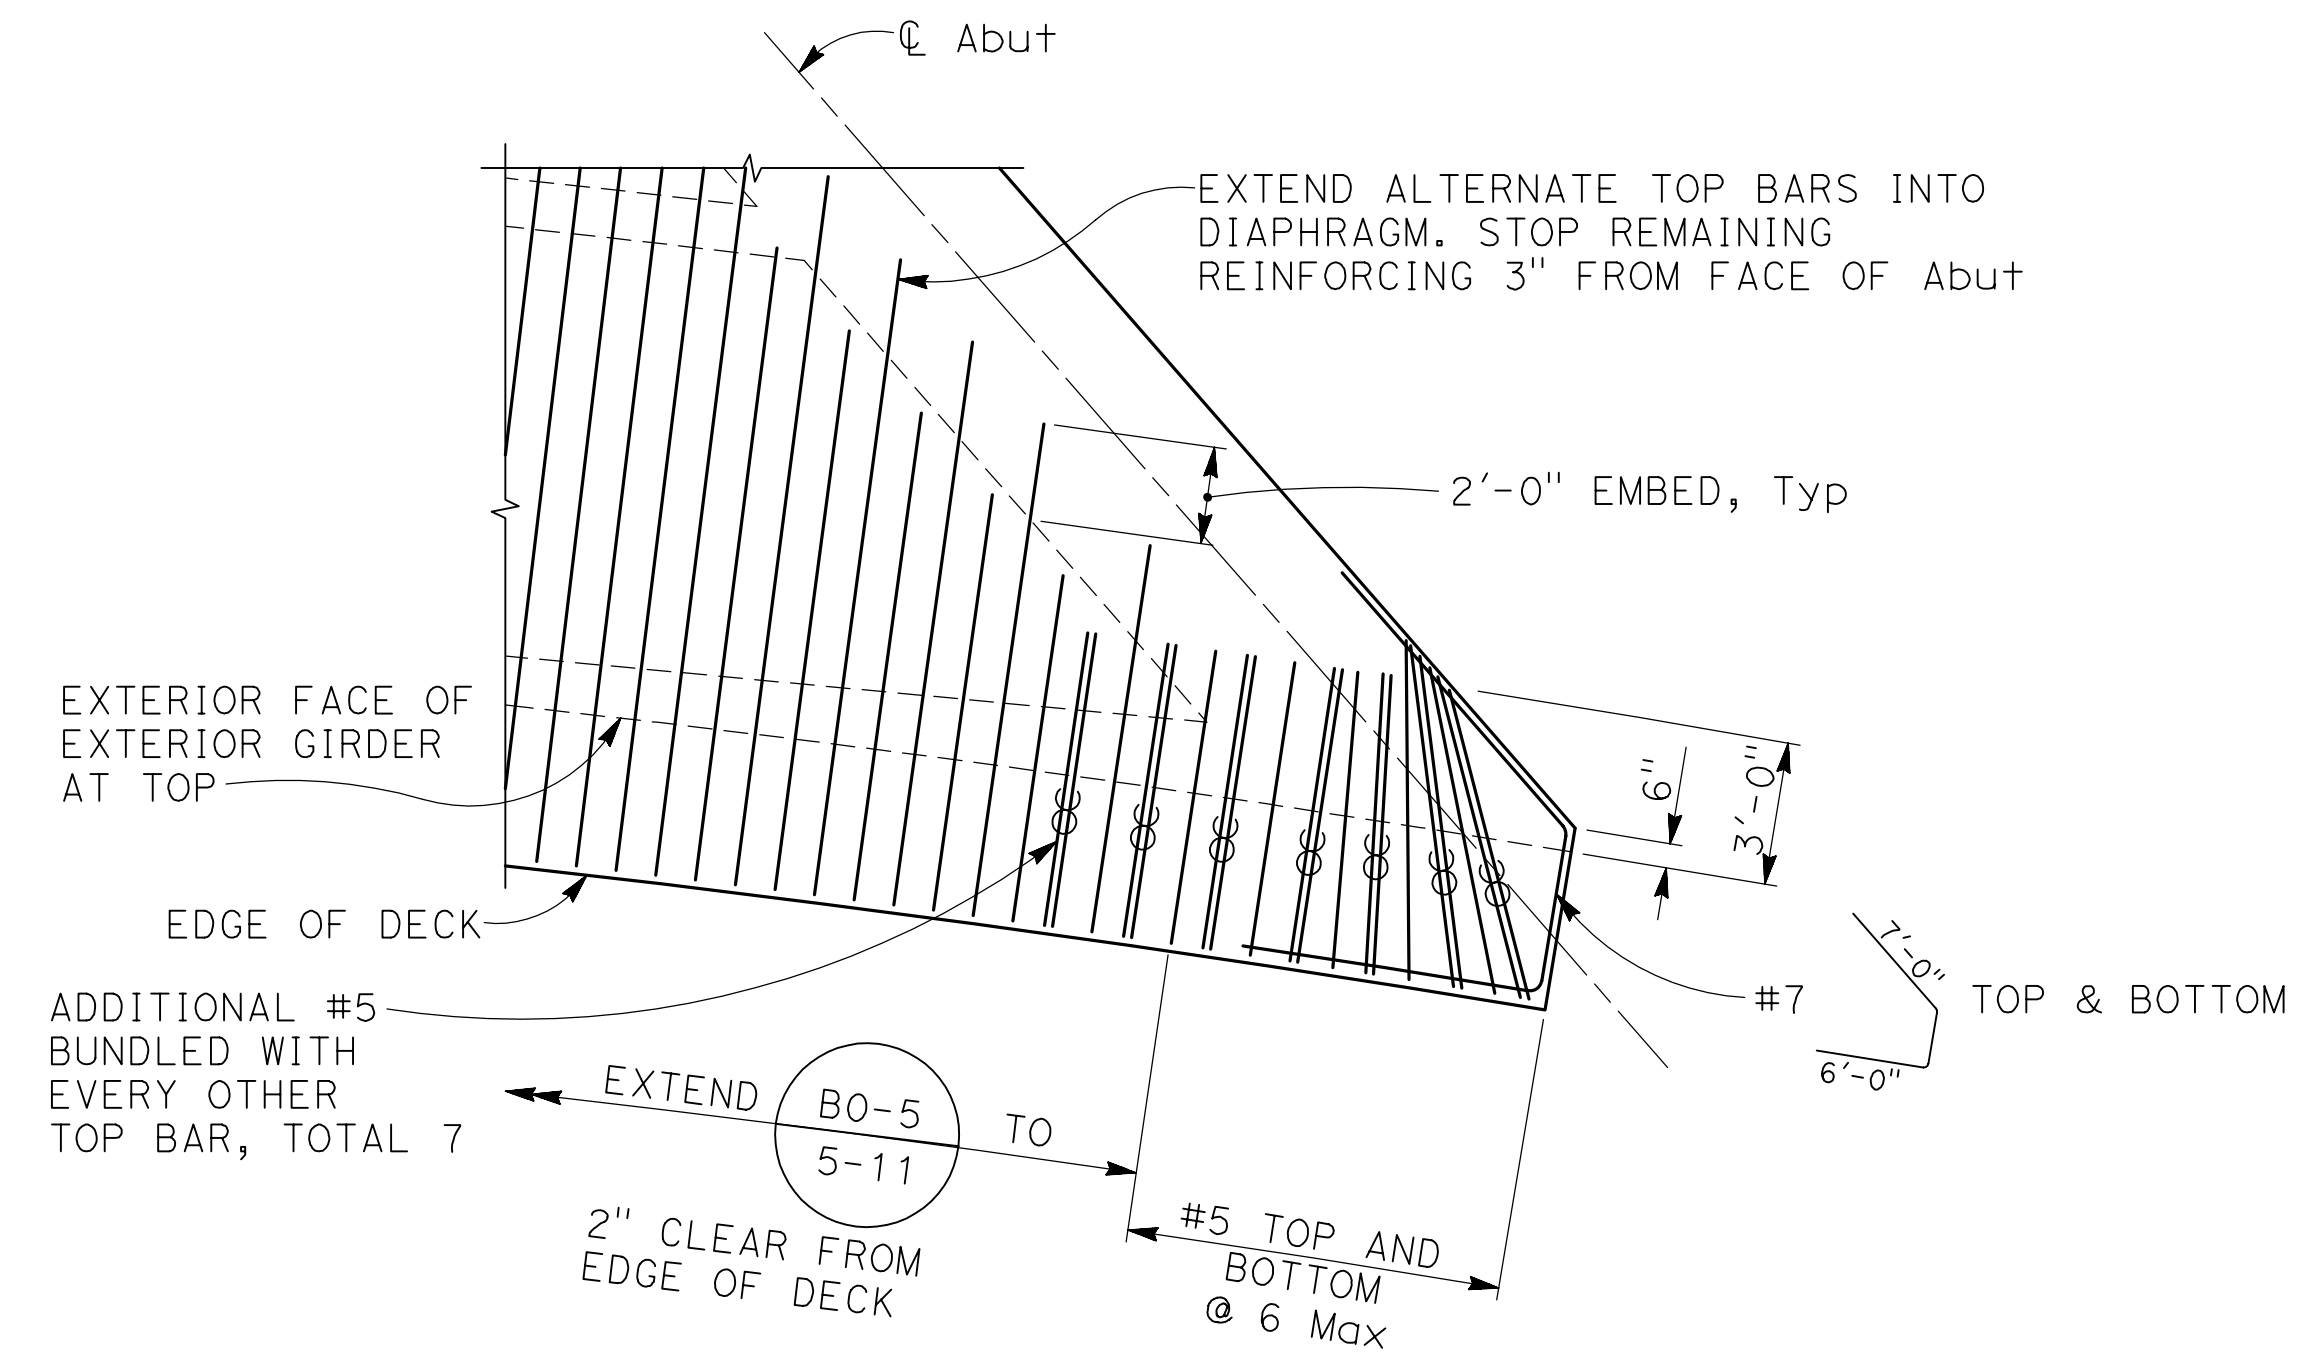

ACUTE CORNER DETAIL (2)
NO SCALE S11

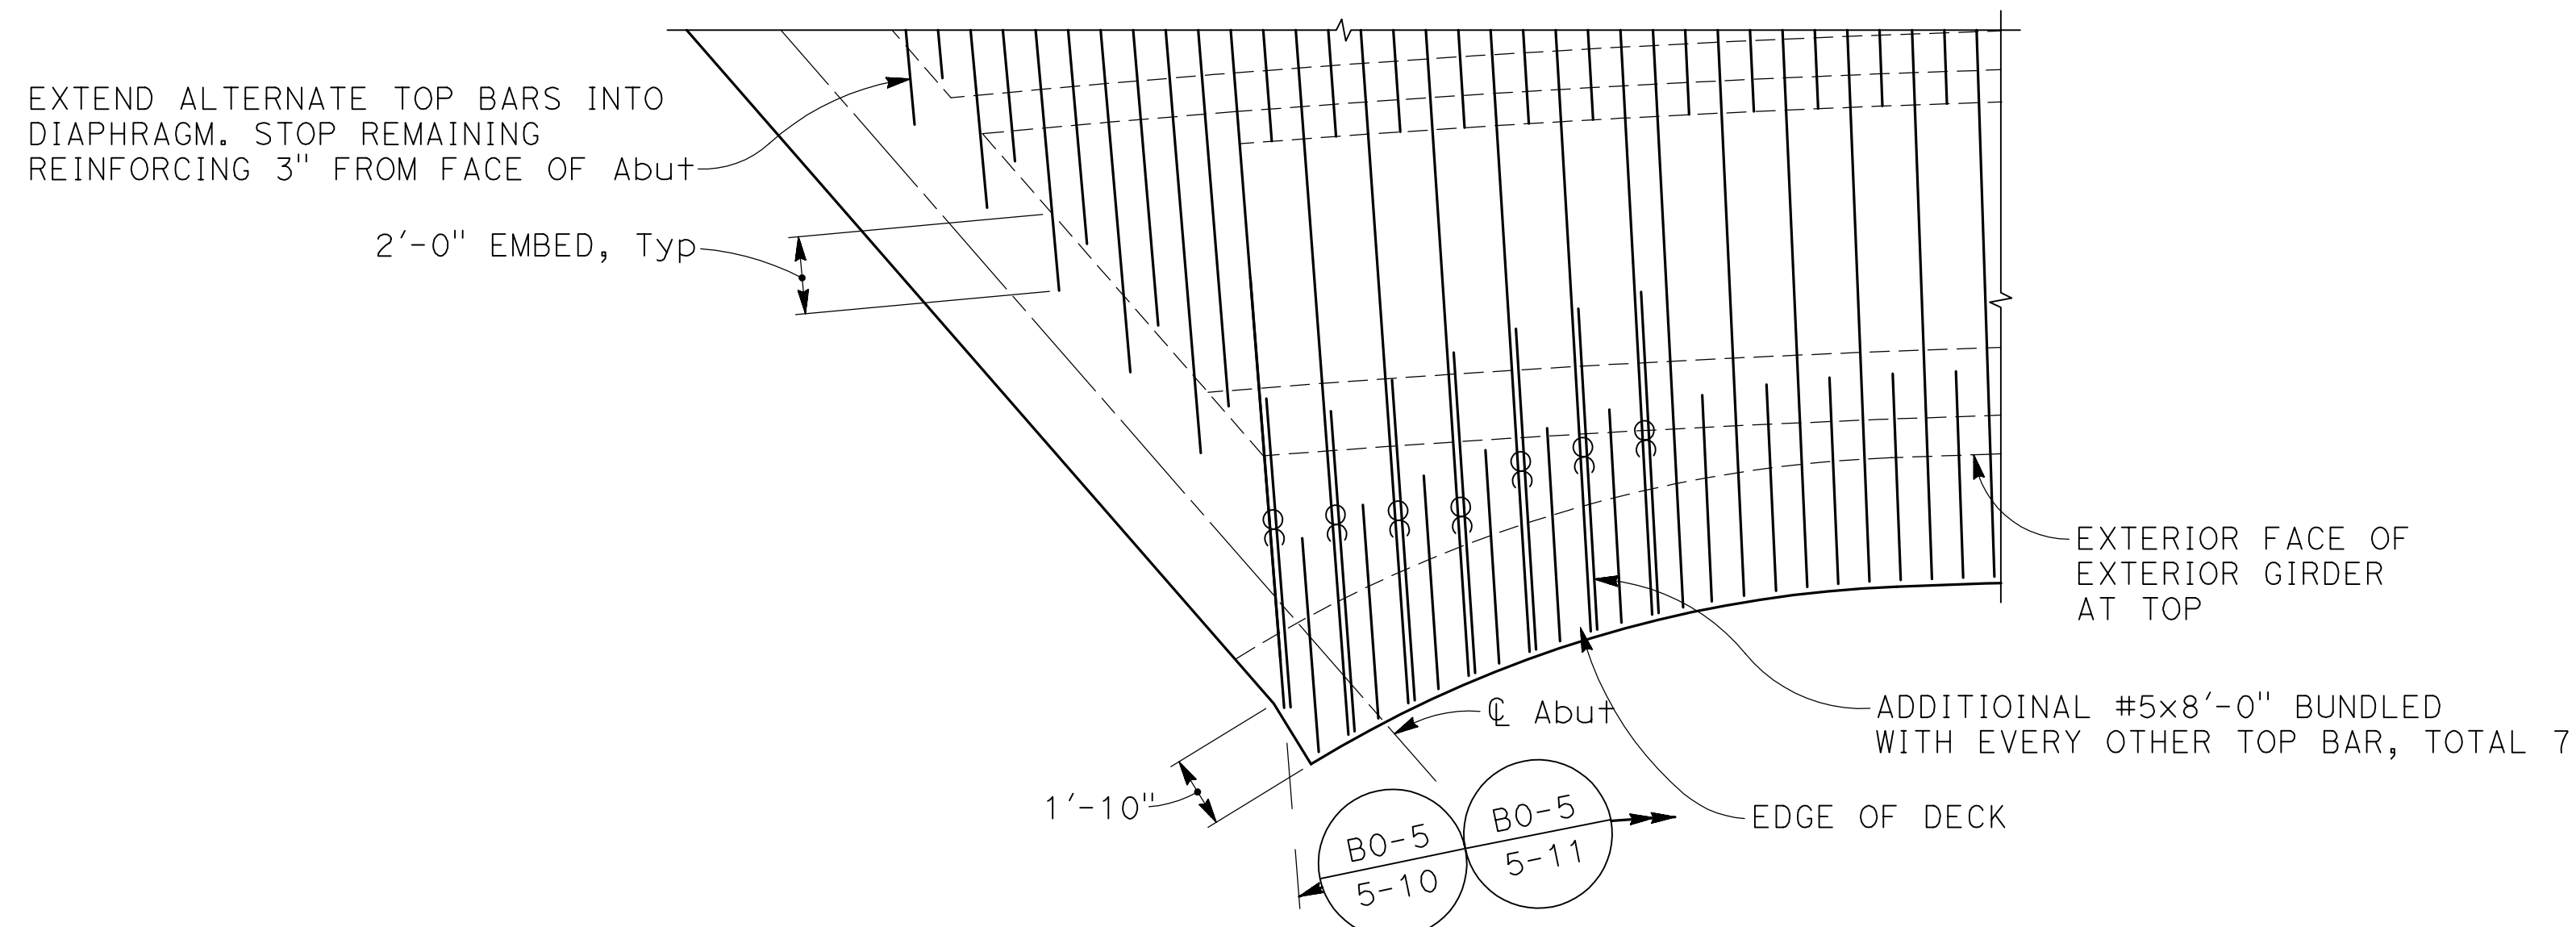


OBTUSE CORNER DETAIL (3)
NO SCALE S11

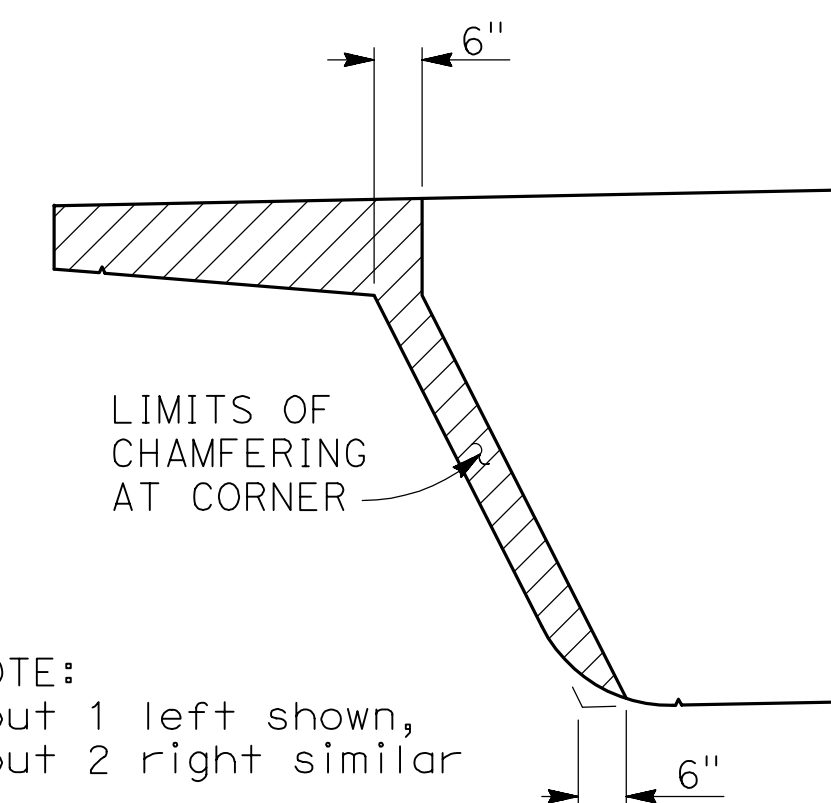

SECTION A
1/2" = 1'-0" S11


NOTE:
THE CONTRACTOR MUST VERIFY ALL CONTROLLING FIELD DIMENSIONS BEFORE ORDERING OR FABRICATING ANY MATERIAL

DESIGNED: SGS	DATE: 1/25/21	RECORD DRAWING	SCALE	PROJECT		DEPARTMENT OF PUBLIC WORKS AND PLANNING
DRAWN: SMH	DATE: 1/25/21	RESIDENT ENGINEER	AS SHOWN	SAND CREEK BRIDGE REPLACEMENT ON ENNIS ROAD		GIRDER DETAILS
CHECKED: ML	DATE: 1/25/21			ROAD NO. 2824-2825	BRIDGE NO. 42C0697, BRLO-5942(238)	DRAWING NO. 11257 SHEET NO. 28 TOTAL 31

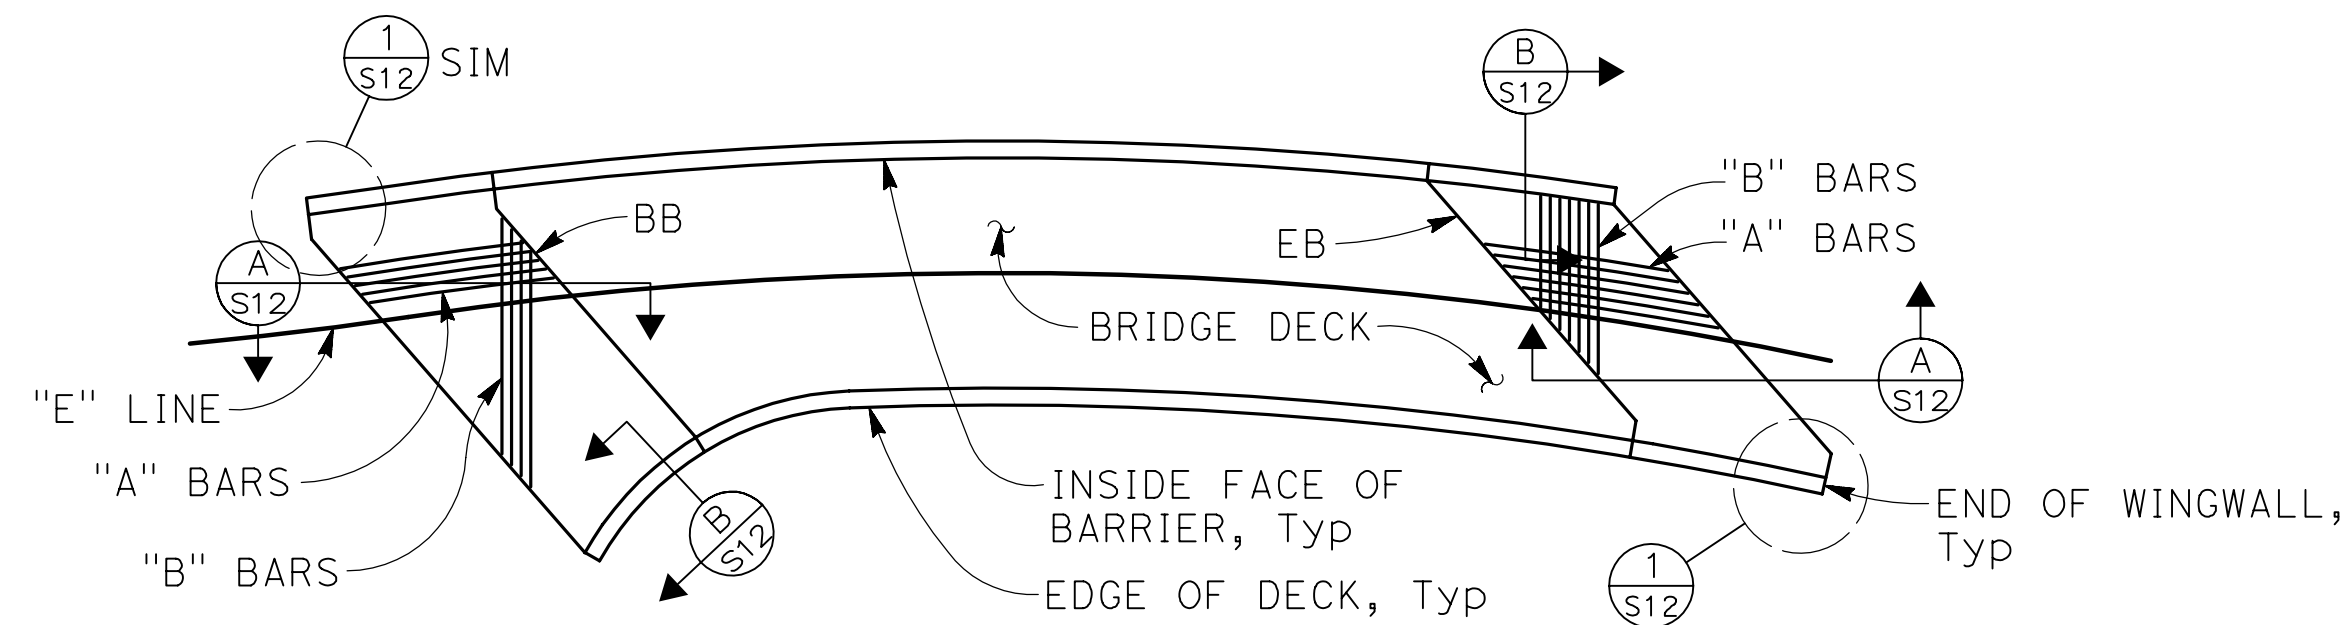

PLAN

1" = 20'

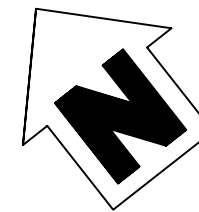


NOTES:

1. Longitudinal construction joints, when permitted by the Engineer, shall be located on lane lines.
2. For drainage details, see "DRAINAGE DETAILS" sheet.
3. At the contractor's option, approach slab transverse reinforcement may be placed parallel to BB or EB. Spacing of transverse reinforcement is measured along \perp roadway.
4. Provide cross slope to match deck surface grade. See "TYPICAL SECTION" and "DECK CONTOURS" sheets.
5. Space "A" bars at 6" max at BB and 9" max at end of approach slab at the southwest approach slab quadrant.


LEGEND:

Remove all polystyrene after concrete is cured.

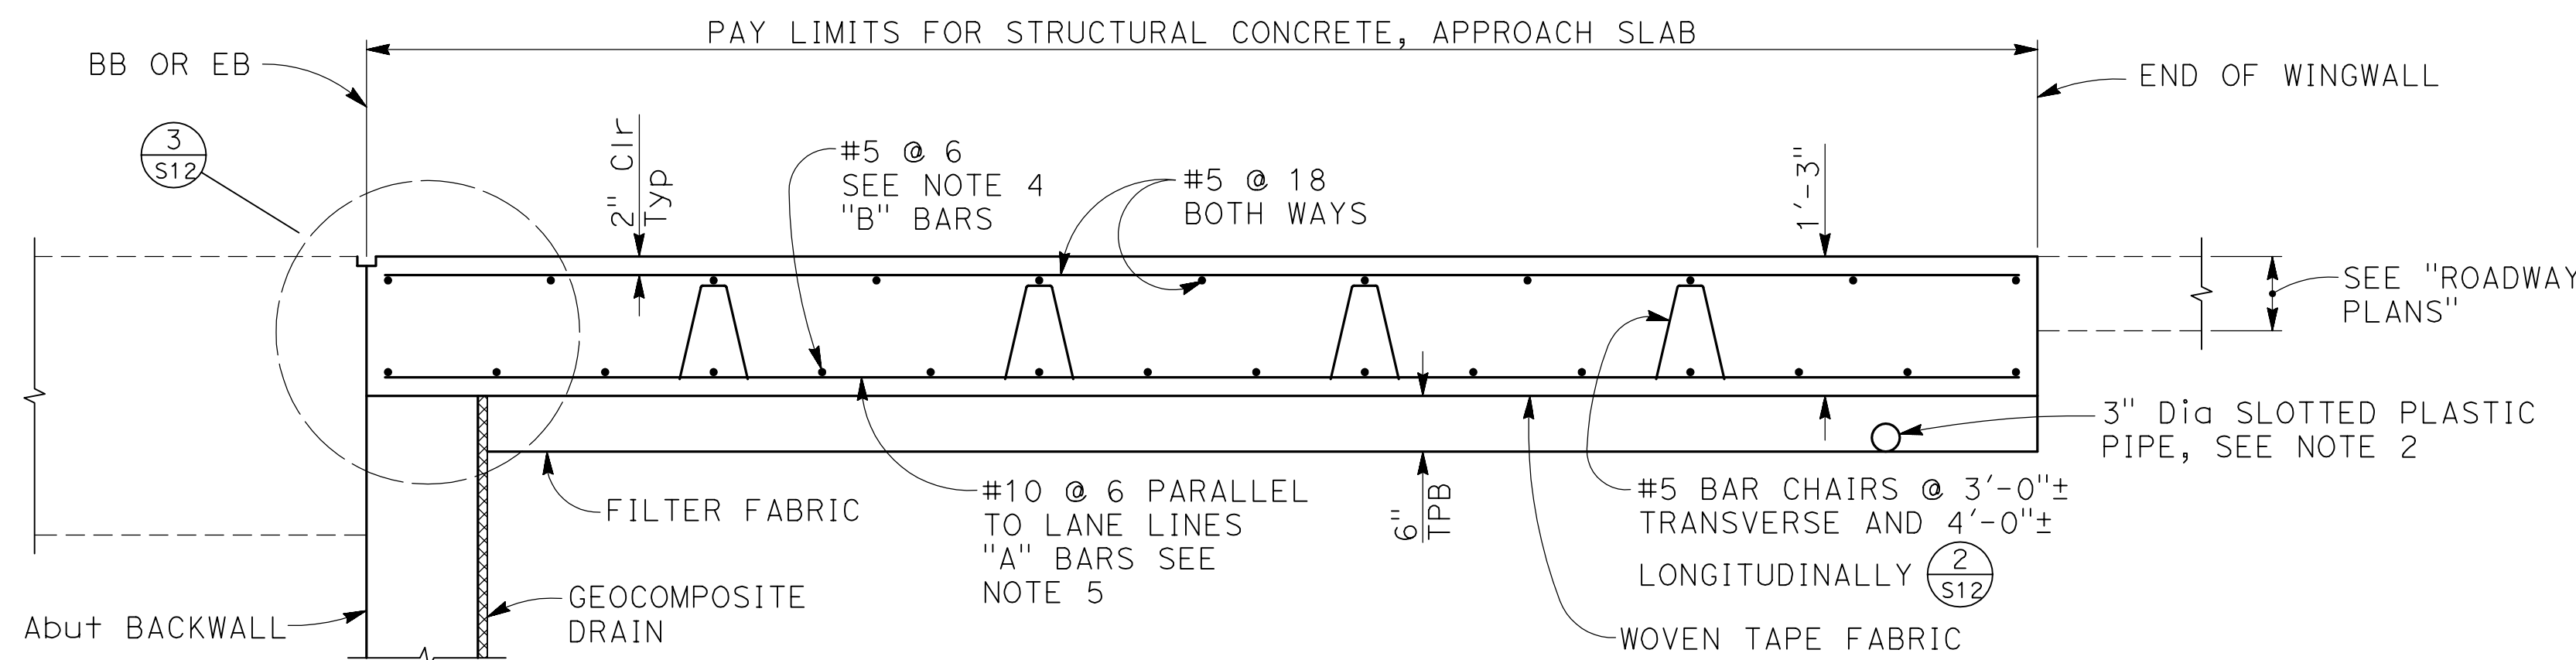


SECTION A

3/4" = 1'-0"

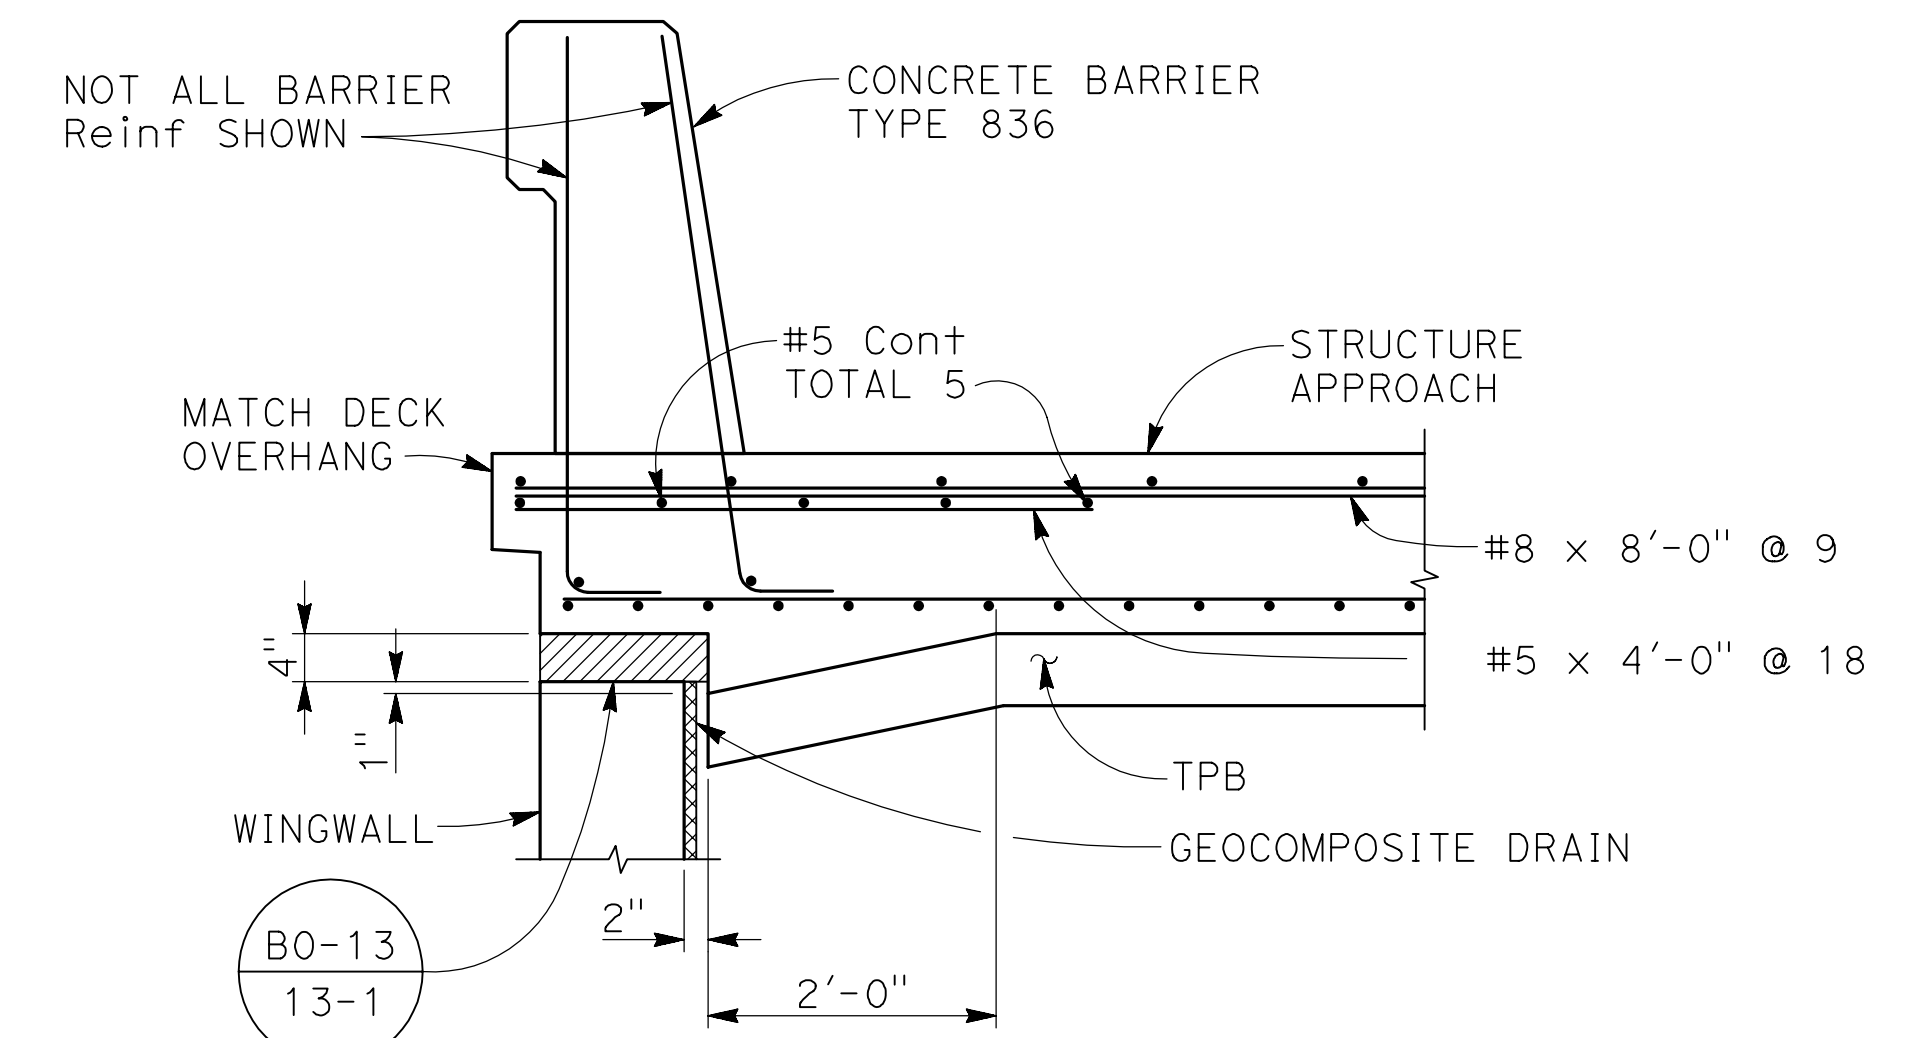



SECTION B

3/4" = 1'-0"

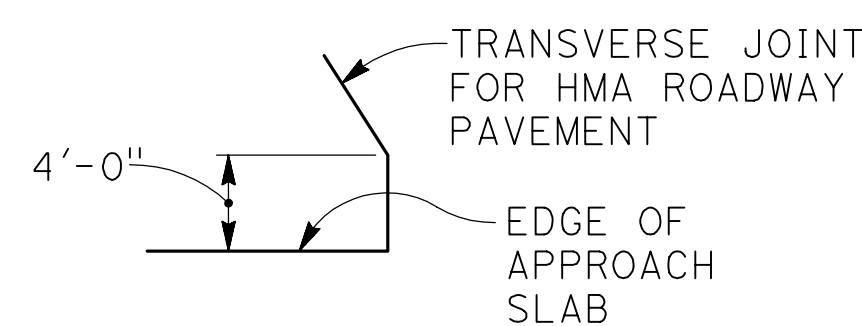



DETAIL 1

NO SCLAE

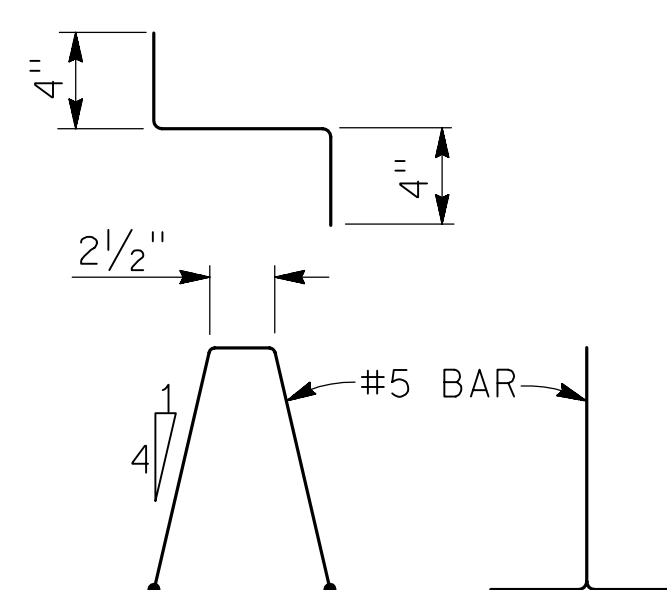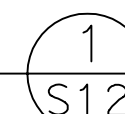


BAR CHAIR DETAIL 2

1 1/2" = 1'-0"

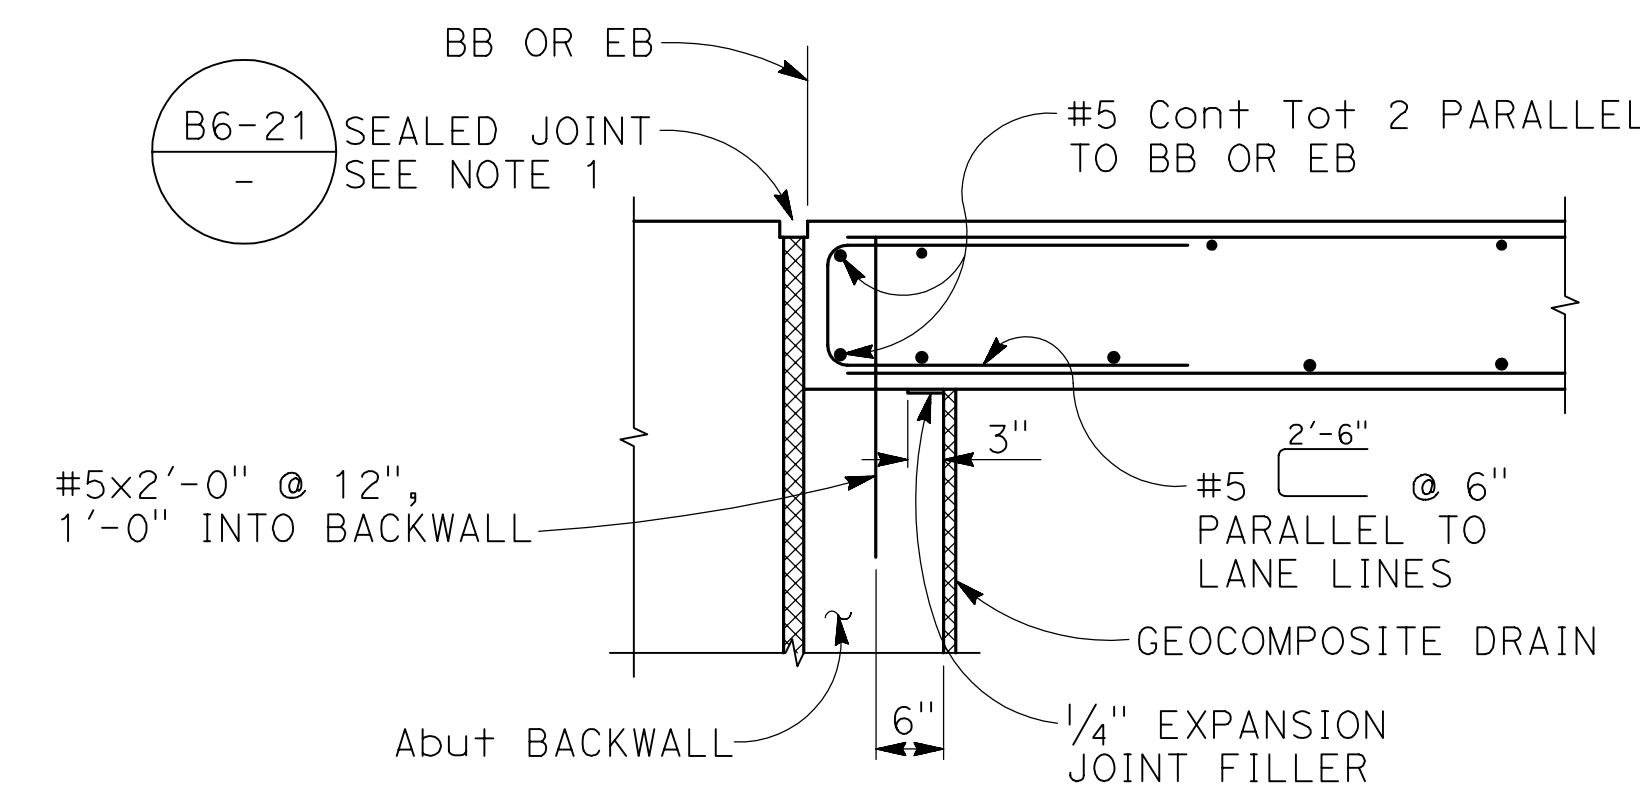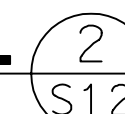


SEAT TYPE ABUTMENT TIE DETAILS 3

3/4" = 1'-0"

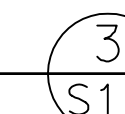


NOTE:
THE CONTRACTOR MUST VERIFY ALL CONTROLLING FIELD DIMENSIONS BEFORE ORDERING OR FABRICATING ANY MATERIAL


DESIGNED: SGS		DATE: 1/25/21	RECORD DRAWING		SCALE	PROJECT		DEPARTMENT OF PUBLIC WORKS AND PLANNING	
DRAWN: AR		DATE: 1/25/21	RESIDENT ENGINEER	DATE	AS SHOWN	SAND CREEK BRIDGE REPLACEMENT ON ENNIS ROAD		STRUCTURE APPROACH DETAILS	
CHECKED: ML		DATE: 1/25/21				ROAD NO. 2824-2825	BRIDGE NO. 42C0697, BRLO-5942(238)	DRAWING NO. 11257	SHEET NO. 29

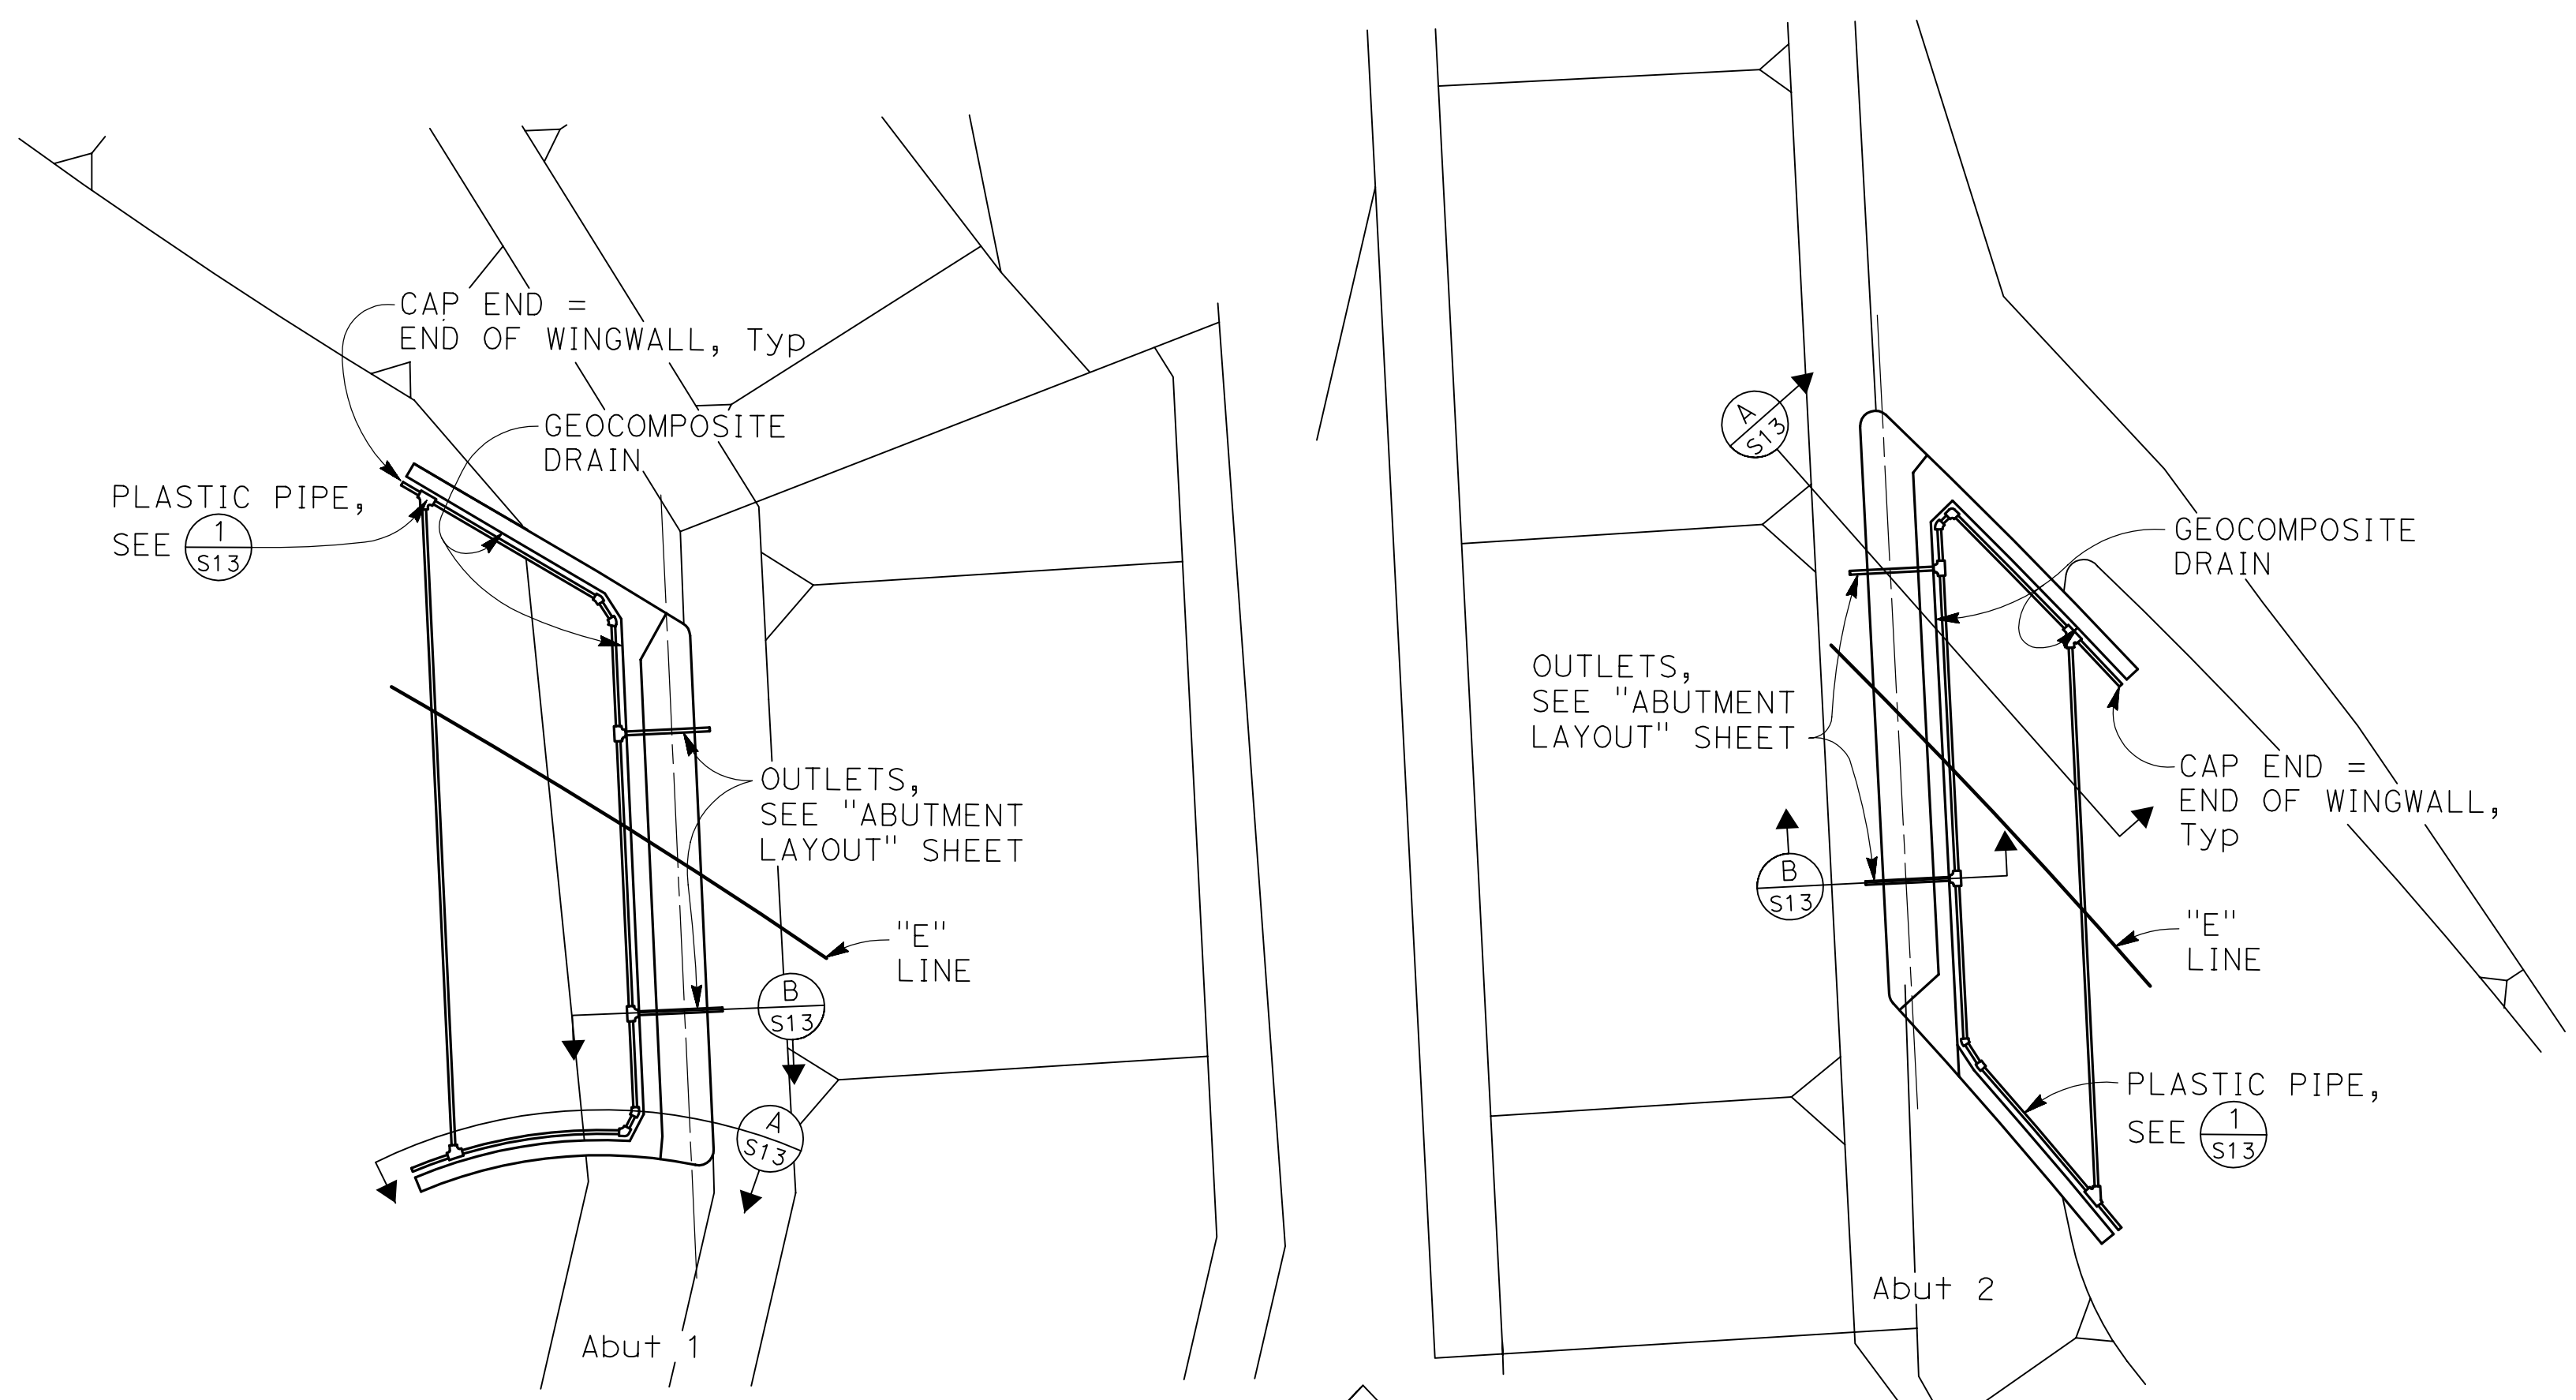

PLAN
1" = 10'

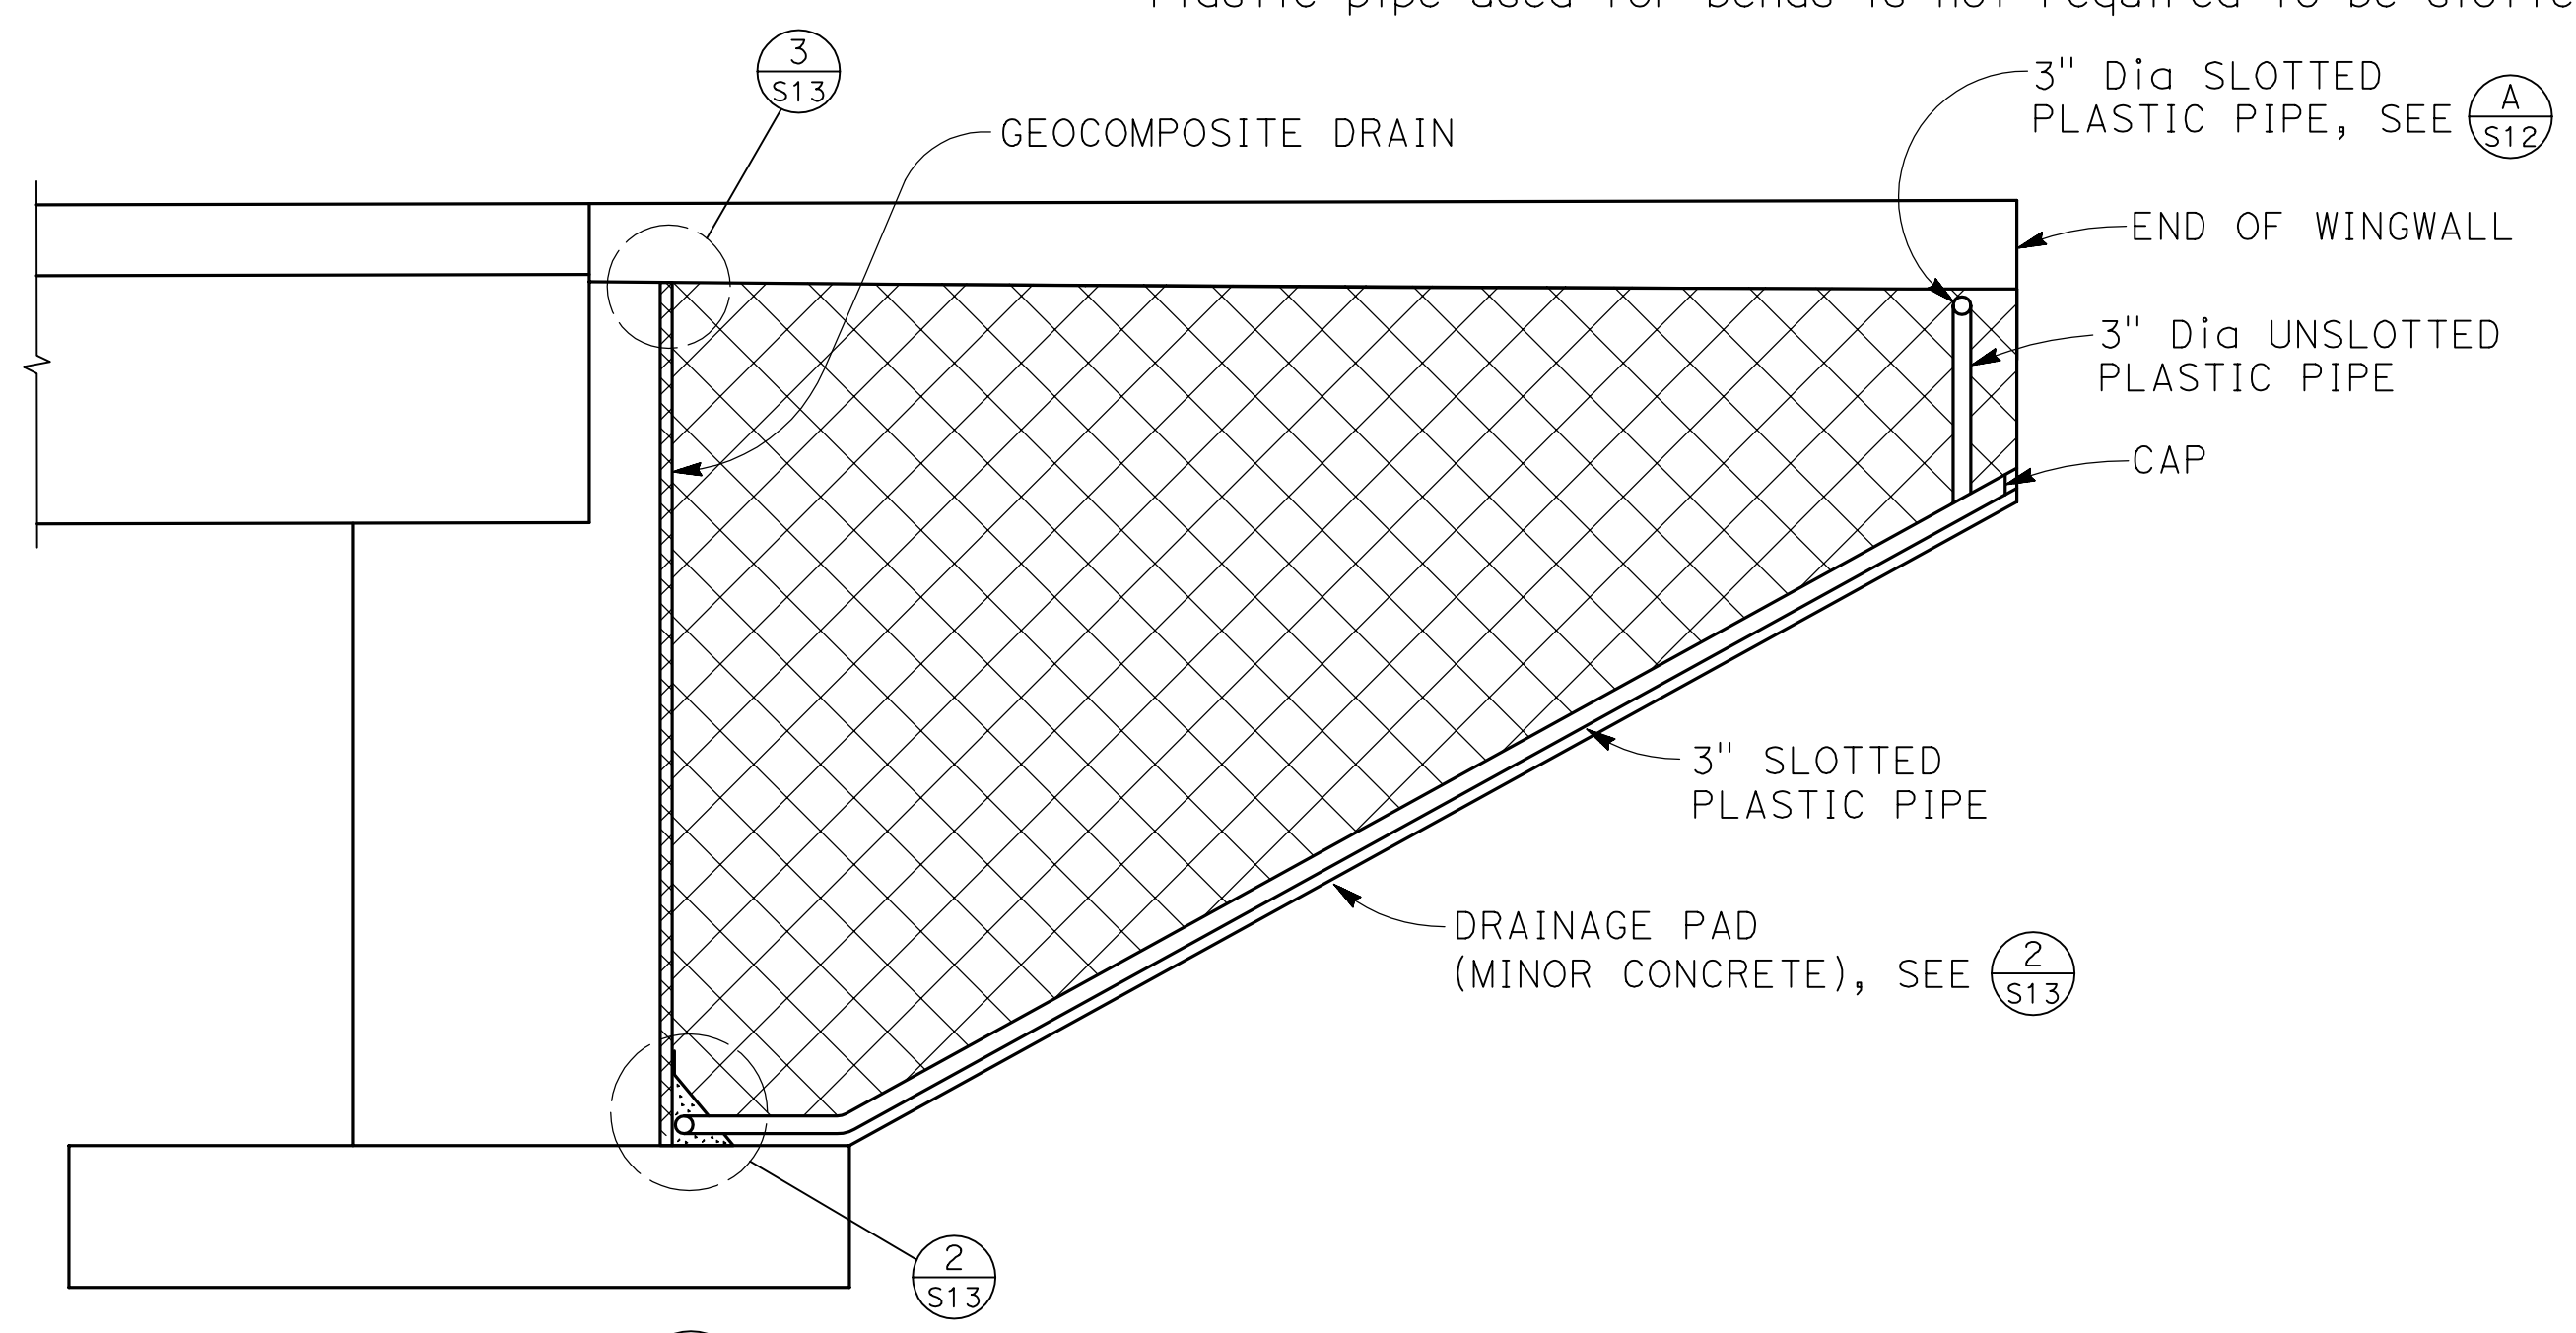


SECTION A
3/8" = 1'-0" S13

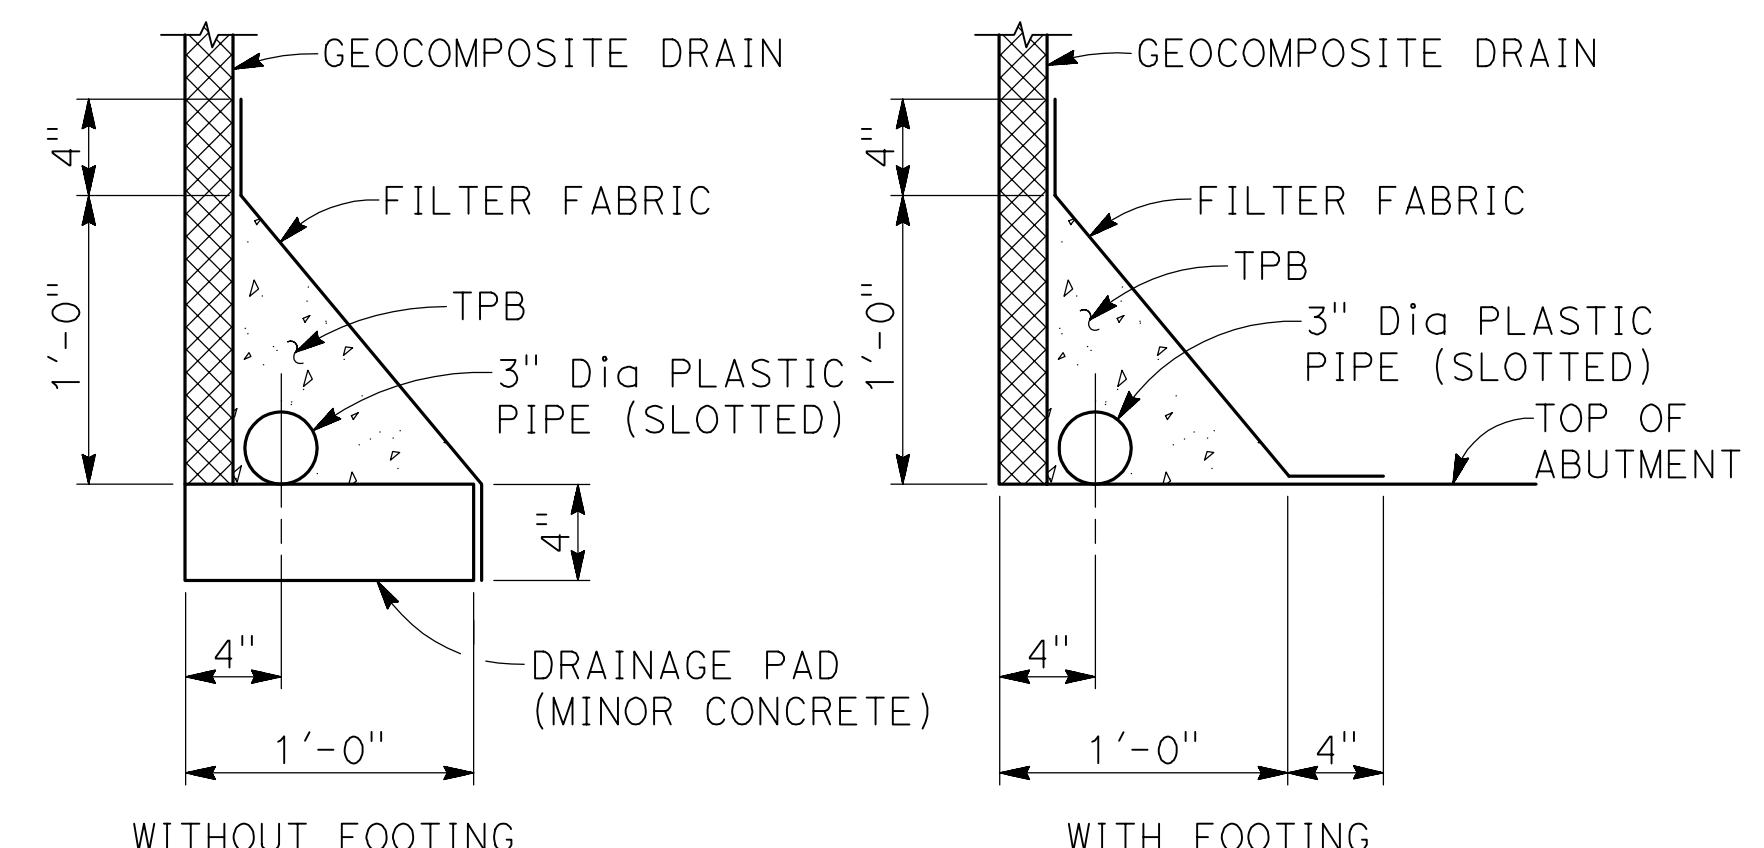


- NOTES:**
- 4" dia drains at locations shown on abutment elevations and at 25' max center to center along wingwall. Exposed wall drains shall be located 3"± above finished grade.
 - Geocomposite drain, cement treated permeable base, and 3" dia slotted plastic pipe continuous behind retaining wall or abutment. Cap ends of pipe. Provide "Tee" connection at each 4" dia drain.
 - Connect the low end of plastic pipe to the main outlet pipe as applicable.


DETAIL 2
NO SCALE S13

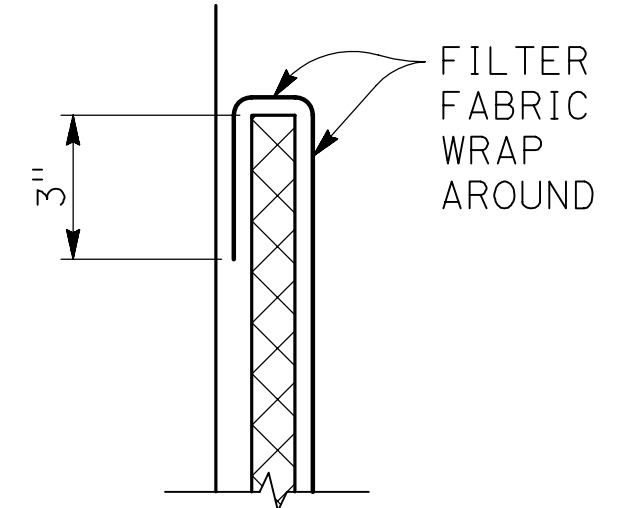

DETAIL 3
1 1/2" = 1'-0" S13

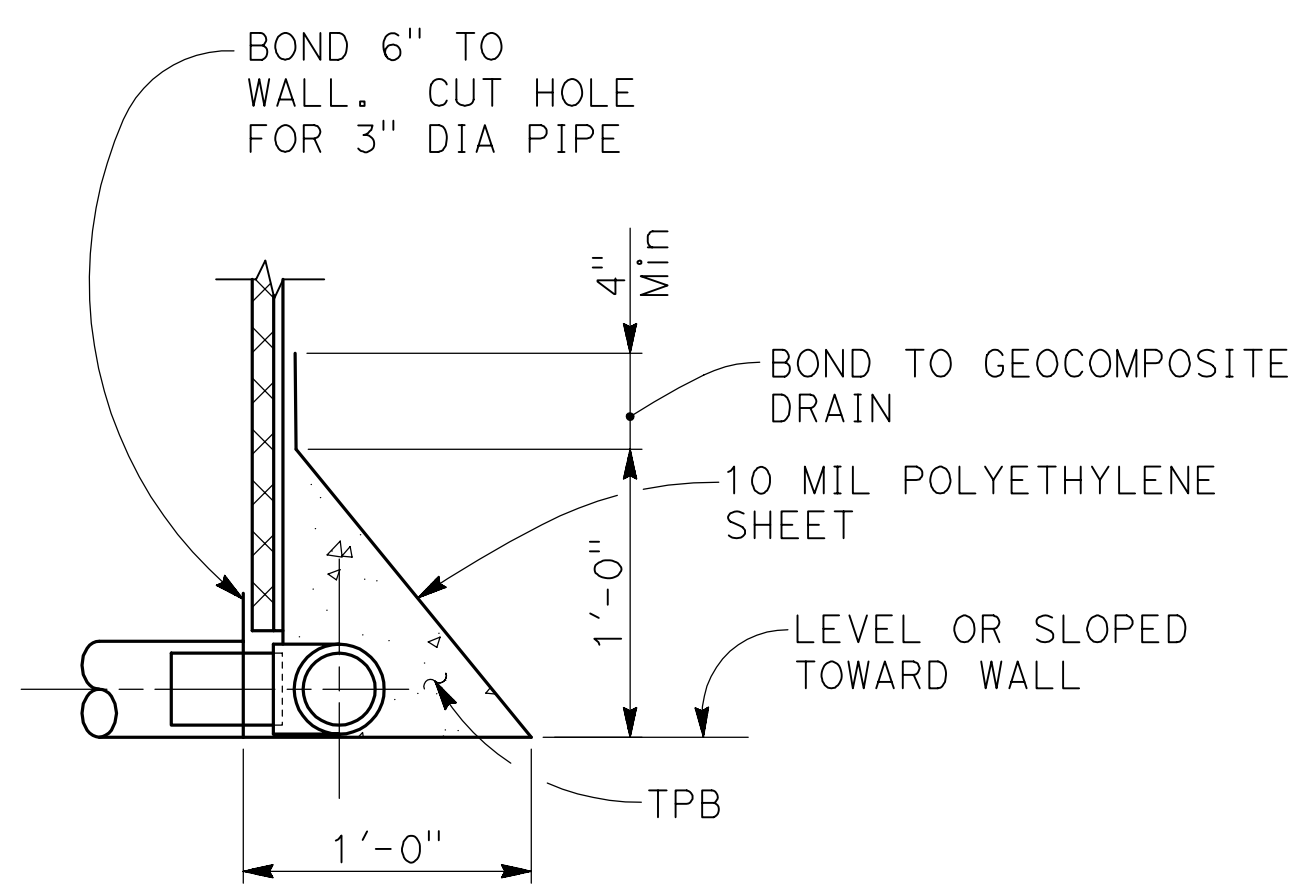

SECTION B
1 1/2" = 1'-0" S13

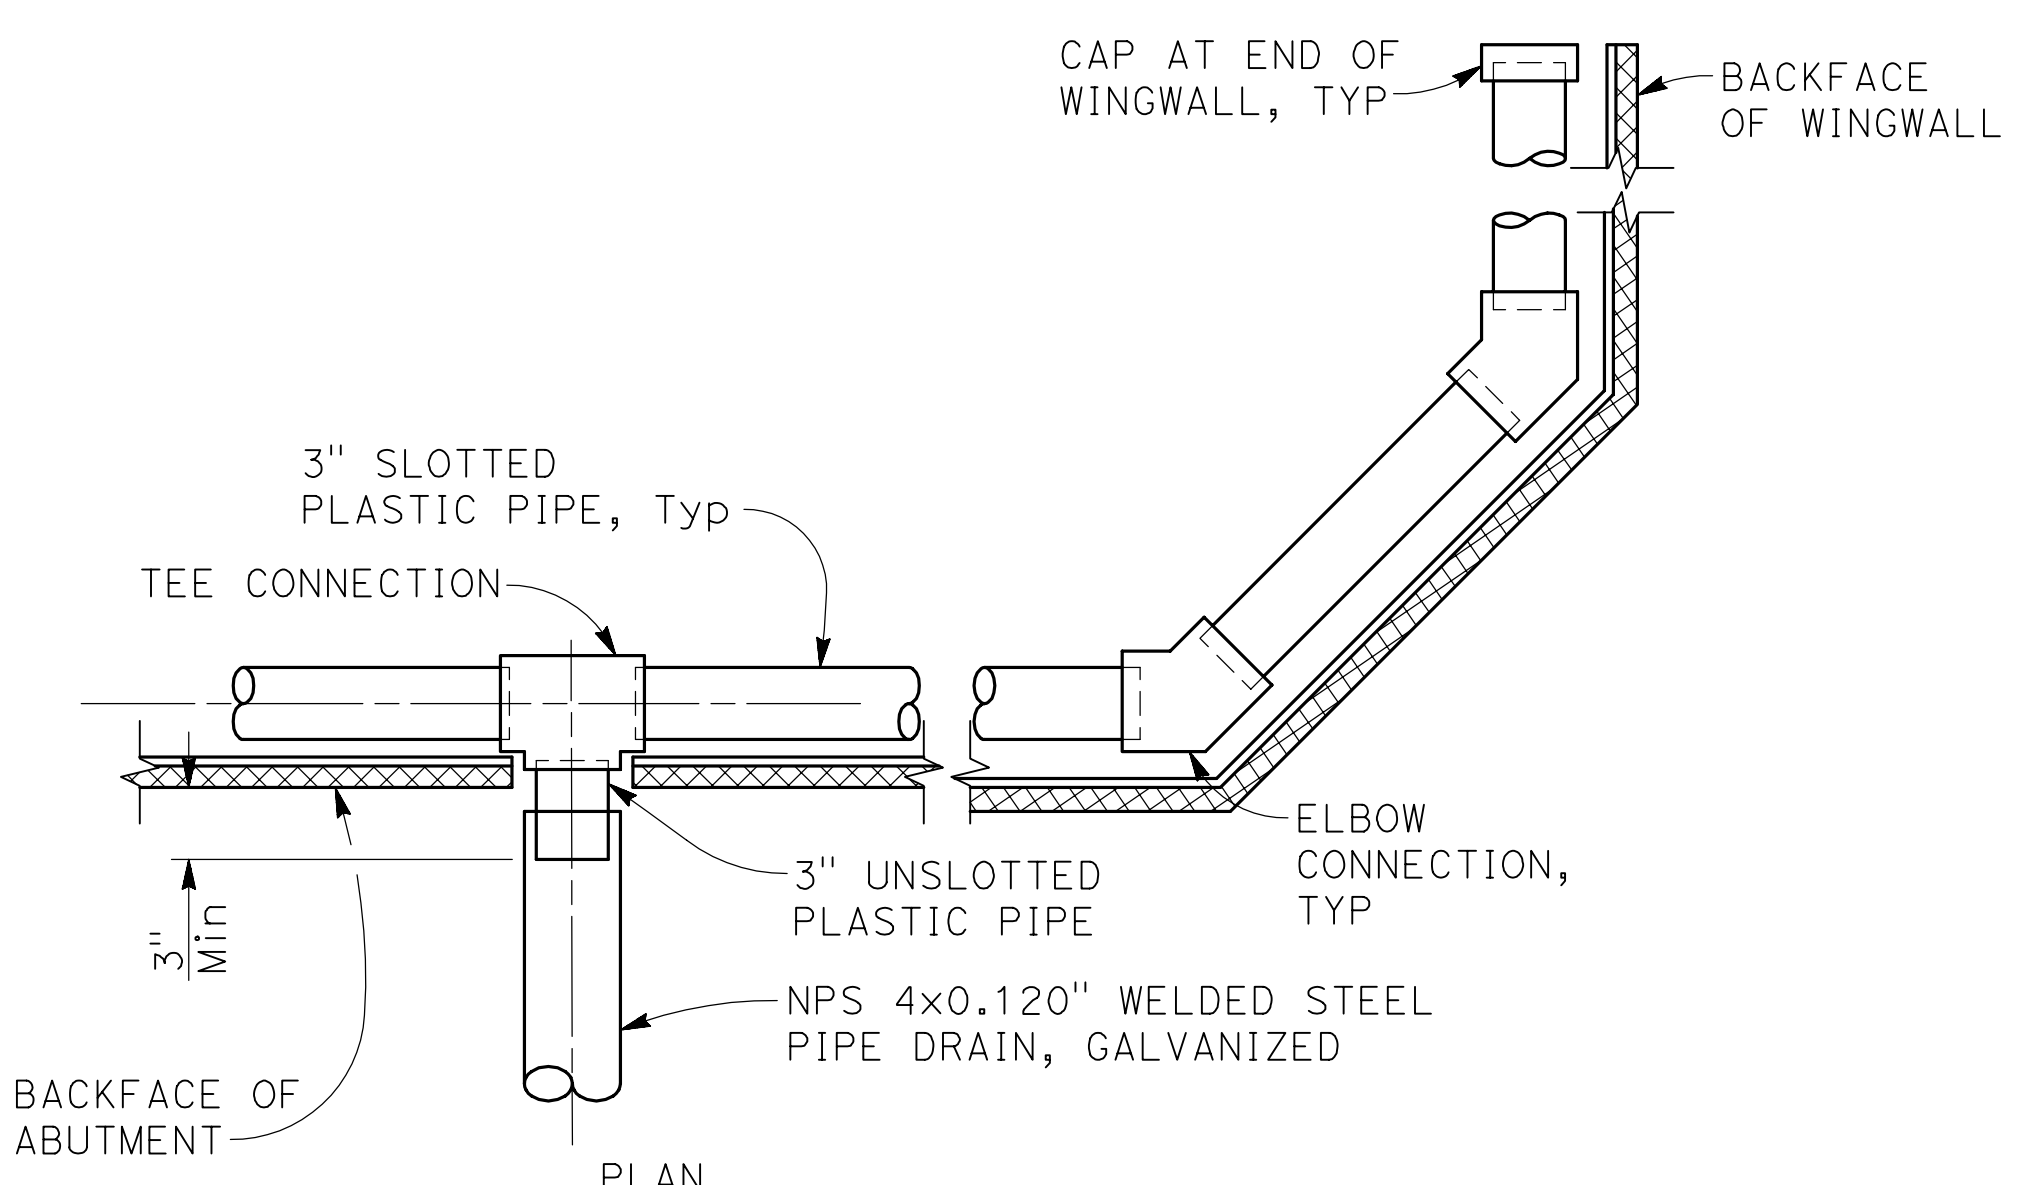

DETAIL 1
1 1/2" = 1'-0" S13

NOTE:
THE CONTRACTOR MUST VERIFY ALL CONTROLLING FIELD DIMENSIONS BEFORE ORDERING OR FABRICATING ANY MATERIAL

DESIGNED: SGS		DATE: 1/25/21	RECORD DRAWING		SCALE: AS SHOWN	PROJECT: SAND CREEK BRIDGE REPLACEMENT ON ENNIS ROAD			DEPARTMENT OF PUBLIC WORKS AND PLANNING	
DRAWN: AR		DATE: 1/25/21	RESIDENT ENGINEER			BRIDGE NO. 42C0697, BRLO-5942(238)			DRAINAGE DETAILS	
CHECKED: ML		DATE: 1/25/21	DATE			ROAD NO. 2824-2825			DRAWING NO. 11257 SHEET NO. 30 TOTAL 31	

THESE PLANS ARE FOR THE CONTRACTOR'S INFORMATION ONLY. THEY ARE NOT TO BE CONSIDERED TO BE PART OF THE CONTRACT DOCUMENTS AND SHALL HAVE NO BEARING WHATSOEVER ON THE INTERPRETATION OF THE STANDARD SPECIFICATIONS, THE STANDARD PLANS, THE SPECIAL PROVISIONS, NOR SHALL THEY HAVE ANY BEARING WHATSOEVER ON THE INTERPRETATION OF THE OTHER PUBLICATIONS REFERENCED THEREIN